



To:

Mr. Anthony Jacque-Plans Examiner Division of Industrial Compliance Bureau of Building Code Compliance

6606 Tussing Road

Reynoldsburg, OH 43068-9009

Project: Chagrin Falls Police & Fire Renovations

21 W Washington Street Chagrin Falls, OH 44022

Project #:2018020653

We submit the following clarifications, revisions, and comments for your review and approval. Comments are organized per Correction Letter No. 2 from Anthony Jacques, dated February 6, 2019, and they are reproduced below for reference. Responses are in bold italics. Clarifications made to the drawing set in response to these comments have been clouded as Revision #3. Please call if you have any questions or concerns.

1) Shop drawings or construction documents have not been received for fire suppression systems to date. The sprinkler system, standpipes and their components, system design, water supplies, acceptance tests, alarms, fire department connections, installation of pipes and fittings and their support from the building structure, protection of piping against damage, use of approved listed valves, hangers, sprinkler heads, supervision, identification devices, inspection, maintenance, etc. shall be detailed to conform to the requirements of the systems referenced in Section 903.3 OBC. Such details shall include calculations and graphic data showing sprinkler spacing, water supply, sizes of piping and fittings, and identification of apparatus and devices.

Acknowledged. Shop drawings for the fire suppression systems will be submitted at a later date after selection of a general contractor. The Village is still attempting to bid the project

2) Shop drawings or construction documents have not been received for fire alarm/detection systems to date. Shop drawings for fire alarm and smoke and fire detection systems shall be submitted for review and approval prior to system installation, and shall include, but not be limited to, all of the items listed in 907.1.2 OBC.

Acknowledged. Shop drawings for the fire alarm/detection systems will be submitted at a later date after selection of a general contractor. The Village is still attempting to bid the project.

3) Processing and plan review fees shall be paid for sprinkler and fire alarm scopes of work. OBC 115.

Acknowledged. Processing and plan review fees will be paid for sprinkler & fire alarm systems after a certified contractor has been selected and the scope/design determined.

(continued)

4) The documents still show sensor release devises on the egress side of egress doors. Sensor release devices (card readers, key pads, magnetic locks, elec. strikes, etc.) are allowed on egress doors in use group or occupancy A, B, E, 1-1,1-2,1-4, M, R-l and R-2 where they meet all six items in OBC 1010.1.9.8. I-3 use groups do not allow these devices. Submit revised documents showing compliance.

Keypad electric lock hardware for Door #102B has been revised to show compliance with the six items listed under OBC 1010.1.9.8. Refer to door #102B on the door schedule and hardware set #18 in the hardware schedule on sheet "A601". The hardware shall automatically unlock when (1) a sensor installed on egress side sends a signal to unlock the door when an occupant approaches the door, (2) there is a loss of power to the door, (3) a manual unlocking device is installed within 5ft of the door between 40" & 48" aff with a sign that reads "PUSH TO EXIT", (4)activation of the fire alarm system, or (5) activation of the automatic sprinkler system or fire detection system. Hardware shall be UL 294 listed.

Alternate: key pad lock set is to be installed only on entrance side of door with ANSI A117.1 compliant handle on the egress side allowing operation of the latch at all times in accordance with OBC 1010.1.10 for rooms with less then 50 occupants.

5) Shop drawings or construction documents have not been received for cooking equipment hood fire suppression systems to date. Type 1 hoods are required to be protected with fire suppression systems in accordance with OMC 509.1. Submit evidence of conformance for wet chemical sprinkler systems for exhaust hood fire suppression with NFPA 17a. The construction drawings for hood suppression shall be drawn to scale with working dimensions on standard size drawing sheet and shall be adequate, sufficiently clear, comprehensive and detailed; section 106.1.1 OBC.

Acknowledged. Shop drawings for the cooking equipment hood fire suppression systems systems will be submitted at a later date after selection of a general contractor. The Village is still attempting to bid the project.

- 6) Shop drawings or construction documents have not been received for cooking equipment exhaust hoods to date. Type 1 exhaust hoods are required where cooking equipment produces grease or smoke. OMC 507.2.
 - Provide type 1 exhaust and hood fire suppression for the range cooking appliance in accordance with OMC 507.2.1.
 - Hood design shall comply with section M-507.0 OBBC. Provide U.L. 710 listed pre-manufactured hoods or show compliance with OMC 507.4, 507.5, 507.7, 507.12, 507.13, 507.14, 507.15 and 507.16. Provide sections
 - A type 1 hood shall be installed with a clearance to combustibles of not less than 18 inches. OMC 507.9.

Acknowledged. Shop drawings or listed pre-manufactured documentation for the cooking equipment exhaust hoods will be submitted at a later date after selection of a general contractor. The Village is still attempting to bid the project.


(continued)

7) Provide a revised note showing the design professional's responsibility. The documents indicate that the design is based on owner provided documents. The design professional in charge shall verify all existing conditions and shall certify with his/her seal all information provided on the documents. OBC 106.2.

Where my stamp & signature are affixed, to the best of my knowledge & understanding, the existing conditions portrayed within the construction documents are true and accurate as best as can be explored, investigated, and researched within the capacities of a design professional allowed by the State of Ohio.

Sincerely,

Richard E Siegfried A.I.A. NCARB RSA Architects, LLC.

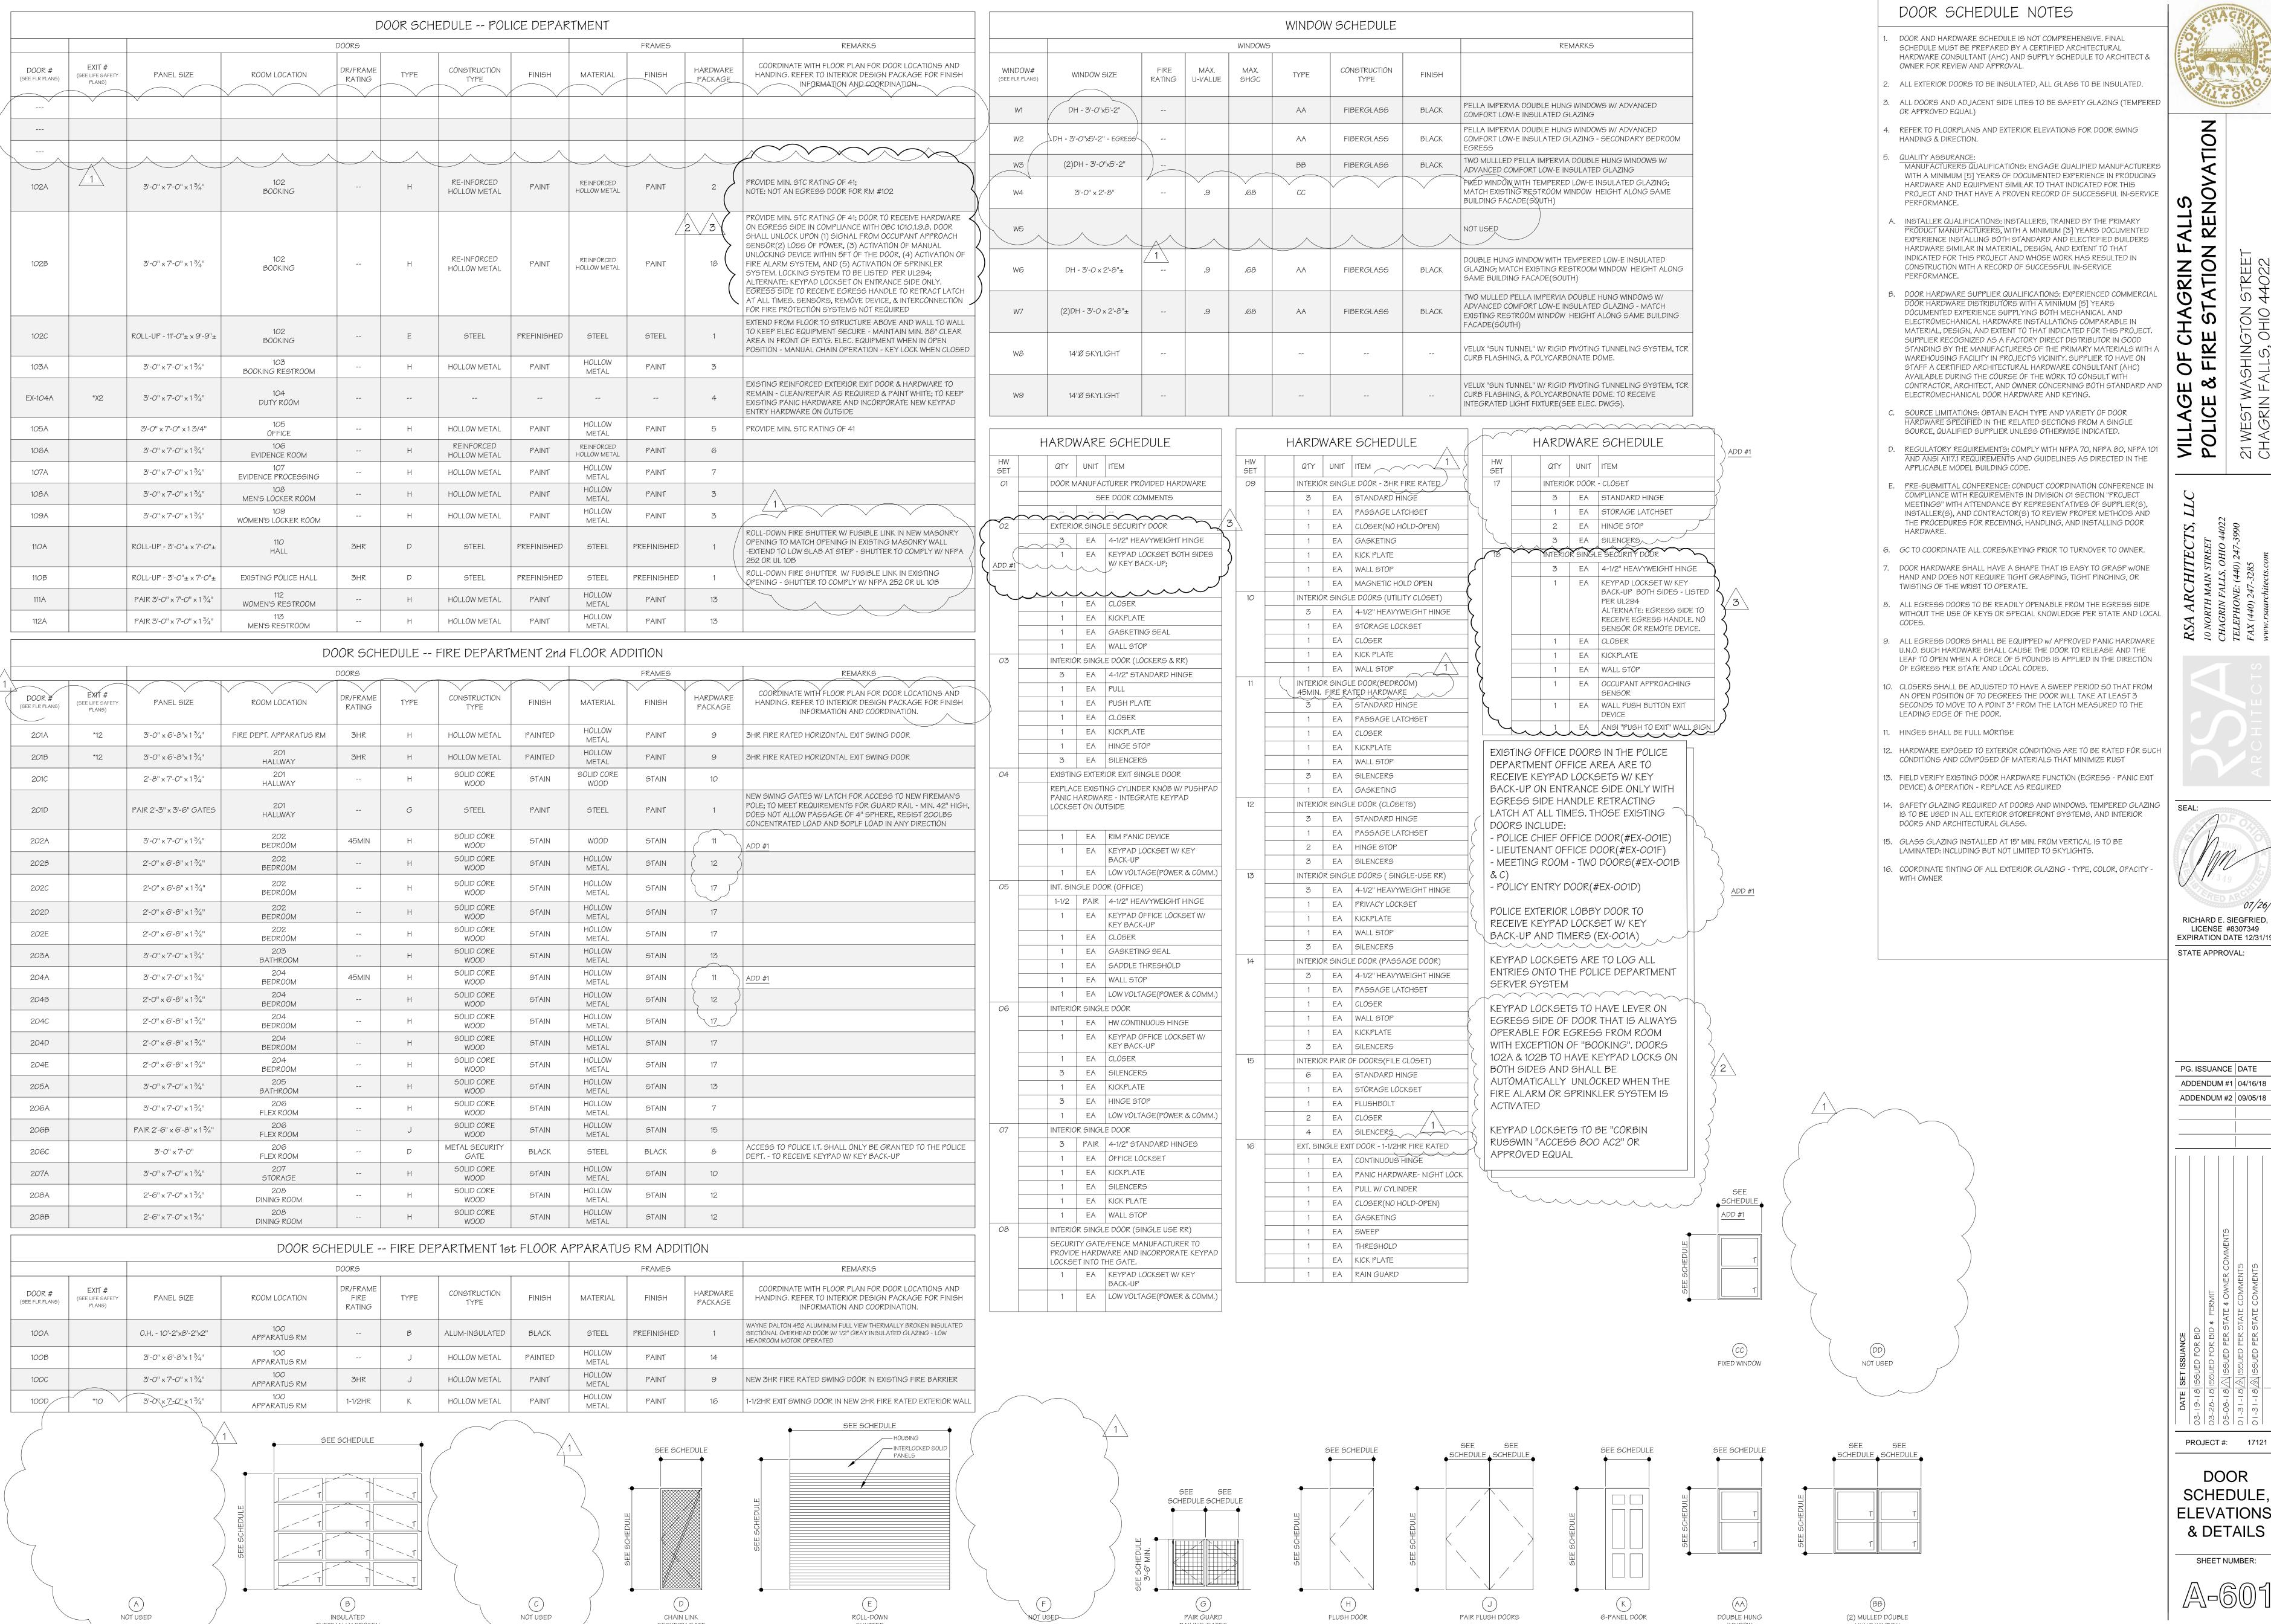

RIN TIO OF (FIR Q jii

RICHARD E. SIEGFRIED, LICENSE #8307349

PG. ISSUANCE DATE ADDENDUM #1 04/16/18

PROJECT #: 17121

DOOR SCHEDULE, **ELEVATIONS** & DETAILS

SHEET NUMBER:

© RSA ARCHITECTS, LLC. 2019