DESIGNERS OF RECORDS:

ARCHITECT

DESIGN UA, INC: GARY HIPOLITE LICENSE NO. #C13681 (714) 892-3900 EXT.701 PHONE NO.:

STRUCTURAL ENGINEER

VP ENGINEERING: BEN PHAN LICENSE NO.: #C57550

(714) 251-4537 PHONE NO.: M.E.P ENGINEER

JOSEPH, ZHIQIANG ZHANG LICENSE NO.:

M34617 PROJECT MANAGER CHARLES LEA PHONE NO.: (714) 715-5613

CIVIL ENGINEER

SHEA MICHAEL ANTI: KIMLEY HORN

LICENSE NO .: (909) 238-3691 PHONE NO.:

NATIONAL ACCOUNT **INFORMATION**

REFER TO SHEET A-8,

DIRECTORY OF MANUFACTURES AND SUPPLIERS

INDEX OF DRAWINGS

ARCHITECTURAL

FLOOR PLAN

EGRESS FLOOR PLAN

ROOF PLAN AND DETAILS

DIRECTORY OF MANUFACTURER

STRUCTURAL GENERAL NOTES

FOUNDATION PLAN

ROOF FRAMING PLAN

STRUCTURAL DETAILS

STRUCTURAL DETAILS

ROOF DETAILS

WALL SECTIONS

STRUCTURAL

S-2

INTERIOR DECOR

COVER SHEET AND GENERAL NOTES

PRELIMINARY METALWORK LAYOUT D2.0-D2.2 INTERIOR BUILDING ELEVATIONS

DECOR ELEVATIONS / DETAILS REFLECTED CEILING PLAN

FLOOR TILE PLAN **BUILDING FINISH LAYOUT**

WAY FINDING SCHEDULE D8.0-D8.3 DECOR SPECIFICATIONS

D8.4-D8.6 FINISH SPECIFICATIONS D9.0 VERIFICATION PLAN

EQUIPMENT

KITCHEN EQUIPMENT SUPPLIER (KES) COVER SHEET K1.0 KES EQUIPMENT PLAN

KES SCHEDULES

KES ELEVATIONS **GENERAL ARCHITECTURAL NOTES** KES NOTES AND DETAILS T-24 ACCESSIBILITY DETAILS KES HOOD DETAILS

KE1.0 KES ELECTRICAL PLAN KM1.0 KES MECHANICAL PLAN

KP1.0 KES PLUMBING PLAN

LANDLORD TENANT RESPONSIBILITY MATRIX TRASH ENCLOSURE DETAILS

T-24 ACCESSIBILITY DETAILS

DRIVE-THRU COMPONENT DETAILS

MECHANICAL

M-1.0 HVAC PLAN M-1.1 MECHANICAL ROOF PLAN

M-2.0 MECHANICAL NOTES & DETAILS

M-2.1 MECHANICAL DETAILS

M-3.0 ENERGY T-24 CALCULATION COMPLIANCE REPORTS

M-3.1 ENERGY T-24 CALCULATION COMPLIANCE REPORTS

M-4.0 HOOD PLANS & SECTIONS M-4.1 HOOD DETAILS & SCHEDULE

M-4.2 HOOD CONTROL DIAGRAM M-4.3 HOOD ANSUL SYSTEM

PLUMBING

P-1.0 SANITARY AND GREASE WASTE PLAN MISCELLANEOUS DETAILS

P-1.1 WATER & GAS PLAN **EXTERIOR ELEVATIONS**

P-1.2 PLUMBING ROOF PLAN EXTERIOR ELEVATIONS P-2.0 PLUMBING NOTES

BLDG. CROSS-SECTIONS/INTERIOR ELEV. P-2.1 PLUMBING SPECIFICATION & SCHEDULE RESTROOM/ADA PLAN & ELEVATIONS

P-2.2 PLUMBING RISER DIAGRAM REFLECTED CEILING PLAN

P-3.0 PLUMBING DETAILS REFLECTED CEILING DETAILS

ELECTRICAL

E-0.1 ELECTRICAL GENERAL NOTES

E-0.2 ELECTRICAL SITE PLAN

WALL SECTIONS E-0.3 ELECTRICAL DIAGRAM

WALL SECTIONS E-0.4 ELECTRICAL PANEL SCHEDULE WALL SECTIONS

E-0.5 MASTER CONTRACTOR PANEL STOREFRONT ELEVATIONS & DOOR SCHEDULE EFC-1 PHOTOMETRIC SITE PLAN

EFC-2 SITE LIGHT SPECIFICATION (2) AND SUPPLIERS E-1.0 LIGHTING PLAN & SCHEDULE

E-1.1 POWER PLAN

E-1.2 ELECTRICAL ROOF PLAN

E-1.3 EMERGENCY LIGHTING PHOTOMETRIC PLAN

E-2.0 TECHNOLOGY PLAN E-3.0 INTERIOR LIGHTING ENERGY T-24 CALCULATION

E-3.1 OUTDOOR LIGHTING ENERGY T-24 CALCULATION COMPLIANCE REPORTS

CODE INFORMATION

BUILDING CODE: 2019 CALIFORNIA BUILDING CODE 2019 CALIFORNIA PLUMBING CODE PLUMBING CODE: **ELECTRICAL CODE:** 2019 CALIFORNIA ELECTRICAL CODE MECHANICAL CODE: 2019 CALIFORNIA MECHANICAL CODE GAS CODE: 2019 CALIFORNIA ENERGY CODE FIRE CODE: 2019 CALIFORNIA FIRE CODE ACCESSIBILITY CODE: 2019 CALIFORNIA BUILDING CODE, CH.11

ADDITIONAL CODE: 2019 CALIFORNIA BUILDING GREEN CODE OCCUPANCY GROUP:

OCCUPANT LOAD:

TYPE OF CONSTRUCTION:

FUNCTION OF SPACE OCCUPANTS

ACCESSORY AREAS, CIRCULATION, RESTROOMS, WALLS, ETC.

287 S.F. 0 OCCUPANTS

V-B (NON-SPRINKLER)

CUSTOMER SERVICE: 58 S.F. 12 OCCUPANTS (WAITING AREA) **DINING FIXED SEATS:** 555 S.F. 38 OCCUPANTS

KITCHEN: 768 S.F. 4 OCCUPANTS STORAGE/ SUPPORT 237 S.F. 1 OCCUPANTS

TOTAL: 55 OCCUPANTS

BUILDING SIZE (GROSS): 2,080 S.F. **BUILDING SIZE (NET):** 1.905 S.F. NUMBER OF STORIES **BUILDING HEIGHT:** 21'-6" (T/O TOWER)

EXIT REQUIREMENTS:

CALIFORNIA BUILDING CODE 2019 TABLE SECTION 1006

OCCUPANT LOAD > 50

ABBREVIATIONS:

A.C. A.C.T. A.F.F.	ASPHALT CONCRETE ACOUSTICAL CEILING TILE ABOVE FINISH FLOOR	MAX. MFR. MECH. MIN.	MAXIMUM MANUFACTURER MECHANICAL MINIMUM
BD.	BOARD	M.O.	MASONRY OPENING
BLDG.	BUILDING	MTD.	MOUNTED
BM.	BEAM	MTL.	METAL
B/-	BOTTOM OF		
OADD	OADDENITOV	(N)	NEW
CARP. C.B.C.	CARPENTRY CALIFORNIA BUILDING CODE	N.A. N.A.P.	NOT APPLICABLE
C.B.C.	CALIFORNIA BUILDING CODE	N.A.P. N.I.C.	NOT A PART NOT IN CONTRACT
C.C.	CENTER TO CENTER	N.T.S.	NOT TO SCALE
C.G.	CORNER GUARD	O.C.	ON CENTER
C.I.	CAST IRON	O.D.	OUTSIDE DIAMETER
C.J.	CONTROL JOINT	O.F.D.	OVER FLOW DRAIN
CLG. CLR.	CEILING CLEAR	O.H. 00SP	OVER HEAD OUT OF SEQUENCE PARKING
C.M.U.	CONCRETE MASONRY UNIT	0/-	OVER
COL.	COLUMN	.	
CONC.	CONCRETE		
C.T.	CERAMIC TILE	PART.	PARTITION
C.W.	COLD WATER	PL. PROP.	PLATE PROPERTY
		P-LAM.	PLASTIC LAMINATE
DIA.	DIAMETER	PLYWD.	PLYWOOD
DIM.	DIMENSION	PT.	PAINT
DN.	DOWN	PR. P.O.C.	PAIR POINT OF CONNECTION
D.S. DWG.	DOWN SPOUT DRAWING	P.O.C. P.S.F.	POINT OF CONNECTION POUNDS PER SQUARE FOOT
D.T.	DRIVE-THRU	P.S.I.	POUNDS PER SQUARE INCH
		QTY.	QUANTITY
E.J.	EXPANSION JOINT	R.	RISER
ELEC. ELEV.	ELECTRIC(AL) ELEVATION	RAD. R.C.P.	RADIUS REFLECTED CEILING PLAN
EQ.	EQUAL	R.D.	ROOF DRAIN
EQUIP.	EQUIPMENT	REF.	REFERENCE
(E)_	EXISTING		Bouloum
EXT.	EXTERIOR	R.I. R.O.	ROUGH IN ROUGH OPENING
F.D.	FLOOR DRAIN	RM.	ROOM
F.E.	FIRE EXTINGUISHER		
F.E.C.	FIRE EXTINGUISHER CABINET	SSBB	SELF SERVICE BEVERAGE BAR
FIXT. F.G.	FIXTURE FINISH GRADE	SCHED. SHT.	SCHEDULE SHEET
F.G. F.O.M.	FACE OF MASONRY	SIM.	SIMILAR
F.O.S.	FACE OF STUD	SPEC.	SPECIFICATION
F.P.	FIRE PROOF	SQ.	SQUARE
F.S.	FLOOR SINK	S.S.	STAINLESS STEEL
FT. FTG.	FOOT (FEET) FOOTING	S.T.C. STL.	SOUND TRANSMISSION COEFFICIENT STEEL
riu.	IOUTING	STRUCT.	STRUCTURAL
GA.	GAUGE	SUSP.	SUSPENDED
GALV.	GALVANIZED	S.V.	SHEET VINYL
	GYPSUM BOARD		
G.C.	GENERAL CONTRACTOR	T24	TITLE 24
H.B.	HOSE BIB	T.	TREAD
H.M.	HOLLOW METAL	TEMP.	TEMPORARY
HORZ.	HORIZONTAL	T.J. TYP.	TOOLED JOINT TYPICAL
HDWR. HT.	HARDWARE	T/-	TOP OF
HT. HVAC	HEIGHT HEATING VENTILATING AND		
	COOLING	U.N.O.	UNLESS NOTED OTHERWISE
H.W.	HOT WATER	V.	VENT
I.D. INT.	INSIDE DIAMETER INTERIOR	V.C.T.	VINYL COMPOSITION TILE
IINI.	INTERIOR	VERT.	VERTICAL
J-BOX	JUNCTION BOX	V.I.F.	VERIFY IN FIELD
JT.	JOINT	V.B.	VINYL BASE
LAV.	LAVATORY	W/	WITH
LTG.	LIGHTING	W.C.	WATER CLOSET
		WD.	WOOD
		W.H.	WATER BROOF
		W.P.	WATER PROOF

WROUGHT IRON

WELDED WIRE FABRIC



BURGER KING RESTAURANT

RESTAURANT FOR:

DESERT HOT SPRINGS, CA (66675 TWO BUNCH PALMS) LLC, AN ILLINOIS LIMITED LIABILITY COMPANY 1400 16TH ST, SUITE 300 OAK BROOK, IL, 60523-8854

LOCATED AT:

66675 TWO BUNCH PALMS TRAIL **DESERT HOT SPRINGS, CA, 92240**

MAY, 2021 DESIGN RELEASE

CONTRACTOR NOTES

A. IT IS THE CONTRACTOR'S RESPONSIBILITY TO REVIEW ALL DRAWINGS AND SPECIFICATIONS, INCLUDING BUT NOT LIMITED TO ARCHITECTURAL, SEATING AND DECOR, KITCHEN EQUIPMENT MECHANICALS, CIVIL, STRUCTURAL, MECHANICAL, PLUMBING, AND ELECTRICAL PRIOR TO SUBMITTING A BID. REPORT ANY

DISCREPANCIES TO ARCHITECT OR ENGINEER PRIOR TO BID. BIDDERS ARE TO VISIT THE SITE AND FAMILIARIZE THEMSELVES WITH EXISTING CONDITIONS AND SATISFY THEMSELVES AS TO THE NATURE AND SCOPE OF THE WORK. THE SUBMISSION OF A BID WILL BE EVIDENCE THAT SUCH AN EXAMINATION HAS BEEN MADE. LATER CLAIMS FOR LABOR, EQUIPMENT, OR MATERIALS REQUIRED, OR FOR ANY DIFFICULTIES ENCOUNTERED WHICH COULD HAVE BEEN FORESEEN HAD AN EXAMINATION BEEN MADE, WILL NOT BE

ALLOWED. C. IT IS THE RESPONSIBILITY OF THE CONTRACTOR TO NOTIFY THE ARCHITECT, LANDLORD, OR TENANT OF ANY DISCREPANCIES ENCOUNTERED ON THE PLANS OR IN EXISTING SITE CONDITIONS PRIOR TO SUBMISSION OF BID.

D. CONTRACTOR, DURING PRE-BID SITE VISIT, SHALL TAKE NOTICE OF ANY VISUALLY APPARENT CODE VIOLATIONS AND ALLOW IN HIS/HER BID FOR CORRECTING SUCH VIOLATIONS. E. CONTRACTORS ARE CAUTIONED TO COORDINATE ITEMS IN THEIR

SCOPE OF WORK WITH OTHER TRADES. F. THESE NOTES APPLY TO ALL SHEETS. G. ALL MANUFACTURES PRODUCTS ARE TO BE INSTALLED PER


DEFERRED SUBMITTAL

EXTERIOR TRELLIS (UNDER SEPARATE PERMIT)

FLAME GRILLING SIGNAGE (UNDER SEPARATE PERMIT) WALK-IN COOLER, FREZZER


PROJECT LOCATION MAP


MANUFACTURERS SPECIFICATIONS AND REQUIREMENTS.

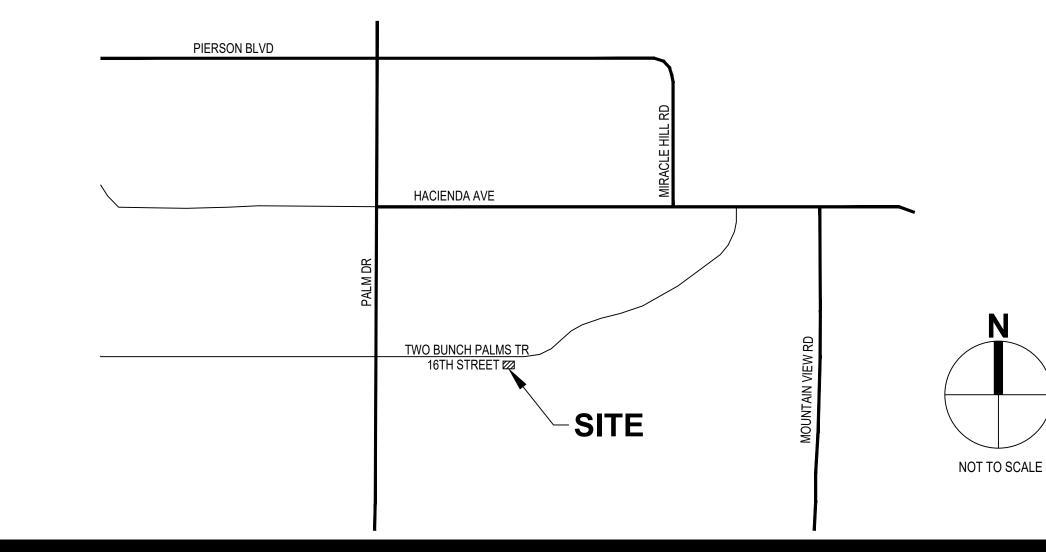



INDEX

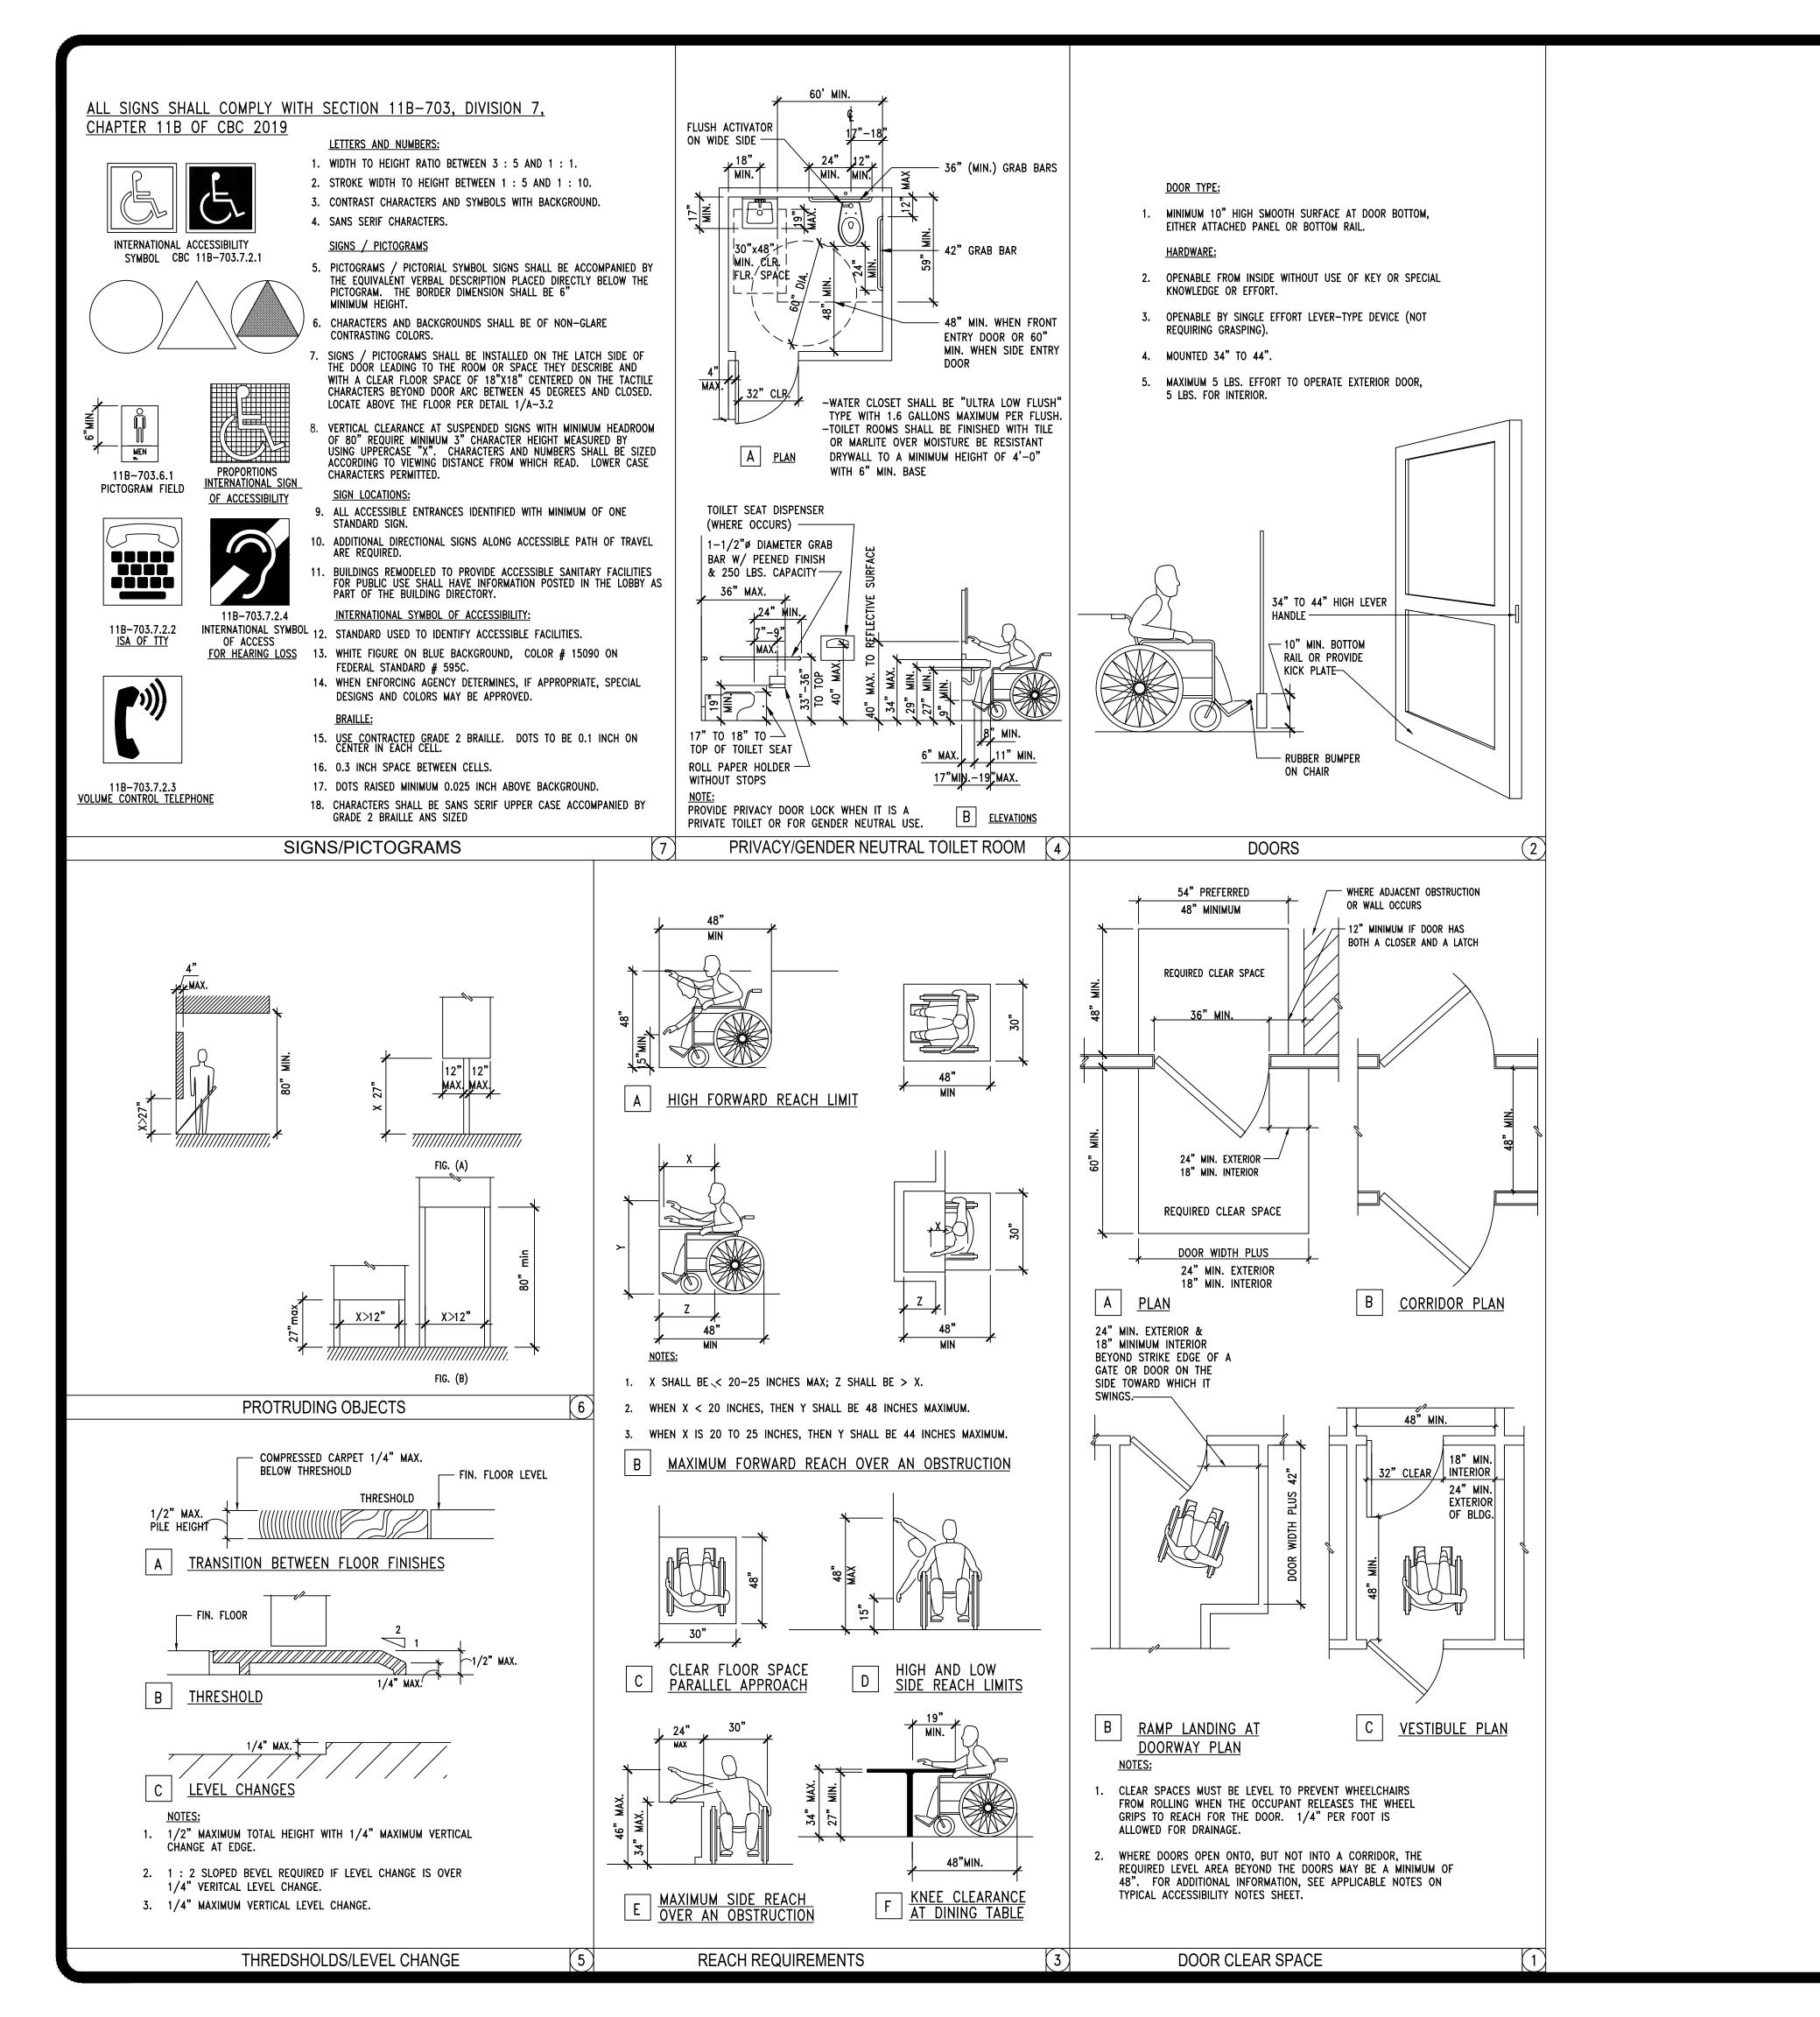

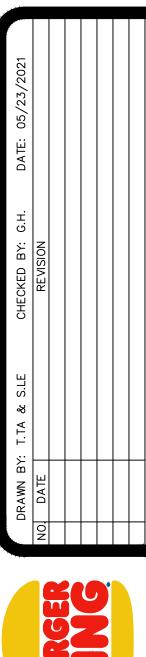



A-0.

THE 2019 CALIFORNIA BUILDING CODE CHAPTER 11B FOR ACCESSIBLE PARKING STANDARDS FOR COMMERCIAL BUILDINGS & PUBLIC ACCOMMODATIONS. FOR ADDITIONAL PARKING REGULATIONS PLEASE REFER TO THE LOCAL MUNICIPAL CODE FOR THE REQUIREMENTS.

ACCESSIBLE PARKING

1. PARKING SPACES COMPLYING WITH SECTION 11B-502 THAT SERVE A PARTICULAR BUILDING OR FACILITY SHALL BE LOCATED ON THE SHORTEST ACCESSIBLE ROUTE FROM PARKING TO AN ENTRANCE COMPLYING WITH SECTION 11B-206.4. WHERE PARKING SERVES MORE THAN ONE ACCESSIBLE ENTRANCE, PARKING SPACES COMPLYING WITH SECTION 11B-502 SHALL DISPERSED AND LOCATED ON THE SHORTEST ACCESSIBLE ROUTE TO THE ACCESSIBLE ENTRANCES. IN PARKING FACILITIES THAT DO NOT SERVE A PARTICULAR BUILDING OR FACILITY, PARKING SPACES COMPLYING WITH SECTION 11B-502 SHALL BE LOCATED ON THE SHORTEST ACCESSIBLE ROUTE TO AN ACCESSIBLE PEDESTRIAN ENTRANCE OF THE PARKING FACILITY. (PER 11B-208.3.1)

PARKING SPACE AND SIGNAGE

1. CAR AND VAN PARKING SPACES SHALL COMPLY WITH SECTION 11B-502. WHERE PARKING SPACES ARE MARKED WITH LINES, WITH MEASUREMENTS OF PARKING SPACES AND ACCESS AISLES SHALL BE MADE FROM THE CENTERLINE OF THE MARKINGS (PER 11B-501.1).

- 2. CAR AND VAN PARKING SPACES SHALL BE 18' LONG MIN.
 CAR PARKING SPACES SHALL BE 9' WIDE MIN. AND VAN
 PARKING SPACES SHALL BE 12' WIDE MINIMUM, SHALL BE MARKED TO
 DEFINED THE WIDTH, AND SHALL HAVE AN ADJACENT ACCESS AISLE
 COMPLYING WITH SECTION 11B-502.3. (PER 11B-502.2).
- 3. ACCESS AISLES SERVING PARKING SPACES SHALL COMPLY WITH SECTION 11B-502.3. ACCESS AISLES SHALL ADJOIN AN ACCESSIBLE ROUTE. TWO PARKING SPACES SHALL BE PERMITTED TO SHARE A COMMON ACCESS AISLE. (PER 11B-502.3).

WIDTH - ACCESS AISLE SERVING CAR AND VAN PARKING SPACE SHALL BE 60" WIDE MINIMUM.

LENGTH - ACCESS AISLE SHALL EXTEND THE FULL REQUIRED LENGTH OF THE PARKING SPACES THEY SERVE. (PER 11B-502.3.2)

MARKING - ACCESS AISLE SHALL BE MARKED WITH A BLUE PAINTED BORDERLINE AROUND THEIR PERIMETER. THE AREA WITHIN THE BLUE BORDERLINES SHALL BE MARKED WITH HATCHED LINES A MAX. OF 36" ON CENTER MAX. IN A COLOR CONTRASTING WITH THAT OF THE AISLE SURFACE, PREFERABLY BLUE OR WHITE. THE WORDS "NO PARKING" SHALL BE PAINTED ON THE SURFACE WITHIN ACCESS AISLE IN WHITE LETTERS A MIN. OF 12" IN HEIGHT & LOCATED TO BE VISIBLE FROM THE ADJACENT VEHICULAR WAY. ACCESS AISLE MARKINGS MAY EXTEND BEYOND THE MINIMUM REQUIRED LENGTH. (PER 11B-502.3.3).

4. PARKING SPACE IDENTIFICATION SIGNS SHALL INCLUDE THE INTERNATIONAL SYMBOL OF ACCESSIBILITY COMPLYING WITH SECTION 11B-703.7.2.1. SIGNS IDENTIFYING VAN PARKING SPACES SHALL CONTAIN ADDITIONAL LANGUAGE OR AN ADDITIONAL SIGN WITH THE DESIGNATION "VAN ACCESSIBLE." SIGNS SHALL BE 60" MIN. ABOVE FINISH FLOOR OR GROUND SURFACE MEASURED TO THE BOTTOM OF THE SIGN. FINISH AND SIZE - PARKING IDENTIFICATION SIGNS SHALL BE REFLECTORIZED WITH A MIN. AREA OF 70 SQUARE INCHES. (PER

11B-502.6.1).
MINIMUM FINE - ADDITIONAL LANGUAGE OR AN ADDITIONAL SIGN BELOW
THE INTERNATIONAL SYMBOL OF ACCESSIBILITY SHALL STATE "MINIMUM
FINE \$250." (PER 11B-520.6.2).

LOCATION - A PARING SPACE IDENTIFICATION SIGN SHALL BE VISIBLE FROM EACH PARKING SPACE. SIGNS SHALL BE PERMANENTLY POSTED EITHER IMMEDIATELY ADJACENT TO THE PARKING SPACE OR WITHIN THE PROTECTED PARKING SPACE WIDTH AT THE HEAD END OF THE PARKING SPACE. SIGNS MAY ALSO BE PERMANENTLY POSTED ON A WALL AT THE INTERIOR END OF THE PARKING SPACE. (PER 11B-502.6.3)

5. EACH ACCESSIBLE CAR AND VAN SPACE SHALL HAVE SURFACE IDENTIFICATION COMPLYING WITH EITHER SECTIONS 11B-502.6.4.1 OR 11B-502.6.4.2. (PER 11B-502.6.4.1)

THE PARKING SPACE SHALL BE MARKED WITH AN INTERNATIONAL SYMBOL OF ACCESSIBILITY (ISA) COMPLYING WITH SECTION 11B-703.7.2.1IN WHITE ON A BLUE BACK GROUND A MINIMUM 36" WIDE BY 36" HIGH. THE CENTER LINE OF ISA SHALL BE A MAXIMUM OF 6" FROM THE CENTER LINE OF THE PARKING SPACE, ITS SIDES PARALLEL TO THE LENGTH OF THE PARKING SPACE AND ITS LOWER CORNER AT, OR LOWER SIDE ALIGNED WITH, THE END OF THE PARKING SPACE LENGTH. (11B-502.6.4.1)

THE PARKING SPACE SHALL BE OUTLINED OR PAINTED BLUE AND SHALL BE MARKED WITH AN ISA COMPLYING WITH SECTION 11B-703.7.2.1 A MIN. 36" WIDE BY 36" HIGH IN WHITE OR A SUITABLE CONTRASTING COLOR. THE CENTERLINE OF THE ISA SHALL BE A MAX. OF 6" FROM THE CENTERLINE OF THE PARKING SPACE, ITS SIDES PARALLEL TO THE LENGTH OF THE PARKING SPACE AND ITS LOWER CORNER AT, OR LOWER SIDE ALIGNED WITH, THE END OF THE PARKING SPACE. (PER 11B-502.6.4.2)

6. AN ADDITIONAL SIGN SHALL BE POSTED EITHER;1) IN A CONSPICUOUS PLACE AT EACH ENTRANCE TO AN OFF-STREET PARKING FACILITY OR

2) IMMEDIATELY ADJACENT TO ON-SITE ACCESSIBLE PARKING AND VISIBLE FROM EACH PARKING SPACE. (PER 11B-502.8)
THE SIZE OF ADDITIONAL SIGN SHALL NOT BE LESS THAN 17" WIDE BY 22" HIGH. (PER 11B-502.8.1)

THE LETTER OF ADDITIONAL SIGN SHALL CLEARLY STATE IN LETTERS WITH A MINIMUM HEIGHT OF 1" THE FOLLOWING:

"UNAUTHORIZED VEHICLES PARKED IN DESIGNATED ACCESSIBLE SPACE NOT DISPLAYING DISTINGUISHING PLACARDS OR SPECIAL LICENSE PLATES ISSUED FOR PERSONS WITH DISABILITIES WILL BE TOWED AWAY AT THE OWNER'S EXPENSE. TOWED VEHICLES MAY BE RECLAIMED AT: ____ OR BY TELEPHONING ____."

BLANK SPACES SHALL BE FILLED IN WHICH APPROPRIATE INFORMATION AS A PERMANENT PART OF THE SIGN. (PER 11B-502.8.2)

VERTICAL CLEARANCE

1. PARKING SPACES, ACCESS AISLES AND VEHICULAR ROUTES SERVING THEM SHALL PROVIDE A VERTICAL CLEARANCE 98" MINIMUM. (PER 11B-502.6)

VAN PARKING SPACES

1. FOR EVERY SIX OR FRACTION OF SIX PARKING SPACES REQUIRED BY SECTION 11B-208.2 TO COMPLY WITH SECTION 11B-502, AT LEAST ONE SHALL BE A VAN PARKING SPACE COMPLYING WITH SECTION 11B-502. (PER 11B-208.2.4).

SURFACES SLOPES OF ACCESSIBLE PARKING SPACES

1. 11B-405.2 SLOPE - RAMP RUNS SHALL HAVE A RUNNING SLOPE NOT STEEPER THAN 1:12.

2. 11B.405.3 CROSS SLOPE - CROSS SLOPE OF RAMP RUNS

SHALL NOT BE STEEPER THAN 1:48
3. 11B-405.6 RISE - THE RISE OF ANY RAMP RUN SHALL BE 30" MAXIMUM.

WALKS & SIDEWALKS

GENERAL. WALKING SURFACES THAT ARE A PART OF AN ACCESSIBLE ROUTE SHALL COMPLY WITH SECTION 11B-403,11B-403.5.1 CLEAR WIDTH. EXCEPT AS PROVIDED IN SECTIONS 11B-403.5.2. AND 11B-403.5.3, THE CLEAR WIDTH OF WALKING SURFACES SHALL BE 36 INCHES (914mm). THE CLEAR WIDTH OF SIDEWALKS AND WALKS SHALL BE 48" INCHES (219mm) MINIMUM. WHEN, BECAUSE OF "RIGHT-AWAY RESTRICTIONS", NATURAL BARRIERS OR OTHER EXISTING CONDITIONS, THE ENFORCING AGENCY DETERMINES THAT COMPLIANCE WITH THE 48-INCH (219mm) CLEAR SIDEWALK WIDTH WOULD CREATE AN UNREASONABLE HARDSHIP, THE CLEAR WIDTH MAY BE REDUCED TO 36 INCHES (914mm)

11B-303.2 VERTICAL CHANGES IN THE LEVEL OF 1/4 INCH (6.4mm) HIGH MAXIMUM SHALL BE PERMITTED TO BE VERTICAL AND WITHOUT EDGE TREATMENT

11B-303.3 BEVELED.

CHANGES IN LEVEL BETWEEN 1/4 INCH (6.4mm) HIGH MINIMUM AND 1/2 INCH (12.7mm) HIGH MAXIMUM SHALL BE BEVELED WITH A SLOPE NOT STEEPER THAN 1:2

11B-403.3 SLOPE.

THE RUNNING SLOPE OF WALKING SURFACES SHALL NOT BE STEEPER THAN 1:20. THE CROSS SLOPE OF WALKING SURFACES SHALL NOT BE STEEPER THAN 1:48

PROTRUDING OBJECTS

11B-307.2 PROTRUSION LIMITS. OBJECTS WITH LEADING EDGES MORE THAN 27 INCHES (686 mm) AND NOT MORE THAN 80 INCHES (2032 mm) ABOVE THE FINISH FLOOR OR GROUND SHALL PROTRUDE 4 INCHES (102 mm) MAXIMUM HORIZONTALLY INTO THE CIRCULATION PATH.

FLOOR OR GROUND SURFACES

(11B-302.1) GENERAL. FLOOR AND GROUND SURFACES SHALL BE STABLE, FIRM, AND SLIP RESISTANT AND SHALL COMPLY WITH SECTION 11B-302


(11B-302.2) CARPET OR CARPET TILE SHALL BE SECURELY ATTACHED AND SHALL HAVE A FIRM CUSHION, PAD, OR BACKING OR NO CUSHION OR PAD. CARPET OR CARPET TILE SHALL HAVE A LEVEL LOOP, TEXTURED LOOP, LEVELCUT PILE, LEVEL CUT/UNCUT PILE TEXTURE. PILE HEIGHT SHALL BE 1/2 INCH (12.7MM) MAXIMUM. EXPOSED EDGES OR CARPET SHALL BE FASTENED TO FLOOR SURFACE AND SHALL HAVE TRIM ON THE ENTIRE LENGTH OF THE EXPOSED EDGE. CARPET EDGE TRIM SHALL COMPLY WITH SECTION 11B-303.

(11B-302.3) OPENINGS. OPENINGS IN FLOOR OR GROUND SURFACES SHALL NOT, ALLOW PASSAGE OF A SPHERE MORE THAN 1/2 INCH (12.7 MM) DIAMETER EXCEPT AS ALLOWED IN SECTION 11B-407.4.3

(11B-303.2) VERTICAL. CHANGES IN LEVEL GREATER THAN 1/4 INCH (6.4 MM) AND NOT EXCEEDING 1/2 IN HEIGHT SHALL BE BEVELED WITH A SLOPE NOT STEEPER THEN 1:2 (11B-303) & (11B-303.3)

SANITARY FACILITIES (GENERAL)

11B-703.7.2.6.3 UNISEX TOILET AND BATHING FACILITIES. UNISEX TOILET AND BATHING FACILITIES SHALL BE IDENTIFIED BY A CIRCLE, 1/4 INCH (6.4mm) THICK AND 12 INCHES (305mm) IN DIAMETER WITH A 1/4 INCH (6.4mm) THICK TRIANGLE WITH A VERTEX POINTING UPWARD SUPERIMPOSED ON THE CIRCLE AND WITHIN THE 12-INCH (305mm) DIAMETER. THE TRIANGLE SYMBOL SHALL CONTRAST WITH THE CIRCLE SYMBOL, EITHER LIGHT ON A DARK BACKGROUND OR DARK ON A LIGHT BACKGROUND. THE CIRCLE SYMBOL SHALL CONTRAST WITH THE DOOR, EITHER LIGHT ON A DARK BACKGROUND OR DARK ON A LIGHT BACKGROUND.

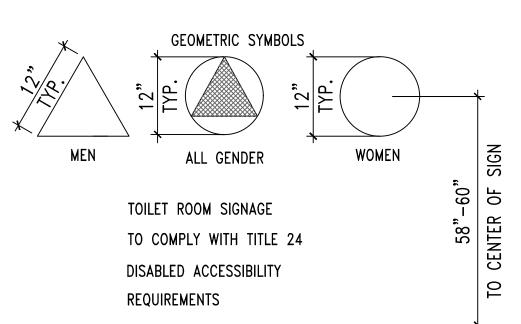

SANITARY FACILITY FIXTURES & ACCESSORIES

11B-606.5 EXPOSED PIPES AND SURFACES.
WATER SUPPLY AND DRAIN PIPES UNDER LAVATORIES
AND SINKS SHALL BE INSULATED OR OTHERWISE
CONFIGURED TO PROTECT AGAINST CONTACT. THERE
SHALL BE NO SHARP OR ABRASIVE SURFACES UNDER
LAVATORIES AND SINKS.

11B-703.7.2.6 TOILET AND BATHING FACILITIES GEOMETRIC SYMBOLS. DOORWAYS LEADING TO TOILET ROOMS AND BATHING ROOMS SHALL BE IDENTIFIED BY A GEOMETRIC SYMBOL COMPLYING WITH SECTION 11B-703.7.2.6. THE SYMBOL SHALL BE MOUNTED AT 58 INCHES (1473mm) MINIMUM AND 60 INCHES (1524mm) MAXIMUM ABOVE THE FINISH FLOOR OR GROUND SURFACE MEASURED FROM THE CENTERLINE OF THE SYMBOL. WHERE A DOOR IS PROVIDED THE SYMBOL SHALL BE MOUNTED WITHIN 1 INCH (25mm) OF THE VERTICAL CENTERLINE OF THE DOOR.

11B-703.4.1. HEIGHT ABOVE FINISH FLOOR OR GROUND. TACTILE CHARACTERS ON SIGNS SHALL BE LOCATED 48 INCHES (1219mm) MINIMUM ABOVE THE FINISH FLOOR OR GROUND SURFACE, MEASURED FROM THE BASELINE OF THE LOWEST BRAILLE CELLS AND 60 INCHES (1524mm) MAXIMUM ABOVE THE FINISH FLOOR OR GROUND SURFACE, MEASURED FROM THE BASELINE OF THE HIGHEST LINE OF RAISED CHARACTERS.

DOOR, DOORWAYS, AND GATES

1. DOORS, DOORWAYS, AND GATES THAT ARE PART OF AN
ACCESSIBLE ROUTE SHALL COMPLY WITH SECTION (11B-404.1)

- 2. MANUAL DOORS, DOORWAYS, AND MANUAL GATES INTENDED FOR USER PASSAGE SHALL COMPLY WITH SECTION 11B-504.2 (PER 11B-404.2)
- 3. DOOR OPENINGS SHALL PROVIDE A CLEAR WIDTH OF 32" MIN. CLEAR OPENINGS OF DOORWAYS WITH SWINGING DOORS SHALL BE MEASURED BETWEEN THE FACE OF THE DOOR AND THE STOP, WITH THE DOOR OPEN 90 DEGREES. OPENINGS MORE THAN 24" DEEP SHALL PROVIDE A CLEAR OPENING OF 36" MIN. THERE SHALL BE NO PROJECTION INTO THE REQUIRED CLEAR OPENING WIDTH LOWER THAN 34" ABOVE THE FINISH FLOOR OR GROUND. PROJECTIONS INTO THE CLEAR OPENING WIDTH BETWEEN 34" AND 80" ABOVE THE FINISH FLOOR OR GROUND SHALL NOT EXCEED 4". (PER 11B-404.2.3)
- 4. SWINGING DOORS AND GATES SHALL HAVE MANEUVERING CLEARANCES COMPLYING WITH TABLE 11B-404.2.4.1.
- 5. RECESSED DOORS & GATES SHALL HAVE MANEUVERING CLEARANCES FORWARD APPROACH AND SHALL BE PROVIDED WHEN ANY OBSTRUCTION WITHIN 18" OF THE LATCH SIDE AT AN INTERIOR DOORWAY, OR WITHIN 24" OF THE LATCH SIDE OF AN EXTERIOR DOORWAY, PROJECTS MORE THAN 8" BEYOND THE FACE OF THE DOOR, MEASURED PERPENDICULAR TO THE FACE OF THE DOOR OR GATE. (PER 11B-404.2.4.3)
- 6. FLOOR OR GROUND SURFACE WITHIN REQUIRED MANEUVERING CLEARANCES SHALL COMPLY WITH SECTION 11B-302. CHANGES IN LEVEL ARE NOT PERMITTED. (PER 11B-404.2.4.4)
- 7. PROVIDED THRESHOLD AT DOORWAYS SHALL BE 1/2" HIGH MAX. RAISED THRESHOLDS AND CHANGES IN LEVEL AT DOORWAYS SHALL COMPLY WITH SECTIONS11B-302 & 11B-303.(PER11B-404.2.5)

8. HANDLES, PULLS, LATCHES, LOCKS, AND OTHER OPERABLE PARTS ON DOORS AND GATES SHALL COMPLY WITH SECTION 11B-309.4. OPERABLE PARTS OF SUCH HARDWARE SHALL BE 34" MINI. AND 44" MAX. ABOVE THE FINISH FLOOR OR GROUND. WHERE SLIDING DOORS ARE IN THE FULLY OPEN POSITION, OPERATING HARDWARE SHALL BE EXPOSED AND USABLE FROM BOTH SIDES. (PER 11B-404.2.7)

9. DOOR & GATE CLOSING SPEED SHALL COMPLY WITH SECTION 11B-404.2.8.

THE DOOR & GATE CLOSERS SHALL BE ADJUSTED SO
THAT FROM AN OPEN POSITION OF 90 DEGREES, THE TIME
REQUIRED TO MOVE THE DOOR TO A POSITION OF 12
DEGREES FROM THE LARCH IS 5 SECONDS MINIMUM. (PER
11B-404.2.8.1)
DOOR & GATE SPRING HINGES SHALL BE ADJUSTED SO THA

DOOR & GATE SPRING HINGES SHALL BE ADJUSTED SO THAT FROM THE OPEN POSITION OF 70 DEGREES, THE DOOR OR GATE SHALL MOVE TO THE CLOSED POSITION IN 1.5 SECONDS MIN. (PER 11B-404.2.8.2)

- 10. THE FORCE FOR PUSHING OR PULLING OPEN A DOOR OR GATE OR OTHER THAN FIRE DOORS SHALL BE AS FOLLOWS:
 A. INTERIOR HINGED DOORS AND GATES: 5 POUNDS MAX.
 B. SLIDING OR FOLDING DOORS: 5 POUNDS MAX.
 C. REQUIRED FIRE DOORS: THE MINIMUM OPENING FORCE ALLOWABLE BY THE APPROPRIATE ADMINISTRATIVE AUTHORITY, NOT TO EXCEED 15 POUNDS.
 THE FORCES DO NOT APPLY TO THE FORCE REQUIRED TO RETRACT LATCH BOLTS OR DISENGAGE OTHER DEVICES THAT HOLD THE DOOR OR GATE IN A CLOSED POSITION. (PER 11B-404.2.9)
- 11. SWINGING DOOR AND GATE SURFACES WITHIN 10" OF THE FINISH FLOOR OR GROUND MEASURED VERTICALLY SHALL HAVE A SMOOTH SURFACE ON THE PUSH SIDE EXTENDING THE FULL WIDTH OF THE DOOR OR GATE. PARTS CREATING HORIZONTAL OR VERTICAL JOINTS IN THESE SURFACES SHALL BE WITHIN 1/16" OF THE SAME PLANE AS THE OTHER AND BE FREE OF SHARP OR ABRASIVE EDGES. CAVITIES CREATED BY ADDED KICK PLATES SHALL BE CAPPED. (PER 11B-404.2.10)

D. EXTERIOR DOORS: 5 POUNDS MAXIMUM.

- 12. AUTOMATIC DOORS & AUTOMATIC GATES SHALL COMPLY WITH SECTION 11B-404.3. FULL-POWERED AUTOMATIC DOORS SHALL COMPLY WITH ANSI/BHMA A156.10. LOW-ENERGY AND POWER- ASSISTED DOORS SHALL COMPLY WITH ANSI/BHMA A156.19. (PER 11B-404.3)
- 13. WHERE DOORS & GATES WITHOUT STANDBY POWER ARE A PART OF A MEANS OF EGRESS, THE CLEAR BREAK OUT OPENING AT SWINGING OR SLIDING DOORS AND GATES SHALL BE 32" MIN. WHEN OPERATED IN EMERGENCY MODE. (PER 11B-404.3.6)

HANDRAILS & GRAB BARS

- 1. HANDRAIL GRIPPING SURFACES WITH A CIRCULAR CROSS SECTION SHALL HAVE AN OUTSIDE DIAMETER OF 1 1/4" MIN. AND 2" MAX. (PER 11B-505.7.1) HANDRAIL GRIPPING SURFACES AND ANY SURFACES ADJACENT TO THEM SHALL BE FREE OF SHARP OR ABRASIVE ELEMENTS AND SHALL HAVE ROUNDED EDGES (PER 11B-505.8)
- 2. GRAB BARS WITH CIRCULAR CROSS SECTIONS SHALL HAVE AN OUTSIDE DIAMETER OF 1 ½" MIN. AND 2" MAX. (PER 11B-609.2.1)
 GRAB BARS AND ANY WALL OR OTHER SURFACES ADJACENT TO GRAB BARS SHALL BE FREE OF SHARP OR ABRASIVE ELEMENTS AND SHALL HAVE ROUNDED EDGES.

COMMUNICATION ELEMENTS

(PER 11B-609.5)

- 1. FIRE ALARM SYSTEMS SHALL HAVE PERMANENTLY INSTALLED AUDIBLE AND VISIBLE ALARMS COMPLYING WITH NFPA 72 & CHAPTER 9, SECTION 907.5.2.1 AND 907.5.2.3 (PER 11B-702.1)
- 2. ALL BUILDING ENTRANCES SHALL BE IDENTIFIED WITH SIGNS THAT COMPLY WITH WITH SECTION 11B-703. WHERE BOTH VISUAL AND TACTILE CHARACTERS, OR TWO SEPARATE SIGNS, ONE WITH VISUAL, AND ONE WITH TACTILE CHARACTERS. SHALL BE PROVIDED. (PER 11B-703.1)
- 3. SIGNS WITH TACTILE CHARACTERS SHALL COMPLY WITH SECTION 11B-703.4 & 11B-703.4.1
- 4. RAISED CHARACTERS SHALL BE 1/32" MIN. ABOVE THEIR BACKGROUND. 11B-703.2.1
- 5. CHARACTERS SHALL BE UPPERCASE. 11B-703.2.2
- 6. CHARACTERS SHALL BE SAN SERIF. CHARACTERS SHALL NOT BE ITALIC, OBLIQUE, SCRIPT, HIGHLY DECORATIVE, OR OF OTHER UNUSUAL FORMS. 11B-703.2.3
- 7. CHARACTERS SHALL BE SELECTED FROM FONTS WHERE THE WIDTH OF THE UPPERCASE LETTER "O" IS 60 PERCENT MIN. AND 110 PERCENT MAX. OF THE HEIGHT OF THE UPPERCASE LETTER "I". 11B-703.2.4
- 8. CHARACTERS HIGH MEASURED VERTICALLY FROM THE BASELINE OF THE CHARACTER SHALL BE 5/8" MIN. AND 2" MAX. BASED ON THE HEIGHT OF THE UPPERCASE LETTER "I". 11B-703.2.5
- 9. STROKE THICKNESS OF THE UPPERCASE LETTER "I" SHALL BE 15 PERCENT MAX. OF THE HEIGHT OF THE CHARACTER. 11B-703.2.6

- 10. CHARACTERS SPACING SHALL BE MEASURED BETWEEN THE TWO CLOSEST POINTS OF ADJACENT RAISED CHARACTERS WITHIN A MESSAGE, EXCLUDING WORD SPACES. WHERE CHARACTERS HAVE RECTANGULAR CROSS SECTIONS, SPACING BETWEEN INDIVIDUAL RAISED CHARACTERS SHALL BE 1/8" MIN. AND 4 TIMES THE RAISED CHARACTER STROKE WIDTH MAXIMUM. WHERE CHARACTERS HAVE OTHER CROSS SECTIONS, SPACING BETWEEN INDIVIDUAL RAISED CHARACTER SHALL BE 1/16" MIN. AND 4 TIMES THE RAISED CHARACTER STROKE WIDTH MAX. AT THE TOP OF THE CROSS SECTIONS. CHARACTERS SHALL BE SEPARATED FROM RAISED BORDERS AND DECORATIVE ELEMENTS 3/8" MIN. 11B-703.2.7
- 11. SPACING BETWEEN THE BASELINES OF SEPARATE LINES OF RAISED CHARACTERS WITHIN A MESSAGE SHALL BE 135% MIN. AND 170% MAX. OF THE RAISED CHARACTER HEIGHT. 11B-703.2.8
- 12. TEXT SHALL BE IN A HORIZONTAL FORMAT. 11B-703.2.9
- 13. BRAILLE SHALL BE CONTRACTED (GRADE 2) AND SHALL COMPLY WITH SECTION 11B-703.3 BRAILLE AND 11B-703.4 INSTALLATION HEIGHT AND LOCATION 11B-703.3
- 14. BRAILLE DOTS SHALL HAVE A DOMED OR ROUNDED SHAPE AND SHALL COMPLY WITH TABLE 11B-703.3.1. THE INDICATION OF AN UPPERCASE LETTER OR LETTERS SHALL ONLY BE USED BEFORE THE FIRST WORD OF SENTENCES, PROPER NOUNS AND NAMES, INDIVIDUAL LETTERS OF THE ALPHABET INITIALS, AND ACRONYMS. 11B-703.3.1
- 15. BRAILLE SHALL BE POSITIONED BELOW THE CORRESPONDING TEXT IN A HORIZONTAL FORMAT, FLUSH LEFT OR CENTERED. IF TEXT IS MULTI-LINED, BRAILLE SHALL BE PLACED BELOW THE ENTIRE TEXT. BRAILLE SHALL BE SEPARATED 3/8" MIN. AND 1/2" MAX. FROM ANY OTHER TACTILE CHARACTERS AND 3/8" MIN. FROM RAISED BORDERS AND DECORATIVE ELEMENTS. 11B-703.3.2 (SEE EXCEPTION).
- 16. SIGNS WITH TACTILE CHARACTERS SHALL COMPLY WITH 11B-703.4 INSTALLATION HEIGHT AND LOCATION. 11B-703.4
- 17. TACTILE CHARACTERS ON SIGNS SHALL BE LOCATED 48"
 MIN. ABOVE THE FINISH FLOOR OR GROUND SURFACE,
 MEASURED FROM THE BASELINE OF THE LOWEST TACTILE
 CHARACTER BRAILLE CELLS AND 60" MAX. ABOVE THE FINISH
 FLOOR OR GROUND SURFACE, MEASURED FROM THE
 BASELINE OF THE HIGHEST TACTILE CHARACTER LINE
 RAISED CHARACTERS. 11B-703.4.1 (SEE EXCEPTION)
- 18. WHERE A TACTILE SIGN IS PROVIDED AT DOOR, THE SIGN SHALL BE LOCATED ALONGSIDE THE DOOR AT THE LATCH SIDE. WHERE A TACTILE SIGN IS PROVIDED AT DOUBLE DOORS WITH ONE ACTIVE LEAF, THE SIGN SHALL BE LOCATED ON THE INACTIVE LEAF. WHERE A TACTILE SIGN IS PROVIDED AT DOUBLE DOORS WITH TWO ACTIVE LEAFS, THE SIGN SHALL BE LOCATED TO THE RIGHT OF THE RIGHT HAND DOOR. WHERE THERE IS NO WALL SPACE AT THE LATCH SIDE OF A SINGLE DOOR OR AT THE RIGHT SIDE OF DOUBLE DOORS, SIGNS SHALL BE LOCATED ON THE NEAREST ADJACENT WALL. SIGNS CONTAINING TACTILE CHARACTERS SHALL BE LOCATED SO THAT A CLEAR FLOOR SPACE OF 18" MIN. BY 18" MIN, CENTERED ON THE TACTILE CHARACTERS, IS PROVIDED BEYOND THE ARC OF ANY DOOR SWING BETWEEN THE CLOSED POSITION AND 45 DEGREE OPEN POSITION. WHERE PERMANENT IDENTIFICATION SIGNAGE IS PROVIDED FOR ROOMS AND SPACES THEY SHALL BE LOCATED ON THE APPROACH SIDE OF THE DOOR AS ONE ENTERS THE ROOM OR SPACE. SIGNS THAT IDENTIFY EXITS SHALL BE LOCATED ON THE APPROACH SIDE OF THE DOOR AS ONE ENTERS THE ROOM OR SPACE. SIGNS THAT IDENTIFY EXITS SHALL BE LOCATED ON THE APPROACH SIDE OF THE DOOR AS ONE EXITS THE ROOM OR SPACE. 11B-703.4.2 (SEE EXCEPTION)
- 19. VISUAL CHARACTERS SHALL COMPLY WITH THE FOLLOWING, EXCEPT WHERE VISUAL CHARACTERS COMPLY WITH 11B-703.2 RAISED CHARACTERS AND ARE ACCOMPANIED BY BRAILLE COMPLYING WITH 11B-703.3 BRAILLE, THEY SHALL NOT BE REQUIRED TO COMPLY WITH 11B-703.5.2 THROUGH 11B-703.5.6, 11B-703.5.8 AND 11B-703.5.9


ELECTRICAL

(11B-308.1.1) E1ECTRICAL SWITCHES. CONTROLS AND SWITCHES INTENDED TO BE USED BY THE OCCUPANT OF A ROOM OR AREAS TO CONTROL LIGHTING AND RECEPTACLE OUTLETS, APPLIANCES OR COOLING, HEATING AND VENTILATING EQUIPMENT, SHALL COMPLY WITH SECTION 11B-308 EXCEPT THE LOW REACH SHALL BE MEASURED TO THE BOTTOM OF THE OUTLET BOX AND THE HIGH REACH SHALL BE MEASURED TO THE TOP OF THE OUTLET BOX.

(11B-308.1.2) ELECTRICAL RECEPTACLE OUTLETS.
ELECTRICAL RECEPTACLE OUTLETS ON BRANCH CIRCUITS
OF 30 AMPERES OR LESS AND COMMUNICATION SYSTEM
RECEPTACLES SHALL COMPLY WITH SECTION 11B-308
EXCEPT THE LOW REACH SHALL BE MEASURED TO THE
BOTTOM OF THE OUTLET BOX AND THE HIGH REACH SHALL
BE MEASURED TO THE TOP OF THE OUTLET BOX.

OPERABLE PARTS

(11B-309.4) OPERATION. OPERABLE PARTS SHALL BE OPERABLE WITH ONE HAND AND SHALL NOT REQUIRE TIGHT GRASPING, PINCHING, OR TWISTING OF THE WRIST. THE FORCE REQUIRED TO ACTIVATE OPERABLE PARTS SHALL BE 5 POUNDS MAXIMUM.

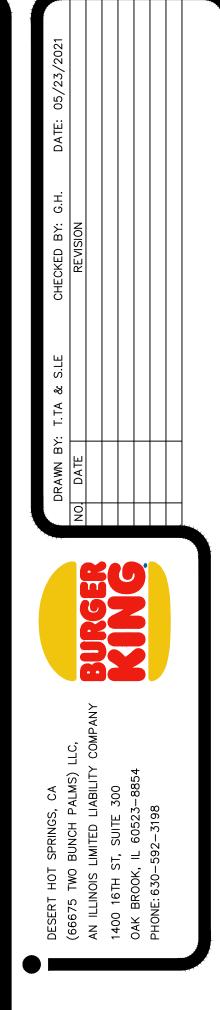


PLANNING AND DESIGN
153 E. City Place Dr. | Santa Ana | CA | 92705



RESTAURANT
S TRAIL
1 92240

RGER KING
745 TWO BUNCH PALMS

A - 0.2

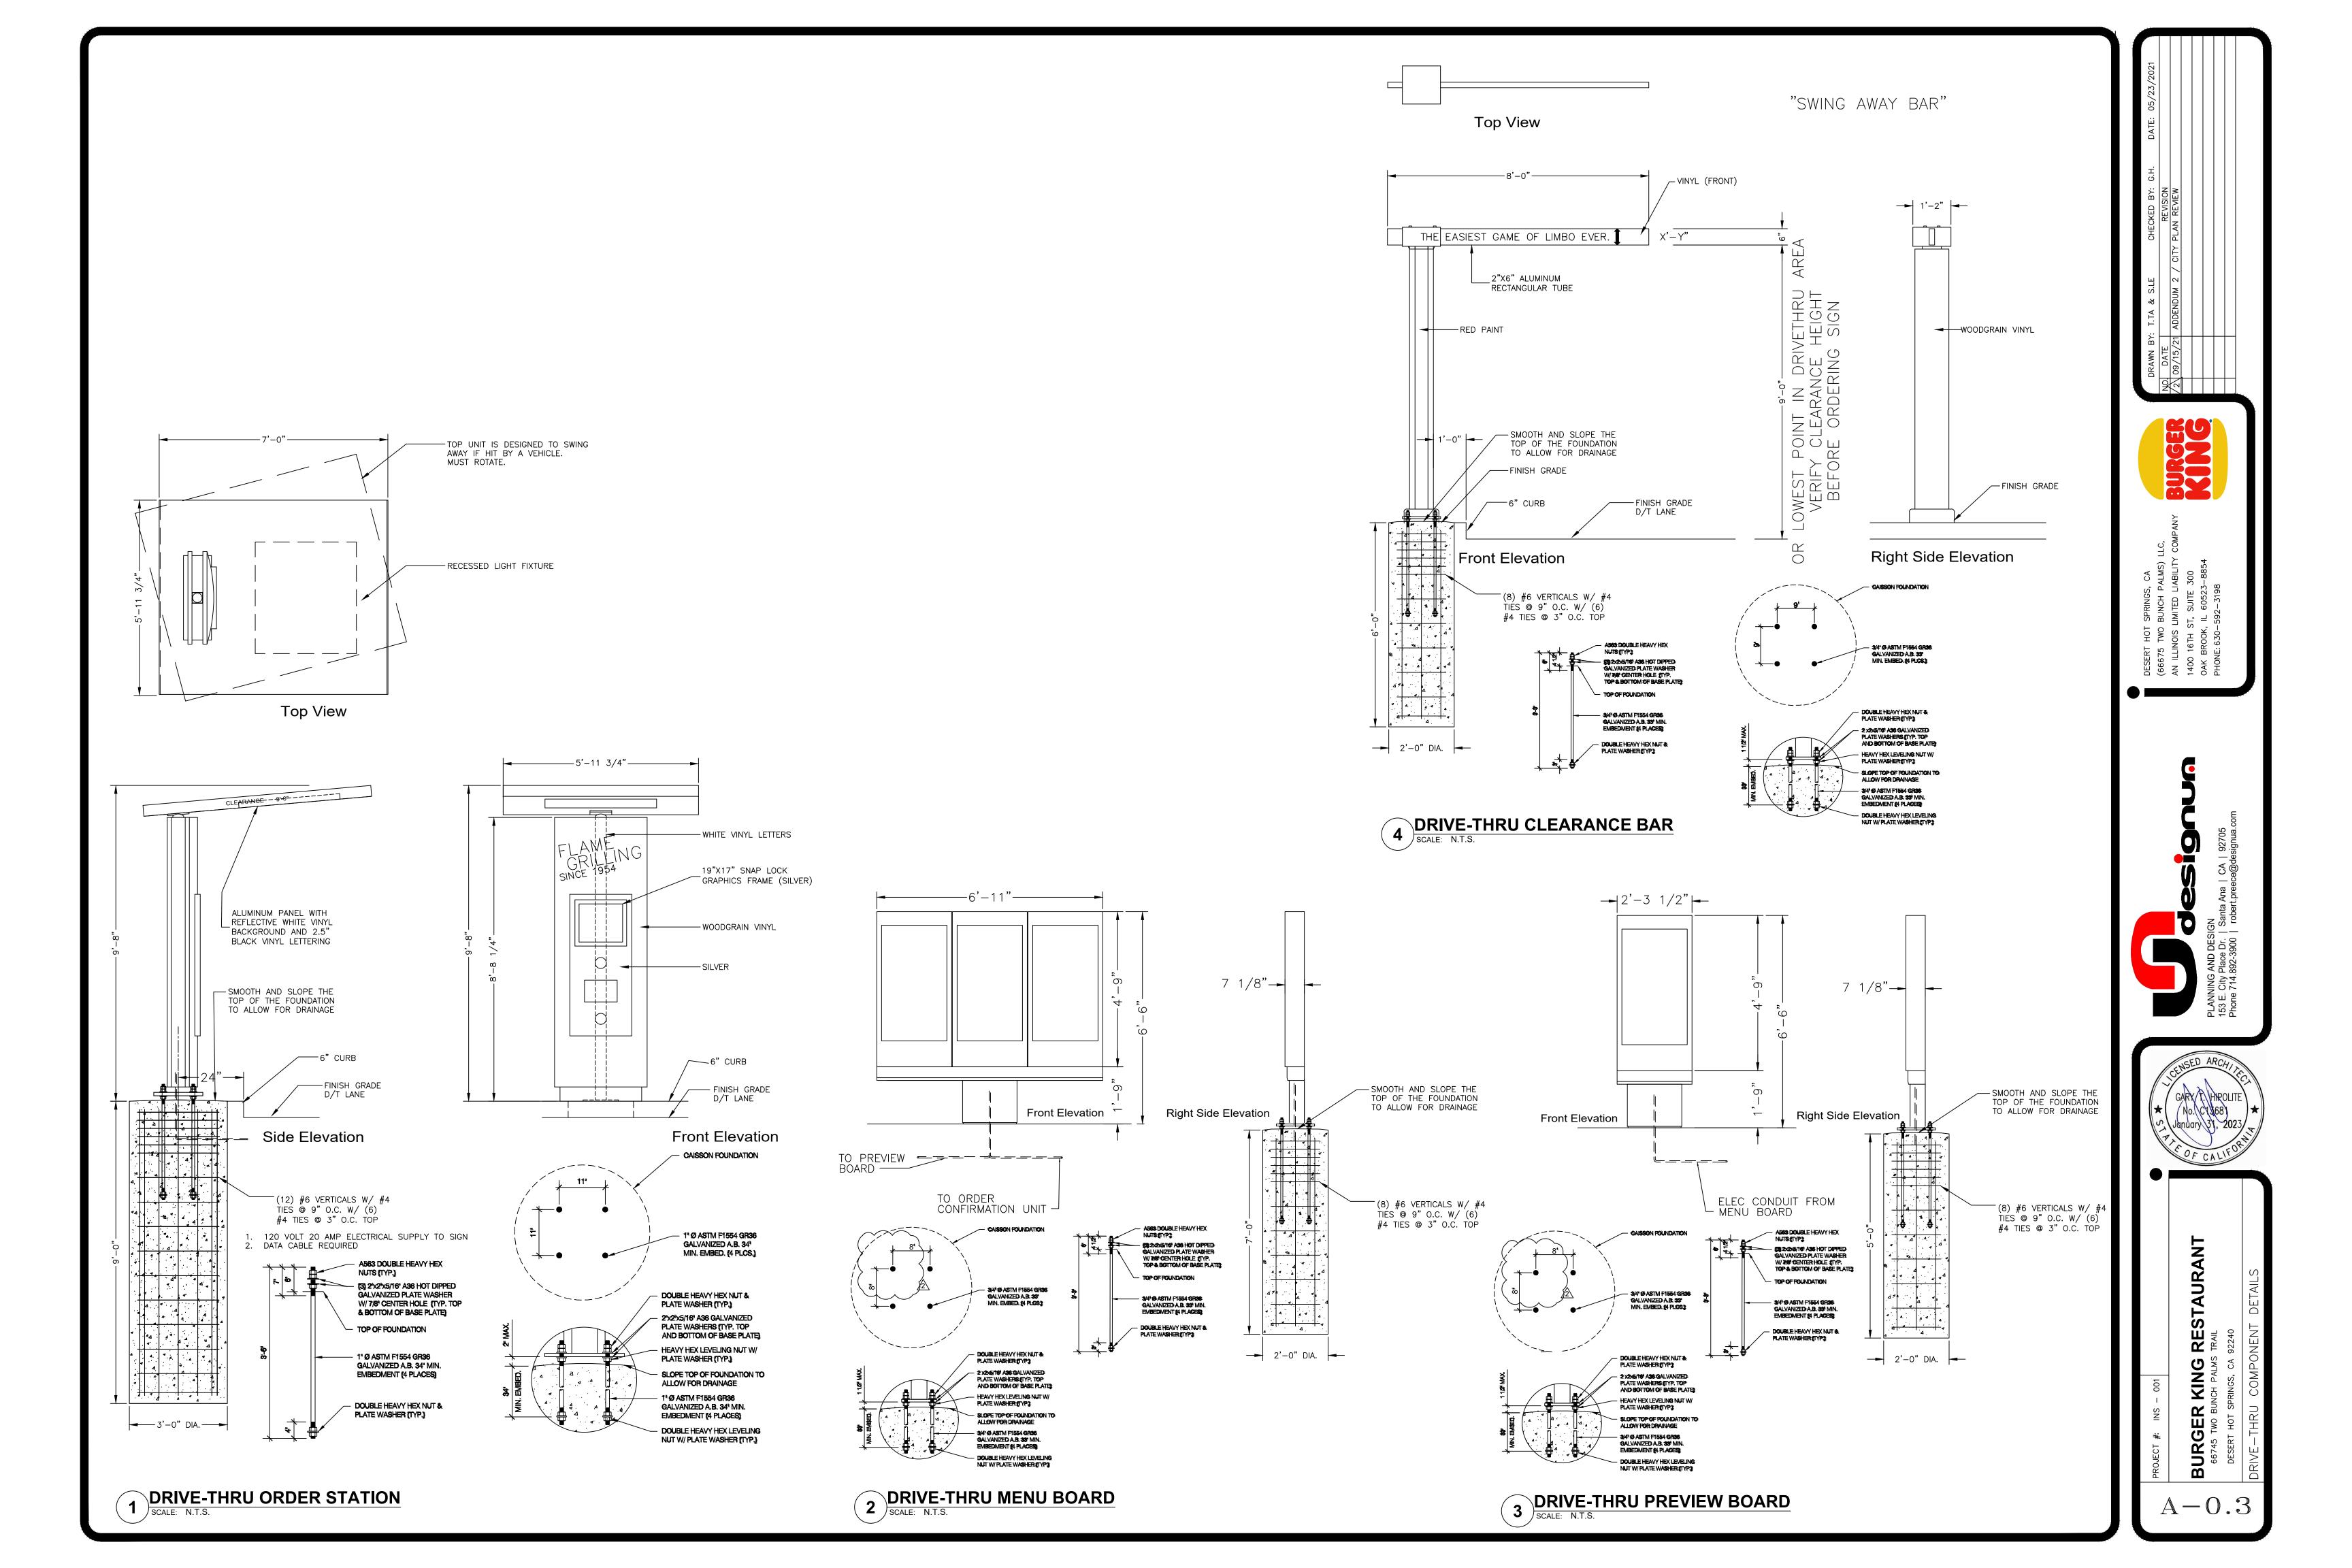


INSITE - F&N INVESTMENTS RESPONSIBILITY MATRIX

SCHEDULE OF INSTALLATION & RESPONSIBILITIES

REA	NO.	DESCRIPTION	G.C.	G.C	TENANT	TENANT	MANUFACTURERS AND
NEA	INU.	DESCRIPTION	G.C. FURNISHED		FURNISHED	INSTALLED	SUPPLIERS
JILDING	1	BUILDING SHELL (FOUNDATION, SLAB WALLS, ROOF, EXTERIOR FINISHES)	N .		1		
JILDING	2	ELECTRICAL SWITCHGEAR AND DISCONNECTS	•	•			
ILDING	3	UTILITIES SERVICES TO BUILDING	•	•			
ILDING	4	EXTERIOR STOREFRONT, GLASS, DOORS, LOCKSETS & HARDWARE	•	•			
ILDING	5	DOORS, FRAMES, HARDWARE	•	•			
JILDING	6	EXTERIOR BUILDING MOUNTED LIGHTING	•	•			
JILDING	7	INTERIOR LIGHTING AND EMERGENCY LIGHTING	•	•			
JILDING	8	EXTERIOR BUILDING SIGNAGE - SIGN AND SIGN BASE			•	•	
JILDING	9	EXTERIOR BUILDING SIGNAGE ELECTRICAL - INCLUDES POWER, CONDUITS AND J-BOXES	•	•			
UILDING	10	EXTERIOR DRIVE THRU SIGNAGE - SIGN AND SIGN BASE			•	•	
UILDING	11	EXTERIOR DRIVE THRU SIGNAGE - FOOTINGS, CONDUIT, PULL-STRINGS AND J-BOXES	•	•			
JILDING	12	EXTERIOR DIRECTIONAL SIGNAGE - SIGN AND SIGN BASE			•	•	
JILDING	13	EXTERIOR DIRECTIONAL SIGNAGE - FOOTING, CONDUIT, PULL-STRINGS AND J-BOXES	•	•			
JILDING	14	PARKING LOT LIGHTING	•	•			
JILDING	15	SITE PYLON/MONUMENT SIGNAGE - SIGN AND SIGN BASE			•	•	
JILDING	16	SITE PYLON/MONUMENT SIGNAGE - INCLUDES POWER, CONDUITS AND J-BOXES	•	•			
JILDING	17	LANDSCAPE AND PAVING (SITE WORK)	•	•			
JILDING	18	MEP VENTS THROUGH ROOF	•	•			
UILDING	19	ROOF MOUNTED SATELLITE/ANTENNA			•	•	
UILDING	20	WATER HEATER AND VENT	•	•	-	-	
JILDING	21	RESTROOM PARTITIONS AND ACCESSORIES	•	•			+
JILDING	22	RESTROOM FINISHES, WALL AND FLOOR		•			_
JILDING JILDING			•	•			+
	23	HVAC SYSTEM COMPLETE					+
JILDING ULDING	24	HVAC CONTROLS EQUIPMENT		•			+
JILDING	25	HVAC CONTROLS LOW VOLTAGE WIRING	•	•			
JILDING	26	HVAC DUCTWORK AND DIFFUSERS	•	•			
JILDING	27	HVAC DUCTMOUNTED SMOKE DETECTORS	•	•			
JILDING	28	RESTROOM PLUMBING FIXTURES	•	•			
JILDING	29	INTERIOR FLOOR FINISHES	•	•			
JILDING	30	INTERIOR WALL FINISHES	•	•			
JILDING	31	INTERIOR CEILING FINISHES	•	•			
JILDING	32	FIRE SPRINKLER (NOT ANSUL)	•	•			
JILDING	33	FIRE EXTINGUISHERS	•	•			
JILDING	34	BUILDING SIGNAGE BLOCKING	•	•			
JILDING	35	MISC. BLOCKING AS REQUIRED	•	•			
JILDING	36	EXTERIOR AWNINGS / CANOPIES			•	•	
JILDING	37	GREASE INTERCEPTOR (EXTERIOR)	•	•			
JILDING	38	GRAPHICS (AS NOTED VENDOR LIST) / MERCHANDISING PACKAGE (MOSS INDICATED HE DOES)			•	•	
STEMS AND PACKAGES	39	PHONE / POS DEVICES			•	•	
STEMS AND PACKAGES	40	PHONE / POS ROUGH-IN CONDUIT	•	•	-	_	
STEMS AND PACKAGES	41	PHONE / POS CABLING			•	•	
YSTEMS AND PACKAGES	42	DECOR ITEMS / PACKAGE			•	•	+
STEMS AND PACKAGES	43	AV SYSTEMS & TELEVISIONS DEVICES			•	•	+
STEMS AND PACKAGES	44	AV SYSTEMS & TELEVISIONS DEVICES AV SYSTEMS & TELEVISIONS ROUGH-IN	•	•			+
					•	•	+
YSTEMS AND PACKAGES	45	AV SYSTEMS & TELEVISIONS CABLING			•	_	+
YSTEMS AND PACKAGES	46	DRIVE THRU WINDOW	•	•			+
YSTEMS AND PACKAGES	47	SMOKE / CO2 DETECTORS	•	•	_	_	
YSTEMS AND PACKAGES	48	SECURITY CAMERA / MONITOR SYSTEM			•	•	_
STEMS AND PACKAGES	49	SECURITY CAMERA / MONITOR SYSTEM ROUGH-IN			•	•	
STEMS AND PACKAGES	50	MUSIC SYSTEM			•	•	
STEMS AND PACKAGES	51	MUSIC SYSTEM ROUGH IN			•	•	
STEMS AND PACKAGES	52	SERVICE LINE MILLWORK AND KNEE WALL	•	•			
STEMS AND PACKAGES	53	OFFICE AND CREW MILLWORK (INCL. WAINSCOTING, CORIAN SILLS, TRIM, CORIAN COUNTER, COUNTER KNEE WALL) •	•			
STEMS AND PACKAGES	54	FIRE ALARM SYSTEM AND PANEL	•	•			
STEMS AND PACKAGES	55	ADA SIGNAGE	•	•			
STEMS AND PACKAGES	56	MAIL RECEPTACLE	•	•			
STEMS AND PACKAGES	57	WINDOW TINTING			•	•	
STEMS AND PACKAGES	58	BLINDS			•	•	
OT USED	59						
OT USED	60						
STEMS AND PACKAGES	61	CORNER GUARDS (STAINLESS)	•	•			
STEMS AND PACKAGES	62	VINYL WALLCOVERING	•	•			
STEMS AND PACKAGES	63	FRP / WALL TILE	•	•			
STEMS AND PACKAGES	64	SAFE			•	•	
STEMS AND PACKAGES	65	DRIVE THRU LOOPS		•	•		
STEMS AND PACKAGES	66	DOORBELL / DOOR ALARM	•	•			
STEMS AND PACKAGES	67	FURNISHINGS			•	•	+
STEMS AND PACKAGES STEMS AND PACKAGES	68	EMPLOYEES LOCKERS			•	•	+
STEMS AND PACKAGES STEMS AND PACKAGES	69	SEATING PACKAGE				•	+
STEMS AND PACKAGES STEMS AND PACKAGES	70	KNOX BOX	•	•			+
			+	_	•	_	+
CHEN EQUIPMENT	71	SERVICE COUNTER SHELVING		_	_	•	+
CHEN EQUIPMENT	72	WALK IN COOLER		•			
CHEN EQUIPMENT	73	WALK IN FREEZER	-	•			1
CHEN EQUIPMENT	74	ROOF MOUNTED REFRIGERATION MOUNT	•	•			
CHEN EQUIPMENT	75	ROOF MOUNTED REFRIGERATION SYSTEM COMPLETE	•	•			
CHEN EQUIPMENT	76	ANSUL SYSTEM	•	•			
CHEN EQUIPMENT	77	GREASE DUCT	•	•			
CHEN EQUIPMENT	78	KITCHEN EQUIPMENT ELECTRICAL CONNECTIONS	•	•			
CHEN EQUIPMENT	79	STAINLESS STEEL WALL PANELS	•	•			
CHEN EQUIPMENT	80	VENT HOODS	•	•			
TCHEN EQUIPMENT	81	CUP DISPENSERS			•	•	†
TCHEN EQUIPMENT	82	3 COMPARTMENT SINK		•	•		1
CHEN EQUIPMENT	83	HAND SINKS		•	•		
TCHEN EQUIPMENT					•	•	+
	84	FREESTANDING SHELVING					+
CHEN EQUIPMENT	85	KITCHEN EQUIPMENT (NOT INCLUDING HOODS, COOLER AND ANSUL SYSTEM)				_	+
CHEN EQUIPMENT	86 87	FREESTYLE BEVERAGE EQUIPMENT LINES AND INSTALL			-	•	
CHEN EQUIPMENT	. 07	YELLOW GREASE TANK	i	i		•	1

SCHEDULE & INSTALLATION NOTES:

1) THE DEVELOPER'S CONTRACTOR SHALL PROVIDE ALL ROUGH-IN SERVICES TO MAKE ALL FINAL CONNECTIONS. THE DEVELOPER'S CONTRACTOR SHALL BE REQUIRED TO REQUEST SHOP DRAWINGS, CATALOG CUTS, SCHEDULES, ETC. FROM THE OWNER'S VENDORS AS NECESSARY TO PROPERLY COORDINATE UTILITY CONNECTIONS, PREPARATIONS, ROOF OPENINGS, AND EQUIPMENT SUPPORTS TO ACCOMMODATE ACTUAL FURNISHED ITEMS AND EQUIPMENT.

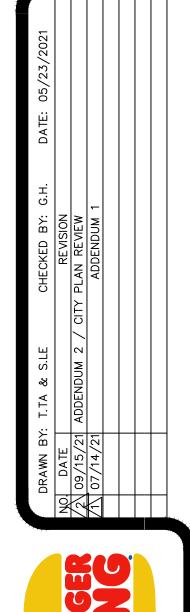



66675 TWO BUNCH PALMS) LLC,
NN ILLINOIS LIMITED LIABILITY COMPA
400 16TH ST, SUITE 300
)AK BROOK, IL 60523—8854
PHONE: 630—592—3198

PLANNING AND DESIGN 153 E. City Place Dr. | Santa Ana | CA | 92705 Phone 714.892-3900 | robert.preece@designua.com




S RESTAURANT
IS TRAIL

ECT #: INS - 001

| RGER KING F

5745 TWO BUNCH PALMS 1

 $^{\uparrow}$ A-0.4

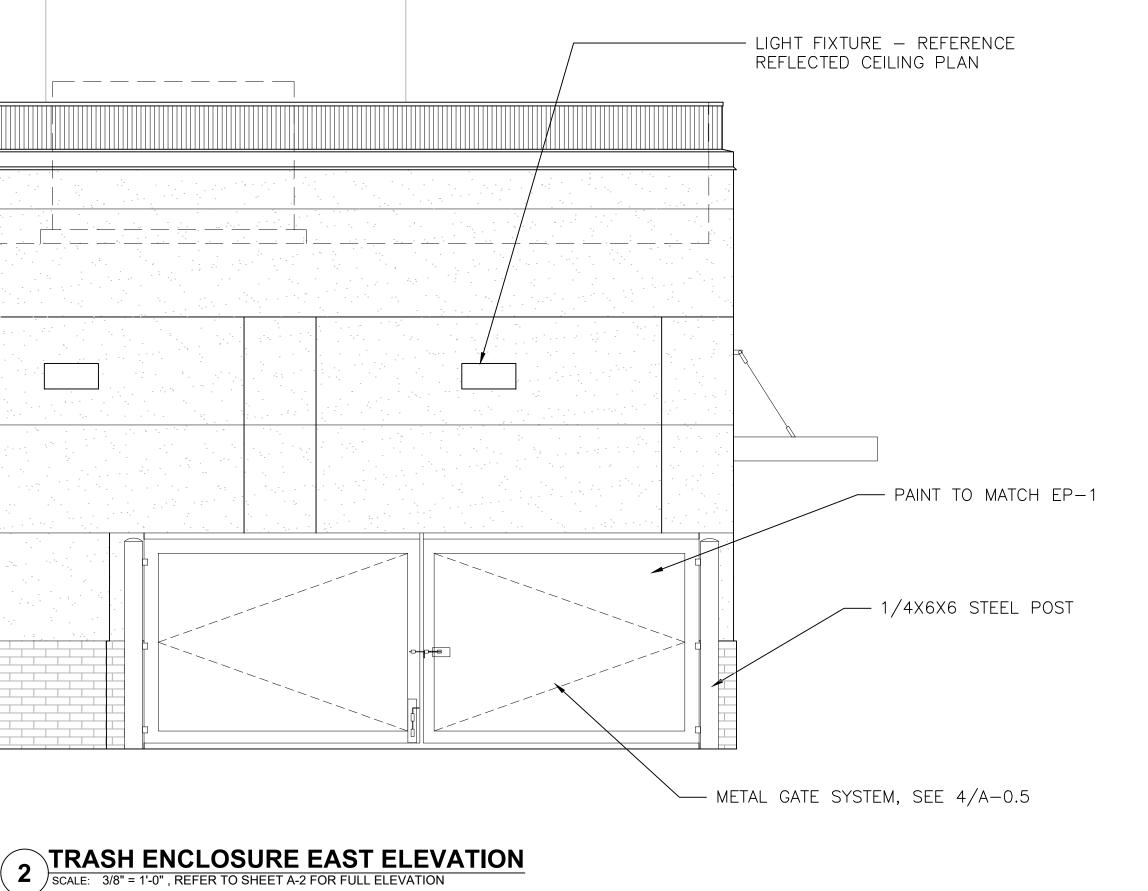

STOCK

-6" CONCRETE CURB,

TYP. STEEL GATE 6" POST FILLED WITH CONC. 5'-0"

REFER TO STRUCTURAL SHEET S-3/DETAIL 15


ABOVE SLAB, 30" EMBEDMENT


REFER TO STRUCTURAL

AND SECTION 3/A-6.4

TRASH ENCLOSURE PLAN

SCALE: 1/4" = 1'-0", REFER TO SHEET A-1 FOR FULL FLOOR PLAN

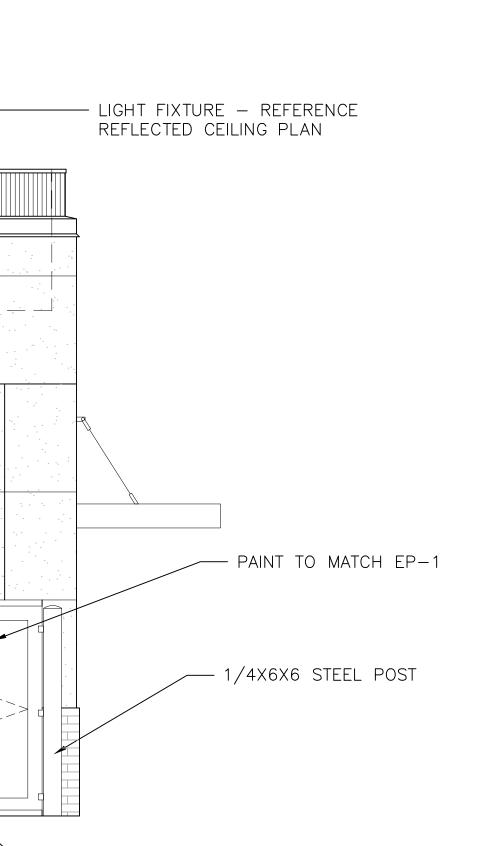

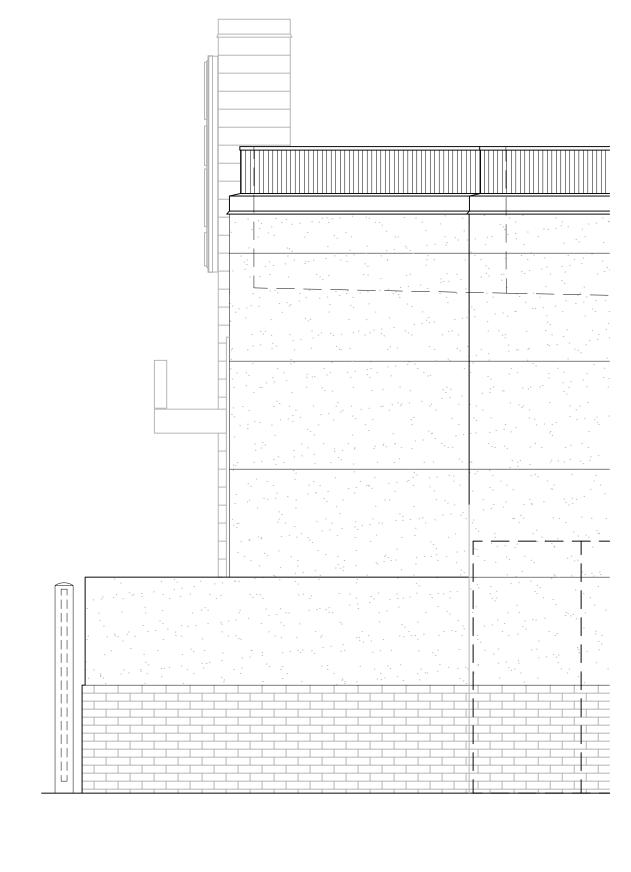



TRASH ENCLOSURE NORTH ELEVATION


SCALE: 3/8" = 1'-0", REFER TO SHEET A-2.1 FOR FULL ELEVATION


NOTES: THE INTERIOR WALL AND FLOOR OF OUTSIDE TRASH DUMPSTER ENCLOSURE


MUST BE SMOOTH AND SEALED WITH AN EPOXY SEALER

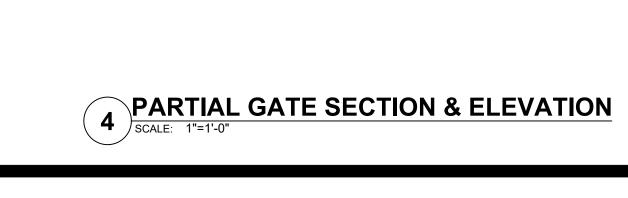


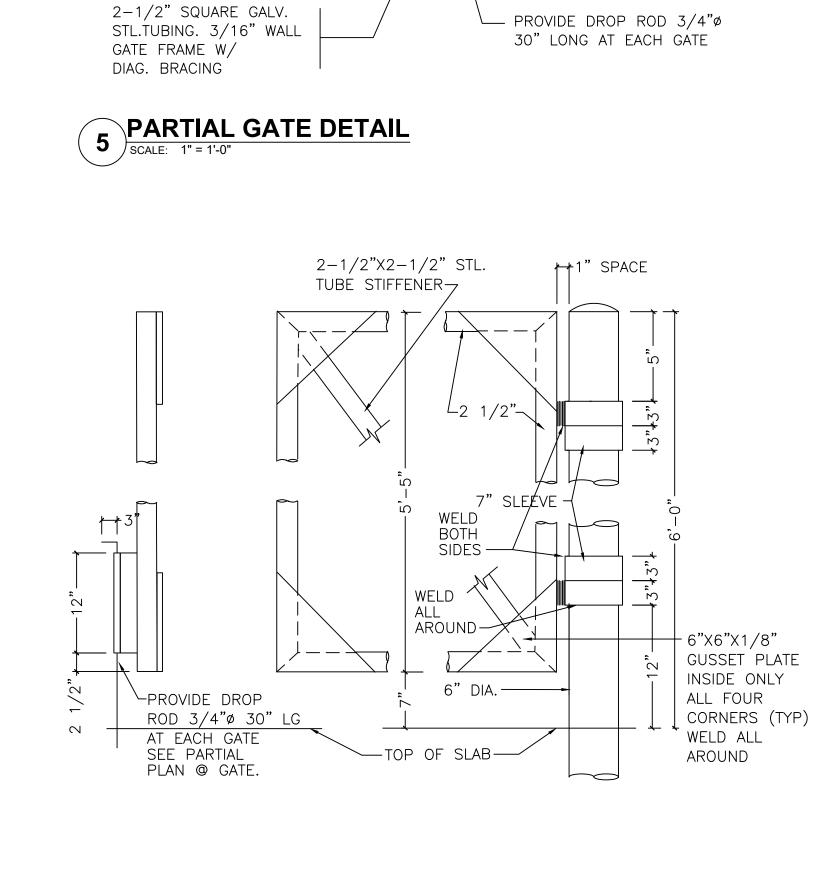

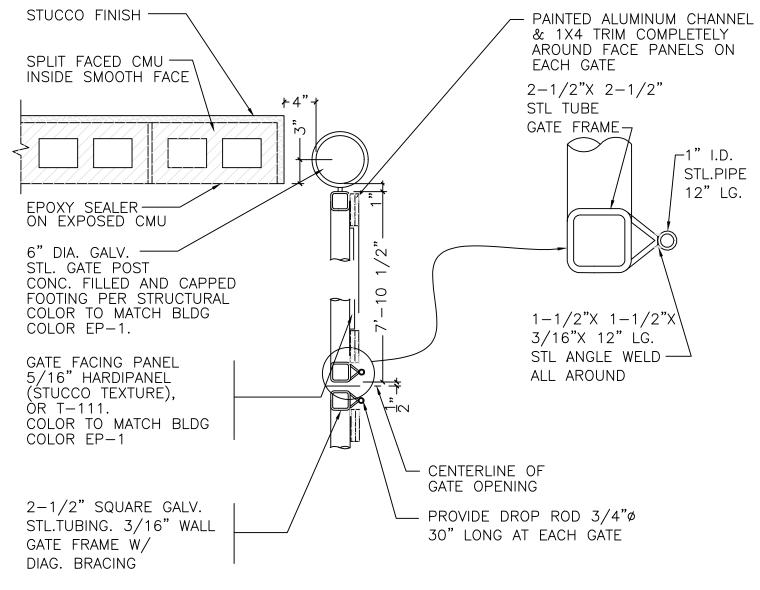

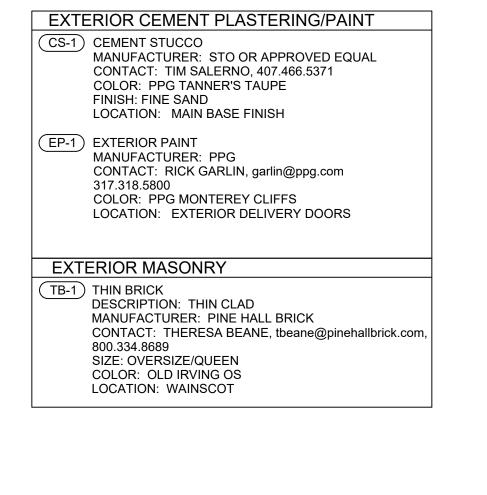


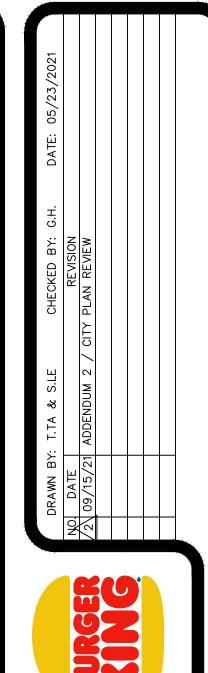

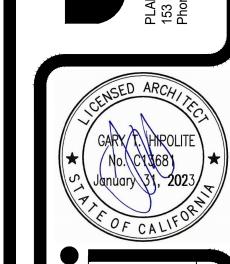

RESTAURAN

A - 0.5

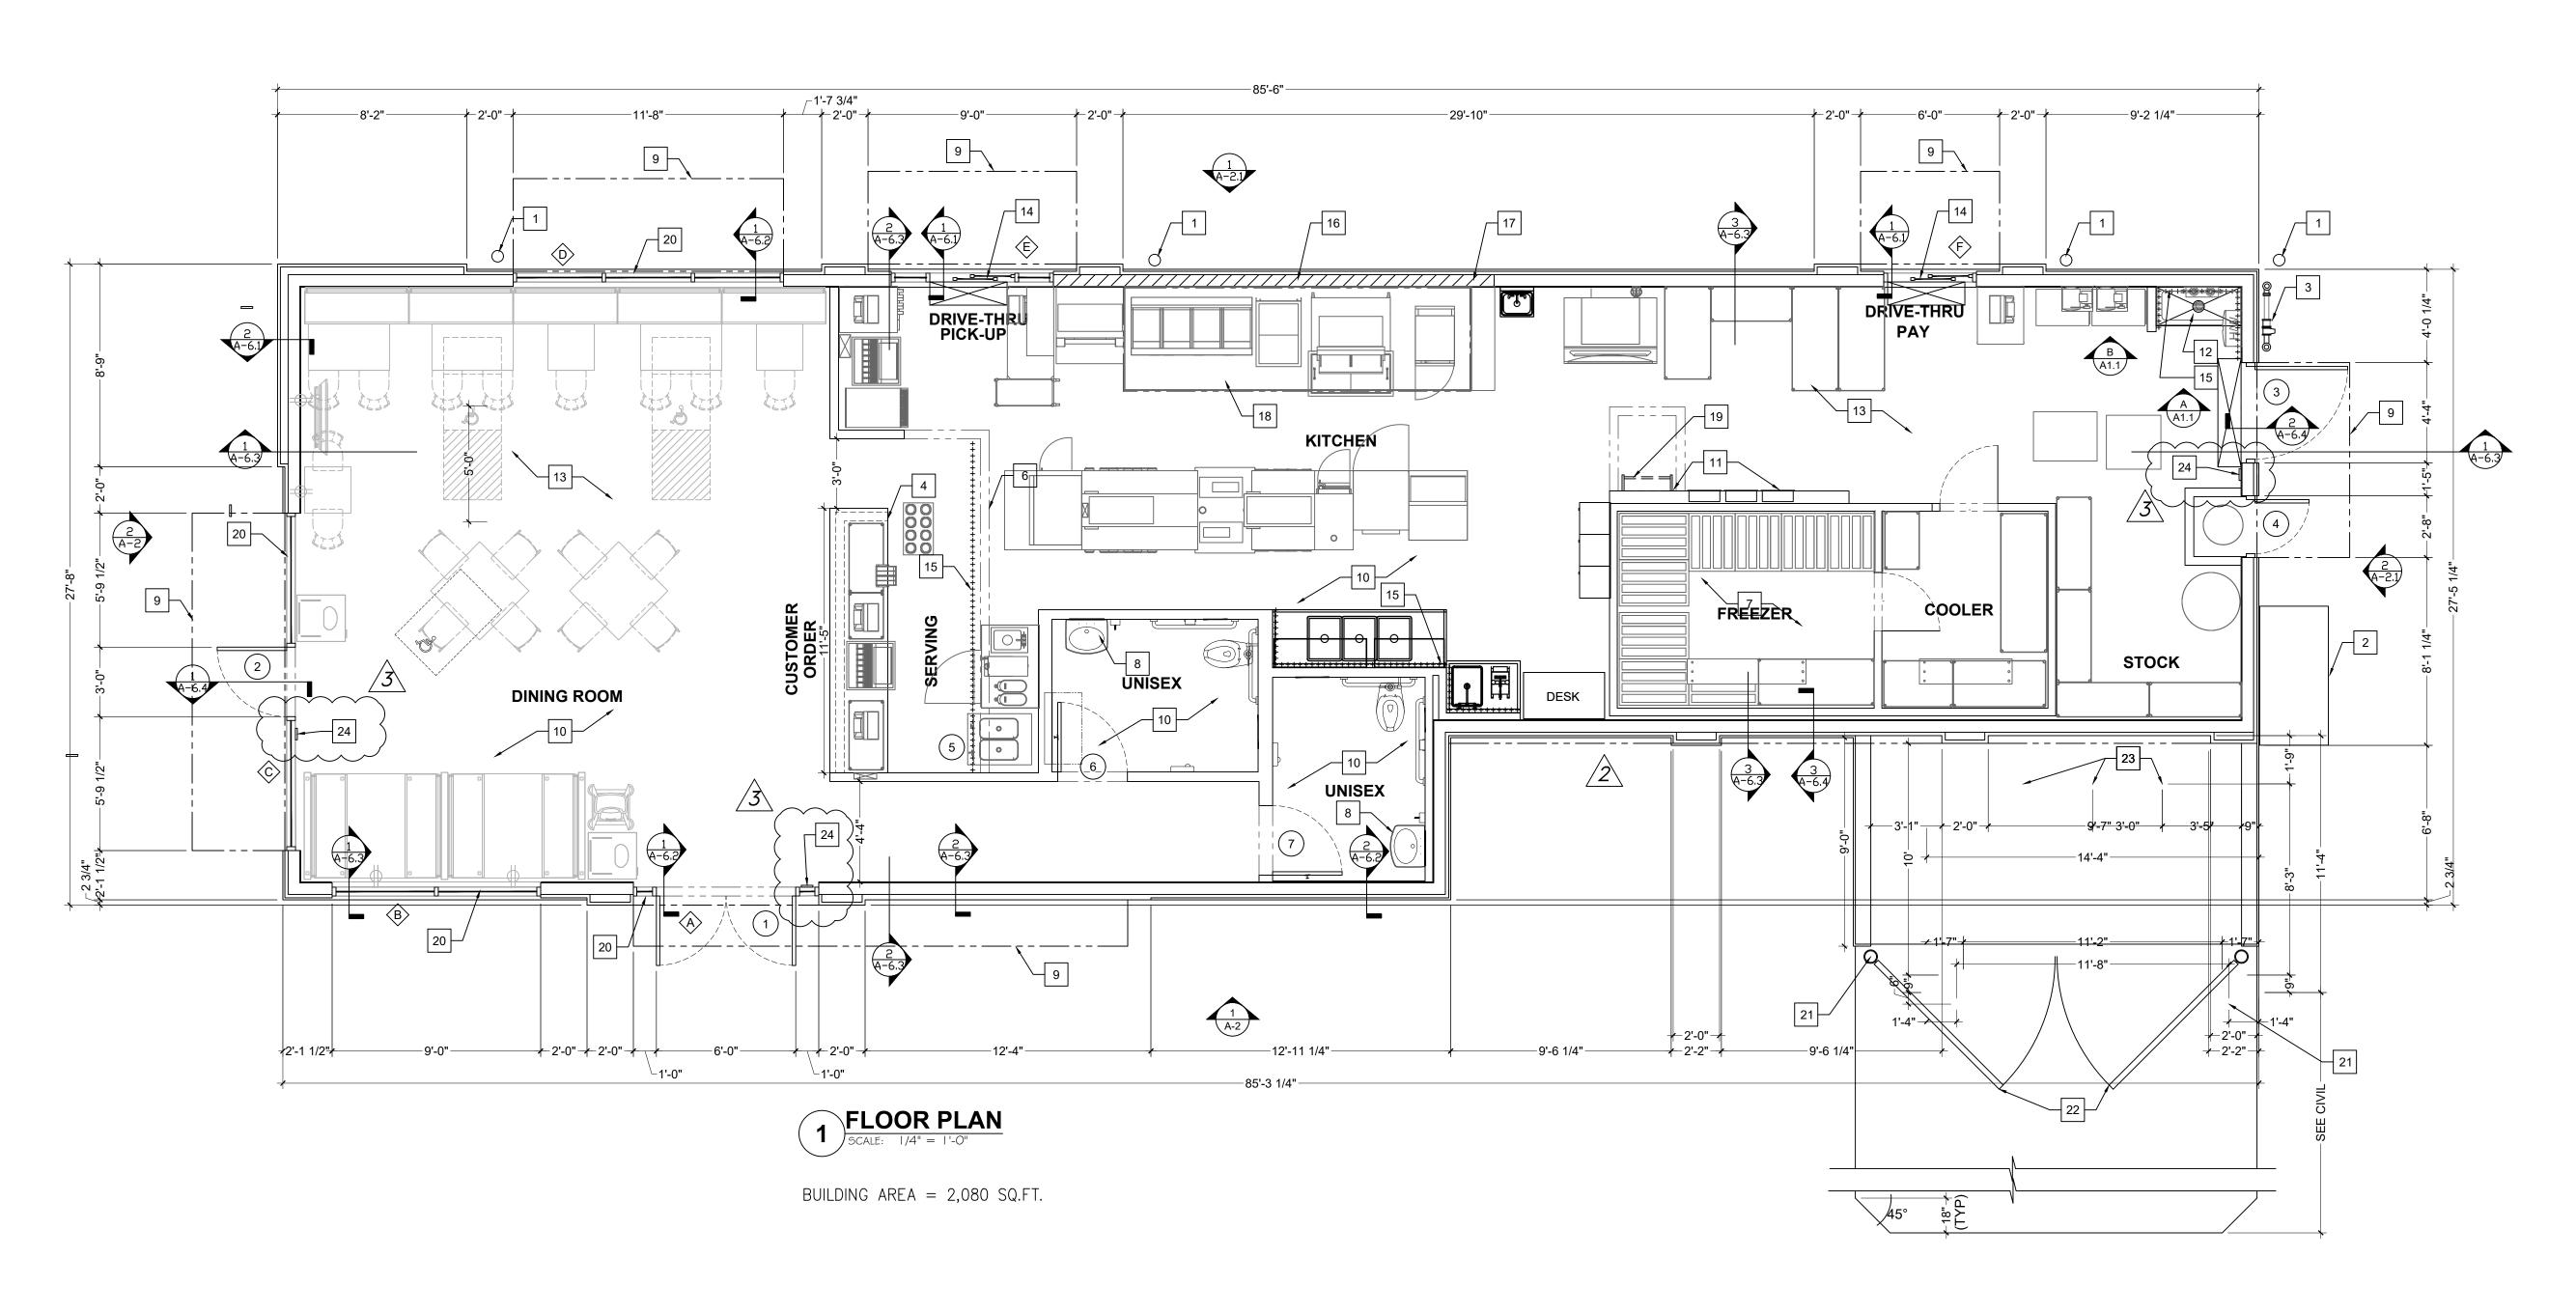

OCCUPANT LOAD CALCULATION: CALIFORNIA BUILDING CODE 2019 TABLE 1004.5 MAXIMUM FLOOR AREA ALLOWANCES PER OCCUPANT

PER S.F.

0 GROSS

AREA


SQ. FT.


OCCUPANTS

49 OCCUPANTS

287 S.F. 0 OCCUPANTS

TACTILE EXIT SIGN

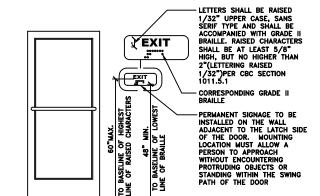

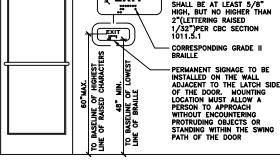



58 S.F. 12 OCCUPANTS (1/5) CUSTOMER SERVICE: (WAITING AREA) FIXED, PER DINING FIXED SEATS: 555 S.F. 32 OCCUPANTS CBC.1004.4 KITCHEN: 768 S.F. 4 OCCUPANTS STORAGE/ SUPPORT (1/300)237 S.F. 1 OCCUPANTS

EXIT REQUIREMENTS:

CALIFORNIA BUILDING CODE 2019 TABLE SECTION 1006

FUNCTION OF SPACE

ACCESSORY AREAS,

RESTROOMS, WALLS, ETC.

CIRCULATION,

TOTAL:

OCCUPANT LOAD <50

GENERAL NOTES:

- A. EXTERIOR DIMENSIONS ARE TO FACE OF EXTERIOR WALL. INTERIOR DIMENSIONS ARE TO FINISH.
 B. FIRE EXTINGUISHER, SHALL COMPLY WITH APPLICABLE BUILDING CODES
- AND LOCAL RESTRICTIONS. C. DESIGNER NOTE: WHEN UTILIZING A DIFFERENT EXTERIOR WALL CONSTRUCTION,
- HOLD INTERIOR DIMENSIONS.
- D. FOR DOOR AND WINDOW TYPES, REFER TO SHEET A-7.1.

CITY NOTES

- A. WALL FLOOR AND CEILING SHALL NOT EXCEED THE FLAME SPREAD CLASSIFICATION
- IN CBC TABLE 803.13 B. REDUCE CONSTRUCTION WASTE BY RECYCLING OR SALVAGING FOR RE-USE A MINIMUM OF 50 PERCENT OF THE NON-HAZARDOUS CONSTRUCTION AND DEMOLITION DEBRIS, OR MEET THE LOCAL CONSTRUCTION AND DEMOLITION WASTE MANAGEMENT ORDINANCE, WHICHEVER IS MORE STRINGENT.
- 1. IDENTIFIES THE MATERIALS TO BE DIVERTED FROM DISPOSAL BY EFFICIENT USAGE, RECYCLING, REUSE ON THE PROJECT OR SALVAGE FOR FUTURE USE OR
- 2. DETERMINES IF MATERIALS WILL BE SORTED ON-SITE OR MIXED
- TRANSPORTATION TO A DIVERSION FACILITY 3. IDENTIFIES THE DIVERSION FACILITY WHERE THE MATERIAL COLLECTION WILL BE
- 4. SPECIFIES THAT THE AMOUNT OF MATERIALS DIVERTED SHALL BE CALCULATED BY WEIGHT OR VOLUME, BUT NOT BY BOTH. (CGBC 5.408.2, 5.408.2.1)



○ KEYED NOTES:

- STEEL BOLLARD REFER TO SHEET S—1.
 NEMA ELECTRIC SERVICE CABINET. REFER TO ELECTRICAL DRAWINGS.
- GAS SERVICE. REFER TO PLUMBING DRAWINGS. SERVICE COUNTER PARTITION BY G.C. REFER TO DETAILS ON SHEET E-4 FOR ADDITIONAL INFORMATION. COORDINATE COUNTER TOP/FINISHES INSTALLATION RESPONSIBILITIES WITH THE INTERIOR DECOR SUPPLIER. MAXIMUM COUNTER HEIGHT = 32" A.F.F.
- CORNER GUARDS AT ALL OUTSIDE CORNERS IN BACK OF HOUSE REFER TO DETAIL #4, SHEET A-1.1. MENU BOARD BULKHEAD ABOVE. REFER TO DETAIL 1, SHEET A-6.1 INTERIOR WALK-IN BOX WITH FLOOR ON CONCRETE SLAB. VERIFY SIZE WITH MANUFACTURER.


8. PROVIDE ADDITIONAL BLOCKING IN WALLS BEHIND PLUMBING FIXTURES FOR SUPPORT OF WATER LINES

- (TYPICAL). 9. LINE OF CANOPY. REFER TO EXTERIOR ELEVATIONS. CANOPY TO BE SUPPLIED BY SIGN VENDOR
- TO BE COORDINATED. 10. SUBSTRATE PANELS:
- KITCHEN CREW RESTROOMS 5/8" USG "DUROCK" PANELS AT FINISH FLOOR TO 24" A.F.F.
- 5/8" WATER RESISTANT GYPSUM BOARD FROM 24" A.F.F. TO 6" ABOVE FINISHED CEILING. PROVIDE ALTERNATE BID OF 5/8" USG "FIBEROCK" PANELS IN LIEU OF DUROCK. DINING ROOM - CORRIDOR
- 5/8" TYPE USG "SHEETROCK" TYPE "X" GYPSUM WALL BOARD. FINISH: CORONADO PAINT - LIGHT ORANGE PEEL APPLIED WITH CORONADO AIR ASSIST TIP (Z-122KD)
- OR EQUAL 11. ELECTRICAL PANELS - RECESS ELECTRICAL CONTACTOR PANEL AND PANELS "A", "B" AND "M" IN FURRED OUT WALL ADJACENT TO EXTERIOR FRAMING. G.C. TO VERIFY PANEL SIZES PRIOR TO FURR-OUT TO INSURE ADEQUATE SPACE.
- 12. CAN WASH DUROCK SUBSTRATE ON ALL THREE SIDES, FLOOR TO CEILING. DETAILS A-1.1
- 13. TILE FLOOR (REFERENCE SPECIFICATIONS ON INTERIOR DECOR DRAWINGS.
- 14. DRIVE-THROUGH SLIDING WINDOW. REFERENCE SHEET A-7.1 15. ++++++ INDICATES 5/8" PLYWOOD BACKING ON WALLS FOR EQUIPMENT AS INDICATED ON PLAN OR SHELF SUPPORT FROM 48" A.F.F. TO 96" A.F.F., BEHIND 3-COMPARTMENT SINK AND PREP SINK AND ON
- BULKHEAD AT MENU BOARD. 16. USG 5/8" DUROCK ON STEEL STUD FRAMING BEHIND HOOD. DUROCK TO EXTEND 18" BEYOND EACH END OF HOOD.
- 17. STAINLESS STEEL PANELS BELOW AND 18" WIDE AT EACH SIDE OF HOOD SUPPLIED BY HOOD
- MANUFACTURER AND INSTALLED BY G.C. 18. TYPE I COOK LINE HOODS - REFER TO HOOD DRAWINGS AND MECHANICAL PLANS.
- 19. ROOF ACCESS LADDER REFERENCE DETAIL ON SHEET A-5. 20. ALUMINUM AND GLASS STOREFRONT, REFERENCE DETAIL.
- 21. 6" DIA. STEEL GATE POST FILLED W/ CONCRETE
- 22. 2 GATES (SEE GATE SECT. & ELEVATION) 23. TYP. GUARD POST- 6" STL PIPE FILLED WITH CONC. 5'-0" ABOVE SLAB, 30" EMBEDMENT


24. TACTILE EXIT SIGN. REFER TACTILE DETAIL/A-1 25.COUNTER TOP - REFERENCE DETAIL #6, A-1.1





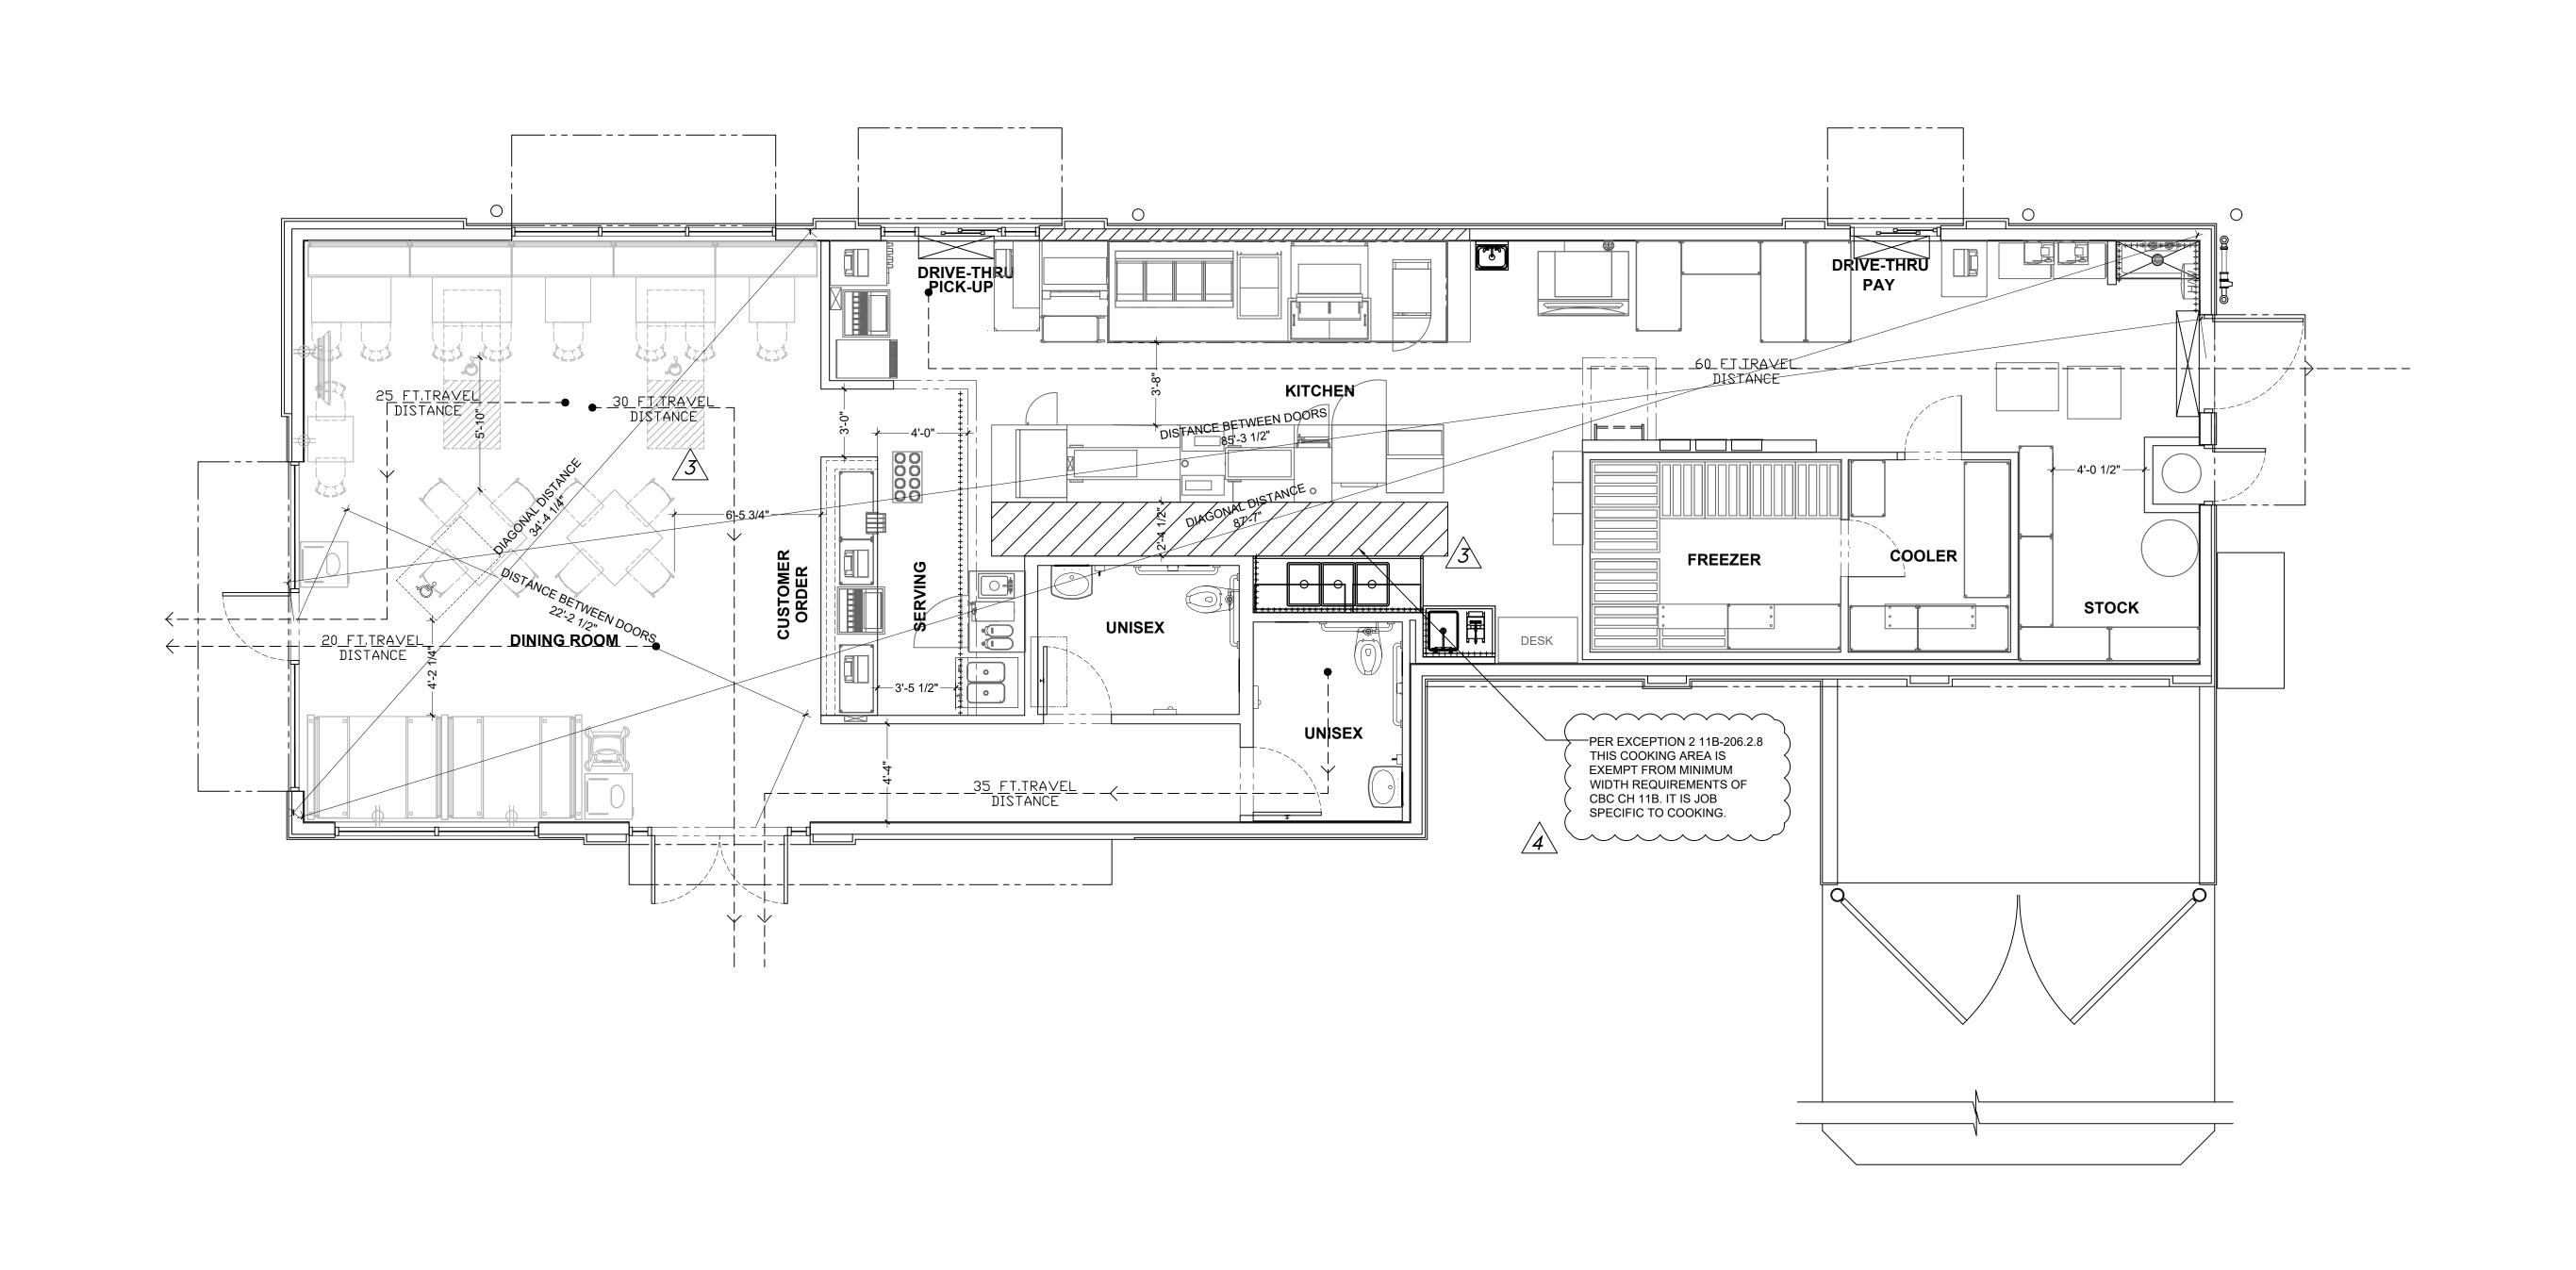




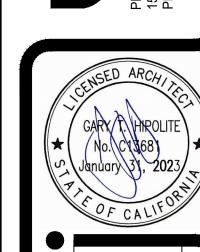





BURGER KING RESTAURANT 66745 TWO BUNCH PALMS TRAIL

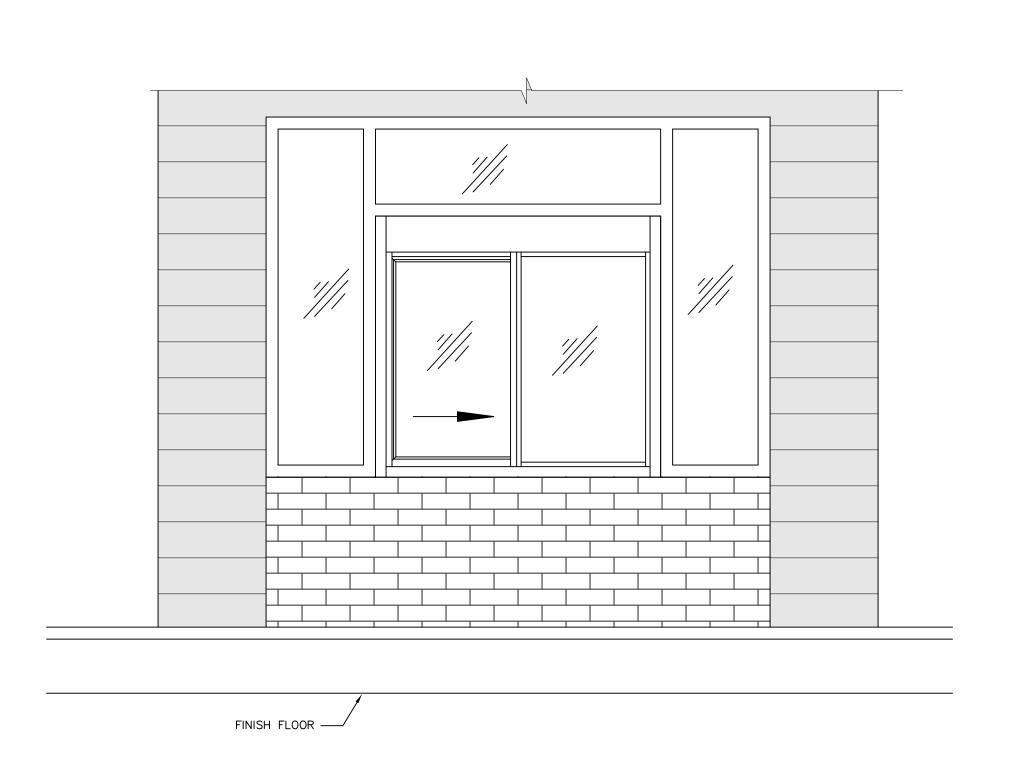



BURGER KING DRIVE THRU ELEVATION


SCALE: 3/4" = 1'-0"

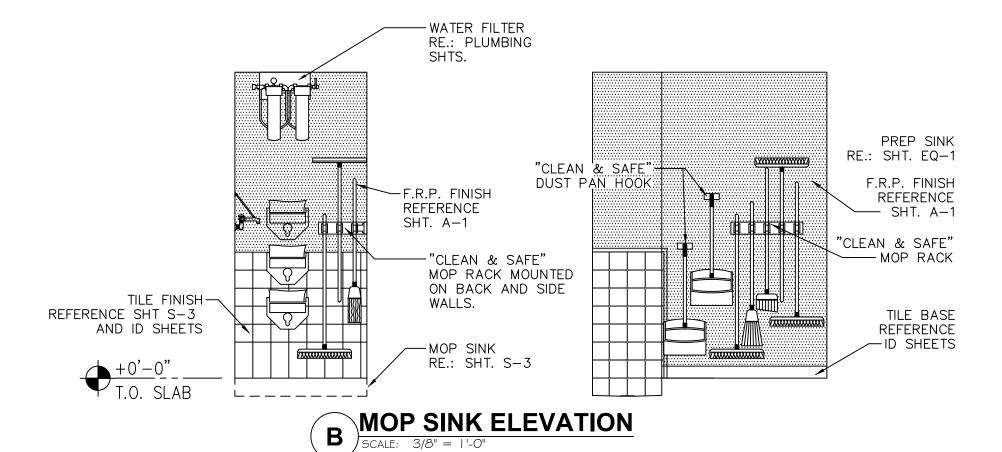


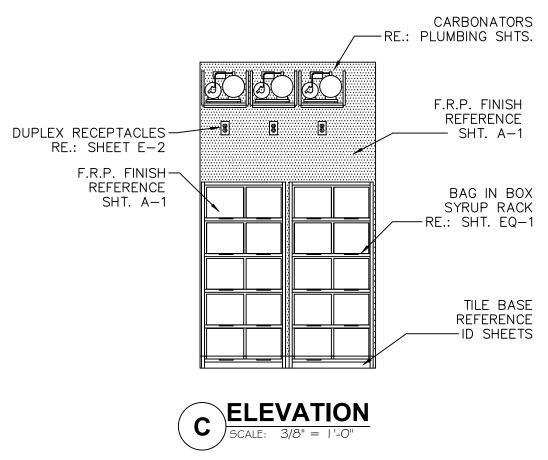


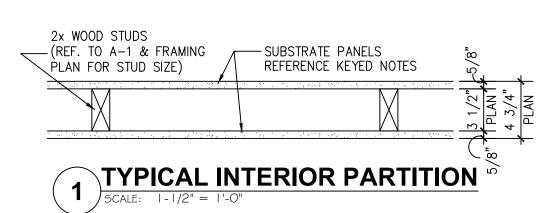


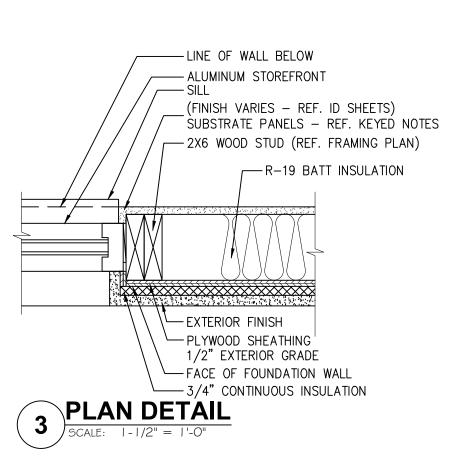


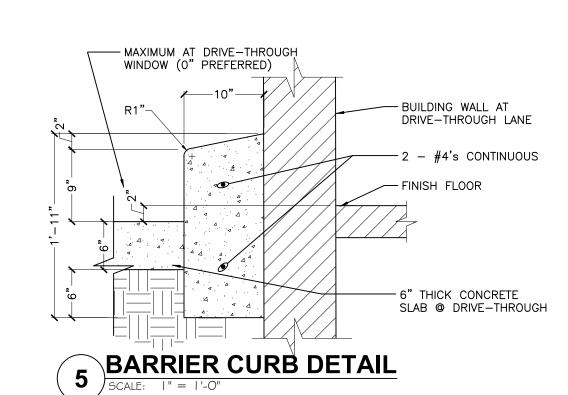


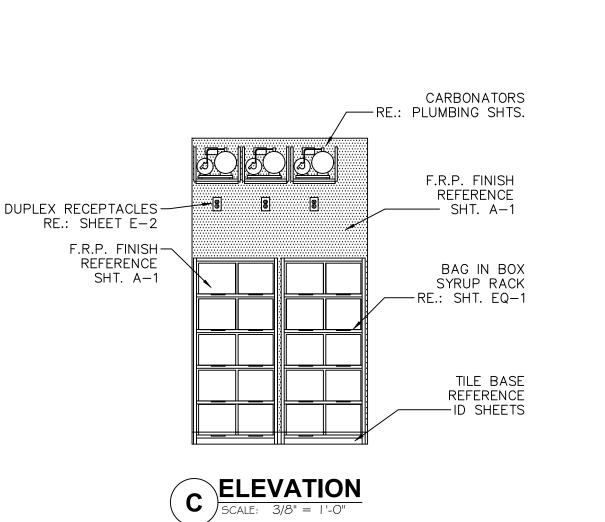

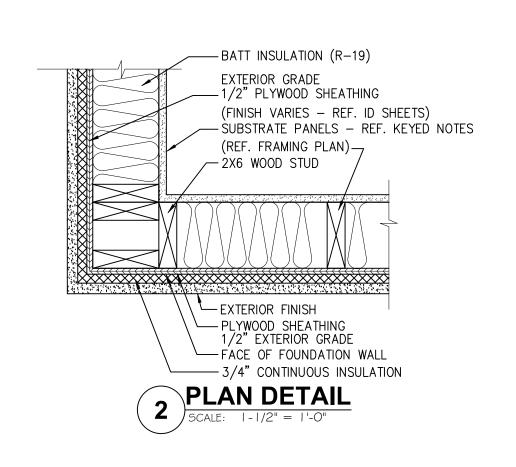


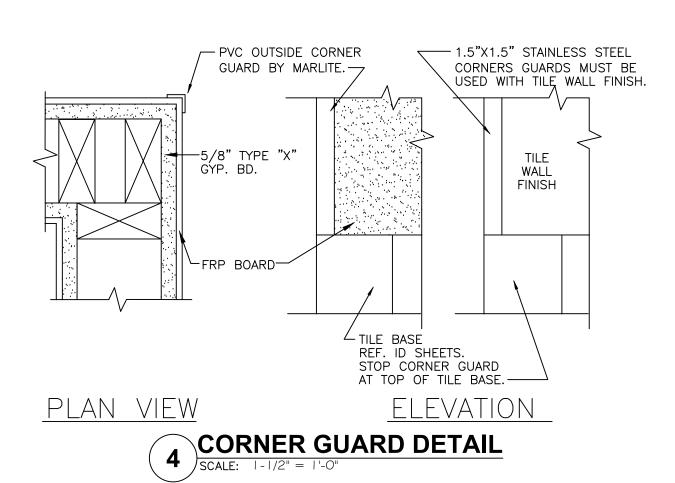


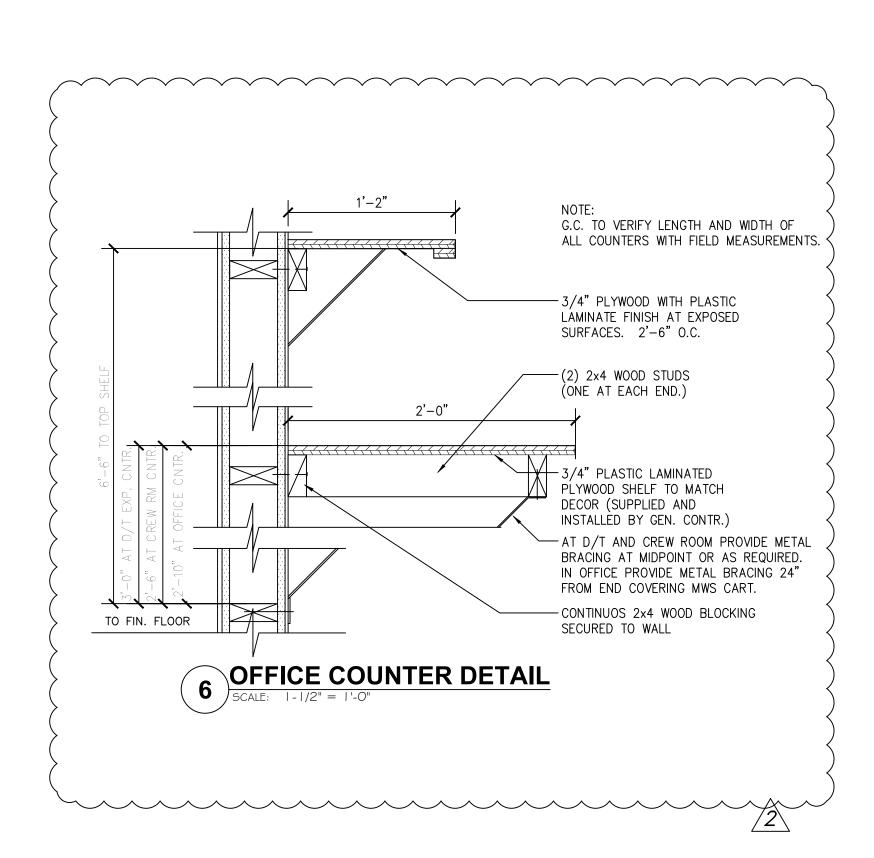


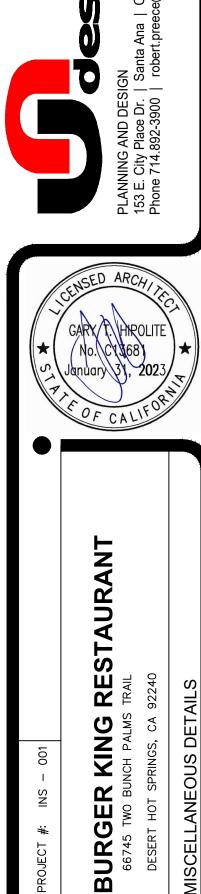

A - 1.1

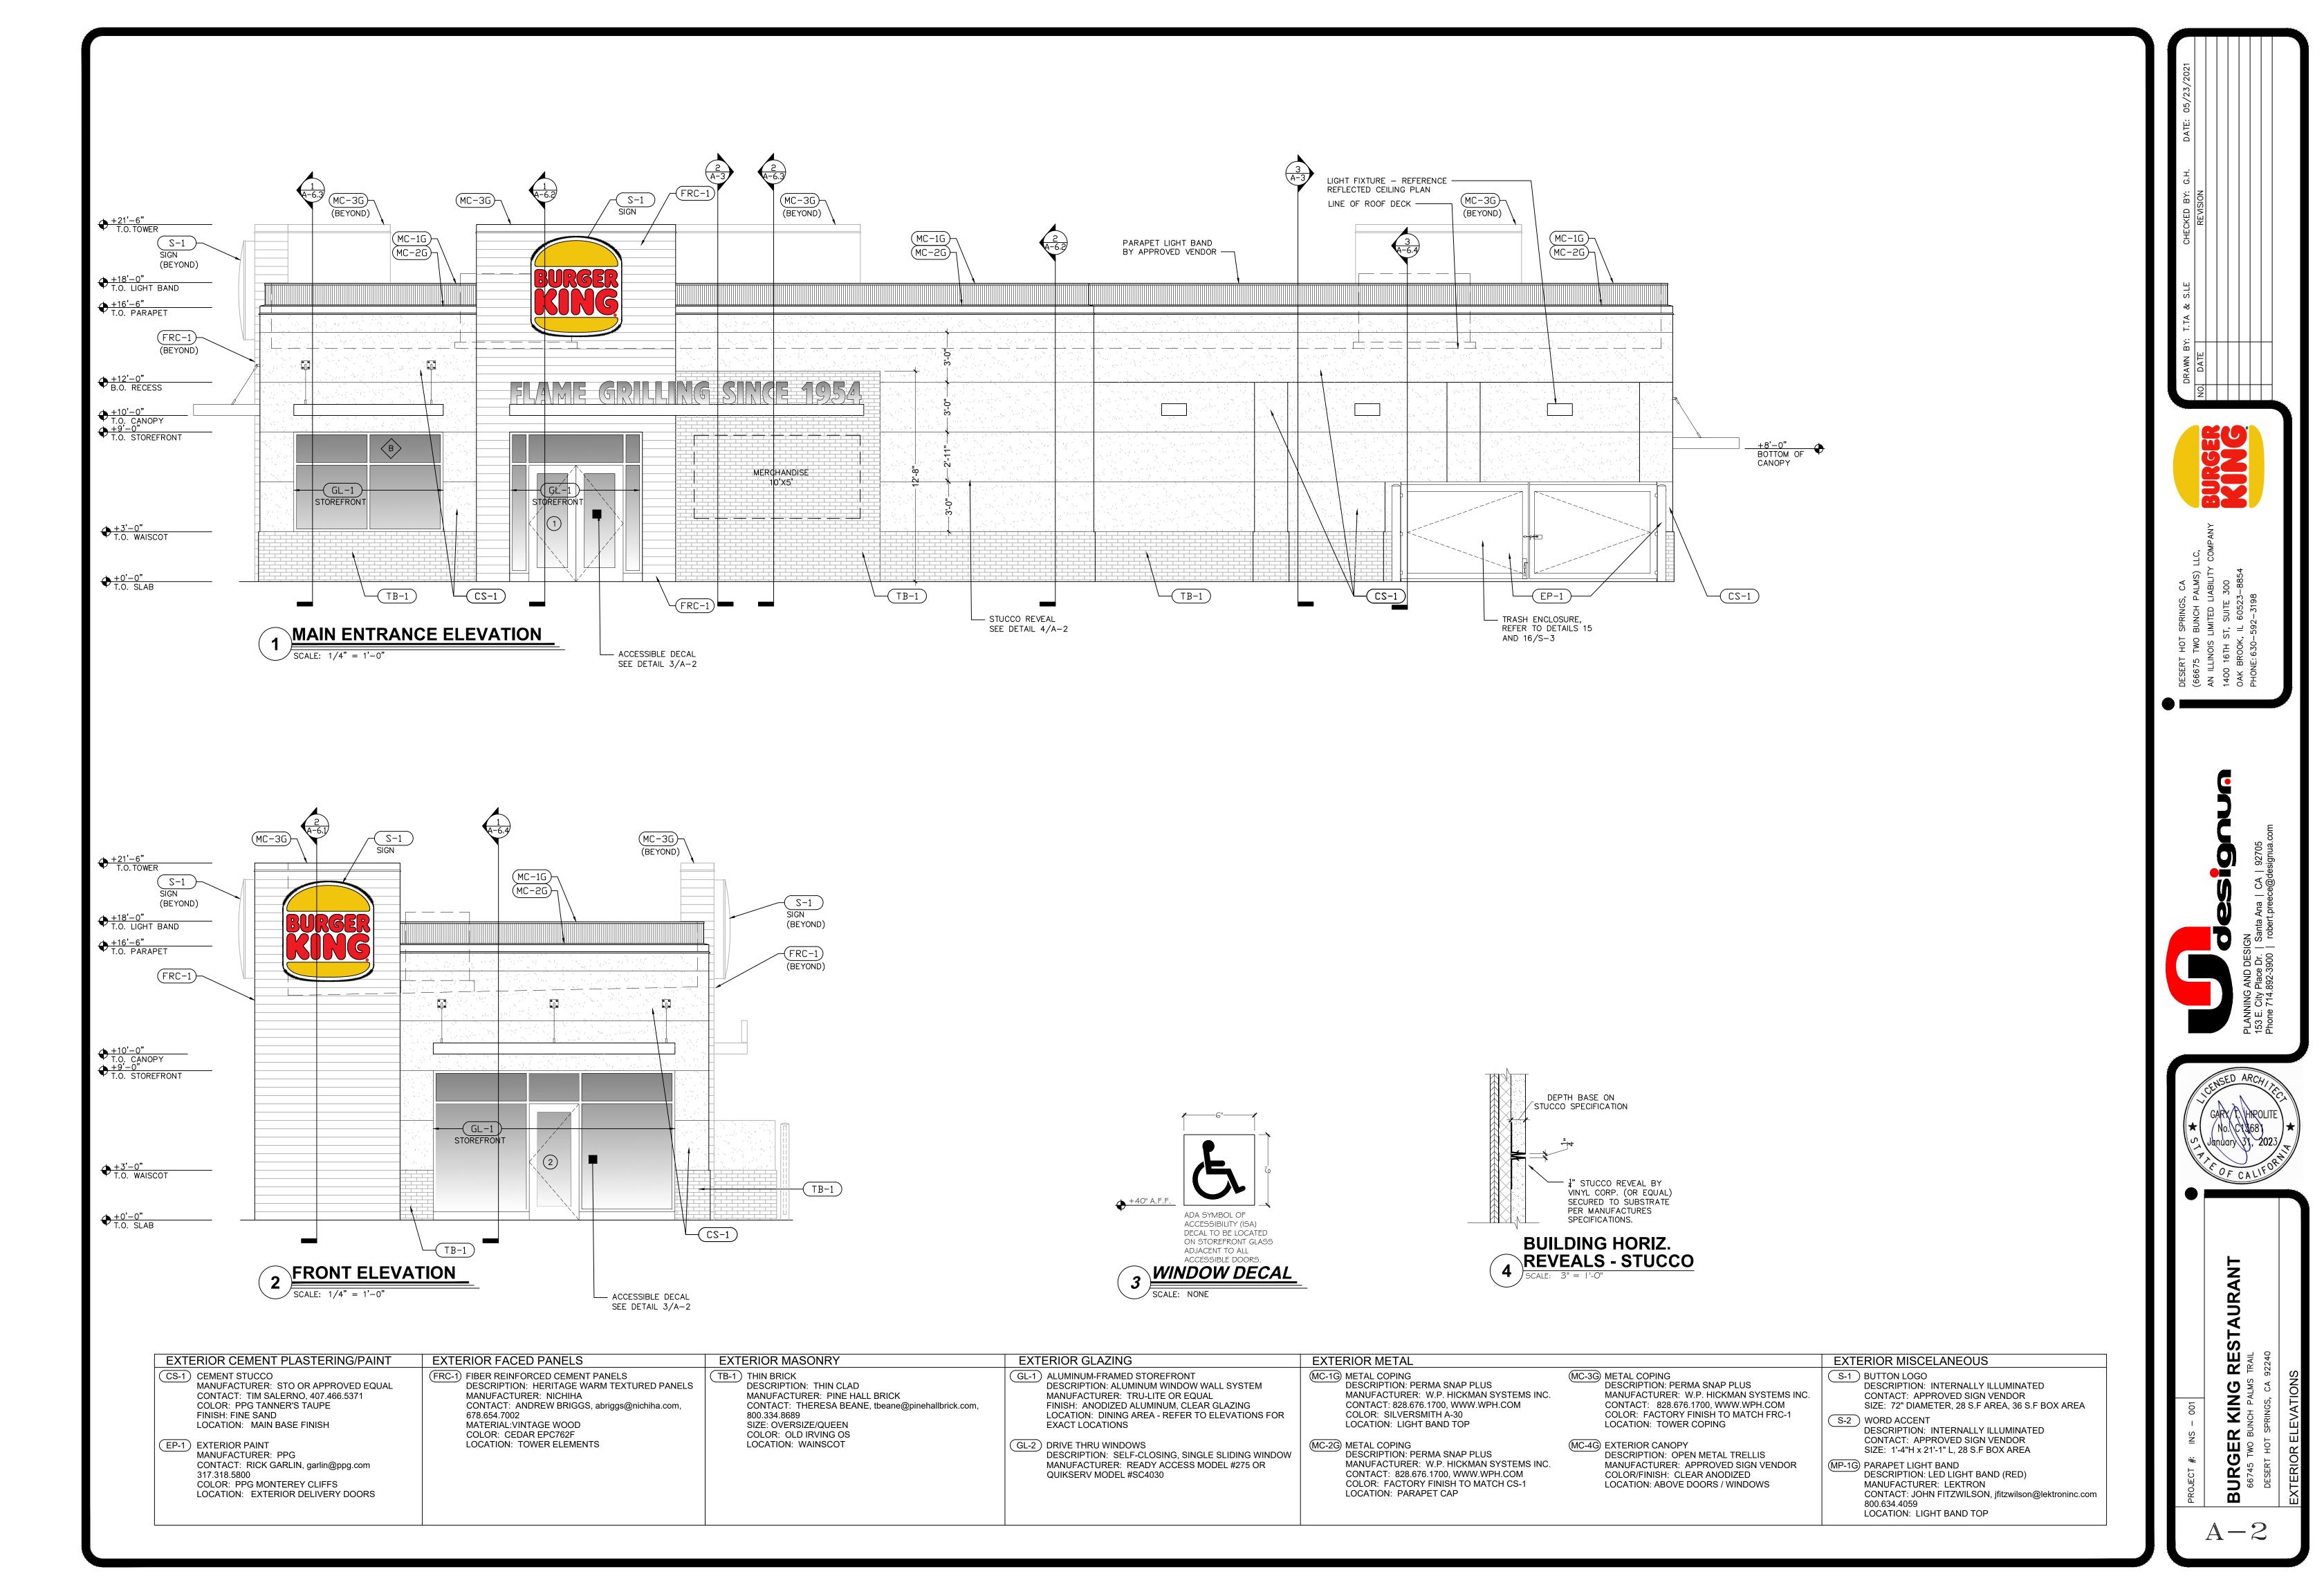

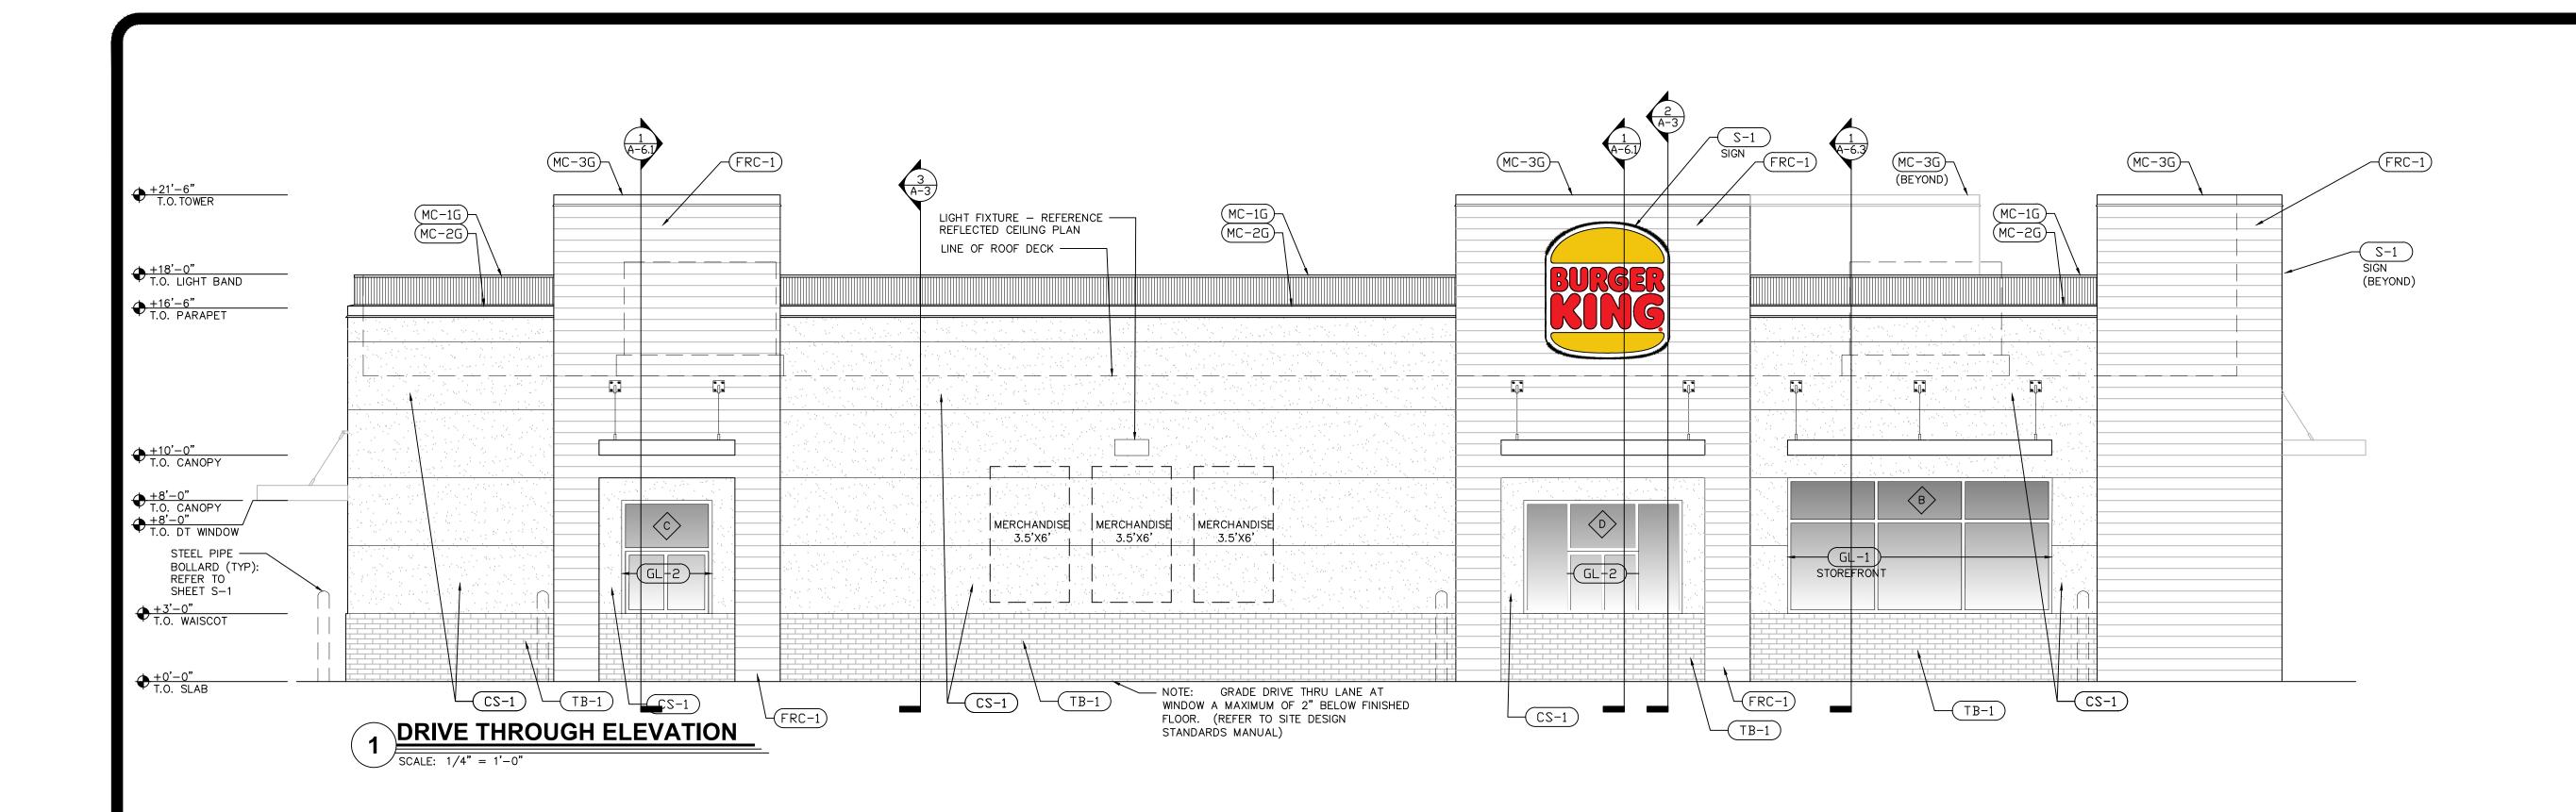

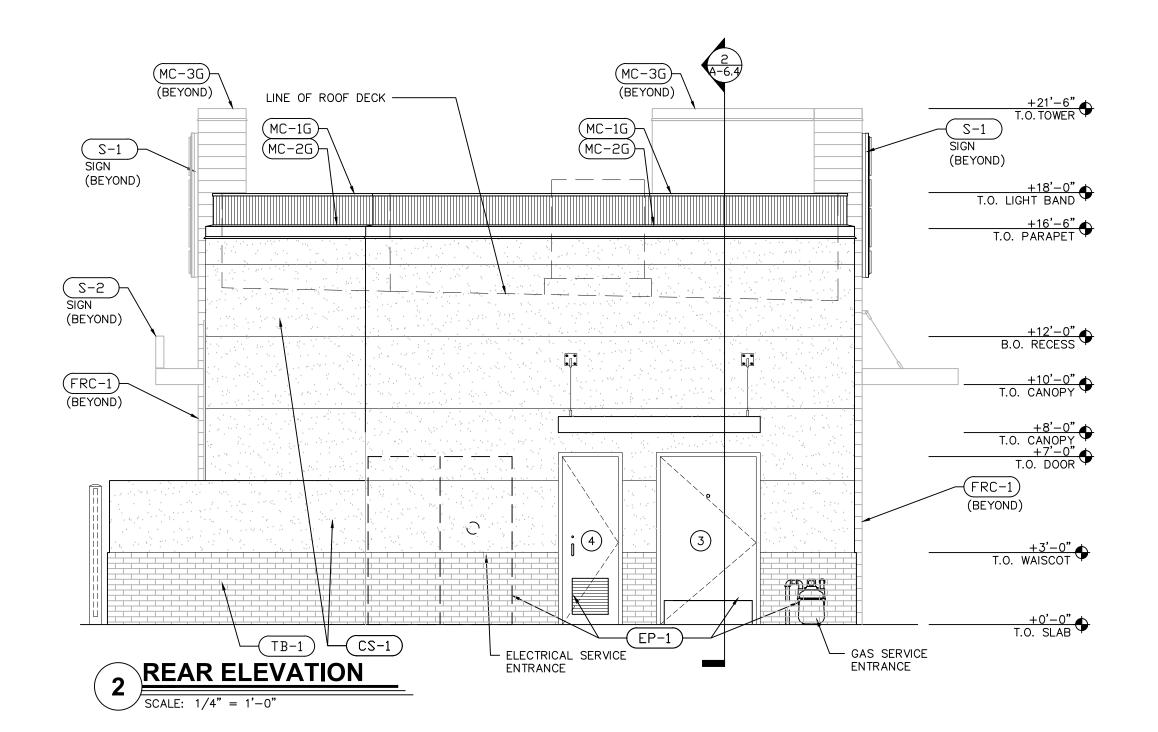

EXTERIOR CEMENT PLASTERING/PAINT (CS-1) CEMENT STUCCO MANUFACTURER: STO OR APPROVED EQUAL CONTACT: TIM SALERNO, 407.466.5371 COLOR: PPG TANNER'S TAUPE FINISH: FINE SAND LOCATION: MAIN BASE FINISH

EP-1 EXTERIOR PAINT MANUFACTURER: PPG CONTACT: RICK GARLIN, garlin@ppg.com 317.318.5800 COLOR: PPG MONTEREY CLIFFS LOCATION: EXTERIOR DELIVERY DOORS EXTERIOR FACED PANELS FRC-1) FIBER REINFORCED CEMENT PANELS

DESCRIPTION: HERITAGE WARM TEXTURED PANELS MANUFACTURER: NICHIHA CONTACT: ANDREW BRIGGS, abriggs@nichiha.com, 678.654.7002 MATERIAL:VINTAGE WOOD COLOR: CEDAR EPC762F LOCATION: TOWER ELEMENTS

EXTERIOR MASONRY TB-1) THIN BRICK

DESCRIPTION: THIN CLAD MANUFACTURER: PINE HALL BRICK CONTACT: THERESA BEANE, tbeane@pinehallbrick.com, 800.334.8689 SIZE: OVERSIZE/QUEEN COLOR: OLD IRVING OS LOCATION: WAINSCOT

EXTERIOR GLAZING

GL-1 ALUMINUM-FRAMED STOREFRONT DESCRIPTION: ALUMINUM WINDOW WALL SYSTEM MANUFACTURER: TRU-LITE OR EQUAL FINISH: ANODIZED ALUMINUM, CLEAR GLAZING LOCATION: DINING AREA - REFER TO ELEVATIONS FOR EXACT LOCATIONS

GL-2 DRIVE THRU WINDOWS DESCRIPTION: SELF-CLOSING, SINGLE SLIDING WINDOW MANUFACTURER: READY ACCESS MODEL #275 OR

QUIKSERV MODEL #SC4030

EXTERIOR METAL

MC-1G METAL COPING DESCRIPTION: PERMA SNAP PLUS MANUFACTURER: W.P. HICKMAN SYSTEMS INC. CONTACT: 828.676.1700, WWW.WPH.COM COLOR: SILVERSMITH A-30 LOCATION: LIGHT BAND TOP

MC-2G METAL COPING DESCRIPTION: PERMA SNAP PLUS MANUFACTURER: W.P. HICKMAN SYSTEMS INC. CONTACT: 828.676.1700, WWW.WPH.COM COLOR: FACTORY FINISH TO MATCH CS-1 LOCATION: PARAPET CAP

MC-3G METAL COPING DESCRIPTION: PERMA SNAP PLUS

MANUFACTURER: W.P. HICKMAN SYSTEMS INC. CONTACT: 828.676.1700, WWW.WPH.COM COLOR: FACTORY FINISH TO MATCH FRC-1 LOCATION: TOWER COPING

MC-4G EXTERIOR CANOPY


DESCRIPTION: OPEN METAL TRELLIS MANUFACTURER: APPROVED SIGN VENDOR COLOR/FINISH: CLEAR ANODIZED LOCATION: ABOVE DOORS / WINDOWS

EXTERIOR MISCELANEOUS

S-1 BUTTON LOGO DESCRIPTION: INTERNALLY ILLUMINATED CONTACT: APPROVED SIGN VENDOR SIZE: 72" DIAMETER, 28 S.F AREA, 36 S.F BOX AREA

S-2 WORD ACCENT DESCRIPTION: INTERNALLY ILLUMINATED CONTACT: APPROVED SIGN VENDOR SIZE: 1'-4"H x 21'-1" L, 28 S.F BOX AREA


MP-1G) PARAPET LIGHT BAND DESCRIPTION: LED LIGHT BAND (RED) MANUFACTURER: LEKTRON CONTACT: JOHN FITZWILSON, jfitzwilson@lektroninc.com 800.634.4059 LOCATION: LIGHT BAND TOP

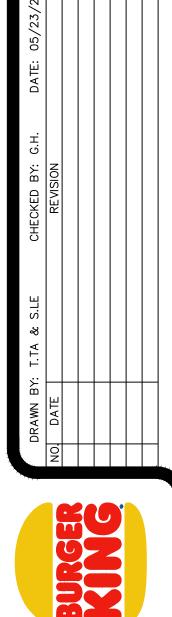





KING PALMS

A-2.2

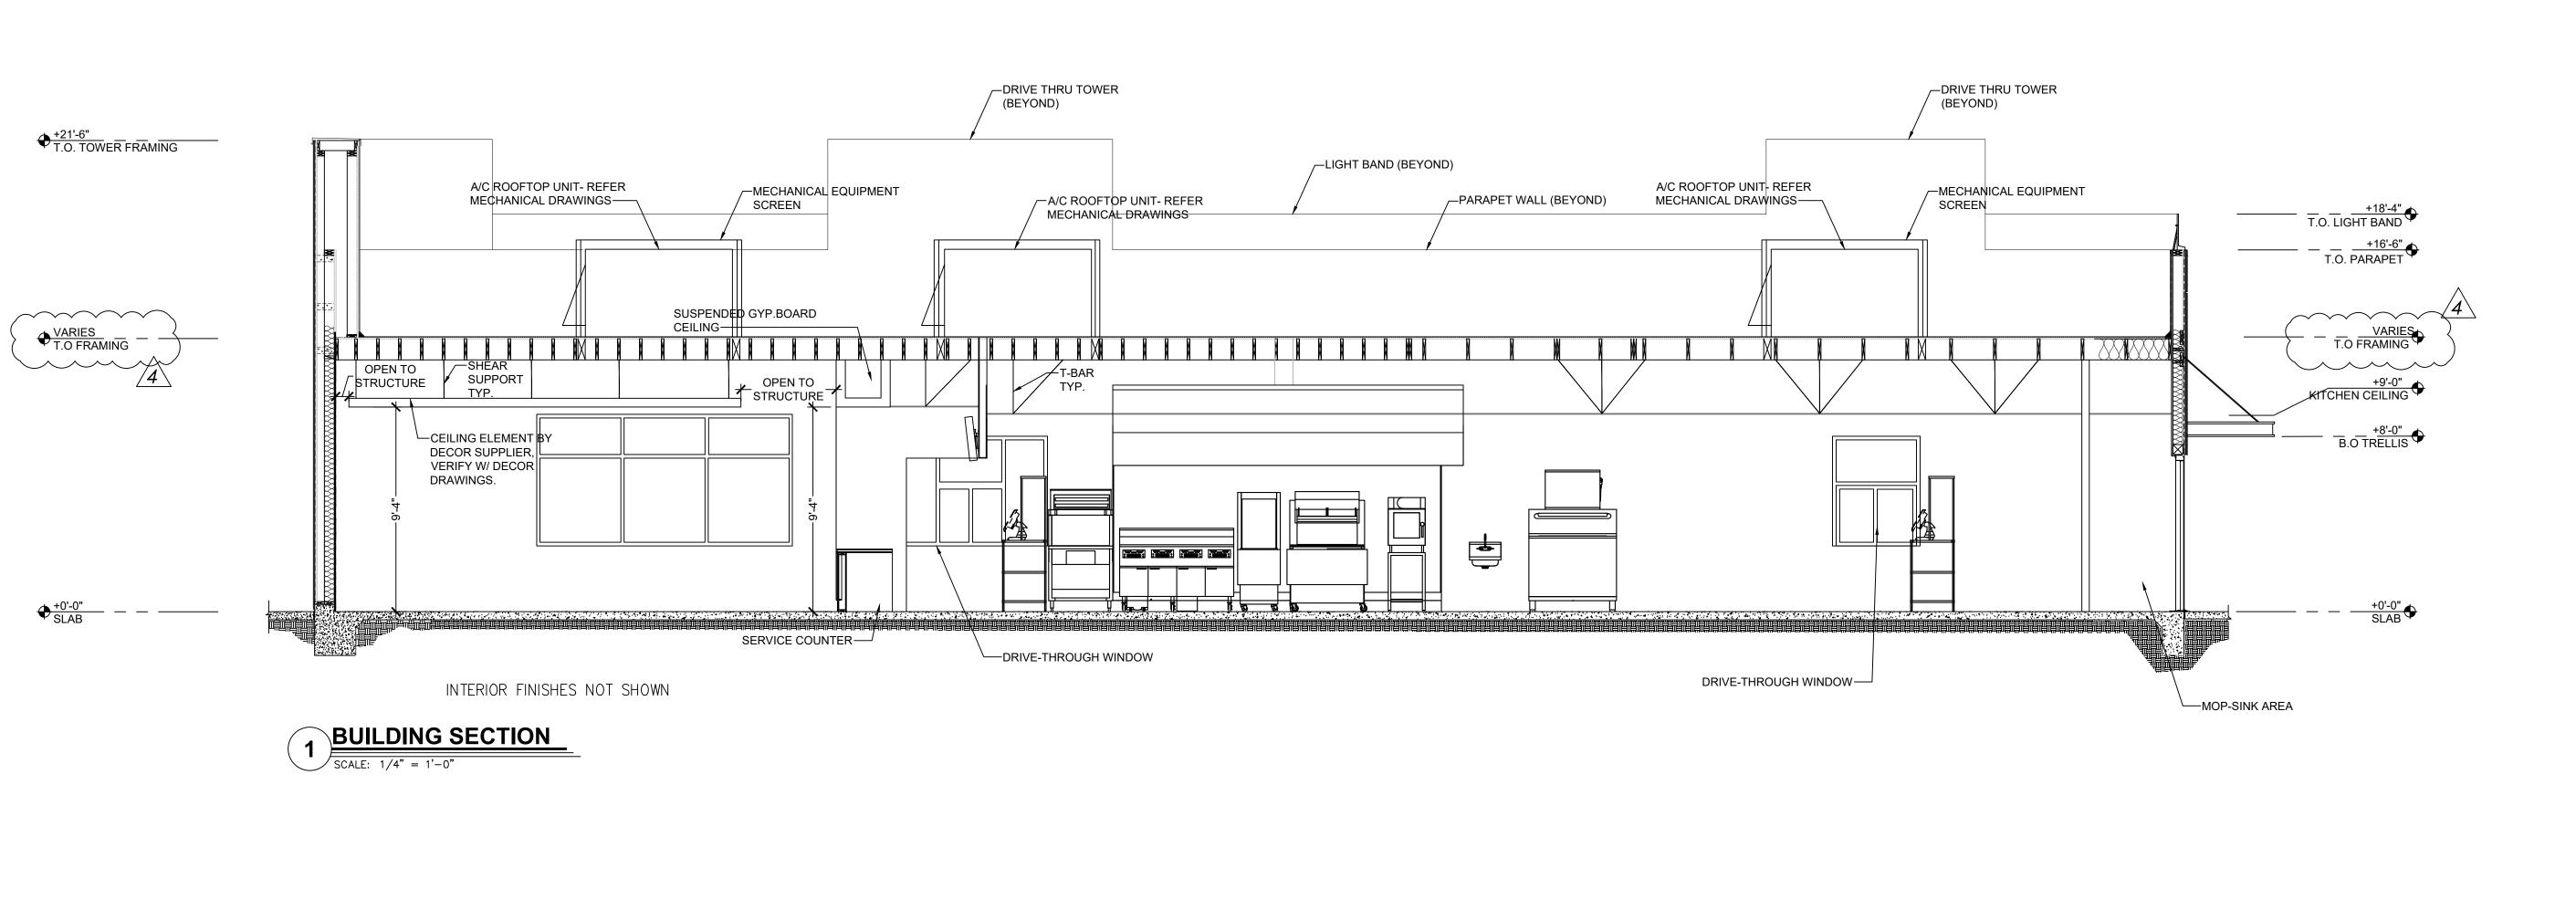

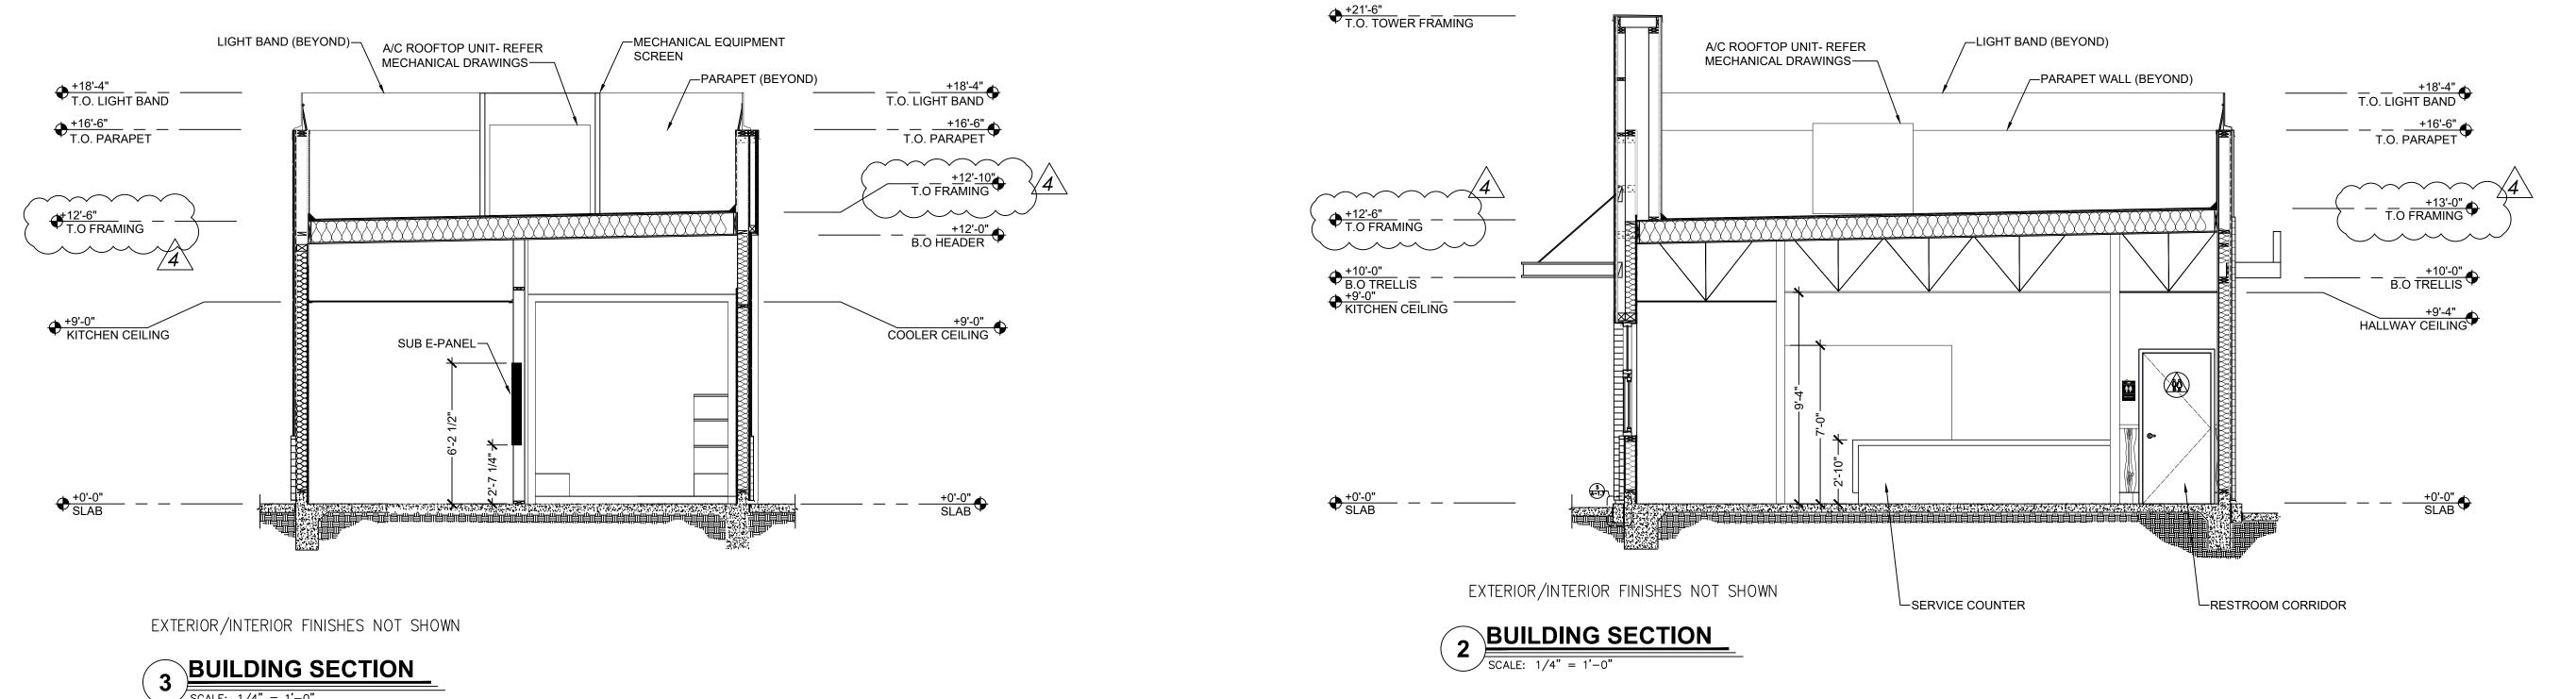



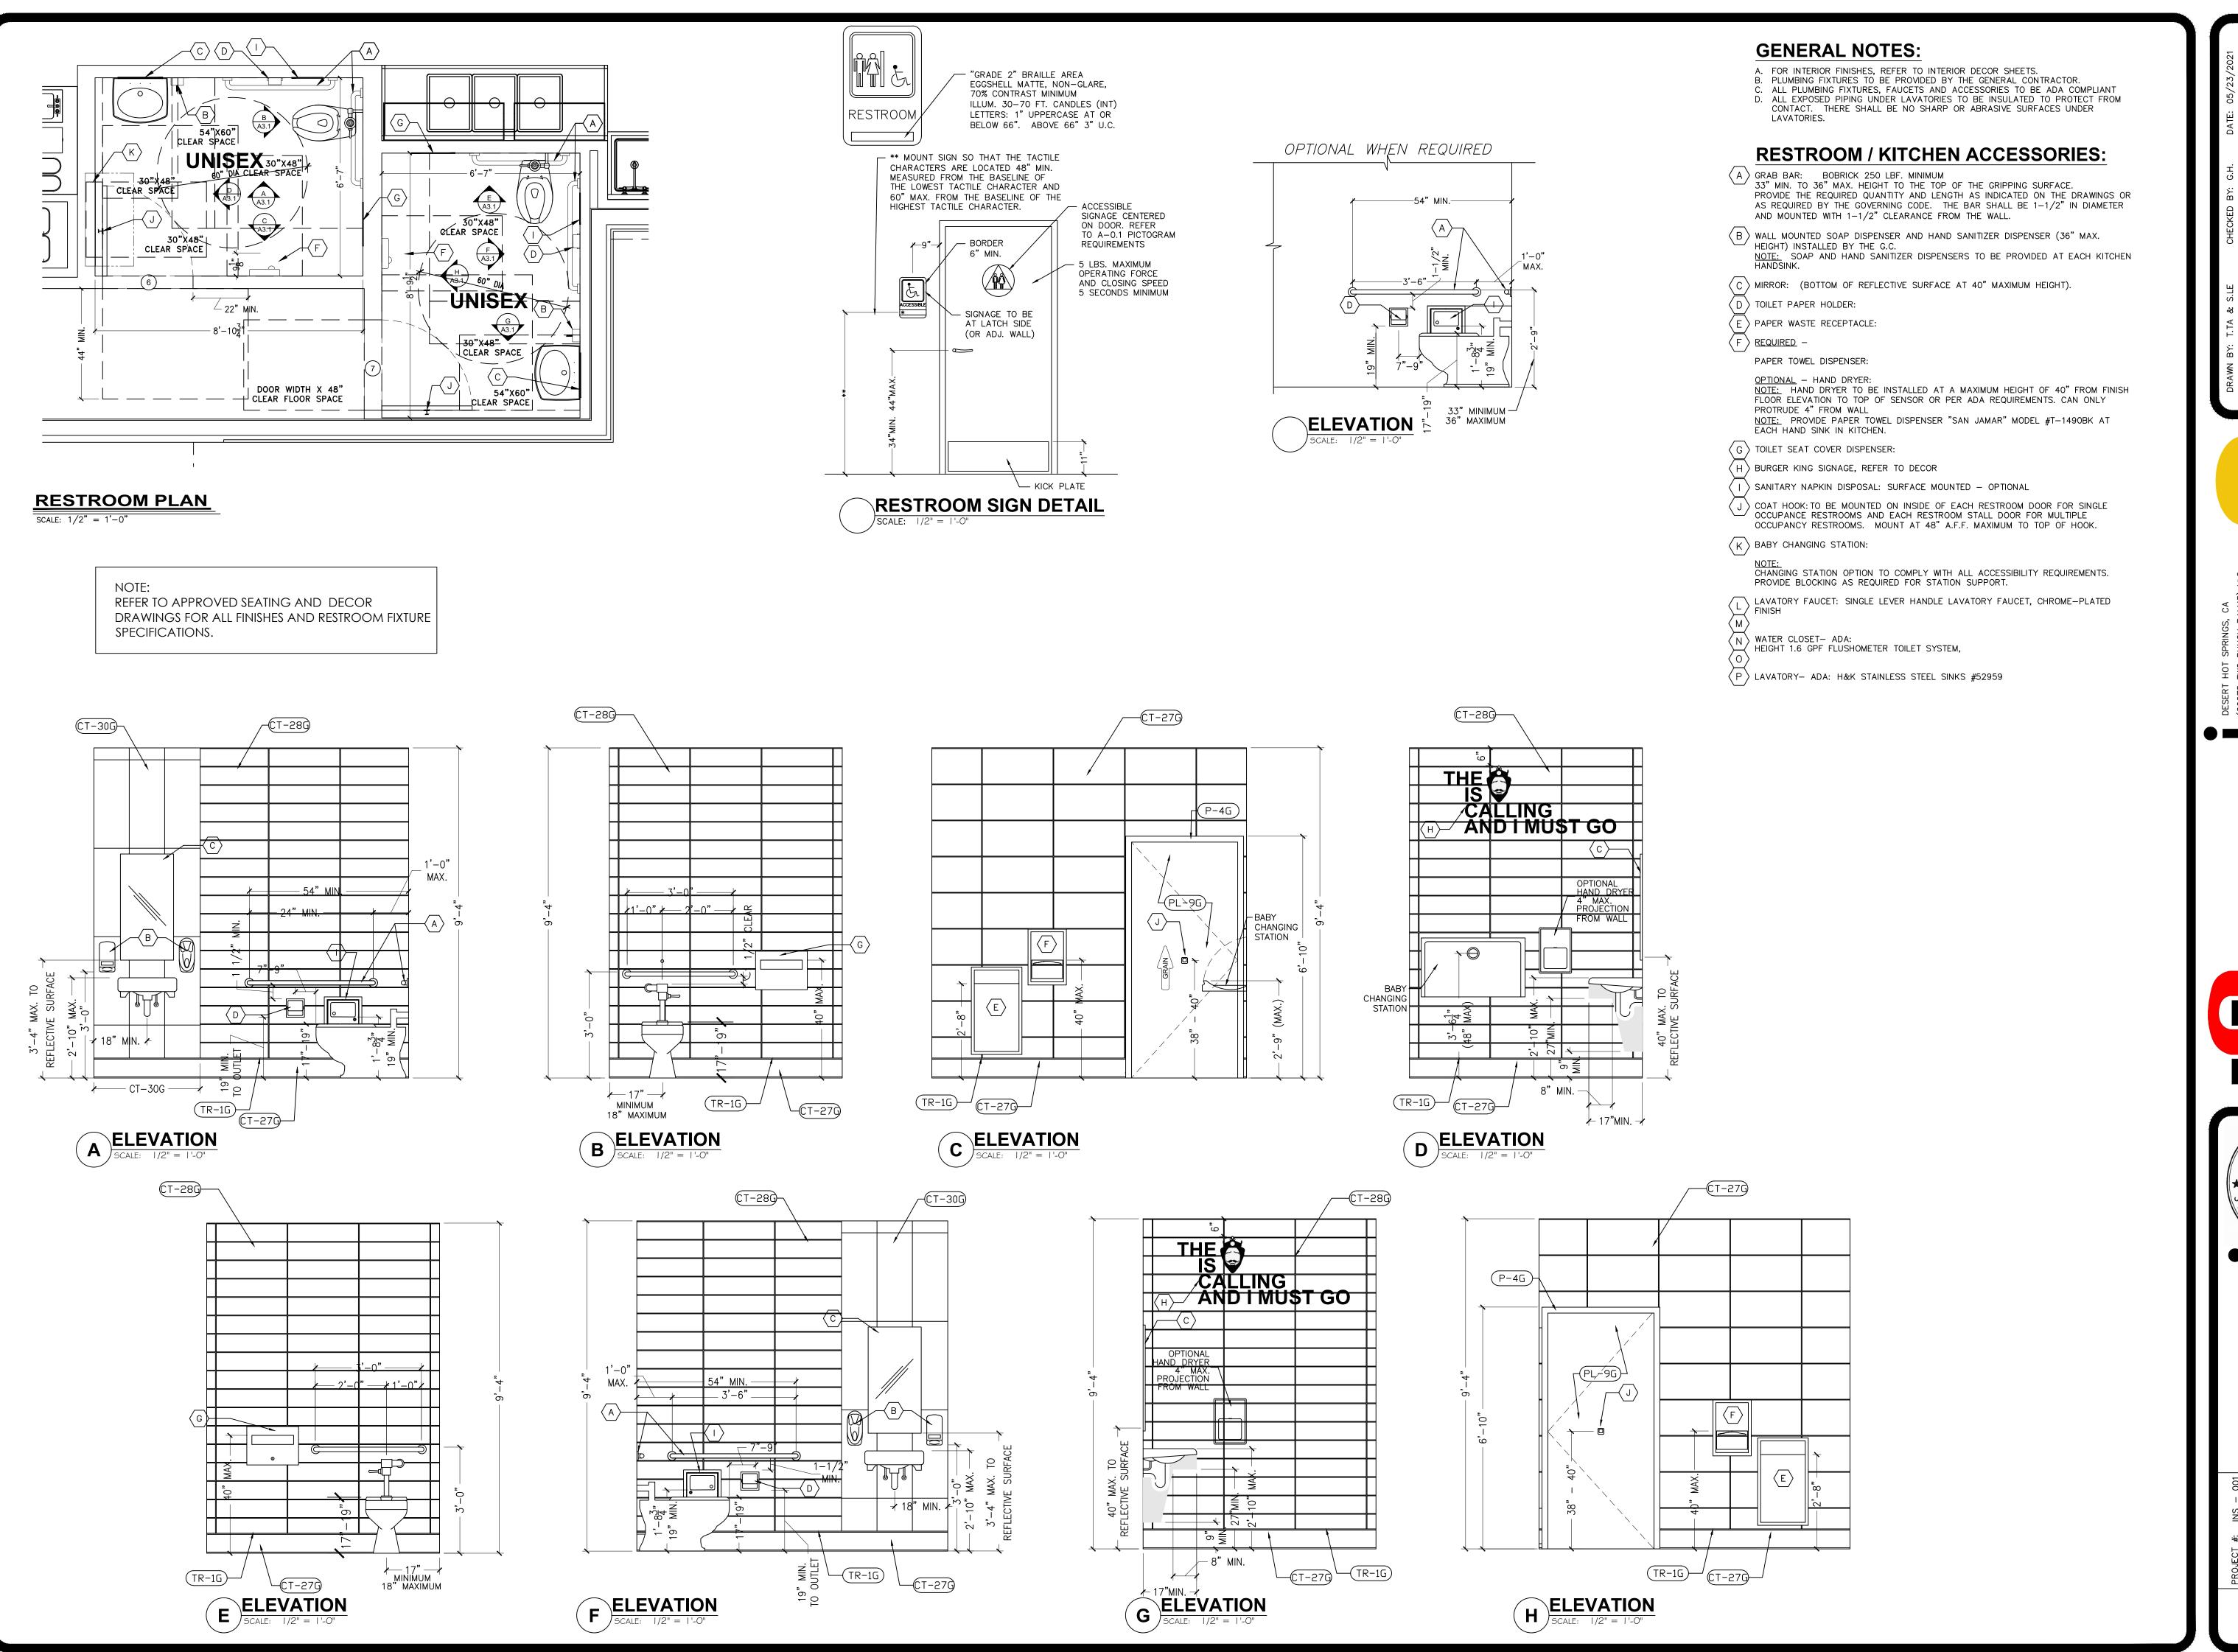

DESERT HOT SPRINGS (66675 TWO BUNCH AN ILLINOIS LIMITED 1400 16TH ST, SUITE OAK BROOK, IL 6052 PHONE: 630–592–319


PLANNING AND DESIGN 153 E. City Place Dr. | Santa Ana | CA | 92705 Phone 714.892-3900 | robert.preece@designua.com



RESTAURANT
S TRAIL
, 92240

RGER KING RESTAL
745 TWO BUNCH PALMS TRAIL
SERT HOT SPRINGS, CA 92240

A - 3.1

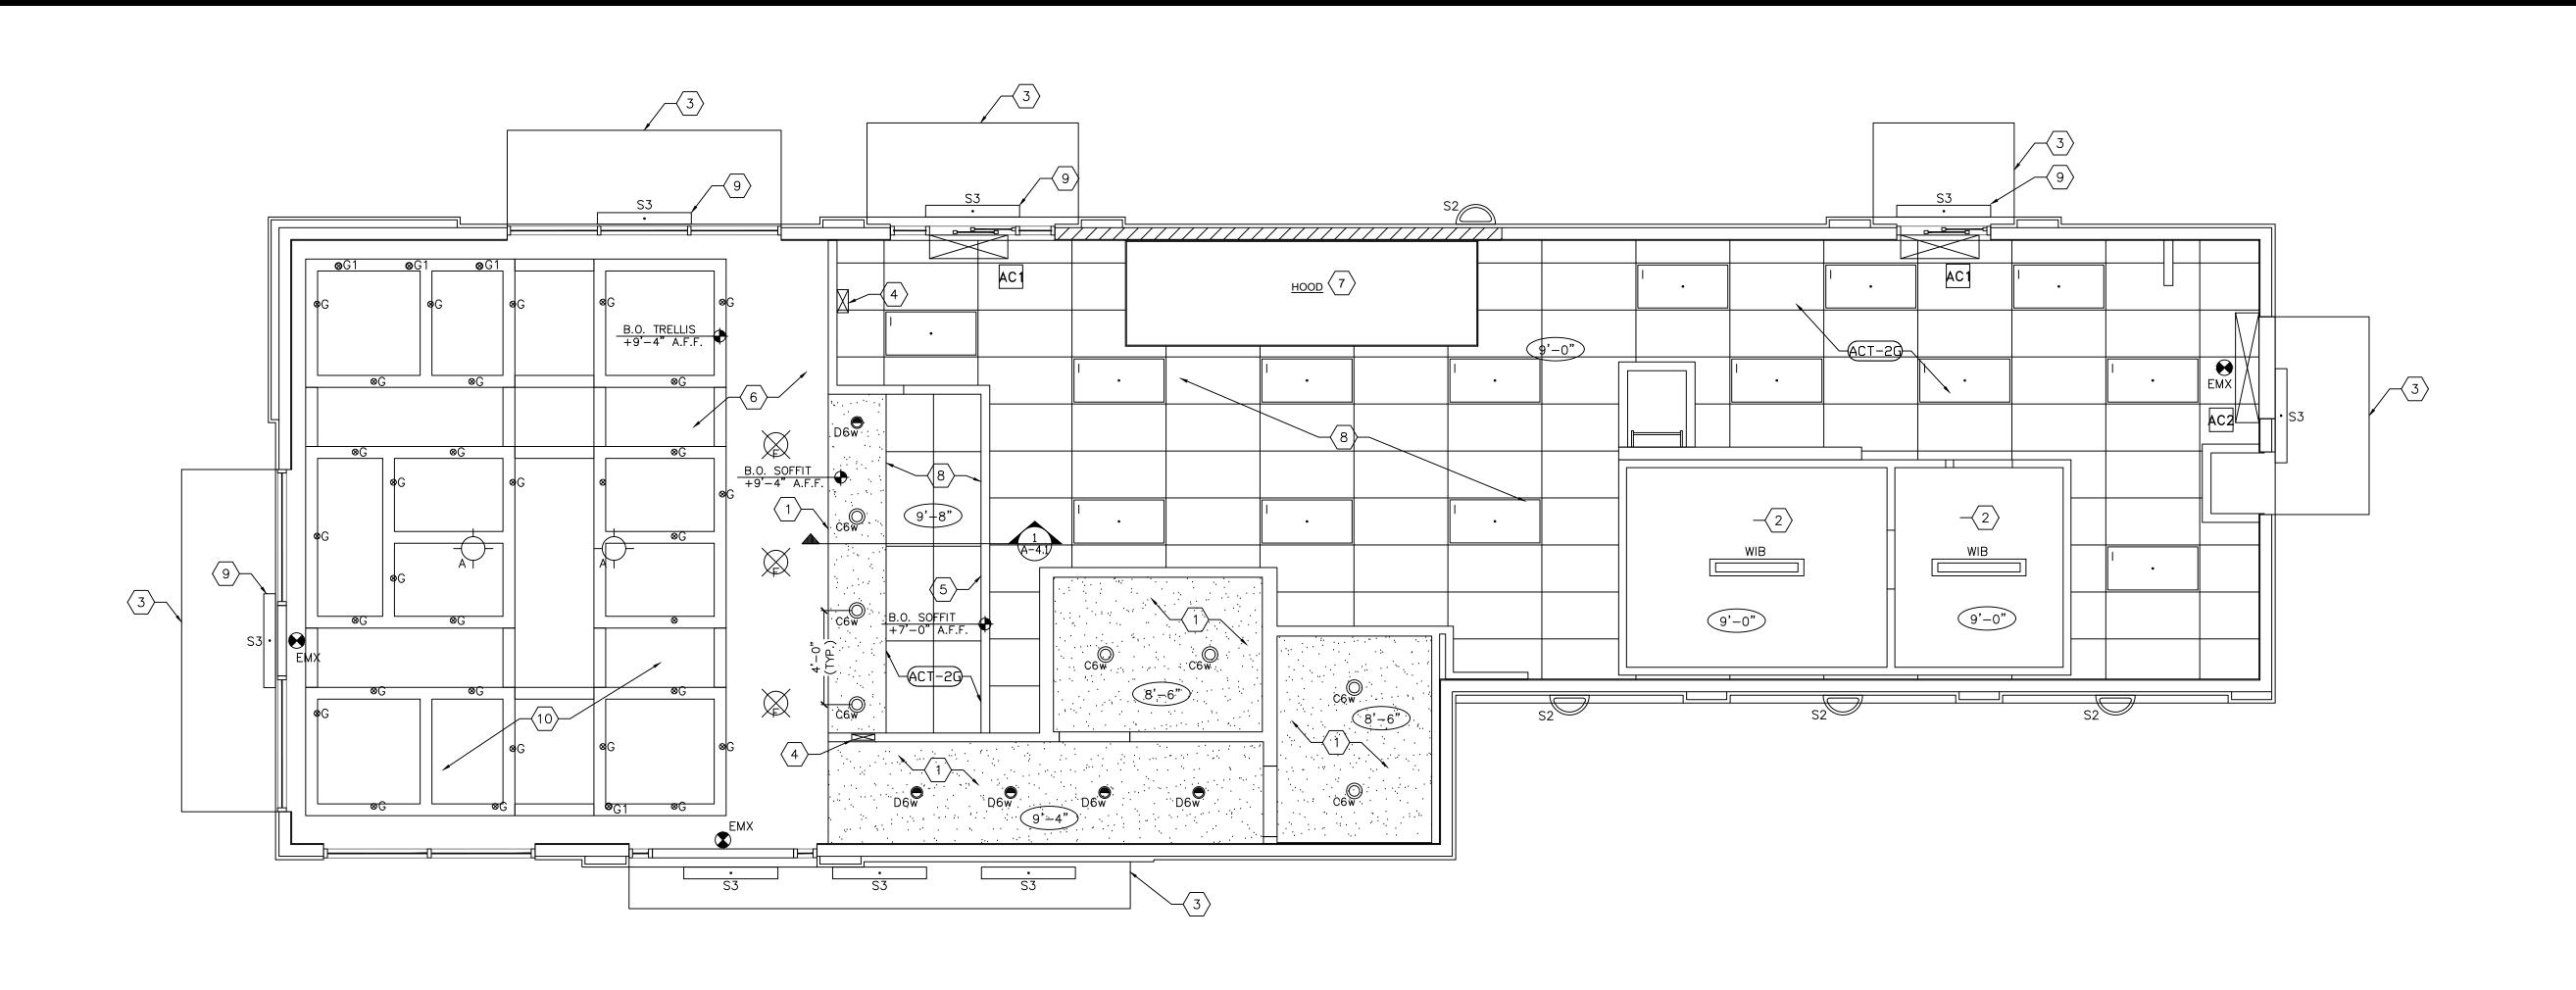

REFLECTED CEILING PLAN

SCALE: 1/4" = 1'-

NOTE:

DINING ROOMS ARE DESIGNED TO A 35 - 40 FOOT-CANDLE LEVEL. KITCHENS ARE DESIGNED TO 50 FOOT-CANDLE LEVEL. RESTROOMS ARE DESIGNED TO 50 FOOT-CANDLE. FOR ADDITIONAL INFORMATION ON LIGHTING REQUIREMENTS REFER TO BURGER KING LIGHTING STANDARDS POSTED @ DESIGNWITHBK.COM/COMMON DOCUMENTS.

NOTE:

REFER TO APPROVED SEATING AND DECOR PLANS FOR FINAL REFLECTED CEILING PLAN, LIGHTING PLAN, SUSPENDED LED WHOPPER AND CROWN LIGHTING.

	MANUFACTURER	MODEL	SERVES	AIRFLOW	ELECTRICAL	NOTE
AC.	READY ACCESS	AA300	DRIVE-THRU	VARIABLE	40 AMP 208 Single Phase 60HZ	1-2
AC2	POWERED AIRE	MP 1-48	SERVICE ENTRANCE 2,559 CFM	VARIABLE	MCA: 10 MOCP: 20 3/4 HP	2
			R TO 30 SECONDS		ECT SWITCH	

GENERAL NOTES:

- A. ALL DIMENSIONS SHOWN ON REFLECTED
- CEILING PLAN ARE FROM FACE OF WALL FINISH UNLESS NOTED OTHERWISE.

 B. THE REFERENCE HEIGHTS INDICATED ON PLAN
- ARE FROM FINISH FLOOR (F.F.)
 C. GENERAL CONTRACTOR TO COORDINATE DINING
 ROOM LIGHTING WITH APPROVED INTERIOR
 DECOR DRAWINGS.
 D. CONTRACTOR SHALL VERIFY FIXTURE
- QUANTITIES AND ALSO MAKE PROPER
 ADJUSTMENTS FOR ANY CHANGES IN PLAN DUE
 TO ADDITIONAL REQUIREMENTS, LOCAL CODES,
 ETC.
 E. FOR H.V.A.C. PLAN, SECTIONS, DUCT
- E. FOR H.V.A.C. PLAN, SECTIONS, DUCT LOCATIONS, SUPPLY AND RETURN GRILLE SIZES AND ADDITIONAL INFORMATION, REFERENCE SHFFT M-1.
- SHEET M-1.

 F. ALL FIXTURES SHALL BE LOCATED IN THE CENTER OF CEILING TILES UNLESS NOTED
- OTHERWISE.

 G. REFERENCE SHEET E-1 FOR LIGHTING LAYOUT
- REQUIREMENTS AND ADDITIONAL INFORMATION.
 H. REFERENCE INTERIOR DECOR SHEETS FOR FINISH SPECIFICATIONS.
- I. CONTRACTOR TO COORDINATE PENDANT LIGHT LOCATIONS WITH DECOR SUPPLIER DRAWINGS.


KEYED NOTES:

- GYPSUM BOARD CEILING/SOFFIT


 EXPOSED STRUCTURE ABOVE WALK-IN BOX, REFER TO WALK-IN BOX DRAWINGS FOR INTERIOR LIGHT FIXTURES
- PREFABRICATED METAL CANOPY OR AWNING
- 4 STAINLESS STEEL SERVICE CHASE
- 5 MENU BOARD AND HEADER. REFERENCE DTL 1/A-4.1
- 6 EXPOSED STRUCTURE TO BE PAINTED REFER TO ID SHEETS FOR COLOR
- 7 MECHANICAL EXHAUST HOOD ABOVE
- 8 SUSPENDED ACCOUSTICAL TILE CEILING. REFER TO SEATING & DECOR PLANS
- 9 CENTER LIGHT TO DOOR OR WINDOW
- EXPOSED PLYWOOD ROOF DECK SHEATHING REFER TO ID SHEETS FOR COLOR.

SYMBOLS LEGEND					
SYMBOL	DESCRIPTION				
	2'x4' T-GRID CEILING, REFERENCE INTERIOR FINISH SCHEDULE FOR TYPE, SHEET D8.4				
	GYPSUM BOARD CEILING. ARMSTRONG DRYWALL GRID SYSTEM (ESR 1289)				
	AIR CURTAIN.				

SY	MBOLS LEGEND		
SYMBOL	DESCRIPTION		
	SUPPLY AIR DIFFUSERS		
	RETURN AIR GRILLES	r M−1 FOR	
	EXHAUST FAN GRILLES		
A	SHAKER PENDANT LIGHT. COORDINATE LOCATION AND QUANTITY WITH DECOR SUPPLIER.		
C6w ©	6" DIAMETER WHT LED RECESSED DOWNLIGHT		
D6w ●	6" DIAMETER WHT LED RECESSED DOWNLIGHT WALL WASHER	ATIONS	
F 💢	SINGLE PENDANT LIGHT. COORDINATE LOCATION AND QUANTITY WITH DECOR SUPPLIER.	FOR SPECIFICATIONS	
G ⊗	2" LED DOWNLIGHT	FOR	
G1 ®	2" LED DOWNLIGHT WALL WASHER	T F-10	
1	2×4 RECESSED LED TROFFER LIGHTING KITCHEN LIGHT	REEERENCE SHEET	
WIB WIB	4' WET LINEAR LED LIGHT	RFFFR	
EM 🛚	UNIVERSAL EMERGENCY LED LIGHTING		
EMX 😝	UNIVERSAL EXIT & EMERGENCY LED LIGHTING		
S1 🖳	LED POLE LIGHT	TING	
S2 D _{S2}	LED WALL MOUNTED EXTERIOR WALL SCONCE (ALSO USED IN OPEN CANOPIES)	EXTERIOR LIGHTING	
S3 .	LED AWNING 4'-0" AWNING LIGHT (USED UNDER AWNINGS AND CLOSED CANOPIES)	FXTFR	

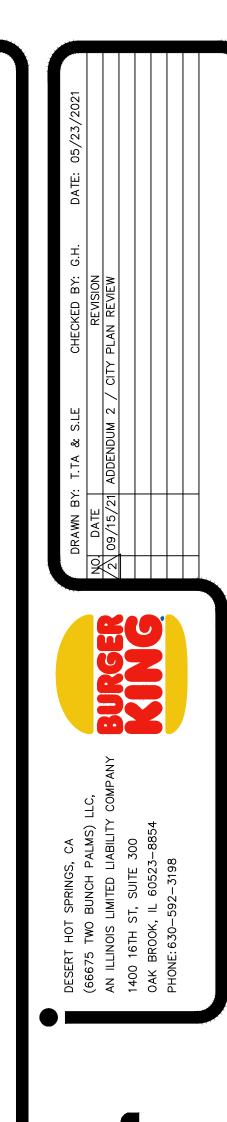


PLANNING AND DESIGN 153 E. City Place Dr. | Santa Ana | CA | 92705 Phone 714.892-3900 | robert.preece@designua.com

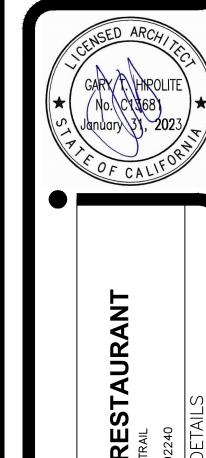

BURGER KING
66745 TWO BUNCH PALM
DESERT HOT SPRINGS, C

A-4

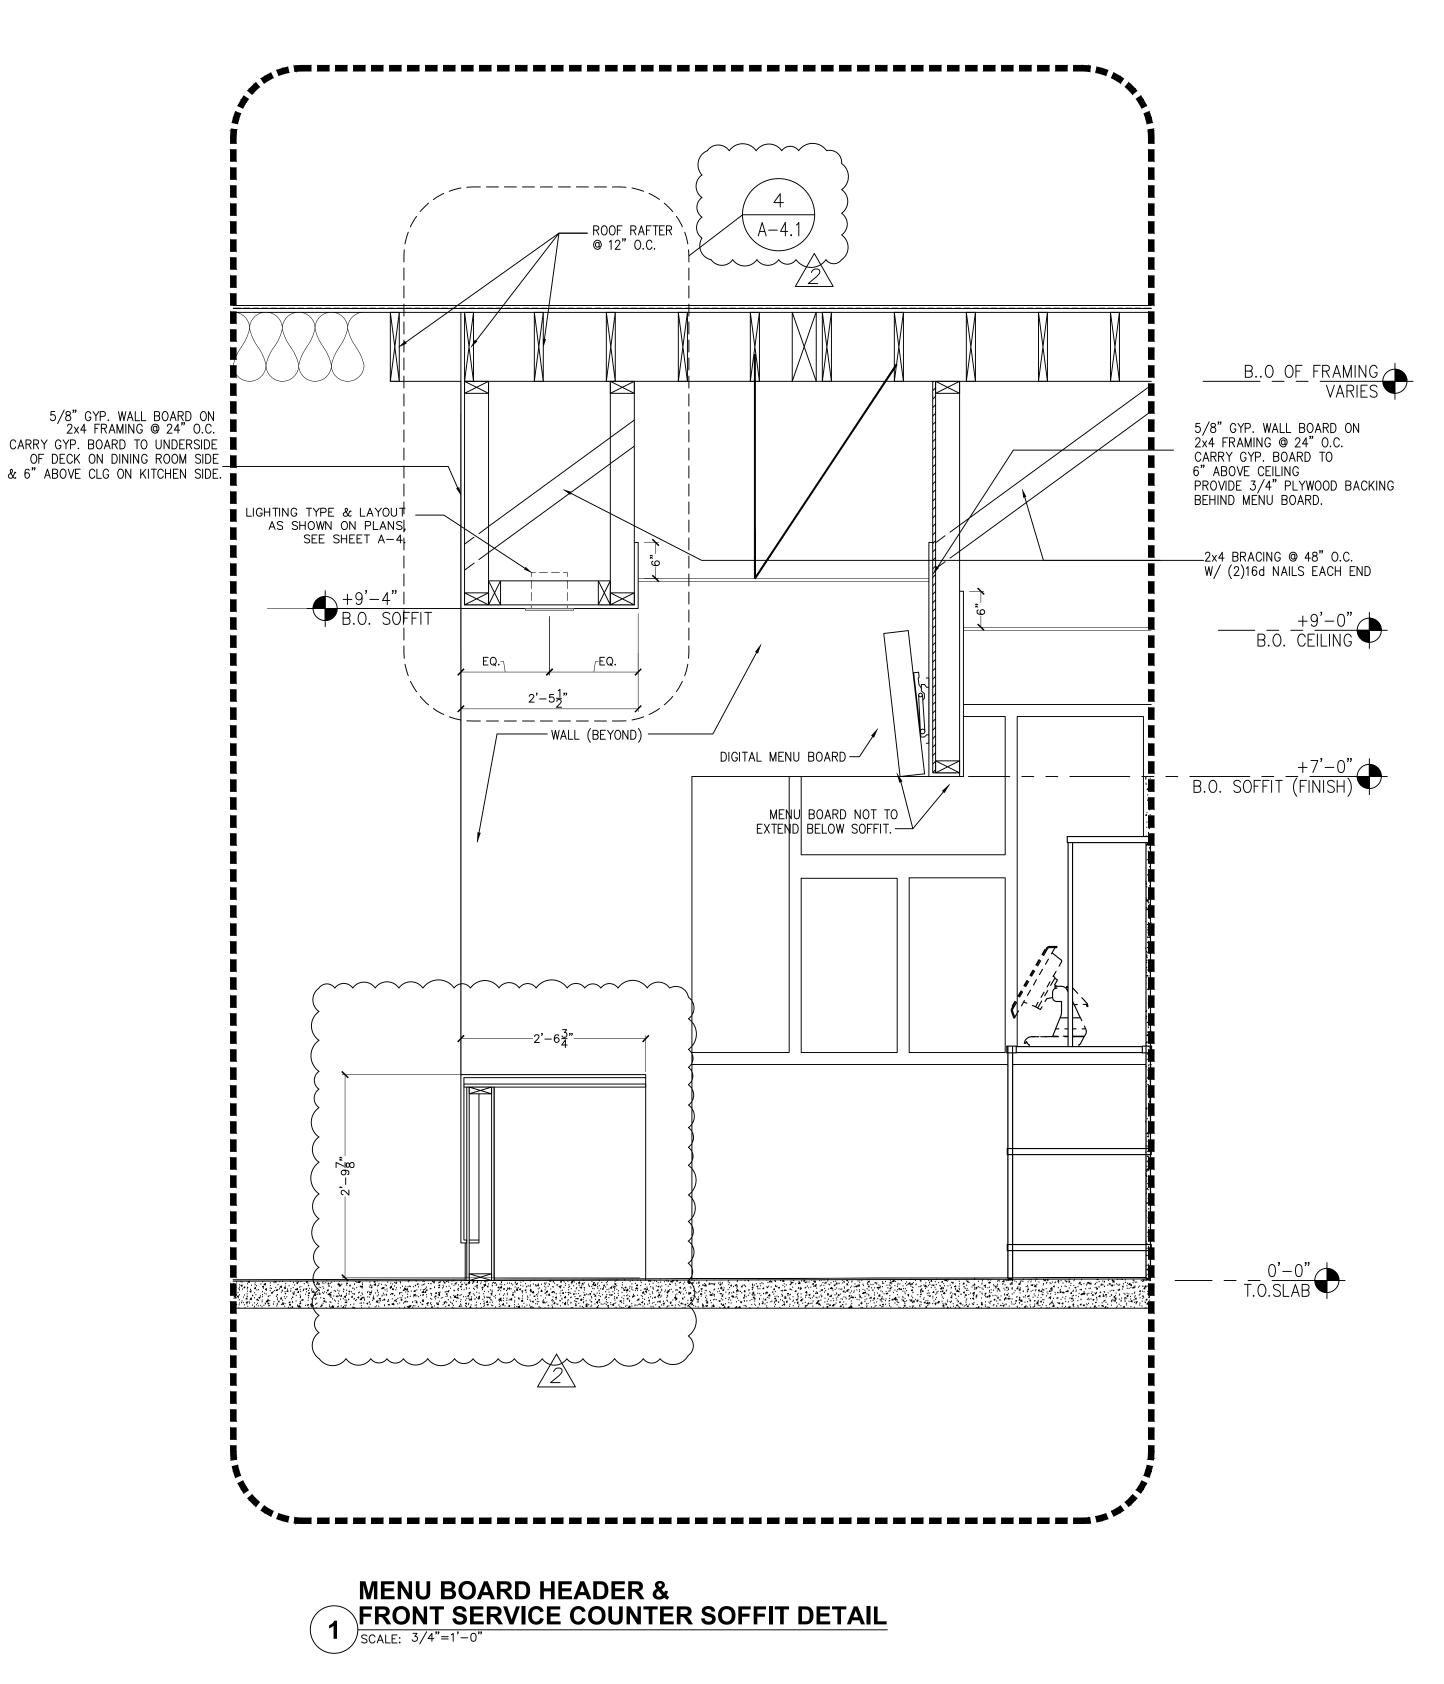

∽REFER TO A-4 & ELECTRICAL DRAWINGS FOR LIGHT SPECIFICATIONS PAINT PER DECOR-

FRONT SERVICE COUNTER SOFFIT DETAIL - RECESSED LIGHTING LAYOUT SCALE: 1/2" = 1'-0"

#12 GA. VERT. WIRE HANGER, GRID LEVEL ADJACENT TO TUBE UNDERSIDE OF FLR. OR ROOF STRUCT. ABOVE - DONN COMPRESSION POST. MODEL TO BE DETERMINED BASED ON REQUIRED LENGTH: VSA 18/30: LENGTH 18" TO 30" VSA 30/48: LENGTH 30"-48" √/ 45 DEGREE TYP.

— CROSS RUNNER


COMPRESSION STRUT W/ LATERAL BRACING @ 12'-0" MAX. EA. DIRECTION & 6'-0" MAX. FROM PERIMETER WALLS

1. GRID SYSTEM TO BE HEAVY DUTY T-BAR.

- 2. INSTALL PER ESR-1222 IN EACH ORTHOGONAL HORIZONTAL DIRECTION, ONE END OF THE CEILING GRID SHALL BE ATTACHED TO THE CLOSING ANGLE. THE OTHER END SHALL HAVE A 0.75" CLEARANCE FROM THE WALL.
- 3. ENDS OF MAIN RUNNERS AND CROSS RUNNERS SHALL BE TIED TOGETHER TO PREVENT THEIR SPREADING 4. ALL TERMINAL ENDS OF MAIN RUNNERS AND CROSS TEES MUST HAVE A VERT.
- HANGER WIRE WITHIN 8" OF EA. WALL OR CLG DISCONTINUITY. 5. Y12 GA. VERTICAL WIRES SHALL BE USED AT 48" O.C. PERIMETER HANGARS
- SHALL BE 8" MAX. FROM WALL AND NOT MORE THAN 1 IN 6 OUT OF PLUMB. 6. IN EACH ORTHOGONAL HORIZONTAL DIRECTION, ONE END OF THE CEILING GRID SHALL BE ATTACHED TO THE CLOSING ANGLE. THE OTHER END SHALL HAVE A 0.75" CLEARANCE FROM THE WALL.
- 7. PERIMETER HANGER WIRES SHALL BE LOCATED WITHIN 8" OF THE END OF EACH RUNNER (CROSS AND MAIN RUNNERS)

- 8. ALL LIGHT FIXTURES TO BE POSITIVELY ATTACHED TO THE SUSPENDED CEILING GRID SYSTEM.
- 9. PROVIDE INDEPENDENT WIRE SUPPORT FROM THE FIXTURE HOUSING TO THE STRUCTURE ABOVE AS FOLLOWS:
- FIXTURES LESS THAN 10 POUNDS, PROVIDE ONE #12 GAGE WIRE (MAY BE SLACK)
- FIXTURES 11-55 POUNDS, PROVIDE TWO#12 GAGE WIRES (MAY BE SLACK)
- FIXTURES 56 POUNDS OR MORE SHALL BE SUPPORTED DIRECTLY FROM THE STRUCTURE ABOVE USING #9 GAGE WIRE


10. REFER TO NOTES SECTION E, SHEET A-O FOR ADDITIONAL CRITERIA

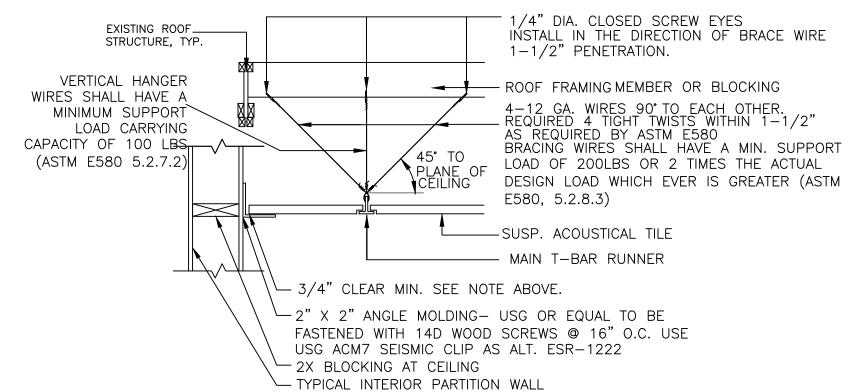


COMPLY WITH ASTM E580 SECTION 5 FOR SEISMIC DESIGN CATEGORY D & E

SEISMIC GRID DETAIL

SCALE: 1/2"=1'-0"

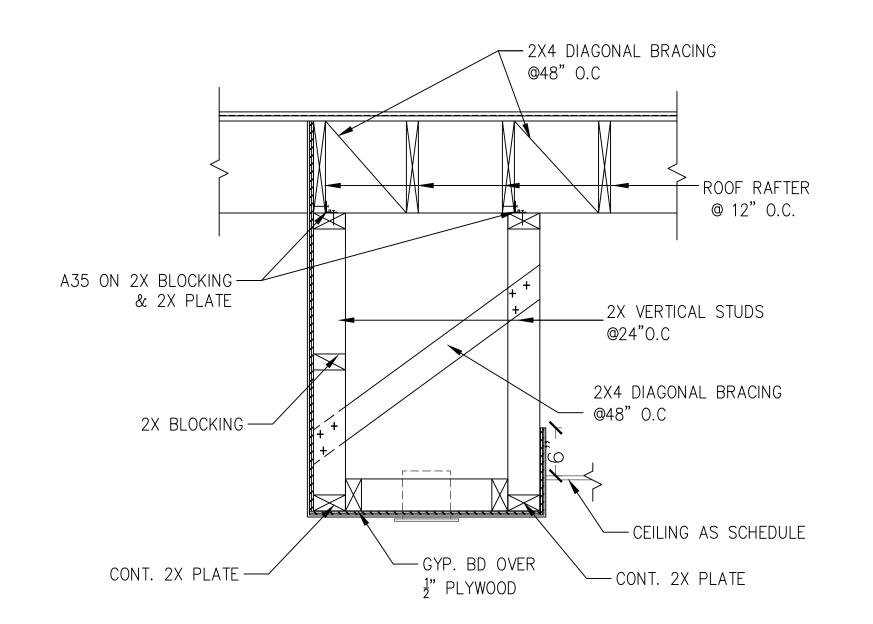

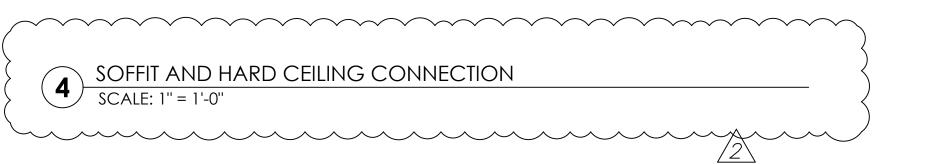





KING HOM

A - 4.1

GENERAL NOTES:

- A. THE ROOF STRUCTURE SHALL NOT BE USED FOR STOCKPILING OF EQUIPMENT OR MATERIALS UNLESS APPROVED BY THE ARCHITECT, STRUCTURAL ENGINEER AND THE JOIST MANUFACTURER.
- B. THE ROOFING SYSTEM SHALL BE AS PER DRAWINGS AND PER MANUFACTURERS SPECIFICATIONS.
- C. COORDINATE ROOF ELEVATIONS WITH STRUCTURAL DRAWINGS. REFER TO SPECIFICATION SHEET FOR ROOF RELATED ITEMS, INCLUDING GUARANTEES, CURBS, FLASHING, ETC.

GENERAL ROOFING NOTES:

- 1. ROOFING SUBCONTRACTOR TO COORDINATE LOCATION OF H.V.A.C. UNITS AND ROOF TOP ACCESSORIES WITH STRUCTURAL, MECHANICAL AND ELECTRICAL DRAWINGS FOR PLACEMENT AND TAPERED RIGID INSULATION BOARD LAY-OUT AND SUBSEQUENT INSTALLATION IN ORDER TO AVOID PONDING WATER CONDITIONS ATTRIBUTABLE TO BOARD LAY-OUT ISSUES.
- 2. ROOF SYSTEMS SPECIFIED SHALL BE EPDM OR DUROLAST AND APPLIED ONLY BY MANUFACTURER APPROVED APPLICATOR IN ORDER TO MEET GUARANTEE REQUIREMENTS.
- COORDINATE LOCATION OF MECHANICAL UNITS WITH STRUCTURAL AND MECHANICAL DRAWINGS.
- 4. HVAC CONDENSATE LINES TO TERMINATE AT ROOF DRAIN OR AS REQUIRED BY LOCAL CODE.
- 5. REFER TO STRUCTURAL AND M-E-P DRAWINGS FOR ADDITIONAL INFORMATION.
 6. ALL CURBS AND PIPE PENETRATIONS SHALL HAVE A MINIMUM OF 16" CLEAR FROM EACH OTHER FOR ROOF FLASHING PURPOSES. ALL EQUIPMENT SHALL HAVE A MINIMUM OF 16" CLEAR FROM ALL ADJACENT PARAPETS. ALL HVAC MOUNTED EQUIPMENT (DISCONNECT BOXES, GFCI, PIPE SUPPORTS) SHALL NOT BE CLOSER THAN 16" FROM EACH OTHER OR CURB. NO UNISTRUT PIPE SUPPORTS SHALL BE USED AS VERTICAL MEMBERS FOR MOUNTING EQUIPMENT TO ROOF SURFACE.
- 7. PONDING WATER IS DEFINED AS WATER THAT DOES NOT DRAIN OR DISSIPATE FROM THE ROOF WITHIN 48 HOURS AFTER PRECIPITATION.
- 8. CONTRACTOR TO USE EPDM OR DUROLAST ROOFING TO MATCH EXISTING COLORATION OF THE MINERAL SURFACE CAP SHEET.
- 9. ALL FLASHING CEMENTS, ASPHALTS, PRODUCTS AND ACCESSORIES SHALL BE APPROVED BY ROOFING MANUFACTURER WITH THE MANUFACTURES'S BRAND. ALL ASPHALTS SHALL BE AMERICAN MANUFACTURED PRODUCTS.


1. SINGLE PLY PREFABRICATED DURO-LAST 50 MIL OR EPDM, EITHER MECHANICALLY FASTENED, ADHERED, OR BALLASTED PER CONTRACTOR.


2. RÔOF ACCESS SCUTTLE, REFERENCE DÉTAIL, THIS SHÉET.

3. PREFABRICATED METAL CANOPY UNDER SEPARATE PERMIT.

- 4. VENT THROUGH ROOF PROVIDE PREFABRICATED DURO-LAST VENT FLASHING FOR ALL VENTS AND PIPE PENETRATIONS.
- 5. INSTALL MODIFIED BITUMEN SACRIFICE SHEET 6'-0' (MIN.) FROM KITCHEN EXHAUST OR AS SPECIFIED.
- 6. ROOF CRICKET WITH SLOPE TO MATCH ROOF, REFER TO DETAIL #3/SHEET A5.1.
- 7. ROOF DRAIN REFER TO DETAIL #4 SHEET A5.1.
- 8. ROOT-TOP AIR CONDITIONING UNIT REFER TO MECHANICAL PLANS.
- 9. EXHAUST FAN REFER TO MECHANICAL PLANS
- 10. ILLUMINATED PARAPET LIGHT BAND.
- 11. METAL COPING.
- 12. CONDENSATE DRAIN, REFER TO MECHANICAL SHEET M1.1
- 13. PROVIDE PITCH PAN WITH CONDUIT OVER OFFICE FOR SATELLITE DISH/ANTENNA.
- 14. EQUIPMENT STAND FOR WALK-IN BOX COOLER/FREEZER CONDENSERS AND ICE MACHINE CONDENSER. REFER TO EQUIPMENT STAND DETAIL, 6/A5.1.
- 15. BUILDING SIGN REFER TO EXTERIOR ELEVATIONS AND ROOF POWER PLAN.
- 16. PARAPET LIGHT BAND BY APPROVED VENDOR. REFER TO ROOF POWER PLAN.
- 10. PARAPET LIGHT BAND BY APPROVED VENDOR. REFER TO ROOF POWER PLAN
- 17. DASHED LINE TO INDICATE 30" AREA OF WALKWAY PADS



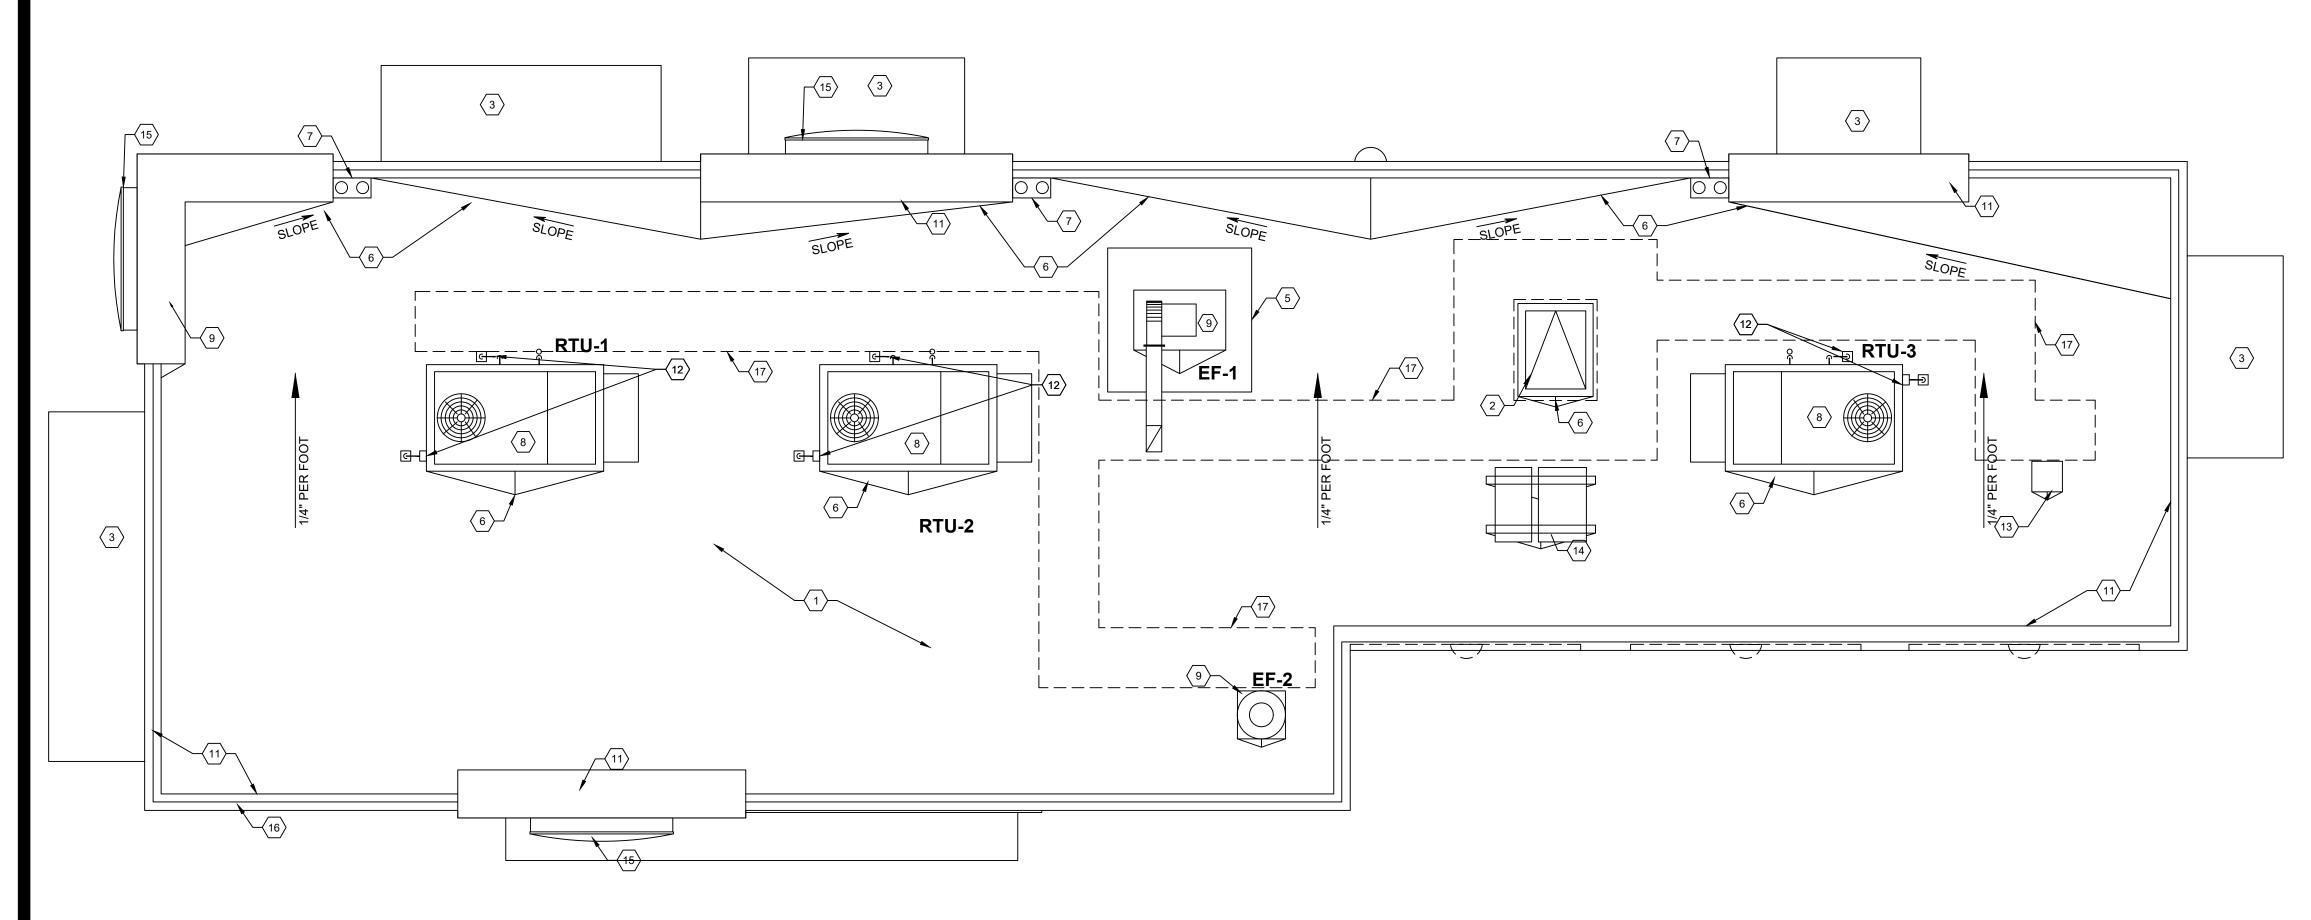

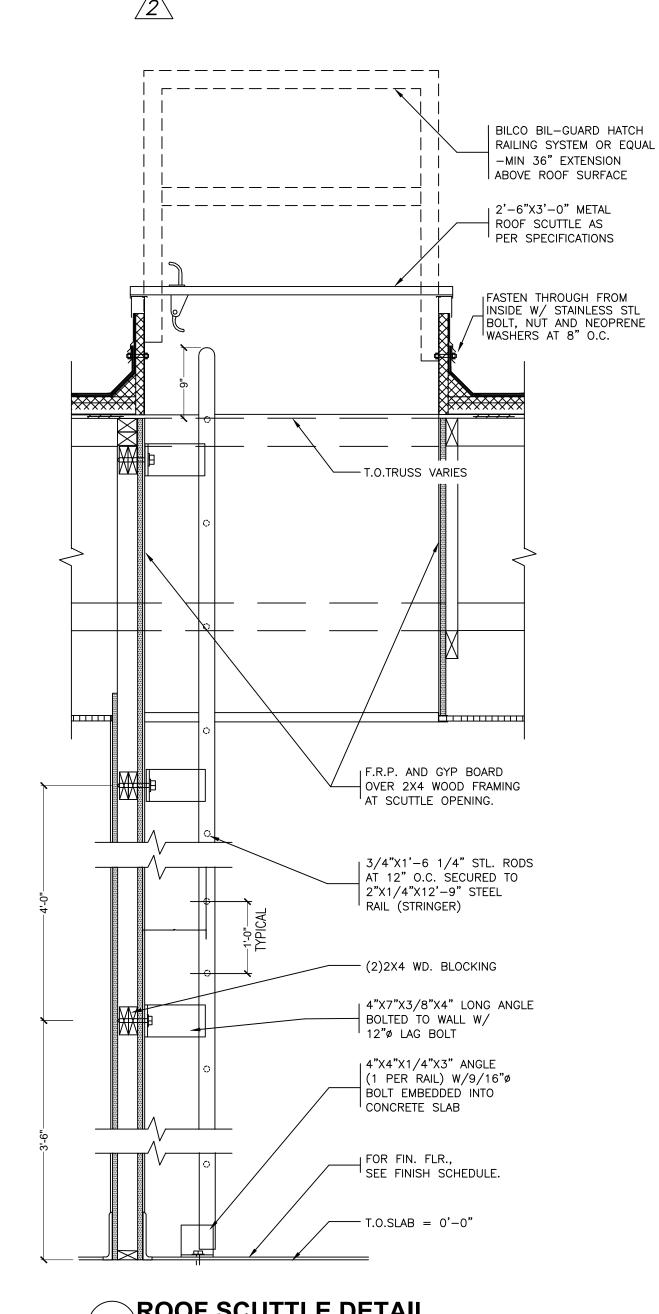



 DRAWN BY: T.TA & S.LE
 CHECKED BY: G.H.
 DATE: 05/23/2

 NO, DATE
 REVISION


 3 10/18/21
 PLAN REVIEW COMMENTS

 2 09/15/21
 ADDENDUM 2 / CITY PLAN REVIEW

ANY BERGER CANA

(66675 TWO BUNCH PALMS) LLC,
AN ILLINOIS LIMITED LIABILITY COMPAI 1400 16TH ST, SUITE 300
OAK BROOK, IL 60523-8854
PHONE: 630-592-3198


ANNING AND DESIGN | CA | 92705

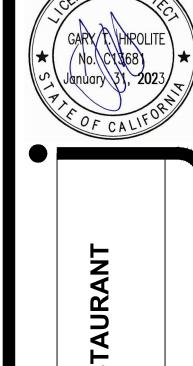


URGER KING RESTAL
66745 TWO BUNCH PALMS TRAIL
DESERT HOT SPRINGS, CA 92240

A-5

1 ROOF PLAN
| SCALE: 1/4" = 1'-0"

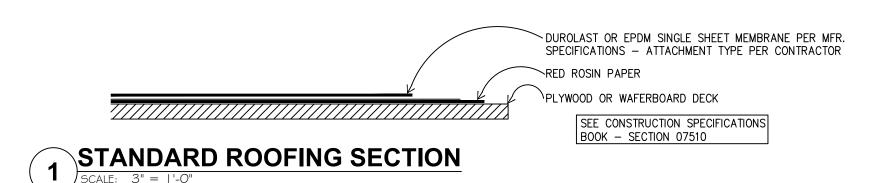

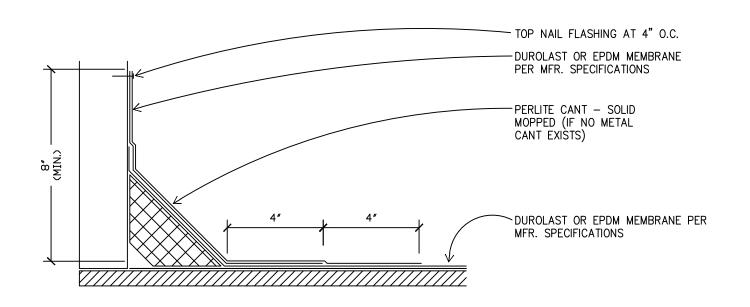



SEE CONSTRUCTION SPECIFICATIONS

BOOK - SECTION 07510


STANDARD BASE FLASHING CONFIGURATION


SCALE: 3" = 1'-0"

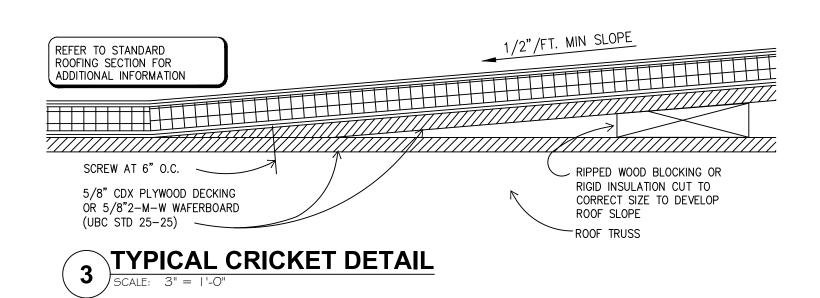

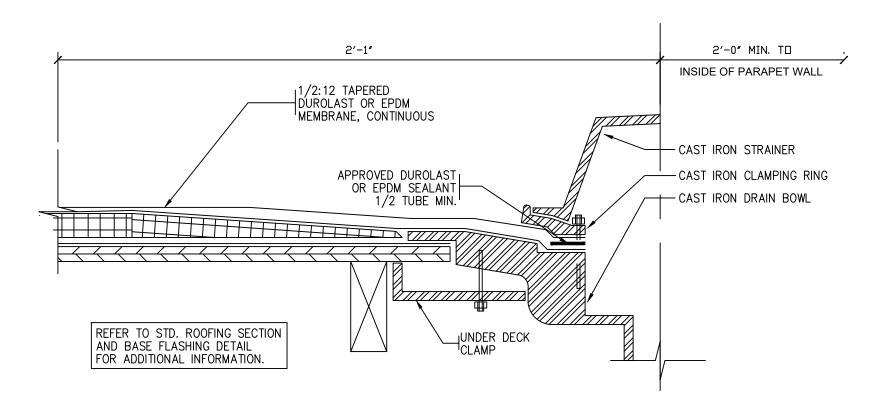

4 ROOF DRAIN DETAIL

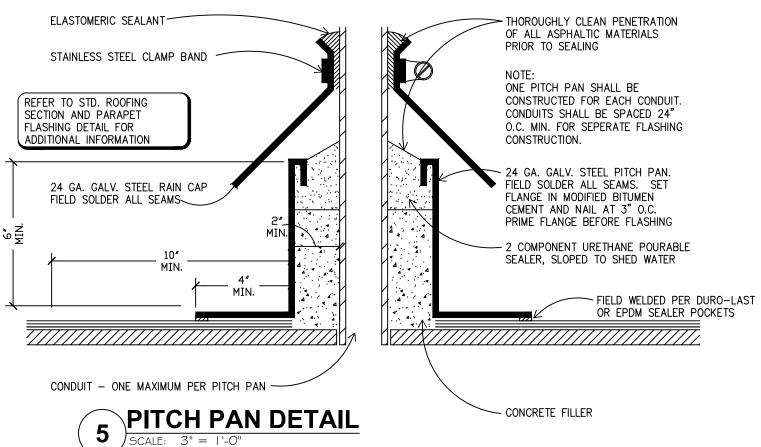


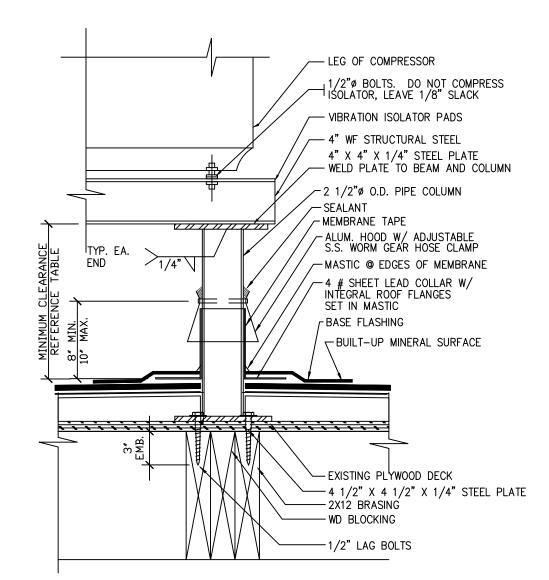

EQUIPMENT STAND DETAIL

VERIFY W/ EQUIPMENT SUPPLIER IF IN CONTRACT. CIEADANCE DELOW DAIGED DOOF MOUNTED

	COW RAISED ROOF MOUNTED ICAL UNITS (INCHES)
WIDTH OF UNIT	MINIMUM CLEARANCE ABOVE ROOF SURFACE
< 24	14
24 < 36	18
36 < 48	24
48 < 60	30
> 60	48

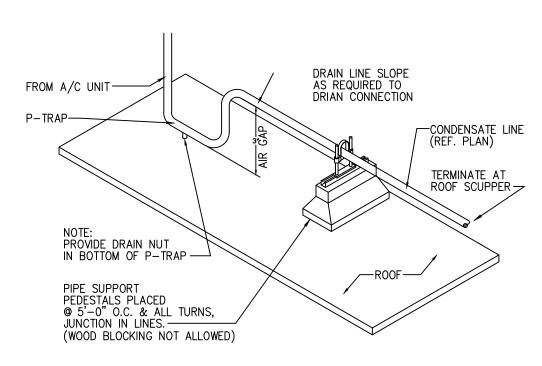

CONDENSATE LINE SUPPORT DETAIL



PRODUCT DATA SHEET

DURO-LAST[®] 50-MIL MEMBRANE

Advantages: Duro-Last[®] 50-Mil (DL50) membrane is an excellent choice for projects requiring a long lasting, energy efficient roofing membrane. The membrane is available in custom-fabricated sections or as roll goods. A complete line of custom-prefabricated accessories is available for the DL50 membrane.

DL50 membrane is composed of PVC film laminated

to both sides of a reinforcement fabric (weft-inserted Duro-Last membranes must not be used with

Duro-Last EV membranes. **PVC Film** - Proprietary thermoplastic PVC formulation of resins, plasticizers, stabilizers, biocides, flame retardants, and U.V. absorbents.

 PVC film above weft-inserted scrim – 28 mil Weft-Inserted Scrim - An 18 x 14 polyester fabric construction with weft insertion, composed of 840 x 1000 denier threads, provides superior tear and puncture resistance. The polyester thread is treated to prevent wicking.

Total Thickness - 50 mil, nominal.

Weight – 0.29 lb. per square foot. Colors – White, tan, gray, dark gray and terra cotta. R-Value – 0.1 ft²·°F·hr/Btu.

Available Configurations:

Custom-fabricated Sections – DL50 is available in custom-fabricated sections as listed within the Ordering and Estimating section on the Duro-Last

Roll Good - Typical Dimensions

Width	Length (max.)	Roll Area	Approx. Weight	Approx. Coverage ¹
64 inches	100 ft.	534 sq. ft.	155 lb.	483 sq. ft.
64 inches	50 ft.	267 sq. ft.	78 lb.	241 sq. ft.
32 inches	100 ft.	267 sq. ft.	78 lb.	217 sq. ft.
12 inches	100 ft.	100 sq. ft.	29 lb.	N/A
8 inches	100 ft.	67 sq. ft.	20 lb.	N/A
1 Assuming 6-	inch overla	p.		

Energy Efficiency:

White DL50 membrane is an excellent product for complying with California Title 24, LEED® and other energy efficiency programs requiring the use of a highly reflective roof membrane. It is an ENERGY STAR[®] qualified product.

Cool Roof Rating Council (CRRC)

230//	boor Roor Rating Council (CRRC)													
	CRRC ID	Solar I hermal Reflectance Reflectance		Solar I hermal Ref				Reflectance Emittance Re		Solar I hermal Reflectance Reflectance		Refle	olar ective x (SRI)	
		Initial	3-yr	Initial	3-yr	Initial	3-yr							
White	0610- 0001	0.88	0.68	0.87	0.84	111	82							
Tan	0610- 0005	0.39	0.33	0.89	0.89	43	35							
Gray	0610- 0004	0.47	0.40	0.89	0.89	54	45							
Dark Gray	0610- 0006	0.26	0.25	0.88	0.89	26	25							
Terra Cotta	0610- 0009	0.26	0.24	0.89	0.88	26	23							

LEED & LEED-EB Credits - White DL50

membrane alone can obtain 1 credit in either U.S. Green Building Council's LEED or LEED-EB programs. In combination with other design criteria the membrane may help attain other credits.

LEED Credit Category	Duro-Last Attribute
Sustainable Sites Credit 7.2 Heat	Solar Reflective Index (SRI) SRI
Island Effect: Roof	= 111
LEED-EB Credit Category	Duro-Last Attribute
Sustainable Sites Credit 6.2 Heat	ENERGY STAR Qualified

Island Effect: Roof ENERGY STAR Qualified Thermal Emittance = 0.87 NSF/ANSI 347 PLATINUM CERTIFIED

The following warranties are available for projects utilizing DL50 membrane. Contact Duro-Last for warranty details.

<u> </u>							
	Ava	ilable Warraı	nties				
Supreme	15-Year NDL Warranty	20-Year NDL Warranty – 15 Years Consequential Damages And 5 Years Material		V – Cor Dam	Year NDL Varranty 15 Years sequential ages And 5 Material and Labor		
Ultra	15-Year NDL Hail Warranty ¹	15-Year NDL Hail & High Wind Warranty ¹	15-Year NDL High Wind Warranty ¹		20-Year NDL High Wind Warranty ¹		
Basic	15-Year NDI	_ Warranty ¹	20-Year NDL W		L Warranty ¹		
Residential	15-Year Romaterial Limite	4	20-Year Residential Material Limited Warranty				

www.duro-last.com

800-248-0280 1 of 2 Duro-Last, "World's Best Roof", and Duro-Bond are registered trademarks owned by Duro-Last, Inc.

LEED is a registered trademark owned by the U.S. Green Building Council. ENERGY STAR is a registered trademark owned by the U.S. Environmental Protection Agency.

Created: 08/17/2012 Revised: 09/01/2012, 11/19/2013, 05/28/2014, 06/05/2014, 01/23/2015, 05/18/2015, 01/22/2016, 02/15/2016, 06/29/2016, 08/15/2017, 03/29/2019

DURO-LAST® 50-MIL MEMBRANE

Codes and Standards

Underwriters Laboratories (US & Canada), UL Evaluation Report (ER10128), FM Approvals, Canadian Construction Materials Centre (CCMC 13299-L), State of Florida, Miami-Dade County, Texas Department of

Store rolls lengthwise on pallets. Use tarps to keep rolls dry.

Membrane Attachment:

Mechanically Fastened – DL50 membrane may be mechanically fastened to a variety of roof deck and wall materials. An appropriate slip sheet or cover board may be required. Refer to the Duro-Last Mechanically Fastened Roofing System Specification for custom-fabricated system requirements. If using roll goods, refer to the Roll Good Mechanically Fastened Roofing System Specification.

Duro-Bond® Roofing System – The Duro-Bond Roofing System (induction weld) may be used to attach DL50

membrane. Refer to the Duro-Bond Roofing System Specification for system requirements.

Adhered – DL50 membrane may be adhered to a variety of properly prepared roof decks, walls, cover boards and insulations. Refer to the Adhered Roofing System Specification for system requirements.

DL50 membrane has been subjected to the tests required by ASTM D4434 "Standard Specification for Poly (Vinyl Chloride) Sheet Roofing" and has been classified as a Type III, internally reinforced sheet. The results of each test are listed below. ASTM's Overall Thickness requirements for the membrane are plus or minus 10% (nominal) of the listed Typical Value

Physical Property	Test Method	ASTM D4434 Requirement	Result	Typical Value
Overall Thickness	ASTM D751	≥ 0.045 and ≤ 0.055 in. (≥ 45 and ≤ 55 mil)	PASS	0.050 in. (50 mil), nomina
Thickness Over Scrim	ASTM D7635	≥ 0.016 in.	PASS	0.028 in. (28 mil)
Breaking Strength ¹	ASTM D751 Grab Method	≥ 200 lbf./in.	PASS	438 x 390 lbf./in.
Elongation ¹	ASTM D751 Grab Method	≥ 15%	PASS	31% x 31%
Seam Strength	ASTM D751 Grab Method	≥ 328 lbf. (75% of Breaking Strength.)	PASS	417 lbf.
Tear Strength ¹	ASTM D751 Procedure B	≥ 45 lbf.	PASS	132 x 163 lbf.
Low Temp. Bend	ASTM D2136	Must pass at -40° F	PASS	PASS
Heat Aging	ASTM D3045	Conditioned for 56 days in oven maintained at 176° F.	PASS	PASS
Accelerated Aging	ASTM G155	10,000 hours total test time. Irradiance level of 0.35 W/m²-340nm. Cycle: 102 minutes light, 18 minutes light + H₂0 spray, 63±2.5° C black panel, 30±5% RH	PASS	PASS
Dimensional Stability ¹	ASTM D1204	Conditioned for 6 hours in oven maintained at 176° F. Allowable change: ≤ 0.5%	PASS	-0.30% x -0.45%
Water Absorption	ASTM D570	Immersed in water at 158° F for 168 hours. Allowable weight change: ≤ 3%	PASS	1.7%
Static Puncture	ASTM D5602	≥ 33 lbf.	PASS	56 lbf.
Dynamic Puncture	ASTM D5635	≥ 14.7 ft-lbf. (20 J)	PASS	≥ 14.7 ft-lbf. (20 J)

Additional Tests Fungi Resistance

Moisture Vapor Transmission



¹ Typical values are shown for both machine and cross machine directions. The machine direction results are listed first.

ASTM G21










No Sustained Growth or Discoloration

800-248-0280 www.duro-last.com Duro-Last, "World's Best Roof", and Duro-Bond are registered trademarks owned by Duro-Last, Inc.


LEED is a registered trademark owned by the U.S. Green Building Council. ENERGY STAR is a registered trademark owned by the U.S. Environmental Protection Agency
Created: 08/17/2012 Revised: 09/01/2012, 11/19/2013, 05/28/2014, 06/05/2014, 01/23/2015, 05/18/2015, 01/22/2016, 02/15/2016, 06/29/2016, 08/15/2017, 03/29/2019

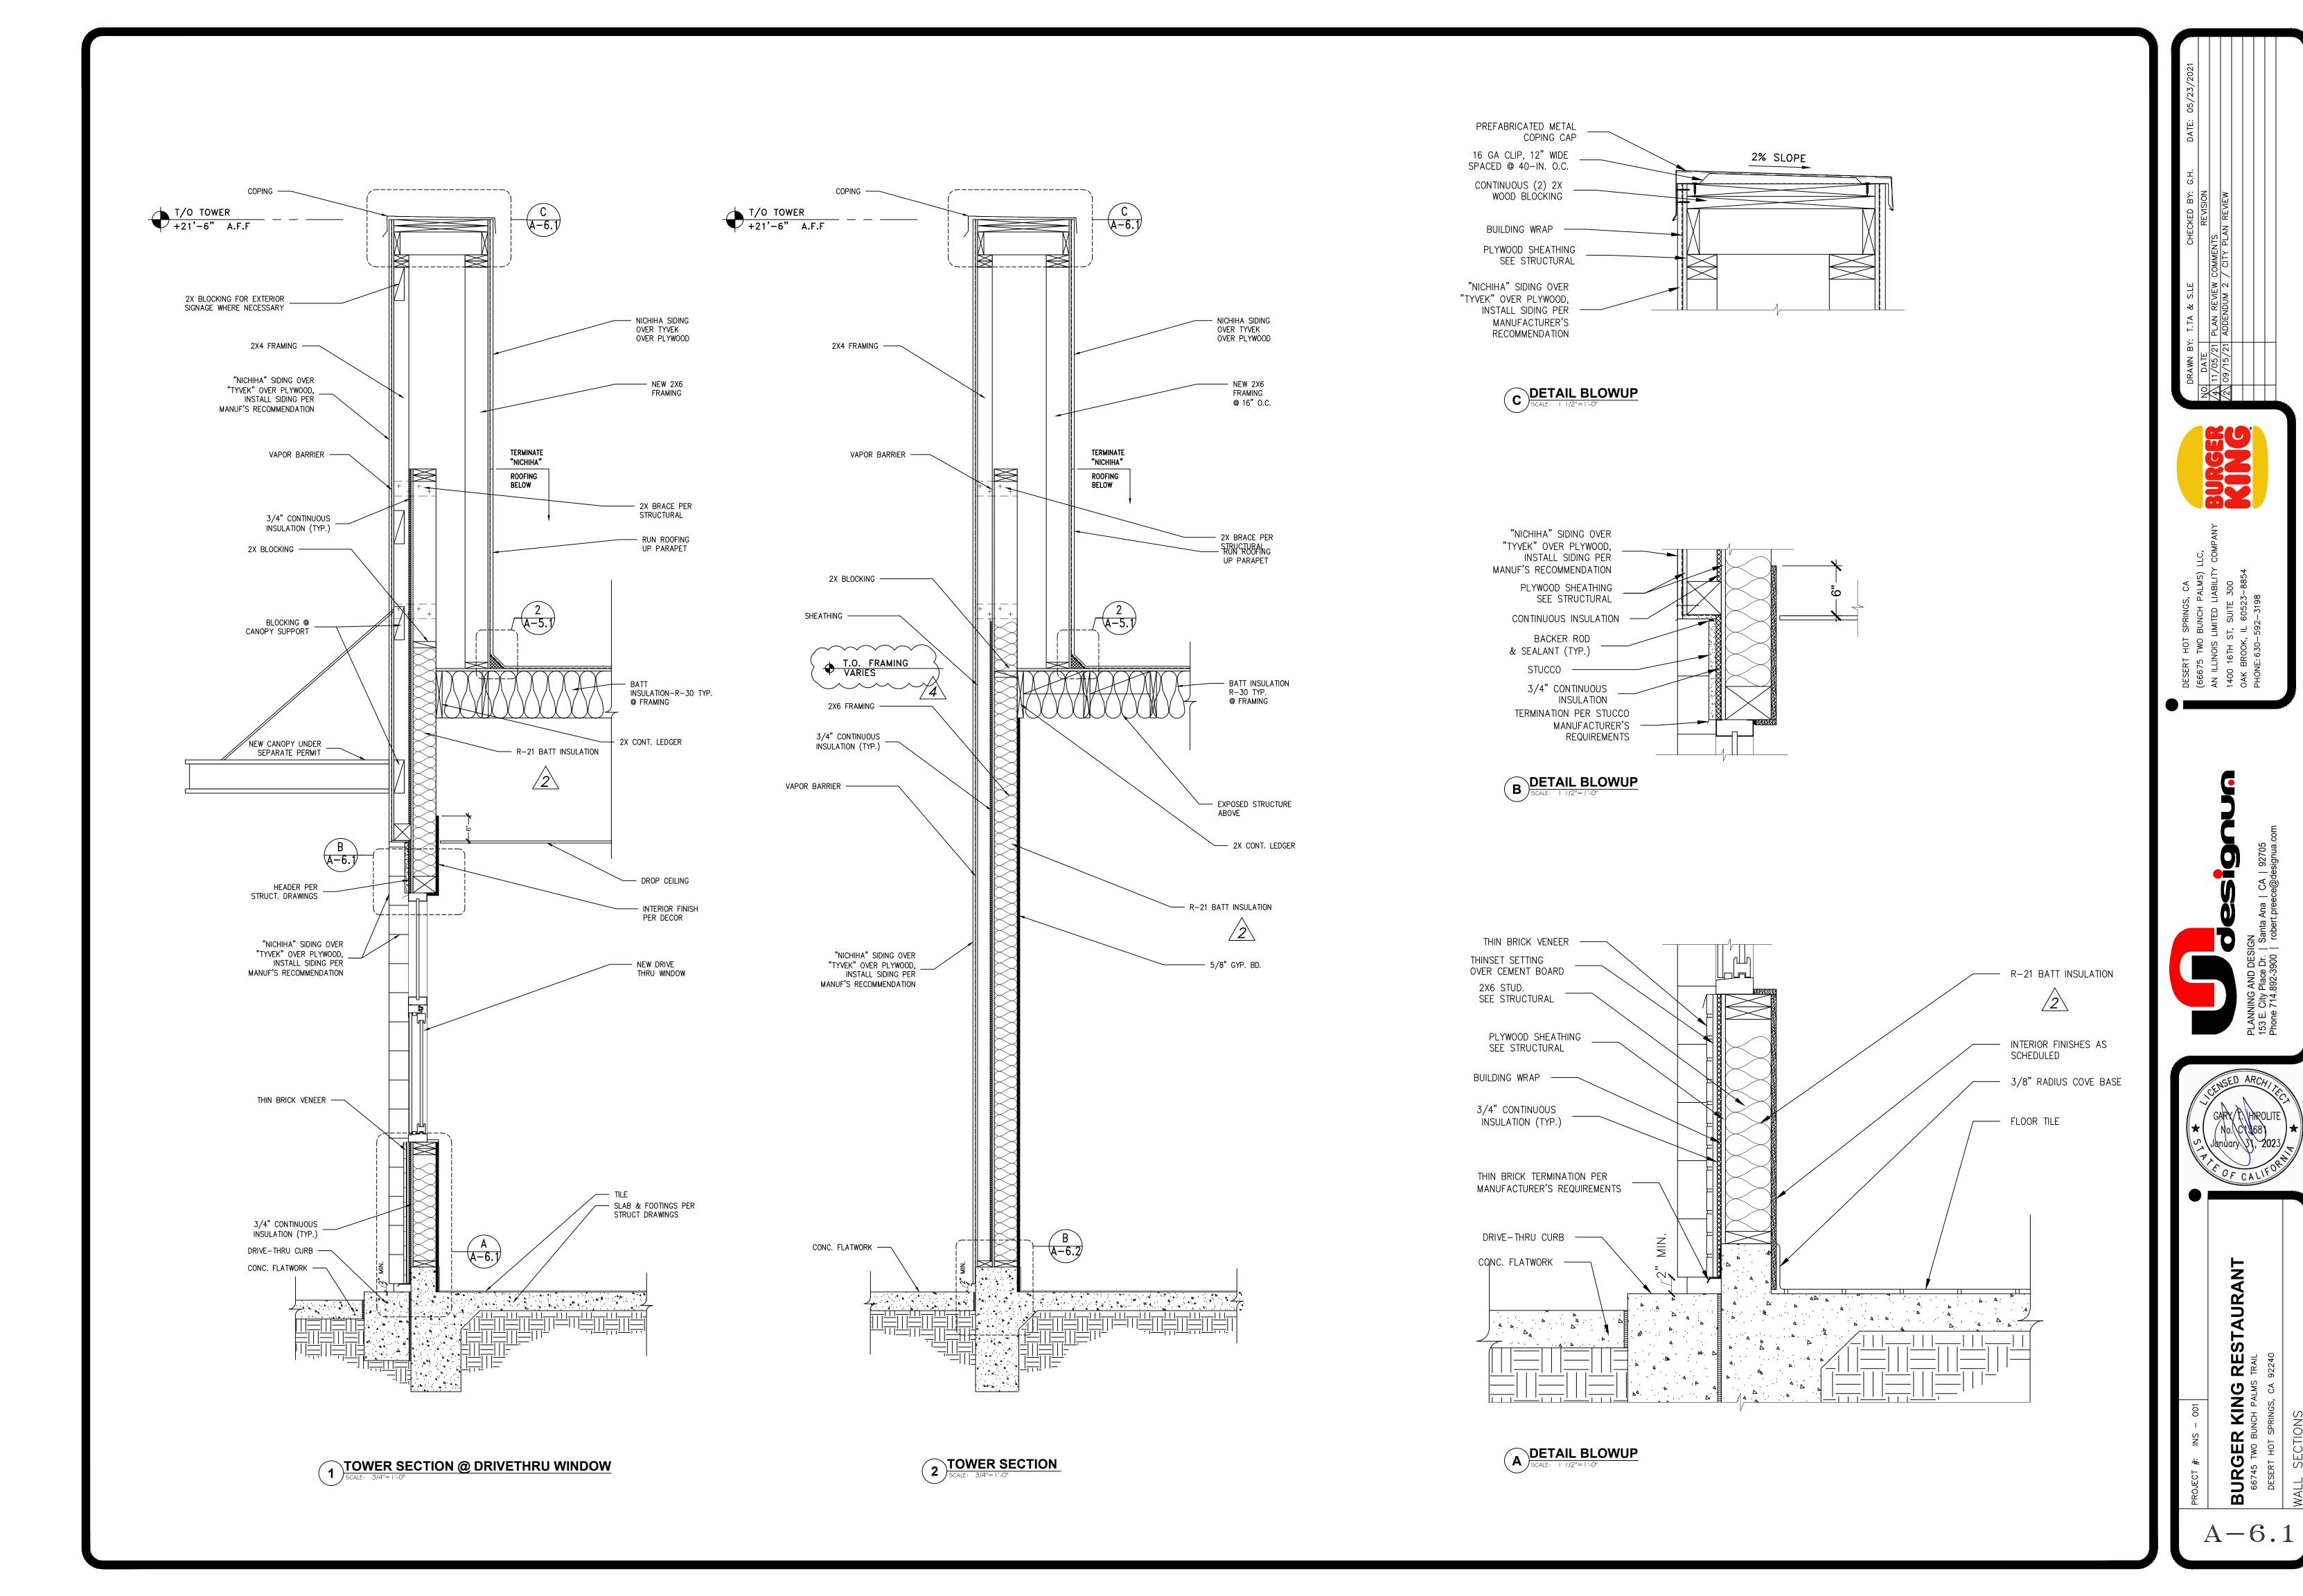


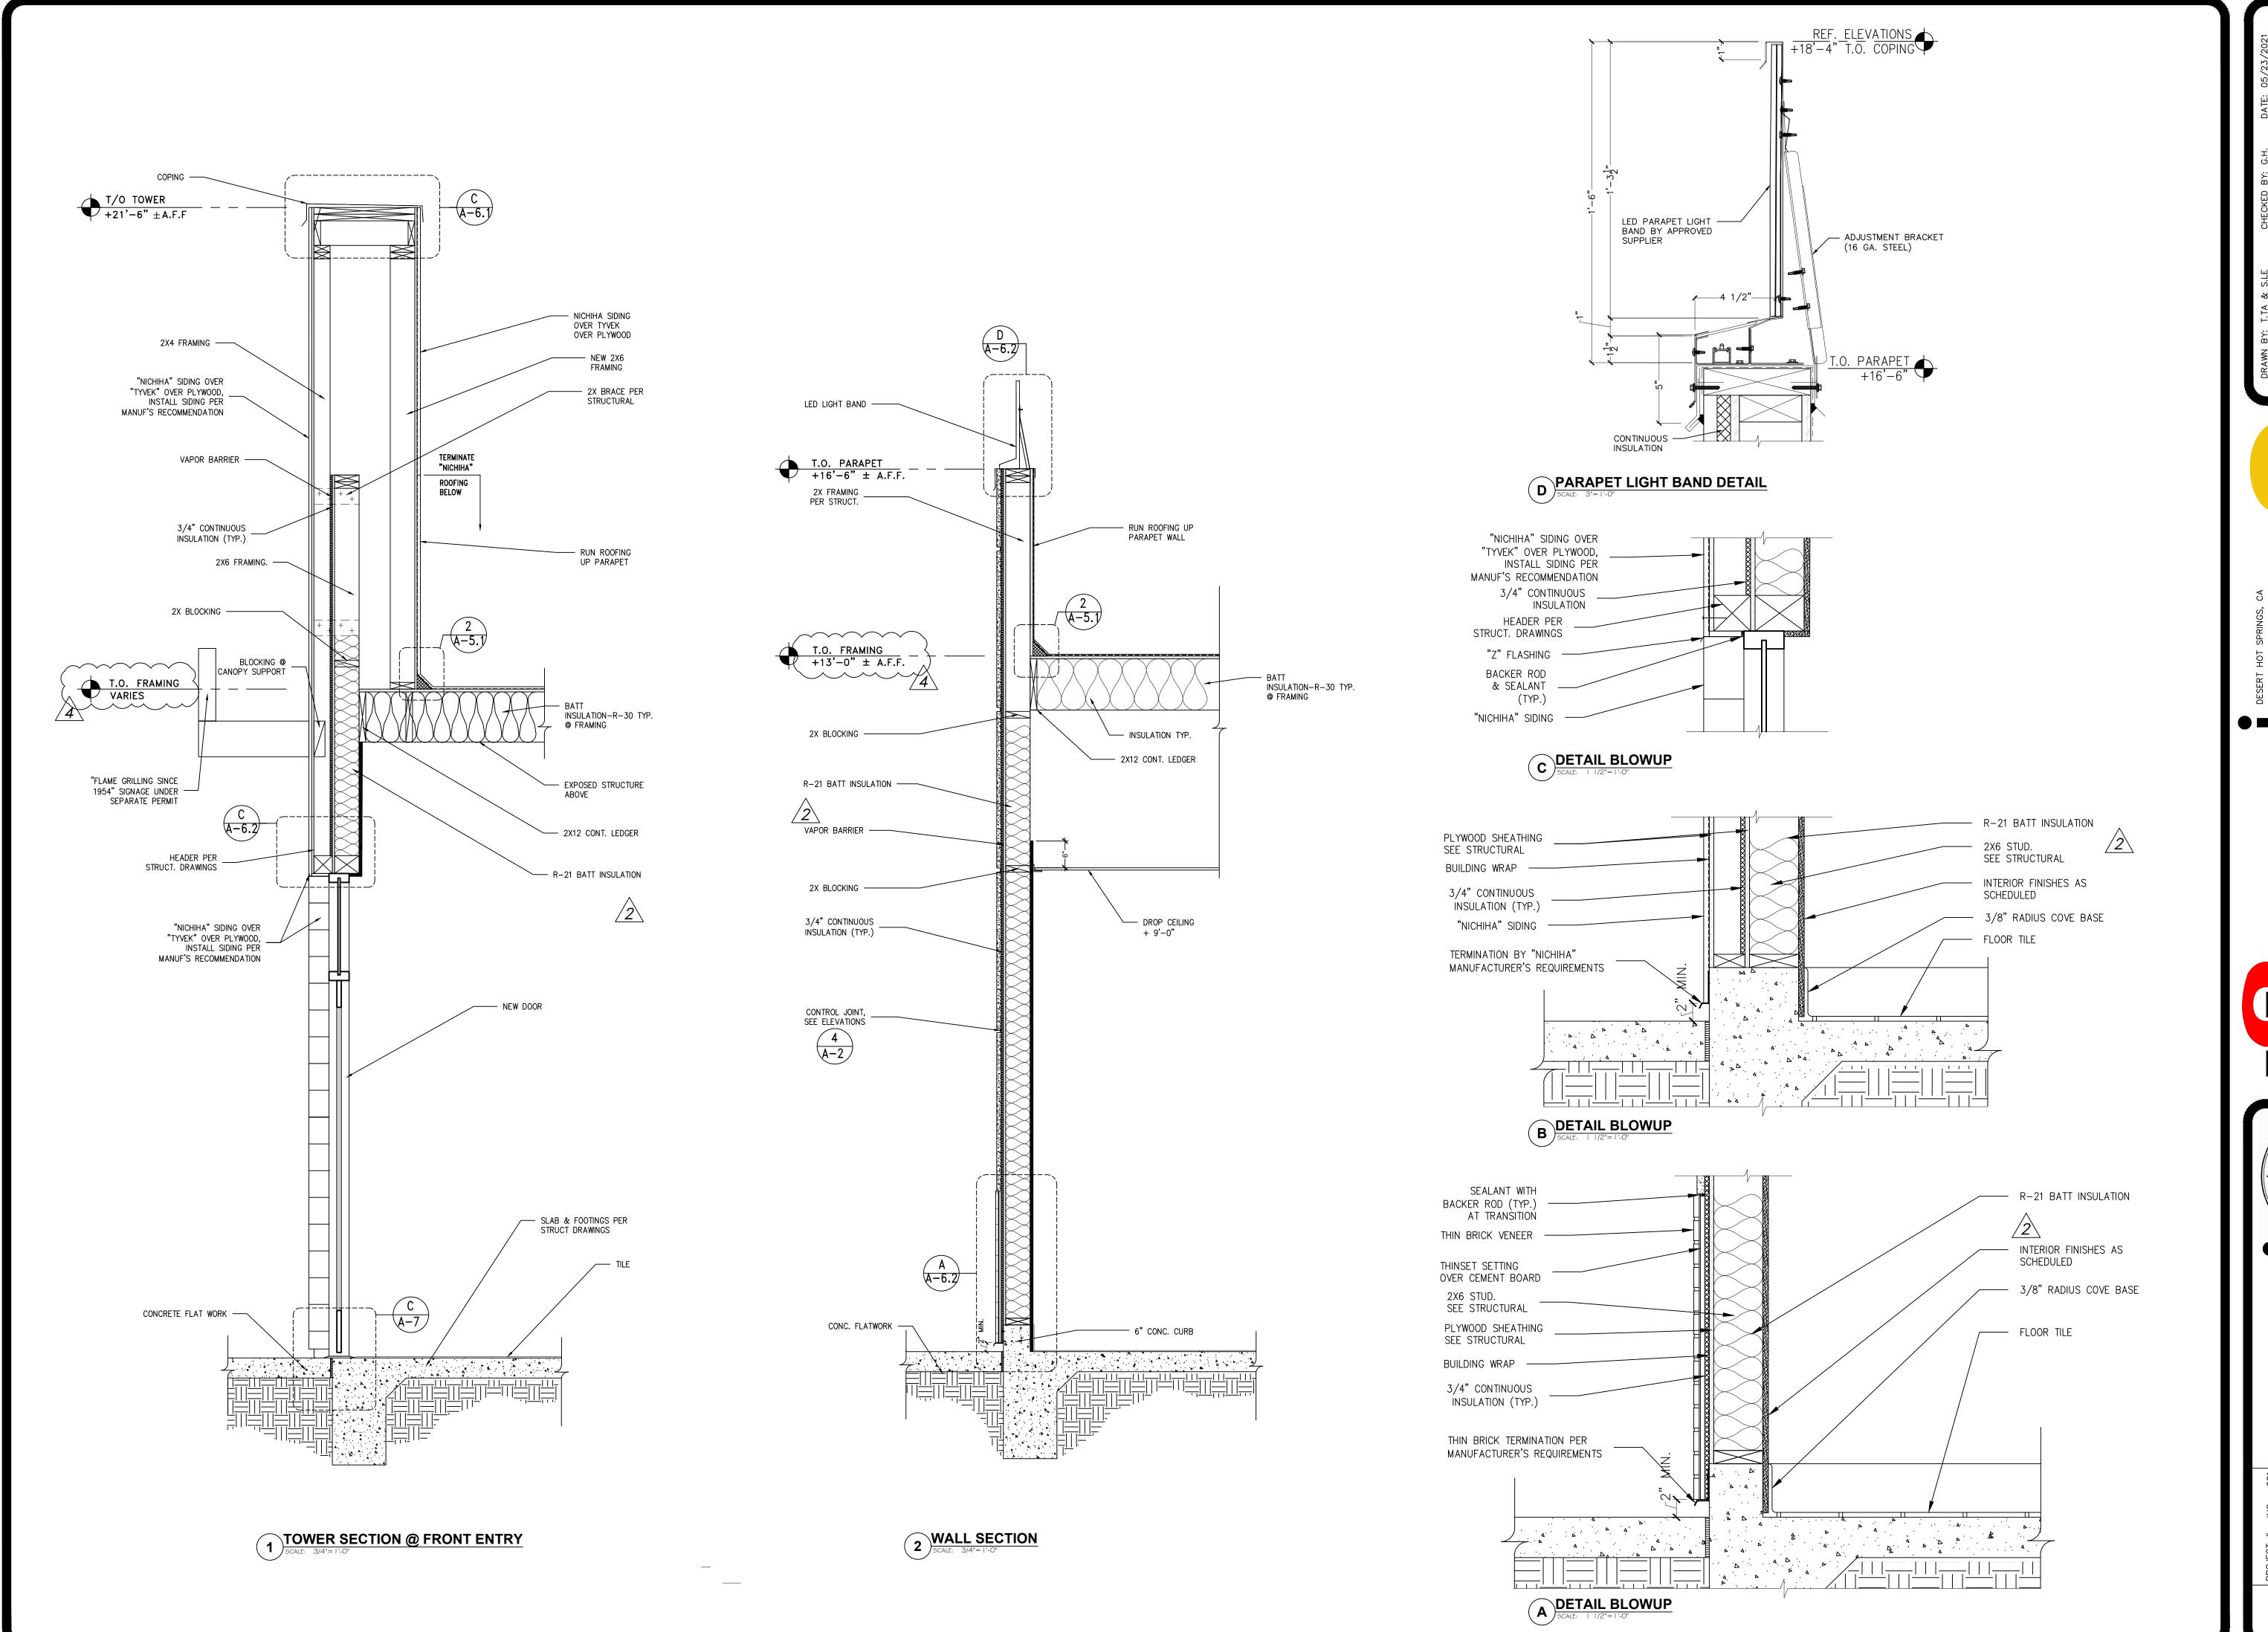

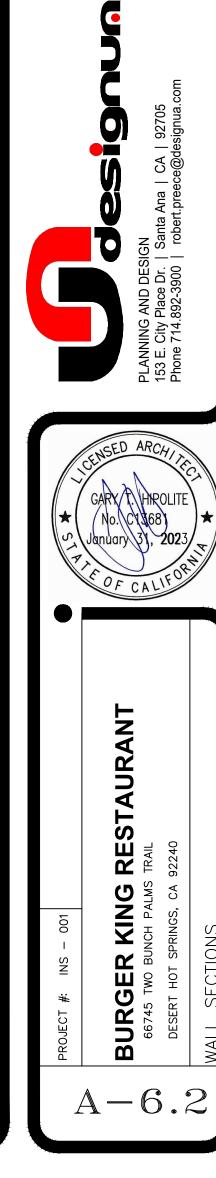


PLAN REVIEW COMMENTS ADDENDUM 2 / CITY PLAN

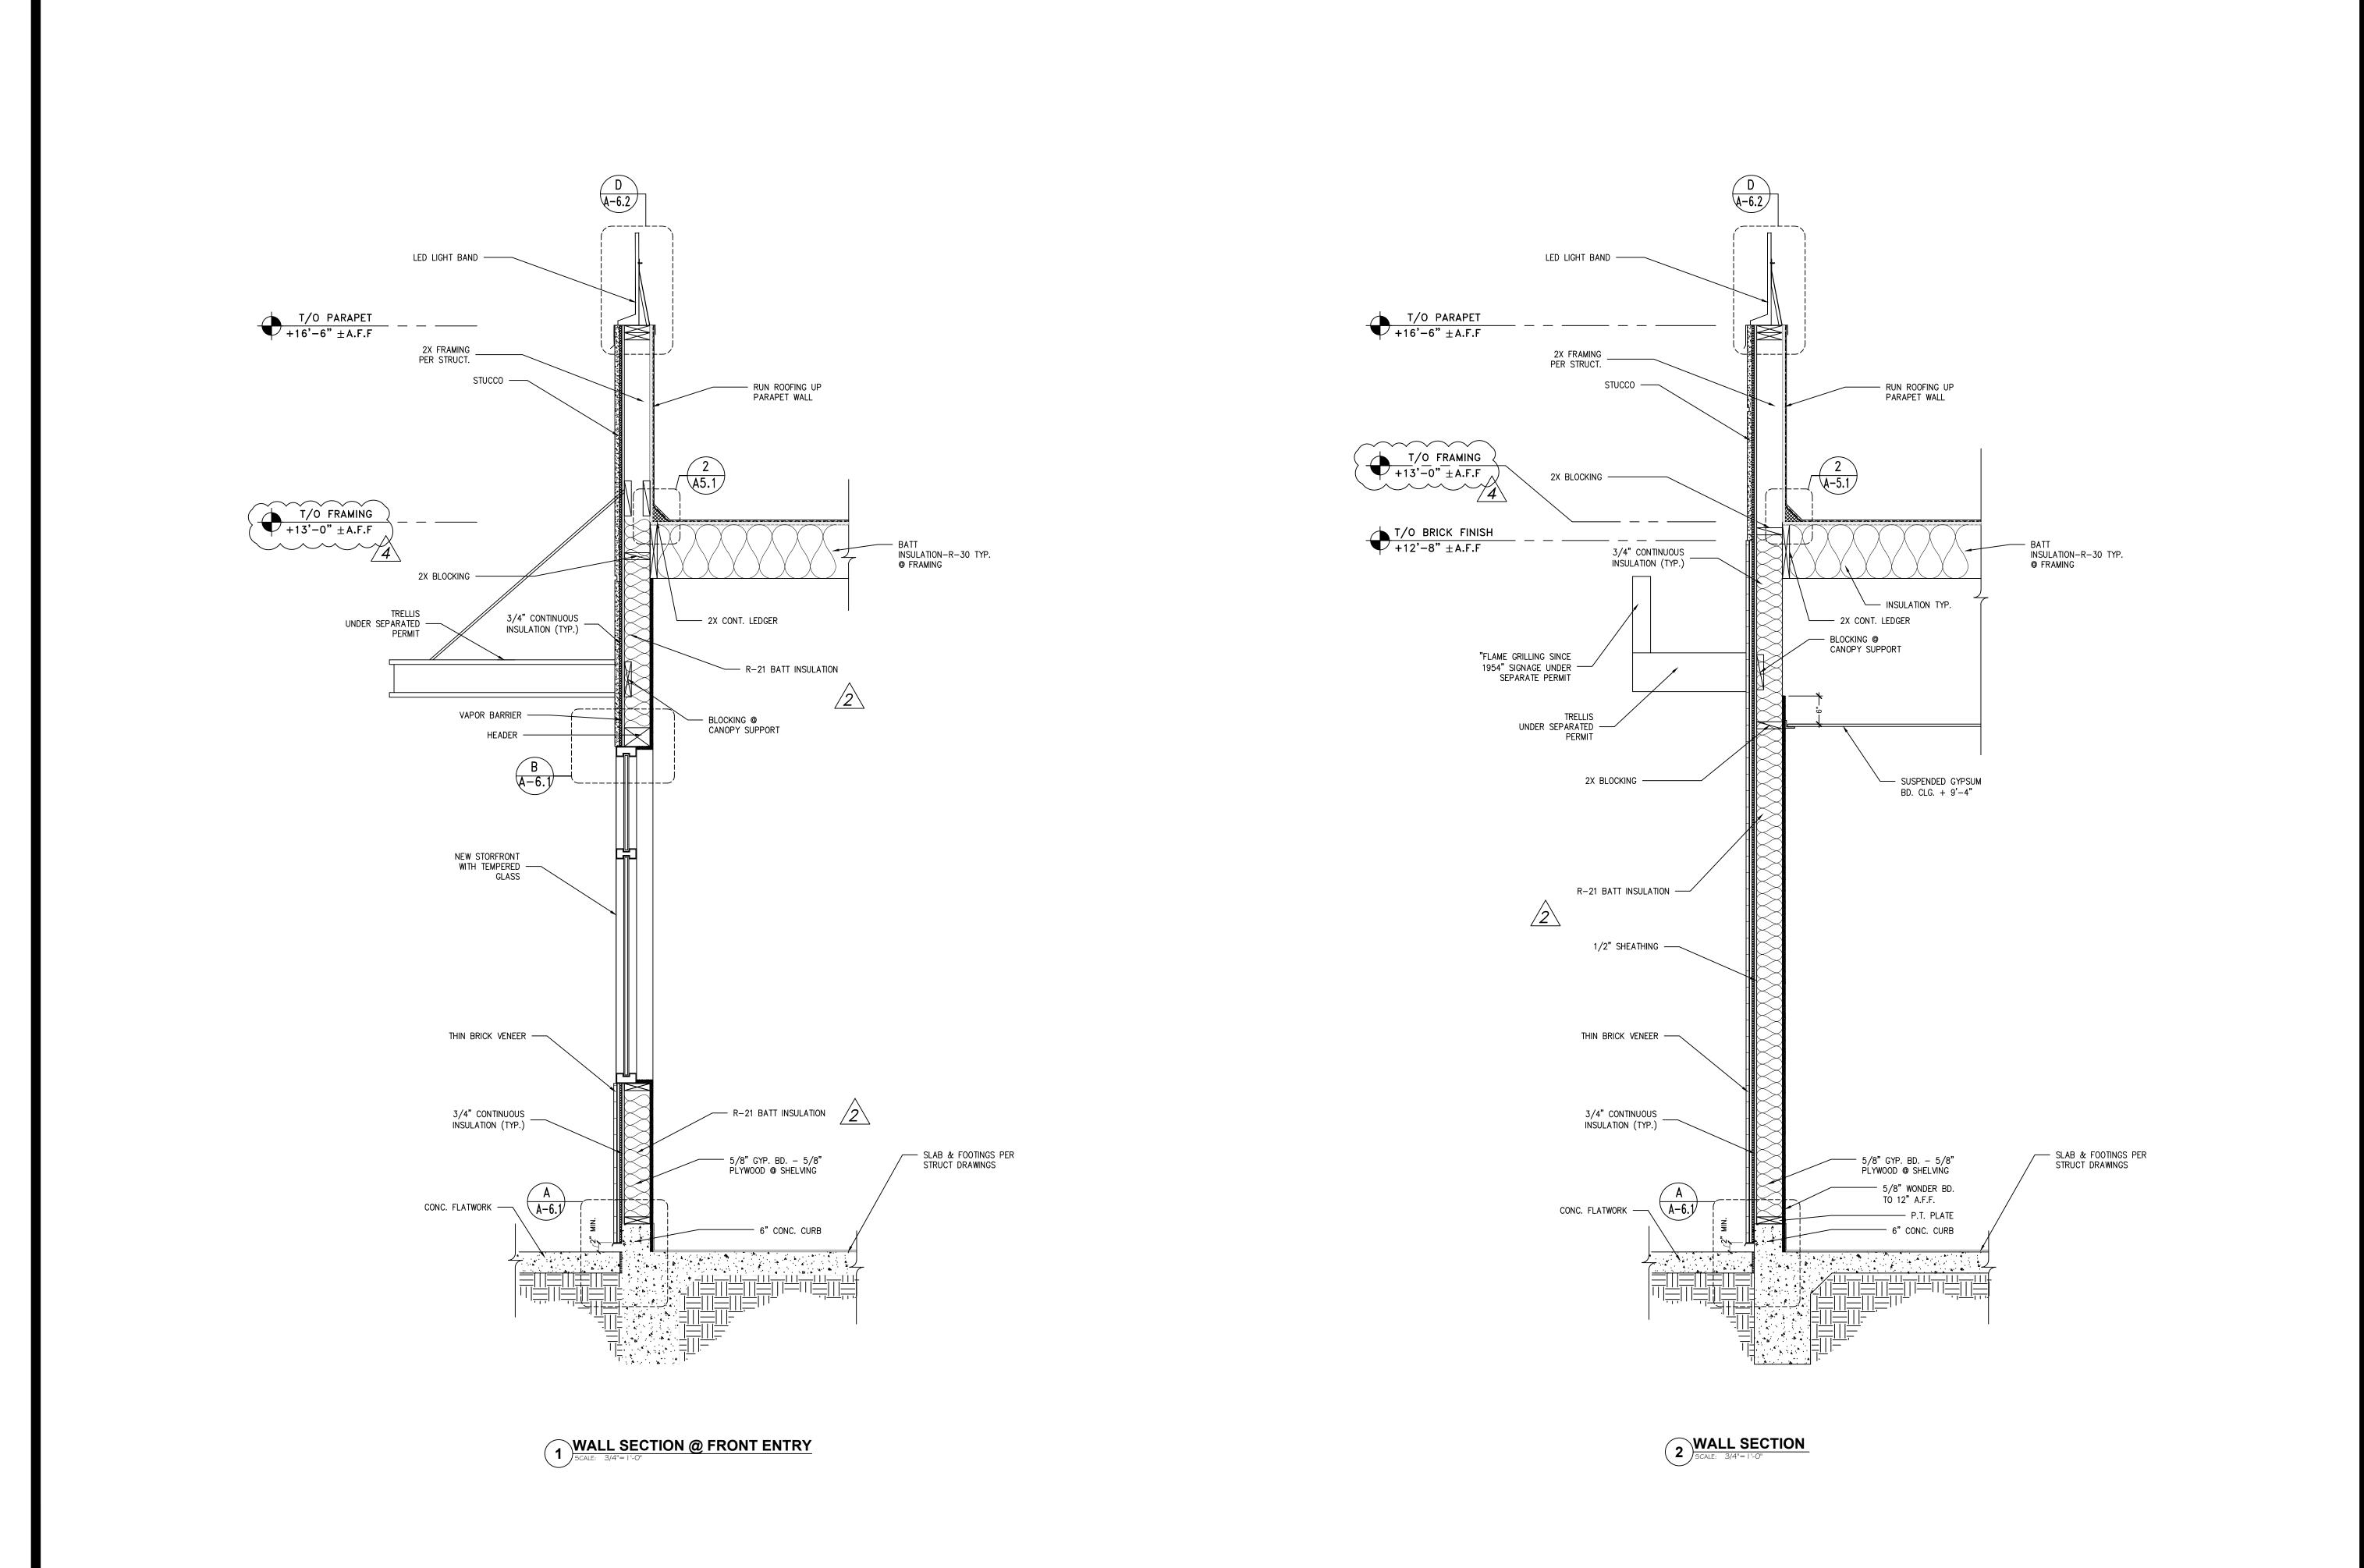


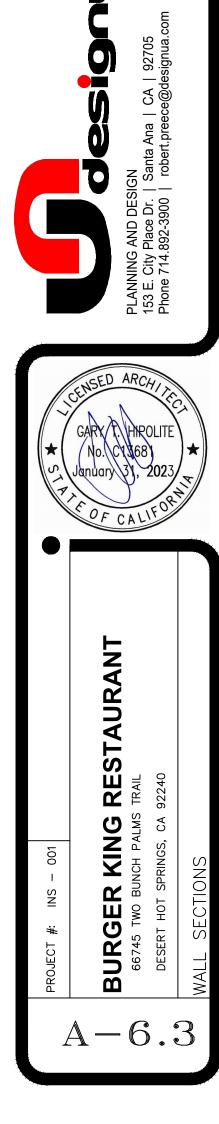



PLAN REVIEW COMMENTS ADDENDUM 2 / CITY PLAN

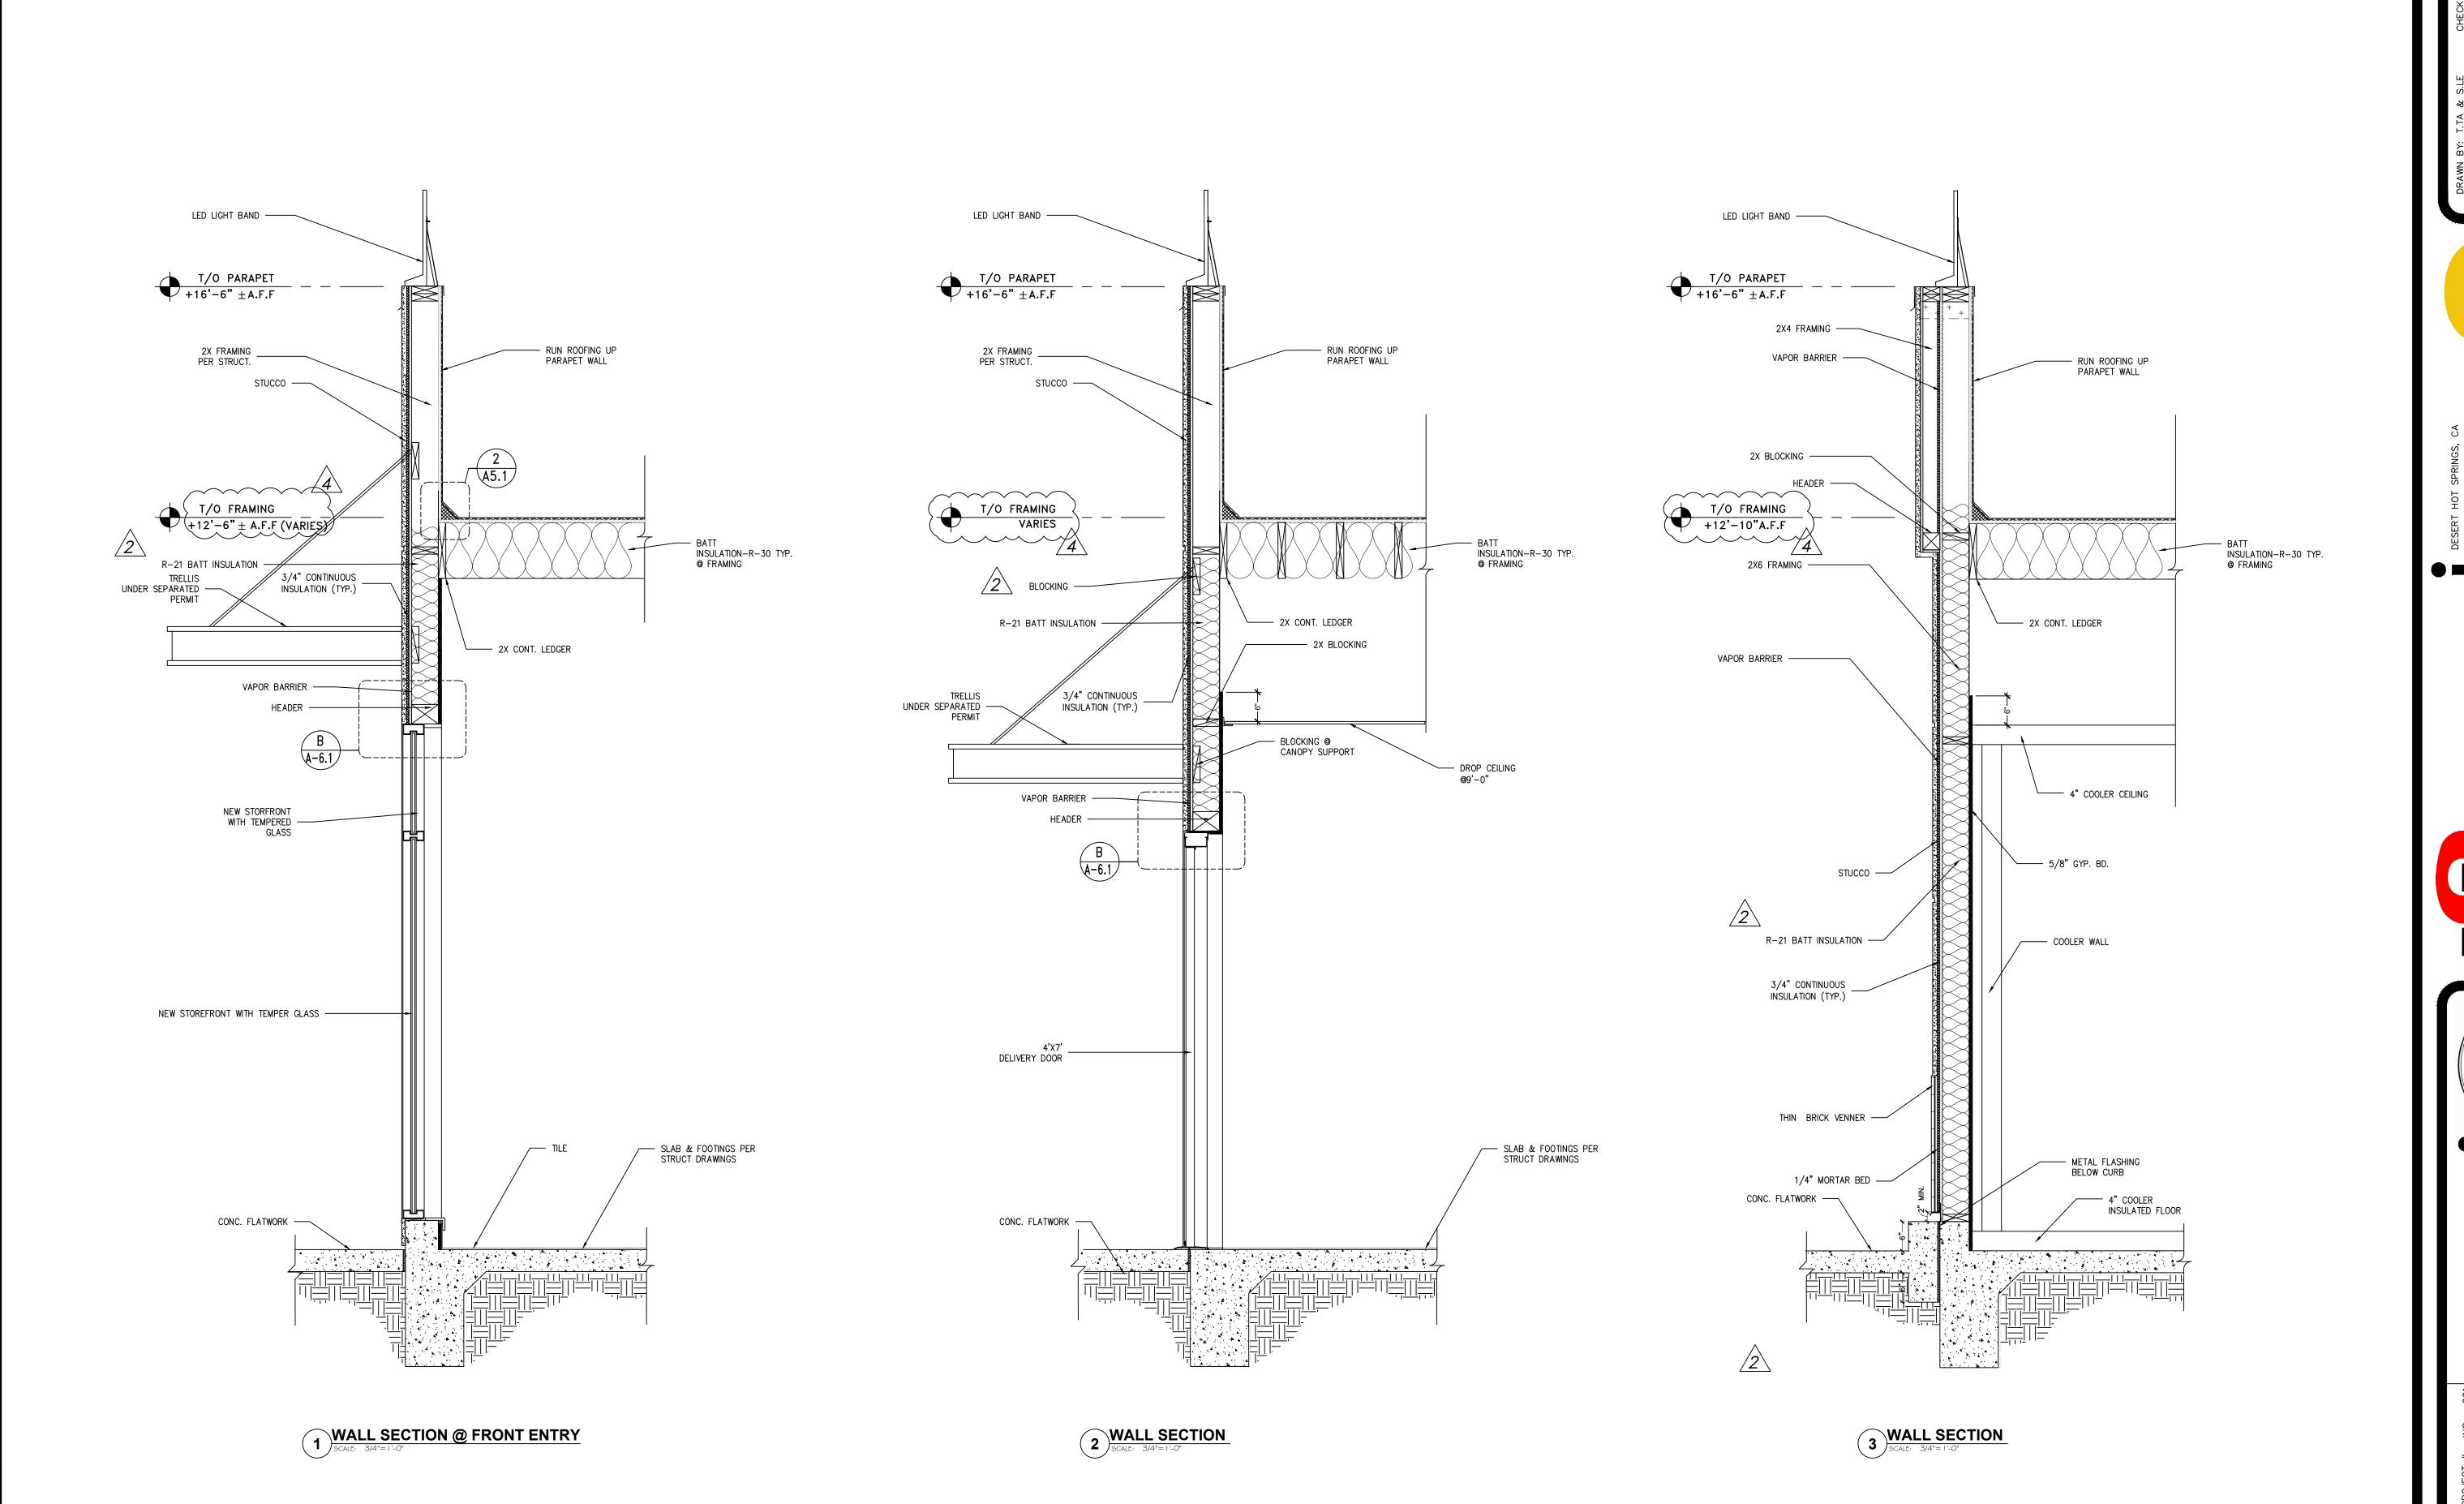




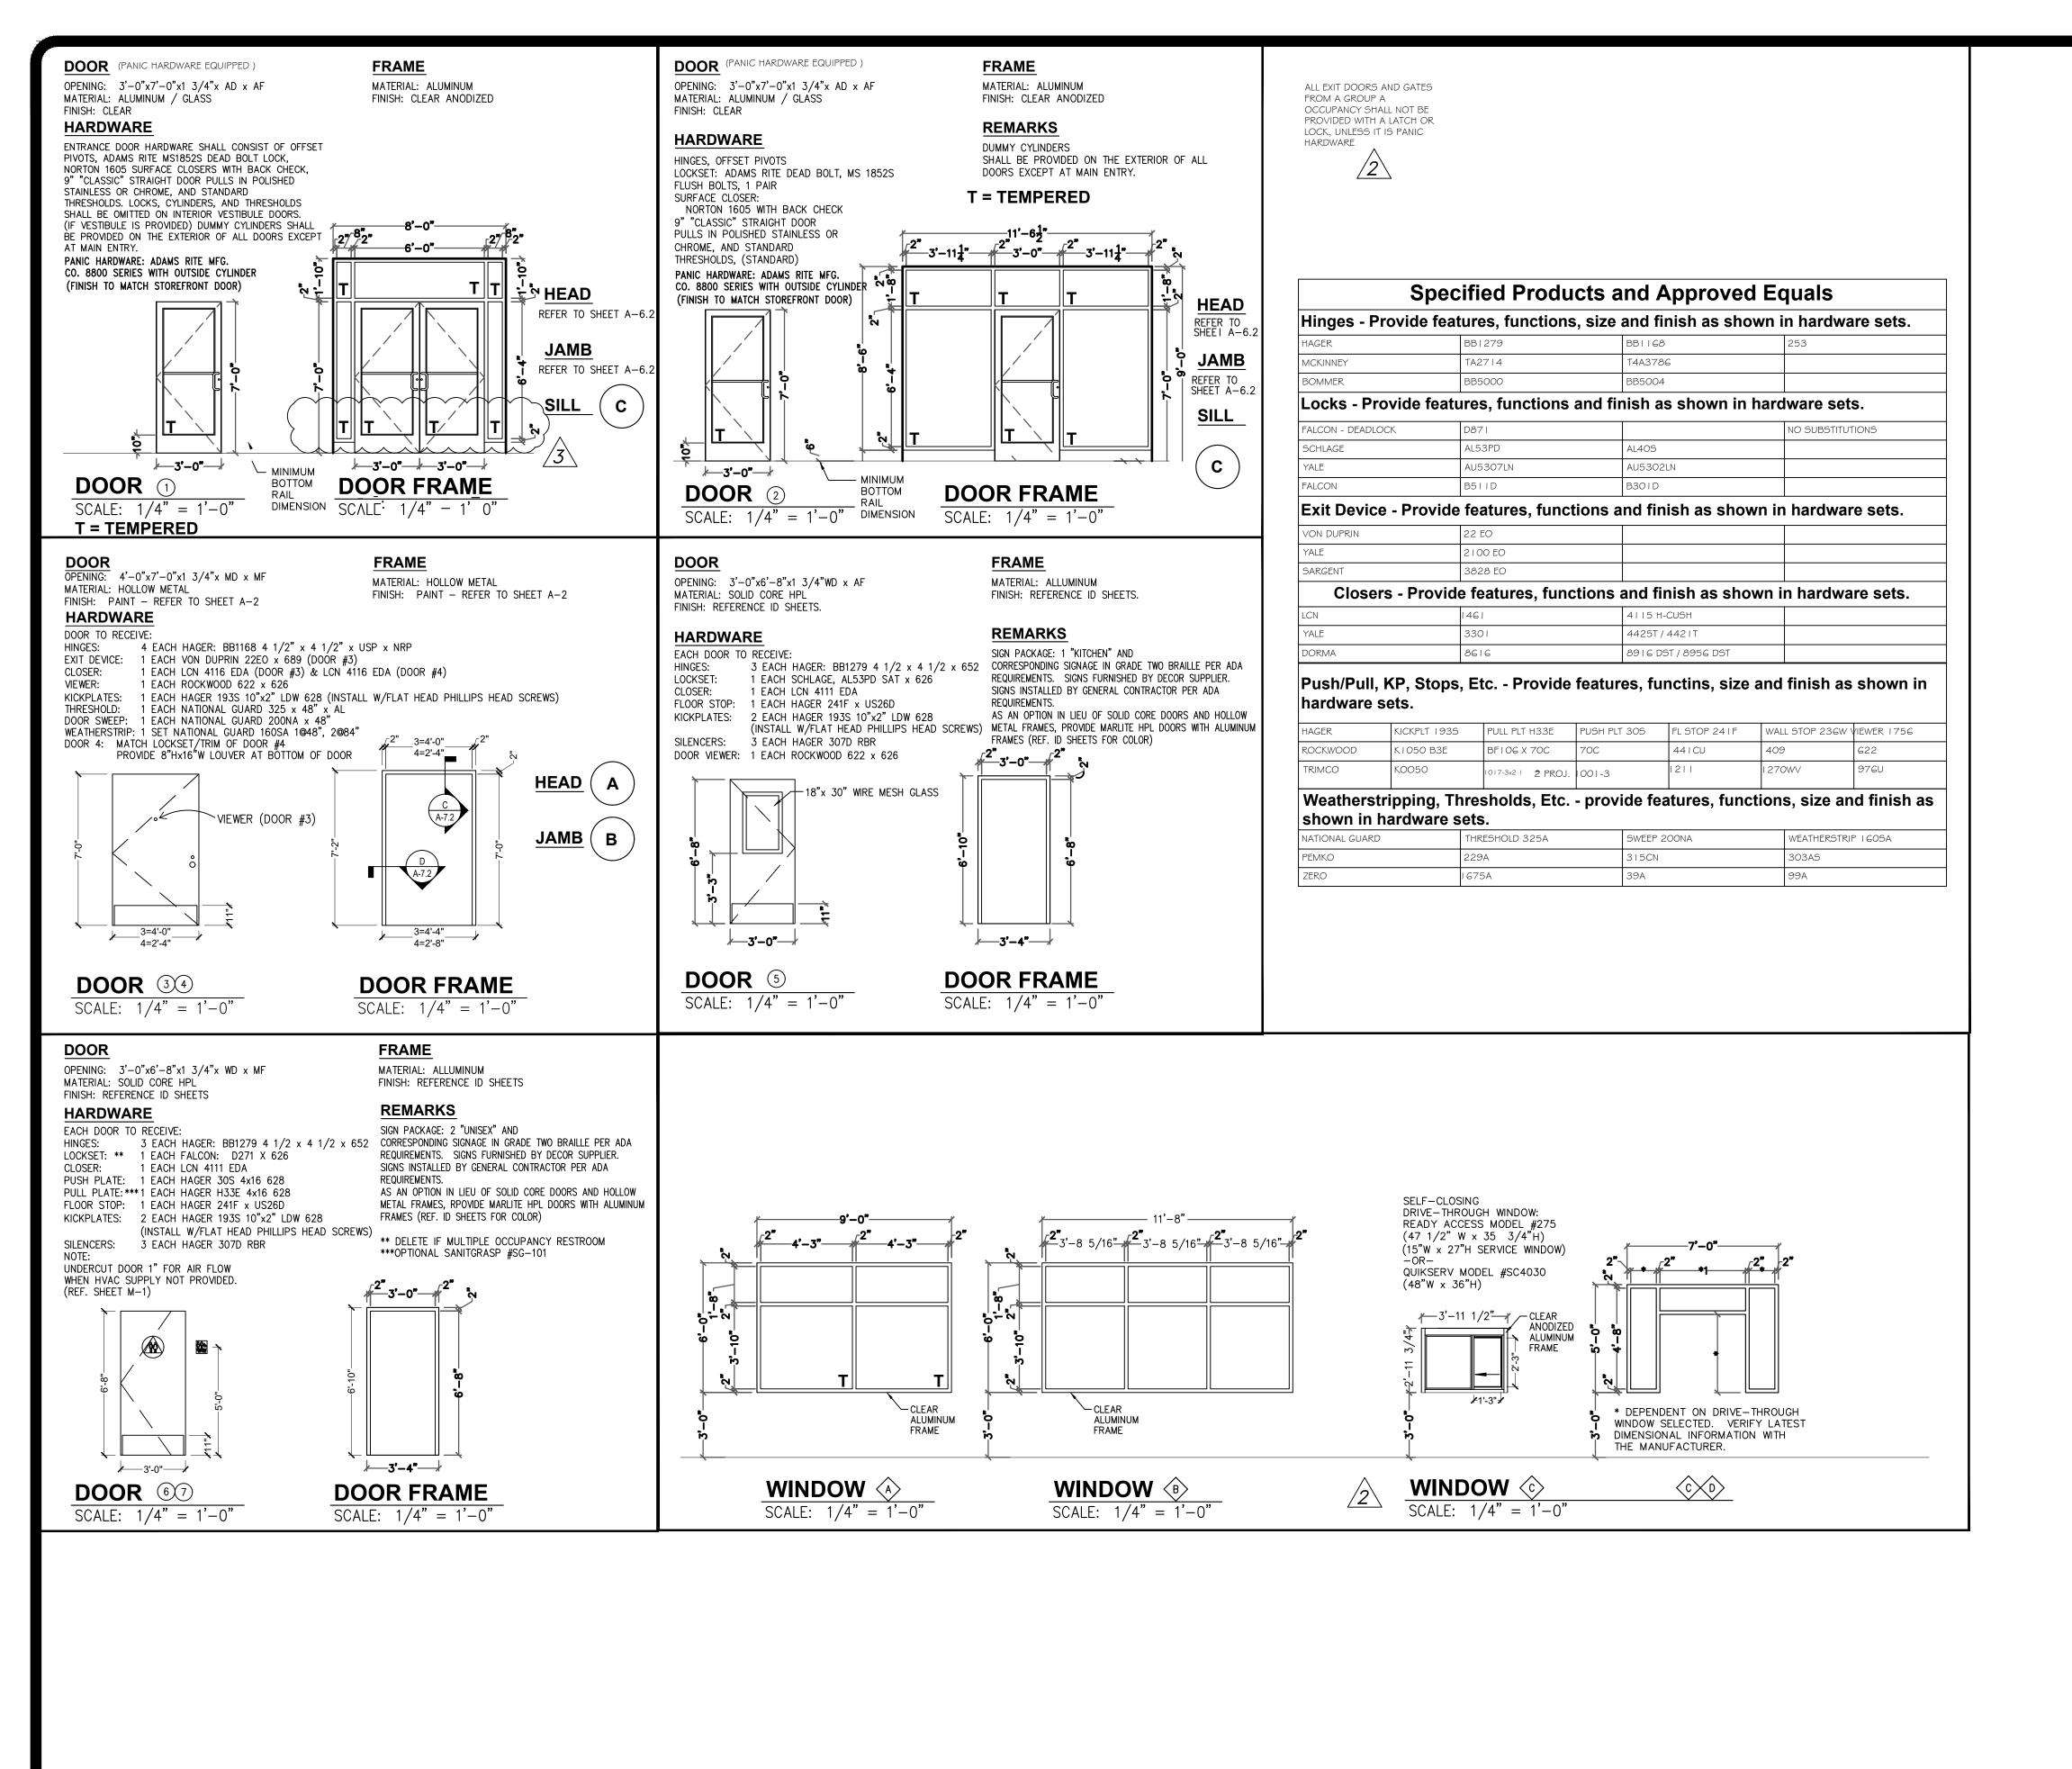

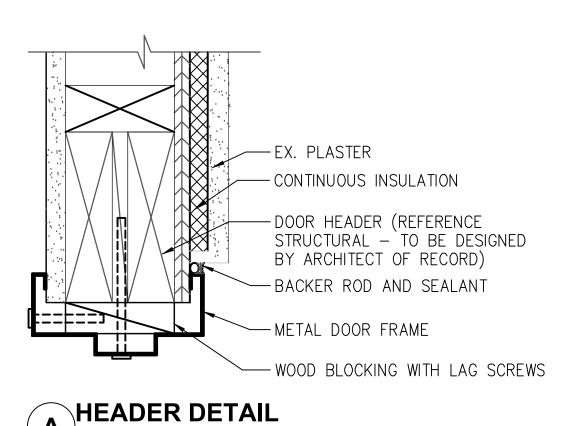

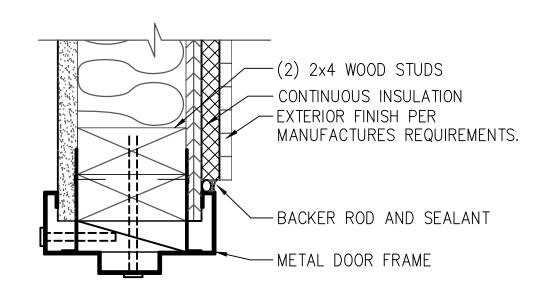



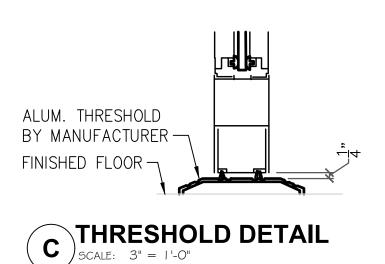





KINGH PALMS

A-7

DIVISION 4 - MASONRY

PINE HALL BRICK CO. (THIN BRICK & FACE BRICK) 2701 SHOREFAIR DRIVE, NW WINSTON-SALEM, NC 27105 THERESA BEANE: (800) 334-8689 TBEANE@PINEHALLBRICK.COM

EVOLUTION BRICK (THINK BRICK, PANELIZED THIN BRICK & FACE BRICK) 126 OLD HIGHWAY 60 EAST HARDINSBURG, KY 40143 GABE POWERS: (502) 558-4612 gabe@evolutionbrick.com

DIVISION 5 - METALS

ADDISON STEEL (STRUCTURAL STEEL) ADDISON, IL 256-747-1554

DIVISION 7 - THERMAL MOISTURE

DIVISION 8 - DOORS AND WINDOWS

(DRIVE-THRU WINDOWS & AIR CURTAINS)

(DRIVE THRU WINDOWS & AIR CURTAINS)

11441 BRITTMOORE PARK DRIVE

HOUSTON, TX. 77041

BRIAN MCCLOSKEY

CHICAGO, IL. 60185

kelly@ready-access.com

1865 LEONARD AVENUE

COLUMBUS, OH 43219

FINGERSAFE USA, INC.

SAVANNAH, GA 31401

orders@fingersafe.com

Meagan@Fingersafe.com

READY ACCESS

bmccloskey@quikserv.com

1815 ARTHUR DRIVE WEST

HAMILTON PARKER COMPANY

JIM CAMPBELL 614-358-7806

jimcampbell@hamiltonparker.com

115 WEST OGLETHORPE AVENUE

MEAGAN KUJAWSKI 912-234-6120

DURO-LAST ROOFING (FLAT ROOFING) 525 MORLEY DRIVE SAGINAW, MI 48601 LINDY BEUTHIN: 800-432-9331 SAMANTHA PICKELMAN 989-758-1048 OR 989-930-9826

BERRIDGE ROOFING (METAL ROOF) TYLER HALL SAN ANTONIO, TX. 210-650-7047

TAMKO ROOFING PRODUCTS (FLAT ROOFING) P.O. BOX 1404 JOPLIN, MO. 64802 800-641-4691

(FLAT ROOF) 1361 ALPS ROAD WAYNE, NJ. 07470 (201) 628-3000 800-766-3411

QUIKSERV

800-388-8307

(FACE BRICK) 4875 BRADSHAW ROAD SACRAMENTO, CA 95827 ERIN LYNCH 916-206-7831

HC MUDDOX BRICK CO.

BORAL STONE (MANUFACTURED STACKED STONE) 1370 GRAND AVENUE, SUITE B SAN MARCOS, CA 92078 JOAN SCRUGGS 760-407-5873 jscruggs@boral.com

FIRESTONE METAL PRODUCTS

YUSUKE KOREEDA: 615-345-9991

MATT STEPHENSON 770-805-9466

6465 EAST JOHNS CROSSING, SUITE 250

(POLYURETHANE ROOFING SYSTEMS)

koreedayusuke@firestonebp.com

250 WEST 96TH STREET

INDIANAPOLIS, IN 46260

(FIBERCEMENT PANELS)

JOHNS CREEK, GA 30097

mstephenson@nichiha.com

BASF CORPORATION

HOUSTON, TX 77054

mrussso@nichiha.com

1703 CROSS POINT AVE

MICHAEL RUSSO: 770-805-9466

(RESTROOM PARTITIONS.COMPLETE

202 HARGER STREET

ANITA CRAIG 330-260-7621

COMMERCIAL INTERIORS

DOVER, NH 44622

acraig@Marlite.com

MANUFACTURING

158 HOLLY STREET

JASPER, GA 30143

(WINDOW FILM)

ST. PAUL, MN

3M CENTER

800-377-1221

DOOR PACKAGES, DOOR HARDWARE)

(RESTROOM PARTITIONS, HOLLOW METAL

JOE CIAMPI: 704-771-2449 OR 800-328-0033

HARDWARE (HINGES, LOCKS, ETC)

3M COMMERCIAL CORE DIVISION

(METAL ROOF)

NICHIHA USA LLC

culturedstone@boral.com 310 SW 24TH STREET BENTONVILLE, AR 72712 bk@hjcinc.com OR 800-459-7099 BARRY BRYANT: 479-899-3555 barry.bryant@hjcinc.com

AMERICAN STANDARD (RESTROOM ACCESSORIES) 1 CENTENNIAL AVENUE PISCATAWAY, NJ. 08854 CONTACT: HAINES, JONES, & CADBURY (HJC)

WORLD DRYER, CO (HAND DRYERS) CONTACT: HAINES, JONES, & CADBURY (HJC) or RESTROOM REMODELS COMPANY

or RESTROOM REMODELS COMPANY

SAN JAMAR (KITCHEN PAPER TOWEL DISPENSERS & SUPPLIES) 555 KOOPMAN LANE ELKHORN, WI. CONTACT: FRANKE, INC. **H&K INTERNATIONAL**

DIVISION 10 - SPECIALTIES

or RESTROOM REMODELS COMPANY

Customer 1st LLC (SAFES) 8899 EAST DAILY ROAD, SUITE #51 PEKIN, IN 47165 MIKE MARCOSA -877-768-9970 mike@customer1stsafes.com

> SPROVERI'S CUSTOM COUNTERS (CORIAN VANITY SINKS) 55 LAURA DRIVE ADDISON, IL 60101 HAINES, JONES, & CADBURY (HJC)

RESTROOM REMODELS COMPANY (FULL RESTROOM PLUMBING CORIAN SINKS ETC) 15 HAMMATT STREET IPSWICH, MA 01938 Krislynn Maciel 978-525-0008 kris@restroomremodels.com

or RESTROOM REMODELS COMPANY

QUALSERV SOLUTIONS

DIVISION 10 - SIGNS AND CANOPIES

ALLEN INDUSTRIES, INC (CANOPIES AND SIGNS) 11351 49TH STREET NORTH CLEARWATER, FL 33762 KEITH WHITLEY 919-410-1234

ENTERA SIGNS (CANOPIES AND SIGNS) 1200 ENTERA DRIVE PANAMA CITY, FL. 32401 850-797-0779 ALAN BRYANT 334-796-3313 alan.bryant@enterabranding.com

SIGN RESOURCE (CANOPIES AND SIGNS) 6135 DISTRICT BLVD. MAYWOOD, CA. 90270 RAMON ORTIZ: 323-326-6463

DAKTRONICS, INC (DIGITAL READERBOARD) 210 DAKTRONICS DRIVE BROOKINGS, SD 57006 sean.campbell@daktronics.com

NRS - NATIONAL READERBOARD SUPPLY (READERBOARD LETTERS & SUPPLIES) 160 PAHLONE PARKWAY PONCHA SPRINGS, CO 81242 Patrick Case 800-243-6676 Sales@nationalreaderboard.com

LEKTRON, INC (LED PARAPET LIGHT BANDS) 7450 E. 46th PLACE TULSA, OK. 74145 ED MILLER 918-622-4978 emiller@lektroninc.com

CUMMINGS SIGNS, INC (CANOPIES AND SIGNS) 105 DALTON PLACE WAY KNOXVILLE, TN 37912 **BROOKE KNIGHT 865-862-4497** brooke.knight@cummingssigns.com FEDERAL HEATH SIGN CO

(CANOPIES AND SIGNS 12704 DUPONT CIRCLE TAMPA FL 33626 FIONA PAUL 813-855-4415 fpaul@federalheath.com

OPTEC DISPLAYS, INC (DIGITAL READERBOARD) 1700 SOUTH DESOTO PLACE ONTARIO, CA 91768 JEFF GATZOW: 888-743-5220 EXT 250 jgatzow@optec-led.com

AND PHOTOMETRICS) 3640 TROUSDALE DRIVE NASHVILLE, TN. 37204 wilg@securitylighting.com

AND PHOTOMETRICS) BATON ROUGE. LA 70809 jennifer@energywisemail.com

> VAOPTO, LLC 5178 WEST PATRICK LANE LAS VEGAS, NV 89188 CHARLES LI 702-517-5789 charles.li@vaopto.com

DIVISION 15 - MECHANICAL

EVERPURE, INC (INSTANT WATER HEATERS) (WATER FILTERS) 1040 MUIRFIELD DRIVE RINNAI NATIONAL ACCOUNT PRICING THROUGH HAINES, JONES, & CADBURY HANOVER PARK, IL. 60133 bk@hjcinc.com OR 800-459-7099 SEAN TEAL 630-306-0296 sean.teal@pentair.com

SELECTO SCIENTIFIC, INC (WATER HEATERS) RHEEM NATIONAL ACCOUNT PRICING (WATER FILTERS) THROUGH 3980 LAKEFIELD COURT HAINES, JONES, & CADBURY SUWANEE, GA. 30024 JUDY COLD 800-635-4017 bk@hjcinc.com OR 800-459-7099 judy@selectoinc.com

3M FOOD SERVICE (WATER FILTERS) ANTUNES (WATER FILTERS) 3M CENTER BLDG. 223-2N-20 180 KEHOE BOULEVARD ST. PAUL, MN. 55144-1000 CAROL STREAM, IL 60188 DAVID RADCLIFF 518-281-7754 MIKE MARSHALL 630-487-3491 mike.marshall@antunes.com dpradliff@mmm.com

ECOLAB (WATER FILTERS) 1801 RIVERBEAND WEST DRIVE FORT WORTH, TX 76118 AL POWELL 816-206-2513 al.powell@ecolab.com

RHEEM

TRANE (AIR CONDITIONING UNITS, RTU's/SPLIT SYSTEMS CONTROLS) 2884 CORPORATE WAY MIRAMAR, FL. 33025 AL MARTINEZ: 954-499-2289 OR 800-440-9554 ken.dickson@tampabay.rr.com bkhvac@trane.com

FRANKE, INC. (BROILER AND FRYER VENTILATION HOODS) 7595 GADSDEN HIGHWAY 800 AVIATION PARKWAY SMYRNA, TN 37086 800-877-5718

H&K INTERNATIONAL (BROILER AND FRYER VENTILATION HOODS) 2200 SKYLINE DRIVE MESQUITE, TX 75149 HEATHER VALVERDE 214-818-3521

fs-bkparts.us@franke.com

heather.valverde@hki.com

EQUIPMENT, PLAYGROUNDS AND DECOR

(POS, IDMB&ODMB HARDWARE/SOFTWARE. SPEED OF SERVICE TIMER, KITCHEN MINDER -CHEF) 4434 MEADOW DRIVE DOYLESTOWN, PA, 18901 MICHAEL SCHWARTZ 215-489-2500 EXT

Samsung/LSI (INTERIOR & OUTDOOR DIGITAL MENU BOARD SCREENS) 10000 ALLIANCE ROAD CINCINNATI, OH 45242 SARA GROFCSIK: 214-952-1242 s.grofcsik@sea.samsung.com DAVID SIMMONS: 513-372-3181

michael.schwartz@xenial.com

LG ELECTRONICS (INTERIOR & OUTDOOR DIGITAL MENU **BOARD SCREENS)** 2000 MILLBROOK DRIVE LINCOLNSHIRE, IL 60069 MICHAEL HA 847-309-4774 michael1.ha@lge.com

David.simmons@lsi-industries.com

HM ELECTRONICS, INC (HME) (DRIVE THRU HEADSETS) 14110 STOWE DRIVE POWAY, CA. 92064 STEVE LEE 858-848-3704 SLee@hme.com

QUALSERV SOLUTIONS (KITCHEN EQUIPMENT CONSOLIDATOR, SMALLWARES) 7400 SOUTH 28th STREET FORT SMITH, AR. 72908 GARY ESPOSITO: 305-205-2938 GEsposito@qualservsolutions.com

H & K INTERNATIONAL (KITCHEN EQUIPMENT CONSOLIDATOR, SMALLWARES, HOODS) 2200 SKYLINE DR DALLAS, TX 75223 **HEATHER VALVERDE: 214-818-3521** heather.valverde@hki.com

TRIMARK USA (KITCHEN EQUIPMENT CONSOLIDATOR, SMALLWARES FOR AAFES ORDERS ONLY) 2601 HOPE CHURCH ROAD WINSTON-SALEM, NC 27103 BILLY HIGH 336-354-4262 billy.high@trimarkusa.com

FRYMASTER CORPORATION (FRYERS) 8700 LINE AVE SHREVEPORT, LA 71106 DEE MILAM 318-862-2328 dee.milam@welbilt.com

FBD PARTNERSHIP, LP (FROZEN BEVERAGE) 8161 INTERCHANGE PARKWAY SUITE 115 SAN ANTONIO, TX 78218 TIM GARRETT 210-637-2870 OR 866-323-2777 tgarrett@fbdfrozen.com

INTERNATIONAL COLD STORAGE (ICS) (WALK-IN COOLERS / FREEZERS, DRY STORAGE COMPARTMENTS) 215 EAST 13th STREET ANDOVER, KS. 67002 FERAS AFFANI: 949-500-9322 Feras.affani@everidge.com

MANITOWOC ICE (ICE MACHINES) 2110 SOUTH 26TH STREET MANITOWOC, WI 54221 DEBBIE PARENZA: 920-242-1036 Deborah.parenza@welbilt.com

HOSHIZAKI AMERICA (ICE MACHINES) 618 HIGHWAY 74 SOUTH PEACHTREE CITY, GA 30269 TRAVIS RIEKEN: 813-995-3994 trieken@hoshizaki.com

PLAY SYSTEMS/SII (SUPERIOR PLAY SYSTEMS) (PLAYGROUND MANUFACTURER) 1050 COLUMBIA DR. CARROLLTON, GA 30717 SHAN MCGUIRE 678-390-1915 https://superiorplay.com/

MOSS RETAIL AND ENVIRONMENTS (GRAPHICS) 2643 WEST CHICAGO AVE CHICAGO, IL 60622 DJ SCANDIFF: 773-435-7617 djscandiff@mossinc.com

NCR HOSPITALITY 800 CORPORATE DRIVE, SUITE 300 FORT LAUDERDALE, FL 33334

NATASHA KARPOVA 678.549.8989

PANASONIC (DRIVE THRU HEADSETS) 2 RIVERVIEW PLAZA, 6TH FLOOR NEWARK, NJ 07102 THERESA MURPHY 201-492-0925 theresa.murphy@us.panasonic.com

natasha.karpova@ncr.com

3M FOOD SERVICE BUSINESS (DRIVE THRU HEADSETS) 3M CENTER BLDG. 223-2N-20 ST. PAUL, MN. 55144-1000 JOE CIAMPI: 704-771-2449 jjciampi@mmm.com

FRANKE (KITCHEN EQUIPMENT CONSOLIDATOR. SMALLWARES, HOODS) 800 AVIATION PARKWAY **SMYRNA, TN. 37086** CUSTOMER SERVICE: 800-877-5178 fs-bkparts.us@franke.com

DUKE MANUFACTURING (BROILERS & PRODUCT HOLDING UNITS) 2305 NORTH BROADWAY ST. LOUIS MO. 63102 RICK GARRIGA 305-270-6242 rgarriga@dukemfg.com

NIECO CORPORATION (BROILERS) 7950 CAMERON DRIVE WINDSOR, CA 95492 RICK GARCIA 305-205-0657 rgarcia@nieco.com

PITCO FRIALATOR (FRYERS) 10 FERRY STREET CONCORD, NH. 03301 MARK MCCABE: 603-230-5509 MMcCabe@pitco.com

LANCER CORP. (BEVERAGE SYSTEM) 6655 LANCER BLVD SAN ANTONIO, TX. 78219 GREG EDWARDS: 904-631-1031 greg.edwards@lancercorp.com

CORNELIUS, INC. (BEVERAGE SYSTEM) 101 BROADWAY STREET WEST OSSEO, MN 55369 ROSS DAVIS: 630-659-8690 ross.davis@cornelius.com

TAYLOR ULTIMATE SERVICES, INC (SHAKE MACHINE, FROZEN BEVERAGE MACHINE) 1780 NORTH COMMERCE PKWY WESTON, FL. 33326 RJ PIEDRA: 954-217-9100 raul@taylorus.comTAYLOR ULTIMATE SERVICES, INC


SCOTSMAN ICE SYSTEMS (ICE MACHINES) 775 CORPORATE WOODS PARKWAY VERNON HILLS, IL 60061 Kurt Mueller 800-726-8762 x15550 kurt.mueller@scotsman-ice.com

Scott.rogers@welbilt.com

SOFT PLAY, LLC (PLAYGROUND MANUFACTURER, SAFETY SURFACING, NON-CONTAINED PLAY EQUIPMENT) 13620 EAST REESE BLVD. SUITE 300 HUNTERSVILLE, NC. 28078 BROCK HODGE 704-948-3430 brock.hodge@softplay.com

VGS, INC (GRAPHICS) 1696 MABRY MILL DRIVE, SW NORTH CANTON, OH 44709 GREG MOROZ: 201-528-9680 ORDER EMAIL: BURGERKING@VGS-INC.COM BMC USA LLC (INTERIOR & EXTERIOR DÉCOR) 2655 SOUTH LE JEUNE ROAD, SUITE 905 CORAL GABLES, FL 33134 ILEANA BARBARA 305-919-0225 ileanabarbara@bmcec.com

CASABLANCA DESIGN GROUP (DECOR) 811 PICKENS INDUSTRIAL DRIVE MARIETTA, GA 30026 JOHN HARRISON: 770-423-9575 John.Harrison@cdg.com

CHARTER HOUSE INC. (INTERIOR & EXTERIOR DÉCOR) 4660 136 AVENUE HOLLAND, MI. 49424 BARB ZILM: 800-314-7659 OR 317-691-6930 barbara.zilm@charter-house.com

ELKAY SYSTEMS (FORMERLY ISI) (DECOR) 241 NORTH BROADWAY, SUITE 600 MILWAUKEE, WI 53202 SCOTT HOOPINGARNER 704-575-7026 scott.hoopingarner@elkay.com

FCC COMMERCIAL FURNITURE (INTERIOR & EXTERIOR DÉCOR) 8452 OLD HWY. 99 NORTH ROSEBURG, OR. 97470 PRESTON O'HARA: 541-464-5284 OR 800-322-7328 EXT 284 preston.ohara@fccfurn.com

FACILITY CONCEPTS, INC (FCI) (DECOR) 7676 ZIONSVILLE ROAD INDIANAPOLIS, IN 46268 KIM REAGAN 317-372-8622 Kregan@fcius.com

SEATING CONCEPTS (DECOR) 125 CONNELL STREET ROCKDALE, IL. 60436 ZACH DEPYSSLER: 815-483-2244 zdepyssler@seating-concepts.com

NAUTICAL FURNISHINGS, LLC (LIMITED DÉCOR ITEMS) 60 NW 60TH STREET FT. LAUDERDALE, FL 33309 MICHAEL HOGLUND: 954-771-1100 mhoglund@nauticalfurnishings.com

COMMERCIAL INTERIOR MANUFACTURERS, INC (LIMITED DÉCOR ITEMS) 158 HOLLY STREET JASPER, GA. 30143 AUSTIN HOLAN austin@cimgbiz.com

MITYLITE (GARDEN GRILL CHAIRS AND BARSTOOLS) 1301 WEST NORTH OREM. UT DENISE MORICE 636-293-5259

denise.morice@mityinc.com TWENTY FOUR 7 GLOBAL SOLUTIONS, INC. (GARDEN GRILL & PRIME CHAIRS AND BARSTOOLS) 898 NORTH SEPULVEDA BLVD, SUITE 465 EL SEGUNDO, CA 90245 BARRY WOON 323-839-0356

Barry.Woon@TwentyFour7-global.com WAUSAU TILE, INC (EXTERIOR DÉCOR ACCESSORIES) P.O. BOX 1520 WAUSAU, WI 54402 RACHEL BATHKE 715-241-0320

KIDZ PACE, INC (INTERACTIVE PLAY) Tom Ralphs 800-668-0206 x244 tom@kidzpace.com www.kidzpace.com

RRBathke@wausautile.com

LSI INDUSTRIES (GRAPHICS) 10000 ALLIANCE ROAD CINCINNATI, OH. 45242 BOB LUCAS 480-368-9399 OR 602-740-9894 Bob.Lucas@LSI-INDUSTRIES.com

APA COLOR GRAPHICS (GRAPHICS) 2929 PACIFIC DRIVE NORCROSS, GA TONY TANTILLO 404-355-1355 tony@apacolorgraphics.com



XING H H G

1/1\ A-8

DIVISION 9 - FINISHES

FOR FINISH MATERIALS, AND CONTACTS, REFER TO FINISH SCHEDULES FOUND IN THE "COMMON DOCUMENTS" SECTION OF THE WWW.DESIGNWITHBK.COM WEBSITE.

KELLY MCGOLDRICK: 800-621-5045 EXT 113 FRAMES & DOORS, WOOD DOORS.

(HOLLOW METAL FRAMES & DOORS, WOOD AUSTIN HOLAN: 706-253-4761

DOORS, HARDWARE (HINGES, LOCKS, ETC) austin@cimgbiz.com

(FINGER IN JAMB SAFETY - PLAYGROUNDS) jjciampi@mmm.com

ARMSTRONG STRATEGIC ACCOUNTS (CEILING TILE) LOUIS JOHN: 407-697-6768 ljjohn@armstrongceilings.com OR ARMSTRONG STRATEGIC ACCOUNTS (800) 442-4212

USG INTERIORS (CEILING TILE) cbenjamin@usg.com

NOTE: USE PROGRAM QUOTE # 00103139 TO RECEIVE NATIONAL BKC PRICING

CHRIS BENJAMIN: 312-436-5458

BOBRICK/KOALA KARE PRODUCTS

(RESTROOM ACCESSORIES, TOILET PARTITIONS & HARDWARE, BABY CHANGING TABLES & HIGHCHAIRS) CONTACT: HAINES, JONES, & CADBURY (HJC)

HAINES, JONES, AND CADBURY (HJC) (FULL RESTROOM PLUMBING PACKAGE, RESTROOM ACCESSORIES, TOILET PARTITIONS, CORIAN SINKS, WATER HEATERS) CONTACT: RESTROOM REMODELS COMPANY

PACKAGE, RESTROOM ACCESSORIES,

ZURN INDUSTRIES (PLUMBING FIXTURES) CONTACT: HAINES, JONES, AND CADBURY

ECOLAB FOOD SAFETY SPECIALTIES INC, DBA DAYDOTS (FIRST AID KITS) IRVING, TX 75062

201 EAST JOHN CARPENTER FREEWAY JOHN PULCHER 800-321-3687 john.pulcher@ecolab.com

rortiz@signresource.com

SEAN CAMPBELL 605-651-5299

keith.whitley@allenindustries.com

DIVISION 16 - ELECTRICAL SECURITY LIGHTING SYSTEMS

(FULL STORE PACKAGE LIGHTING FOR INTERIOR/EXTERIOR BUILDING & SITE LIGHTS. SURVEYS AND PHOTOMETRICS) 2100 GOLF ROAD, SUITE 460 ROLLING MEADOWS, IL. 60008 WHITNEY WATSON: 800-544-4848 EXT 131

LSI INDUSTRIES INC. (INTERIOR AND EXTERIOR LIGHTING, SURVEYS AND PHOTOMETRICS) 10000 ALLIANCE ROAD CINCINNATI, OH. 45242 BOB LUCAS 480-368-9399 OR 602-740-9894

Bob.Lucas@LSI-INDUSTRIES.com CREE LIGHTING (INTERIOR AND EXTERIOR LIGHTING, SURVEYS AND PHOTOMETRICS) 9201 WASHINGTON AVENUE RACINE, WI 53406 STEVE FRIEDMAN 847-830-1444

steve.friedman@cree.com KONTECHUSA (INTERIOR AND EXTERIOR BUILDING LIGHTING) 18045 ROLAND STREET CITY OF INDUSTRY, CA 91748 SUKIT SANGLIMSUWAN 702-728-8263 OR

866-236-8701

sukit@kontechusa.com

HERMITAGE LIGHTING NATIONAL ACCOUNTS (MASTER LIGHTING CONSOLIDATOR, SURVEYS DAVID CHUDACOFF 615-843-3369 dchudacoff@hermitagelighting.com

(BROILER AND FRYER VENTILATION HOODS)

10900 SOUTHWEST AVERY STREET

JOHN ANDERSON 971-223-1238

john.anderson@gaylordusa.com

CARRIER CORPORATION

6304 CARRIER PARKWAY

KEN REVILLA 860-660-6379

SPRINGFIELD. MO 65803-4637

(FIRE PROTECTION SYSTEMS)

JAMES KNOWLES 205-655-5721

james.knowles@amerex-fire.com

TRUSSVILLE, AL 35173-0081

GAYLORD INDUSTRIES, INC

www.amerex-fire.com

TUALATIN, OR, 97062

KEN DICKSON: 813-966-9200

AMEREX CORPORATION

Ken.revilla@carrier.utc.com

(AIR CONDITIONING)

SYRACUSE, NY. 13221

LOREN COOK CO

(EXHAUST FANS)

2015 E. DALE

ENERGYWISE SOULUTIONS, LLC (MASTER LIGHTING CONSOLIDATOR, SURVEYS 8550 UNITED PLAZA BOULEVARD, SUITE 702 JENNIFER WADDICK 877-225-1336

(INTERIOR AND EXTERIOR BUILDING LIGHTING)

HILL PHOENIX POWER SYSTEMS DIVISION (FACTORY INTEGRATED SWITCH GEAR) 8166 INDUSTRIAL BLVD COVINGTON, GA. 30014 PAUL BROWN: 678-699-0129 paul.brown@hillphoenix.com

STRUCTURAL GENERAL NOTES:

DESIGN AND LOADING

```
1. THE STRUCTURAL DESIGN OF THIS BUILDING WAS BASED ON THE DESIGN CRITERIA:
   A. BUILDING CODE: 2019 CBC
   B. FLOOR LIVE LOAD: N/A
   C. ROOF LIVE LOAD: 20 PSF
       ROOF DEAD LOAD: 13 PSF
   D. SNOW LOADS: N/A
   E. BASIC WIND SPEED: 110 MPH (3-SECOND GUST)
         IMPORTANCE FACTOR: 1.00
        BUILDING OCCUPANCY CATEGORY: II
        WIND EXPOSURE: C
        PRESSURES PER ASCE7
   F. SEISMIC OCCUPANCY CATEGORY: II
         IMPORTANCE FACTOR: 1.00
        SITE CLASS: D
        SS = 1.325, S1 = 0.871
        SDS = 1.060, SD1 = 1.045
        DESIGN CATEGORY: E
        PLYWOOD PANELS (R = 6.5)
        DESIGN BASE SHEAR = 0.212
        ANALYSIS PROCEDURE: EQUIVALENT LATERAL FORCE PROCEDURE
   G. FLOOD LOAD: N/A
```

FOUNDATION NOTES

H. SPECIAL LOADS: N/A

I. SOIL ALLOWABLE BEARING LOAD = 2,500 PSF

- THE FOUNDATION DESIGN OF THIS BUILDING WAS BASED ON THE FOLLOWING CRITERIA: A. MINIMUM ALLOWABLE SOIL BEARING CAPACITY = 2,500 PSF.
- 2. ALL EXTERIOR FOOTINGS SHALL EXTEND BELOW THE MAXIMUM ANTICIPATED DEPTH OF
- 3. THE CONTRACTOR SHALL NOTIFY THE ARCHITECT OR ENGINEER OF RECORD IMMEDIATELY IN THE EVENT THAT THE SOILS CONDITIONS ENCOUNTERED VARY FROM THOSE SHOWN ON THE BORING LOGS.

CONCRETE AND REINFORCING

- 1. ALL CONCRETE SHALL BE IN ACCORDANCE WITH THE "AMERICAN CONCRETE INSTITUTE BUILDING CODE" (ACI 318) AND WITH "SPECIFICATIONS FOR STRUCTURAL CONCRETE FOR BUILDINGS" (ACI 301) LATEST EDITIONS
- 2. ALL NORMAL WEIGHT CONCRETE (145 PCF) SHALL OBTAIN A MINIMUM 28 DAY COMPRESSIVE STRENGTH OF 3000 PSI (3500 PSI FOR SLABS AND 4000 PSI FOR BRACE FRAME FOOTING).
- 3. ALL CONCRETE SUBJECT TO EXTERIOR EXPOSURE SHALL BE AIR ENTRAINED AS RECOMMENDED BY ACI 318.
- 4. TEST CYLINDERS SHALL BE MADE AND TESTED AS OUTLINED IN CHAPTER 16 OF ACI-301.
- 5. REINFORCING BARS SHALL BE DEFORMED BARS OF NEW BILLET STEEL CONFORMING TO ASTM A-615, GRADE 60. WELDED WIRE FABRIC SHALL CONFORM TO ASTM A-185. ALL REINFORCING AND ACCESSORIES SHALL BE DETAILED AND PLACED IN ACCORDANCE WITH ACI STANDARD 315 AND 315R.
- 6. PROVIDE ALL ACCESSORIES NECESSARY TO SUPPORT REINFORCEMENT AT POSITIONS SHOWN ON THE PLANS AND DETAILS. PLASTIC COATED ACCESSORIES SHALL BE USED IN ALL EXPOSED CONCRETE WORK.
- 7. THE GENERAL CONTRACTOR SHALL CHECK WITH ARCHITECTURAL, MECHANICAL AND ELECTRICAL DRAWINGS AND THE SUB-CONTRACTORS FOR OPENINGS, SLEEVES, ANCHORS, HANGERS, INSERTS, SLAB DEPRESSIONS AND OTHER ITEMS RELATED TO THE CONCRETE WORK AND SHALL ASSUME RESPONSIBILITY FOR THEIR PROPER LOCATION.

STRUCTURAL STEEL

- STRUCTURAL STEEL SHALL BE DETAILED, FABRICATED AND ERECTED IN ACCORDANCE WITH THE AISC "STEEL CONSTRUCTION MANUAL", 13TH EDITION.
- 2. STRUCTURAL STEEL SHALL CONFORM TO THE FOLLOWING ASTM SPECIFICATIONS:
 - A ANCHOR RODS F1554, GRADE 36
 - B. HIGH STRENGTH STRUCTURAL BOLTS A325-N U.N.O. C. STRUCTURAL SHAPES (W) A992
 - D. STRUCTURAL SHAPES (M, S, C, MC, PLATES) A36
- E. STRUCTURAL SHAPES (HP) A572
- STRUCTURAL TUBING (HSS) A500 GRADE B
- G. STRUCTURAL ANGLES A36
- 3. ALL WELDING ELECTRODES SHALL BE E70-XX. ALL SHOP AND FIELD WELDING SHALL BE MADE IN ACCORDANCE WITH A.W.S. D1.1 "CODE FOR WELDING IN BUILDING CONSTRUCTION" AND SHALL BE MADE BY CERTIFIED WELDERS.

<u>LUMBER</u>

- 1. ALL GRADES OF LUMBER SHALL BE RATED BY THE SOUTHERN PINE INSPECTION BUREAU (SPIB), OR THE WESTERN WOOD PRODUCTS ASSOCIATION (WWPA). LUMBER GRADES SHALL BE AS FOLLOWS. WITH A MAXIMUM MOISTURE CONTENT OF 19%:
- A. SOUTHERN PINE NO. 1.
- B. DOUGLAS FIR-LARCH NO. 1. C. HEM-FIR NORTH NO. 1
- 2. BOLT HEADS AND NUTS BEARING ON WOOD SHALL BE PROVIDED WITH STANDARD CUT

WASHERS. ALL WOOD IN CONTACT WITH CONCRETE OR MASONRY SHALL BE PRESSURE TREATED.

- MINIMUM NAILED CONNECTIONS FOR WOOD FRAMING MEMBERS SHALL BE IN ACCORDANCE WITH THE LOCAL BUILDING CODE OR TABLE 2304.9.1 OF THE INTERNATIONAL BUILDING CODE IF NO OTHER CRITERIA IS GIVEN.
- 4. CONNECTORS SHOWN ON THE DETAILS ARE MANUFACTURED BY SIMPSON. WRITTEN APPROVAL BY ENGINEER REQUIRED FOR SUBSTITUTIONS.

ROOF & WALL SHEATHING

- 1. ALL SHEATHING SHALL CONFORM TO AMERICAN PLYWOOD ASSOCIATION (APA) DESIGN SPECIFICATIONS, LATEST EDITION. SHEATHING SHALL BE CONTINUOUS OVER THREE ADJACENT SPANS MINIMUM.
- 2. WALL SHEATHING SHALL BE 15/32" (1/2" NOMINAL) APA RATED SHEATHING, STRUCTURE 1 32/16. ALL WALL SHEATHING SHALL BE FASTENED TO SUPPORTING MEMBERS W/ 8d COMMON NAILS @ 6" O.C. AT PANEL EDGES AND 12" O.C. AT INTERMEDIATED SUPPORTS U.N.O.
- 3. ROOF SHEATHING SHALL BE 5/8" APA RATED SHEATHING, STRUCTURE 1, 48/24, UNO. ALL ROOF SHEATHING SHALL BE FASTENED TO SUPPORTING MEMBER w/10d COMMON NAILS @ 6:12 (CONTINUOUS PANEL EDGES: DISCONTINUOUS PANEL EDGE: FIELD).

MASONRY

MASONRY DESIGN AND CONSTRUCTION SHALL CONFORM TO "BUILDING CODE REQUIREMENTS FOR MASONRY STRUCTURES", ACI 530/ASCE 5/TMS 402.

MASONRY MATERIALS SHALL CONFORM TO THE LATEST EDITION OF THE FOLLOWING

- HOLLOW LOAD BEARING CONCRETE BLOCK: ASTM C-90, GRADE N1 MINIMUM COMPRESSIVE STRENGTH = 1900 PSI AT 28 DAYS.
- MORTAR: ASTM C-270, TYPE S
- MINIMUM COMPRESSIVE STRENGTH = 1800 PSI AT 28 DAYS. • MORTAR: ASTM C-270, TYPE M
- MINIMUM COMPRESSIVE STRENGTH = 2500 PSI AT 28 DAYS (USED FOR BELOW GRADE WORK)
- GROUT: ASTM C−476, MINIMUM COMPRESSIVE STRENGTH = 2000 PSI AT 28 DAYS
- MASONRY REINFORCEMENT: ASTM A-82, GALVANIZED
- MASONRY PRISM STRENGTH: F'm = 1500 PSI

PRIOR TO DELIVERY OF MASONRY UNITS TO THE JOB SITE, FURNISH TO THE OWNER AFFIDAVITS FROM AN APPROVED TESTING LABORATORY CERTIFYING THAT ALL UNITS CONFORM TO THEIR RESPECTIVE ASTM REQUIREMENTS. GROUT ALL CAVITIES CONTAINING REINFORCEMENT IN LIFTS NOT TO EXCEED 5'-0".

LABORATORY PREPARED MIXES SHALL BE PREPARED AND TESTED IN ACCORDANCE WITH ASTM C-270. FIELD MORTAR SHALL BE TESTED BY AN APPROVED TESTING LABORATORY IN ACCORDANCE WITH ASTM C-780 TWO SETS OF THREE MORTAR CUBES SHALL BE TAKEN DIRECTLY FROM THE MIXER FOR EACH DAY OF MASONRY WORK. TEST THE CUBES AT 28 DAYS. ACCEPTANCE OF THE MORTAR SHALL BE AT THE DISCRETION OF THE ENGINEER. PROVIDE STANDARD DUR-O-WALL OR EQUIVALENT REINFORCEMENT AT EVERY SECOND BLOCK COURSE IN ALL WALLS UNLESS MORE RESTRICTIVE REQUIREMENTS ARE NOTED CALCIUM CHLORIDE AND/ OR ADMIXTURES CONTAINING CALCIUM CHLORIDE SHALL NOT BE INCLUDED IN MORTAR OR GROUT MIX. EXCEPT WHEN APPROVED IN WRITING BY THE STRUCTURAL ENGINEER. NO ANTI FREEZE COMPOUNDS SHALL BE USED TO LOWER THE MORTAR'S FREEZING POINT.

NO EXTERIOR MASONRY SHALL BE LAID WHEN THE OUTSIDE AIR TEMPERATURE IS LESS THAN 40 DEGREES FAHRENHEIT, UNLESS THE RECOMMENDATIONS SPECIFIED BY THE INTERNATIONAL MASONRY INDUSTRY ALL WEATHER COUNCIL IN THEIR PUBLICATION "RECOMMENDED PRACTICES AND GUIDE SPECIFICATIONS FOR COLD WEATHER MASONRY" ARE STRICTLY FOLLOWED.

THE MASONRY CONTRACTOR SHALL PROVIDE BRACING TO WITHSTAND HORIZONTAL PRESSURES AS REQUIRED BY THE BUILDING CODE AND LOCAL ORDINANCE.

SHOP DRAWINGS

- 1. SHOP DRAWING SUBMITTALS SHALL CONSIST OF A MINIMUM OF 2 REPRODUCIBLES OF EACH DRAWING.
- 2. SHOP DRAWINGS SHALL BE REVIEWED BY CONTRACTOR TO VERIFY THAT SUBMITTAL IS COMPLETE PRIOR TO SUBMITTING TO ARCHITECT/ENGINEER.
- 3. DRAWINGS CREATED BY THE ENGINEER OF RECORD CANNOT BE REPRODUCED AND/OR USED AS A SHOP DRAWING SUBMITTAL. SHOP DRAWING SUBMITTALS SHALL INCLUDE THE FOLLOWING:
- A. CONCRETE MIX DESIGN B. FOUNDATION REINFORCING BARS
- STRUCTURAL STEEL
- D. STRUCTURAL MASONRY
- E. ROOF SHEATHING F. TRELLIS SYSTEM & CALCULATIONS
- G. SAWN LUMBER AND CONNECTORS

SPECIAL INSPECTIONS

SPECIAL INSPECTIONS SHALL BE PERFORMED IN ACCORDANCE WITH SECTION 1704 OF CBC AND THE OWNER SHALL EMPLOY ONE OR MORE SPECIAL INSPECTORS TO PROVIDE INSPECTIONS DURING CONSTRUCTION ON THE TYPES OF WORK LISTED UNDER SECTION 1704 THE FOLLOWING AREAS OF WORK REQUIRE SPECIAL INSPECTIONS IN ACCORDANCE WITH THE LISTED 2016 CBC SECTIONS/LOCATIONS:

- 1. SOILS SECTION 1704.7 PER TABLE 1704.7.
- 2. CONCRETE SECTION 1704.4 PER TABLE 1704.4. 3. STEEL - SECTION 1704.3 PER TABLE 1704.3.
- 4. MASONRY SECTION 1704.5 PER TABLE 1704.5.1
- 5. WOOD SECTION 1704.6.

STRUCTURAL OBSERVATION

- STRUCTURAL OBSERVATION: STRUCTURAL OBSERVATION IS REQUIRED FOR THE STRUCTURAL SYSTEM COMPLYING WITH CBC SECTION 1702. STRUCTURAL OBSERVATION IS THE VISUAL OBSERVATION OF THE ELEMENTS AND CONNECTIONS OF THE STRUCTURAL SYSTEM AT SIGNIFICANT CONSTRUCTION STAGES AND THE COMPLETED STRUCTURE FOR GENERAL CONFORMANCE WITH THE CONTRACT DOCUMENTS. STRUCTURAL OBSERVATION DOES NOT WAIVE THE RESPONSIBILITY FOR THE INSPECTIONS REQUIRED OF THE BUILDING INSPECTOR OR TESTING LABORATORY.
- STRUCTURAL OBSERVER: THE OWNER SHALL EMPLOY A CIVIL OR STRUCTURAL ENGINEER OR ARCHITECT TO PERFORM STRUCTURAL OBSERVATIONS. THE ENGINEER OR ARCHITECT SHALL BE REGISTERED OR LICENSED IN THE STATE OF CALIFORNIA.
- **OBSERVATION REPORTS:** STRUCTURAL OBSERVER SHALL PREPARE A REPORT FOR EACH SIGNIFICANT STAGE OF CONSTRUCTION OBSERVED. THE ORIGINAL OF THE OBSERVATION REPORT SHALL BE SENT TO THE BUILDING INSPECTOR'S OFFICE AND SHALL BE SIGNED AND SEALED (WET STAMP) BY THE RESPONSIBLE STRUCTURAL OBSERVER. ONE COPY OF THE OBSERVATION REPORT SHALL BE ATTACHED TO THE APPROVED PLANS. COPIES OF THE REPORT SHALL ALSO BE GIVEN TO THE OWNER, CONTRACTOR, AND DEPUTY INSPECTOR.
- 4. FINAL OBSERVATION REPORT: STRUCTURAL OBSERVER SHALL PREPARE AND SUBMIT A FINAL OBSERVATION REPORT STATING THAT ALL OBSERVED DEFICIENCIES WERE RESOLVED AND THE STRUCTURAL SYSTEM IS IN GENERAL CONFORMANCE WITH THE APPROVED PLANS AND SPECIFICATIONS

STRUCTURAL SHEET INDEX:

- STRUCTURAL GENERAL NOTES
- FOUNDATION PLAN
- ROOF FRAMING PLAN
- STRUCTURAL DETAILS
- STRUCTURAL DETAILS

SPECIAL INSPECTION IS REQUIRED FOR:

- 1. CMU WALL CONSTRUCTION (PERIODIC)
- 2. SHEARWALL NAILING FOR TYPE 2 AND ABOVE (PERIODIC)
- 3. 3,000PSI CONCRETE FOOTING (PERIODIC)

STRUCTURE OBSERVATION IS REQUIRED AT:

- 1. Foundation
- 2. Shear Wall Nailing
- 3. Roof Nailing

STRUCTURAL OBSERVATION PROGRAM AND DESIGNATION OF THE STRUCTURAL OBSERVER

PROJECT ADDRESS:	66675 TWO BUNCH PALMS TRAIL, DESERT HOT SPRINGS, CA 92240	PERMIT APPL. NO.:
Description of Work	TENAN IMPROVEMENT	

Architect: --Engineer: BEN PHAN Owner: MCD STRUCTURAL OBSERVATION (only checked items are required) Firm or Individual to be responsible for the Structural Observation

		T	T
FOUNDATION	WALL	FRAME	DIAPHRAGM
▼ Footing, Stem Walls, Piers	☐ Concrete	☐ Steel Moment Frame	☐ Concrete
☐ Mat Foundation	⊠ Masonry	☐ Steel Braced Frame	☐ Steel Deck
☐ Caisson, Piles, Grade Beams	⊠ Wood	☐ Concrete Moment Frame	☒ Wood
Stepping/Retaining Foundation, Hillside Special Anchors	□ Others: List	☐ Masonry Wall Frame	□ Others: List

DECLARATION BY OWNER

I, the Owner of the project, declare that the above listed firm or individual is hired by me to be the Structural Observer.

DECLARATION BY ARCHITECT OR ENGINEER OF RECORD

(required if the Structural Observer is different from the Architect or Engineer of Record) I, the Architect of Engineer of record for the project, declare that the above listed firm or individual is designated by me to be responsible for the Structural Observation.

LICENSE # C 57550

TEL: (714) 251 4537

153 E. City Place Drive


C57550 License No.

05/18/2021

VP ENGINEERING No. C-57550 Exp. 12-31-21 SANTA ANA, CA 92705 Email: benphanconsultant@gmail.com



 \mathbf{m} STRUCTURAL GENERAL NOTES

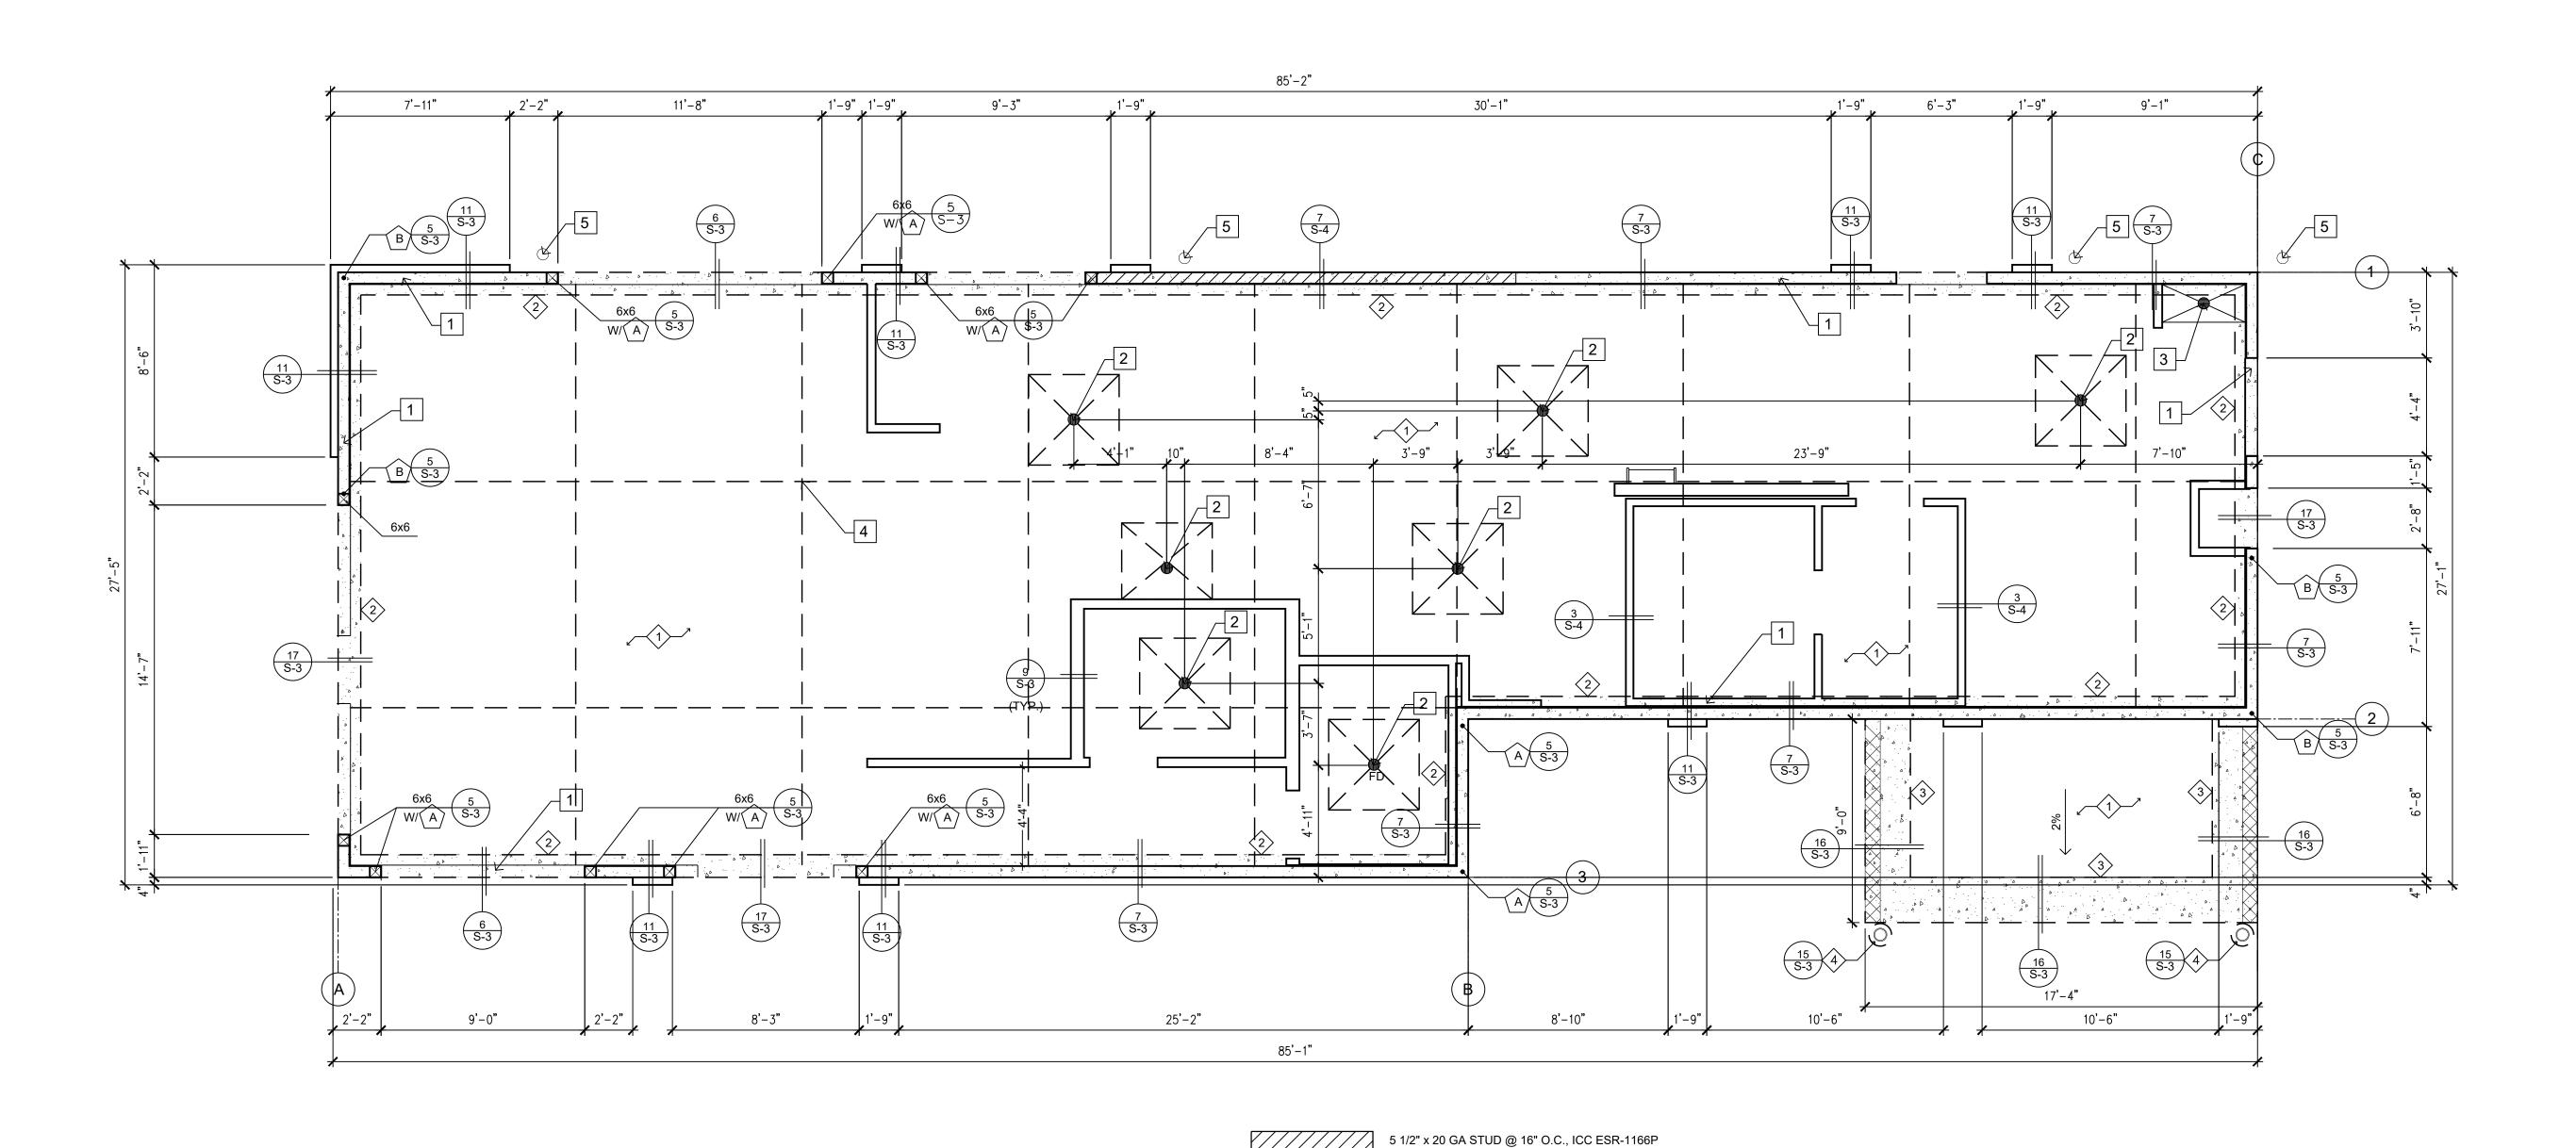

NOTES:

1. FASTENERS FOR PRESERVATIVE-TREATED WOOD SHALL BE OF HOT DIPPED ZINC-COATED GALVANIZED

STEEL, STAINLESS STEEL, SILICON BRONZE OR COPPER.

2. SHEARWALL ANCHOR BOLTS AND HOLD-DOWN HARDWARE MUST BE SECURED IN PLACE PRIOR TO FOUNDATION INSPECTION.

3. USE 2X6 P.T. SILL FOR ALL EXTERIOR WALLS (TYP.), UNLESS OTHERWISE NOTICED ON PLAN

SYMBOLS LEGEND

_ _ _

DROP IN SLAB (VERIFY PRIOR TO CONSTRUCTION)

 \Diamond FOUNDATION NUMBER

PAD NUMBER



DETAIL NUMBER DETAIL SHEET NUMBER



NEW FOUNDATION

POST OR TRIMMER AS NOTED

FOUNDATION PLAN NOTES

(N) 5" CONC. SLAB, 3,000 PSI @ 28 DAYS, W/ #3 @ 18" OCEW O/ 2" SAND, O/ 10-MIL VISQUEEN, O/ 3" OF 3/4" MAX. CLEAN GRAVEL

2 12" W x 18" D CONT. FOOTING W/ 2-#4 T&B

3 2'-0" W x 12" D CONT. FOOTING W/ 3-#4 BOTTOM

12" DIA. X 5'-3" DEEP CAISSON, 3,000 PSI @ 28 DAYS, W/ (4) #4 VERT REBAR & #3 TIES @ 12" OC

HOLDOWN NOTES

A HDU2 & SSTB16

B HDU5 & SSTB24

KEYED NOTES:

1. 8"Wx6"H CONCRETE CURB - REINFORCEMENT AS SPECIFIED.

2. DRAINAGE FIXTURE - REFERENCE PLUMBING DRAWINGS. SLOPE 4'x4' AREA TO DRAIN @ 2% SLOPE.

3. MOP SINK. SEE DETAIL 1/S-3.

4. SAW-CUT CONSTRUCTION JOINTS EVERY 10' EACH WAY. SEE DETAIL 13/S-3.

5. 6"Øx 8'-0" STEEL BOLLARD, FILL WITH CONCRETE, TOP OF BOLLARD AT 5'-0" ABOVE SURFACE OF PAVING WITH 24"Ø x 3'-0" DEEP CONCRETE FOOTING.

6. DESIGNER OF RECORD TO COORDINATE ALL F.D. AND F.S. LOCATIONS WITH KICHEN OPTION AND APPROVED KITCHEN MECHANICALS.

GENERAL NOTES:

8" THICK CMU WALL, SOLID GROUT, W/ #4 VERT. REBAR @ 16" OC AND #4 HORZ. REBAR @ 24" OC

A. FOUNDATION PLAN WAS BASED ON AN ASSUMED ALLOWABLE BEARING CAPACITY OF 2,500PSF. IT IS THE CONTRACTOR'S RESPONSIBILITY TO VERIFY THIS BEARING CAPACITY WITH SOIL BORINGS.

B. ALL FOOTING EXCAVATIONS SHALL BE INSPECTED AND APPROVED BY A QUALIFIED SOILS ENGINEER REPRESENTING THE OWNER PRIOR TO PLACING CONCRETE. EXCAVATIONS SHALL BE FREE OF WATER AT ALL TIMES.

C. NO ENGINEERED FILL SHALL BE PLACED UNTIL EXCAVATION BOTTOMS HAVE BEEN INSPECTED AND APPROVED BY A SOILS ENGINEER. D. BACKFILLING:

D.A. BOTH SIDES OF FOUNDATION WALLS SHALL BE BACKFILLED SIMULTANEOUSLY SO AS TO PREVENT OVERTURNING OR LATERAL MOVEMENT OF WALLS.


D.B. NO FILL OR BACKFILL SHALL BE SETTLED BY THE USE OF WATER. E. SEE SHEET S-3 FOR STRUCTURAL NOTES. SEE ELECTRICAL SHEETS FOR LOCATIONS OF UNDERGROUND CONDUIT. G. SEE PLUMBING PLAN FOR LOCATIONS OF UNDERGROUND PIPING.

THE LATERAL & UPLIFT REACTIONS AS REQUIRED.

H. ALL CONTINUOUS FOOTINGS SHALL BE CENTERED UNDER FOUNDATION WALLS UNLESS NOTED OTHERWISE. SOILS CONTRACTOR SHALL REFER AND CONFORM TO ALL RECOMMENDATIONS AND FINDINGS AS SET FORTH IN THE SOILS GEOLOGICAL REPORT. THE OWNER AND/OR ARCHITECT ACCEPTS NO RESPONSIBILITY FOR THE ACCURACY OF THE FINDINGS. OR FOR THE FINAL RECOMMENDATIONS,


GRADING, TRENCHING, ETC. - CONTACT OWNER FOR INSTRUCTIONS PRIOR TO THE CONTINUATION OF WORK SHOULD ANY UNUSUAL CONDITIONS BECOME APPARENT DURING GRADING OR FOUNDATION CONSTRUCTION. EXISTING ELEVATIONS AND LOCATIONS TO BE JOINTED SHALL BE VERIFIED BY THE CONTRACTOR PRIOR TO CONSTRUCTION. IF THEY DIFFER FROM THOSE SHOWN ON THE DRAWINGS, THE CONTRACTOR SHALL NOTIFY THE OWNER SO THAT MODIFICATIONS CAN BE MADE BEFORE PROCEEDING WITH THE WORK. BEAMS, COLUMNS AND FOOTING AT GRID LINES 2,6 &11 ARE ACTING AS WIND FRAMES FOR THE BUILDING. ALL MEMBERS TO BE DESIGNED TO SUPPORT

VP ENGINEERING LICENSE # C 57550 153 E. City Place Drive SANTA ANA, CA 92705 TEL: (714) 251 4537 Email: benphanconsultant@gmail.com

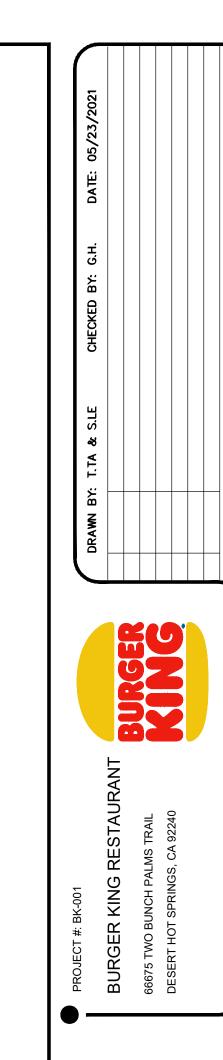

 $\mathbf{\Omega}$

2-7 FOUNDATION PLAN

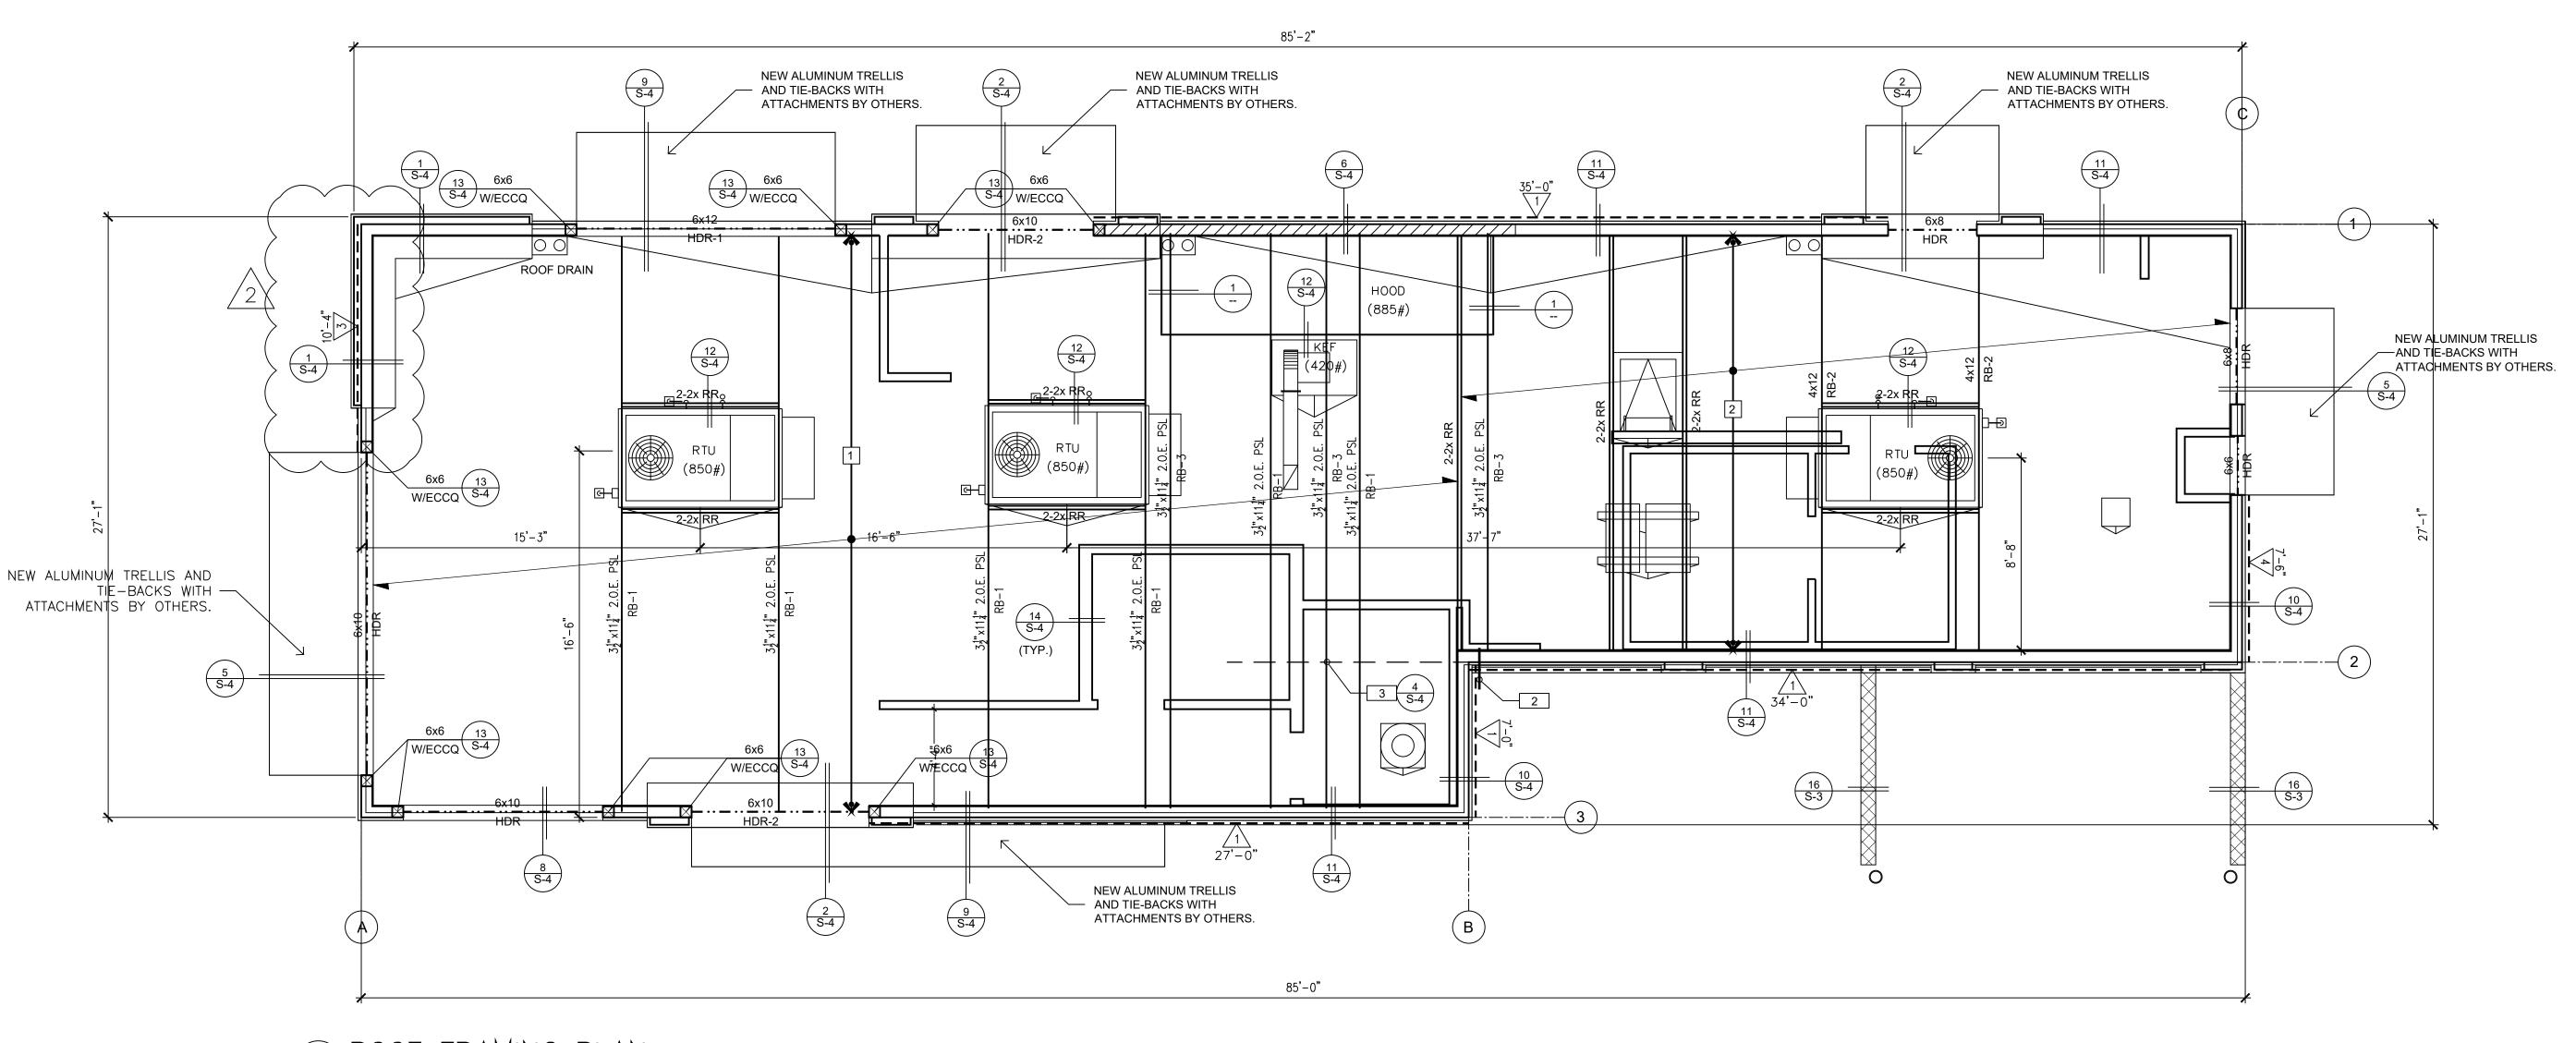

2 ROOF FRAMING PLAN
SCALE: 1/4"=1'-0"

NOTES:

1. ROOF DIAPHRAGM: 5/8" C-D EXTERIOR APA RATED 32/16, 10d @ 6" @ PANEL EDGES & 12" @ INTERMEDIATE.
2. USE 2X6 STUDS @ 16" OC FOR ALL EXTERIOR WALLS (TYP.), UNLESS OTHERWISE NOTICED ON PLAN
3. USE TYPE 1 SHEARWALL FOR ALL EXTERIOR WALLS (TYP.), UNLESS OTHERWISE NOTICED ON PLAN

5 1/2" x 20 GA STUD @ 16" O.C., ICC ESR-1166P

1 (N) 2x12 RR @ 12" OC (RR-1) 2 (N) 2x12 RR @ 24" OC (RR-2)

STRAP SCHEDULE

1 MSTAM36 (HORZ)

2 ST6236 (HORZ)

3 CMST14 CONT. STRAP (HORZ). SEE DET. 4/S-4

POST NOTES

☐ 6X6 POST, U.N.O

SYMBOLS LEGEND

SPAN AND DIRECTION OF ROOF MEMBER PER SCHEDULE

SPAN AND DIRECTION OF FLOOR MEMBER PER SCHEDULE

Y
SHEAR PANEL NUMBER, MINIMUM

SHEAR PANEL NUMBER, MINIMUM LENGTH NOTED, REFER TO SHEET SD.2 FOR PANEL TYPE

DETAIL NUMBER
DETAIL SHEET NUMBER

X HANGER TYPE

X HOLDOWN TYPE

VERT. STRAP NUMBER

X HORZ. STRAP NUMBER

SHEAR WALL SCHEDULE					
<u></u>	2	<u></u>	4		
1/2"	1/2"	1/2"	1/2"		
24/0	24/0	24/0	24/0		
8 D @ 6"	8 D @ 4"	8 D @ 3"	8 D @ 2"		
8 D @ 12"	8 D @ 12"	8 D @ 12"	8 D @ 12"		
2-2X	2-2X	2-2X	2-2X		
2X	2X	3X	3X		
2X	2X	3X	3X		
4X OR DBL 2X	4X OR DBL 2X	4X OR DBL 3X	4X OR DBL 3X		
16 D @ 6"	16 D @ 4"	40 D @ 4"	40 D @ 3"		
5/8" @ 24"	5/8" @ 24"	5/8" @ 16"	5/8" @ 12"		
24" O.C.	16" O.C.	12" O.C.	9" O.C.		
APA CDX Struct. 1	APA CDX Struct. 1	APA CDX Struct. 1	APA CDX Struct. 1		
280	345	550	730		


(SHEAR WALL SCHEDULE FOR CBC-2019)
(SHEAR WALL #3 & 4 :W/ 3X OR 2-2X STUD, SILL & BLOCKS BETWEEN ADJACENT PANELS 1/2" EDGE

DISTANCE FOR PLYWOOD BOUNDARY NAILING)

(X) = FOR METAL STUD, BOUNDARY NAILS TO BE #10 SCREW @ 6" OC

GENERAL NOTES:

6' HIGH, 8" THICK CMU WALL, SOLID GROUT, W/ #4 VERT. REBAR @ 16" OC AND #4 HORZ. REBAR @ 24" OC

A. ROOF OPENINGS FOR A/C UNITS.

CONTRACTOR SHALL BE RESPONSIBLE FOR COORDINATION
WITH MFR. AND SUPPLY SHOP DRAWINGS FOR INSTALLATION.

B. IF REMOTE COMPRESSORS ARE USED. CONTRACTOR SHALL

COORDINATE INSTALLATION WITH EQUIPMENT MANUFACTURER.

C. SEE SHEET A-5 FOR DETAIL OF SCUPPERS, ROOF DRAINS.

ROOF PENETRATIONS AND PITCH PANS.

D. REFERENCE MECHANICAL SHEETS FOR RTU MOUNTING DETAILS.

E. STRUCTURAL DESIGN CRITERIA.

REFERENCE GENERAL NOTE, SHEET S-0.


F. ALL HORIZ. FRAMING LUMBER, INCLUDING 2x JOISTS, BEAMS AND HEADERS SHALL BE DENSE NO 2 DOLIGIAS FIRELARCH OR BETTE

HEADERS SHALL BE DENSE NO. 2 DOUGLAS FIR-LARCH OR BETTER. G. ALL WOOD STUDS SHALL BE STRUCTURAL NO. 2 DOUGLAS FIR-LARCH OR BETTER

H. ALL BEAM SPLICES SHALL OCCUR OVER SUPPORT COLUMNS.

I. VERIFY EXACT LOCATIONS OF MECHANICAL UNITS

WITH MECHANICAL CONTRACTOR.

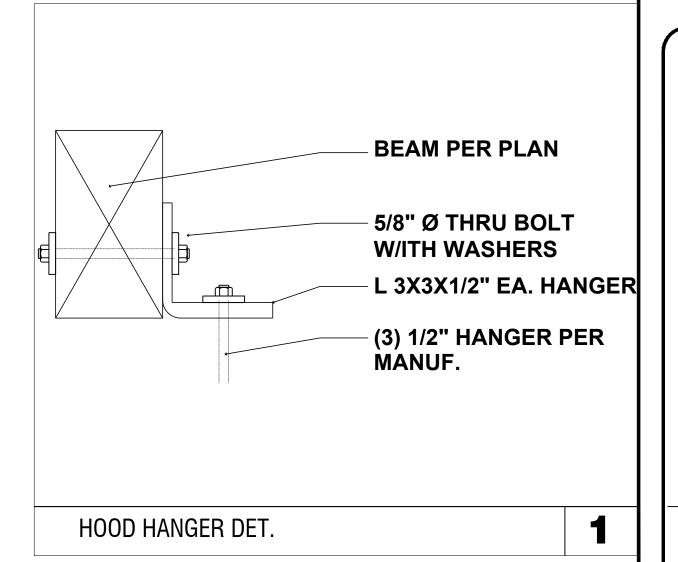

VP ENGINEERING
LICENSE # C 57550

153 E. City Place Drive
SANTA ANA, CA 92705


TEL: (714) 251 4537
Email: benphanconsultant@gmail.com


PROJECT #: INS - 001

BURGER KING RESTAURAN
66745 TWO BUNCH PALMS TRAIL
DESERT HOT SPRINGS, CA 92240

ROOF FRAMING PLAN

OFESSIONAL # LOPESSIONAL # LOP

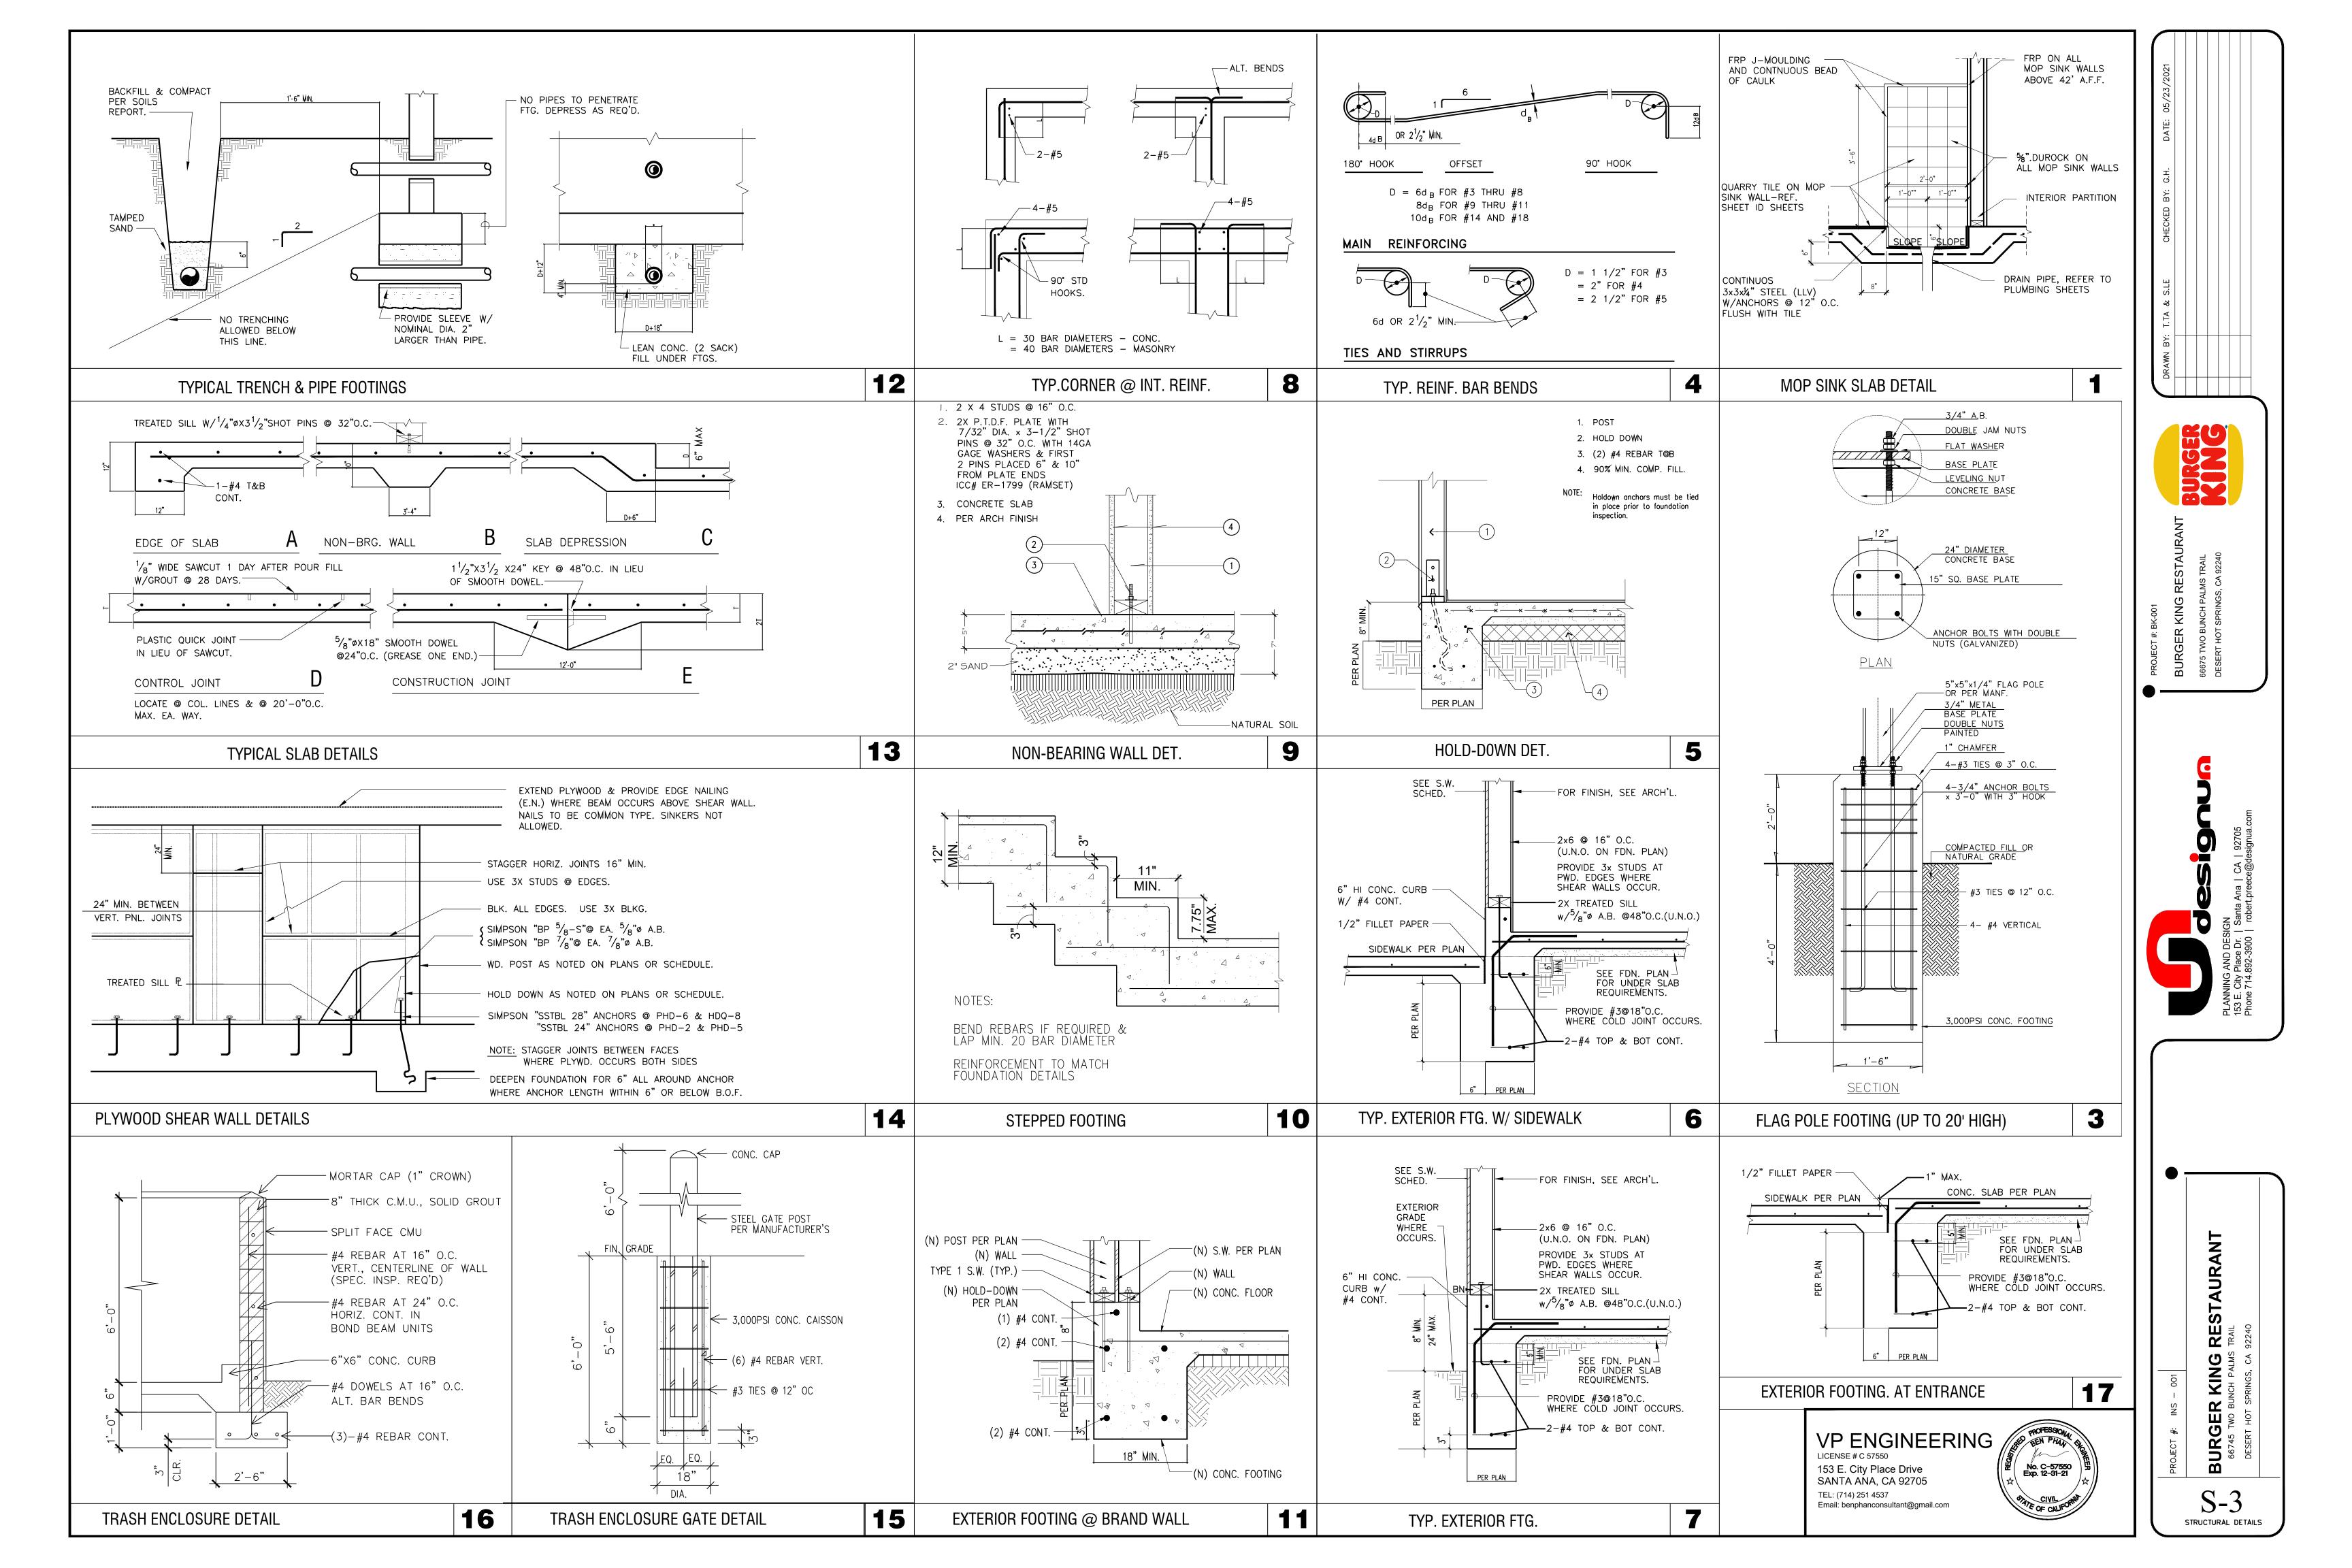

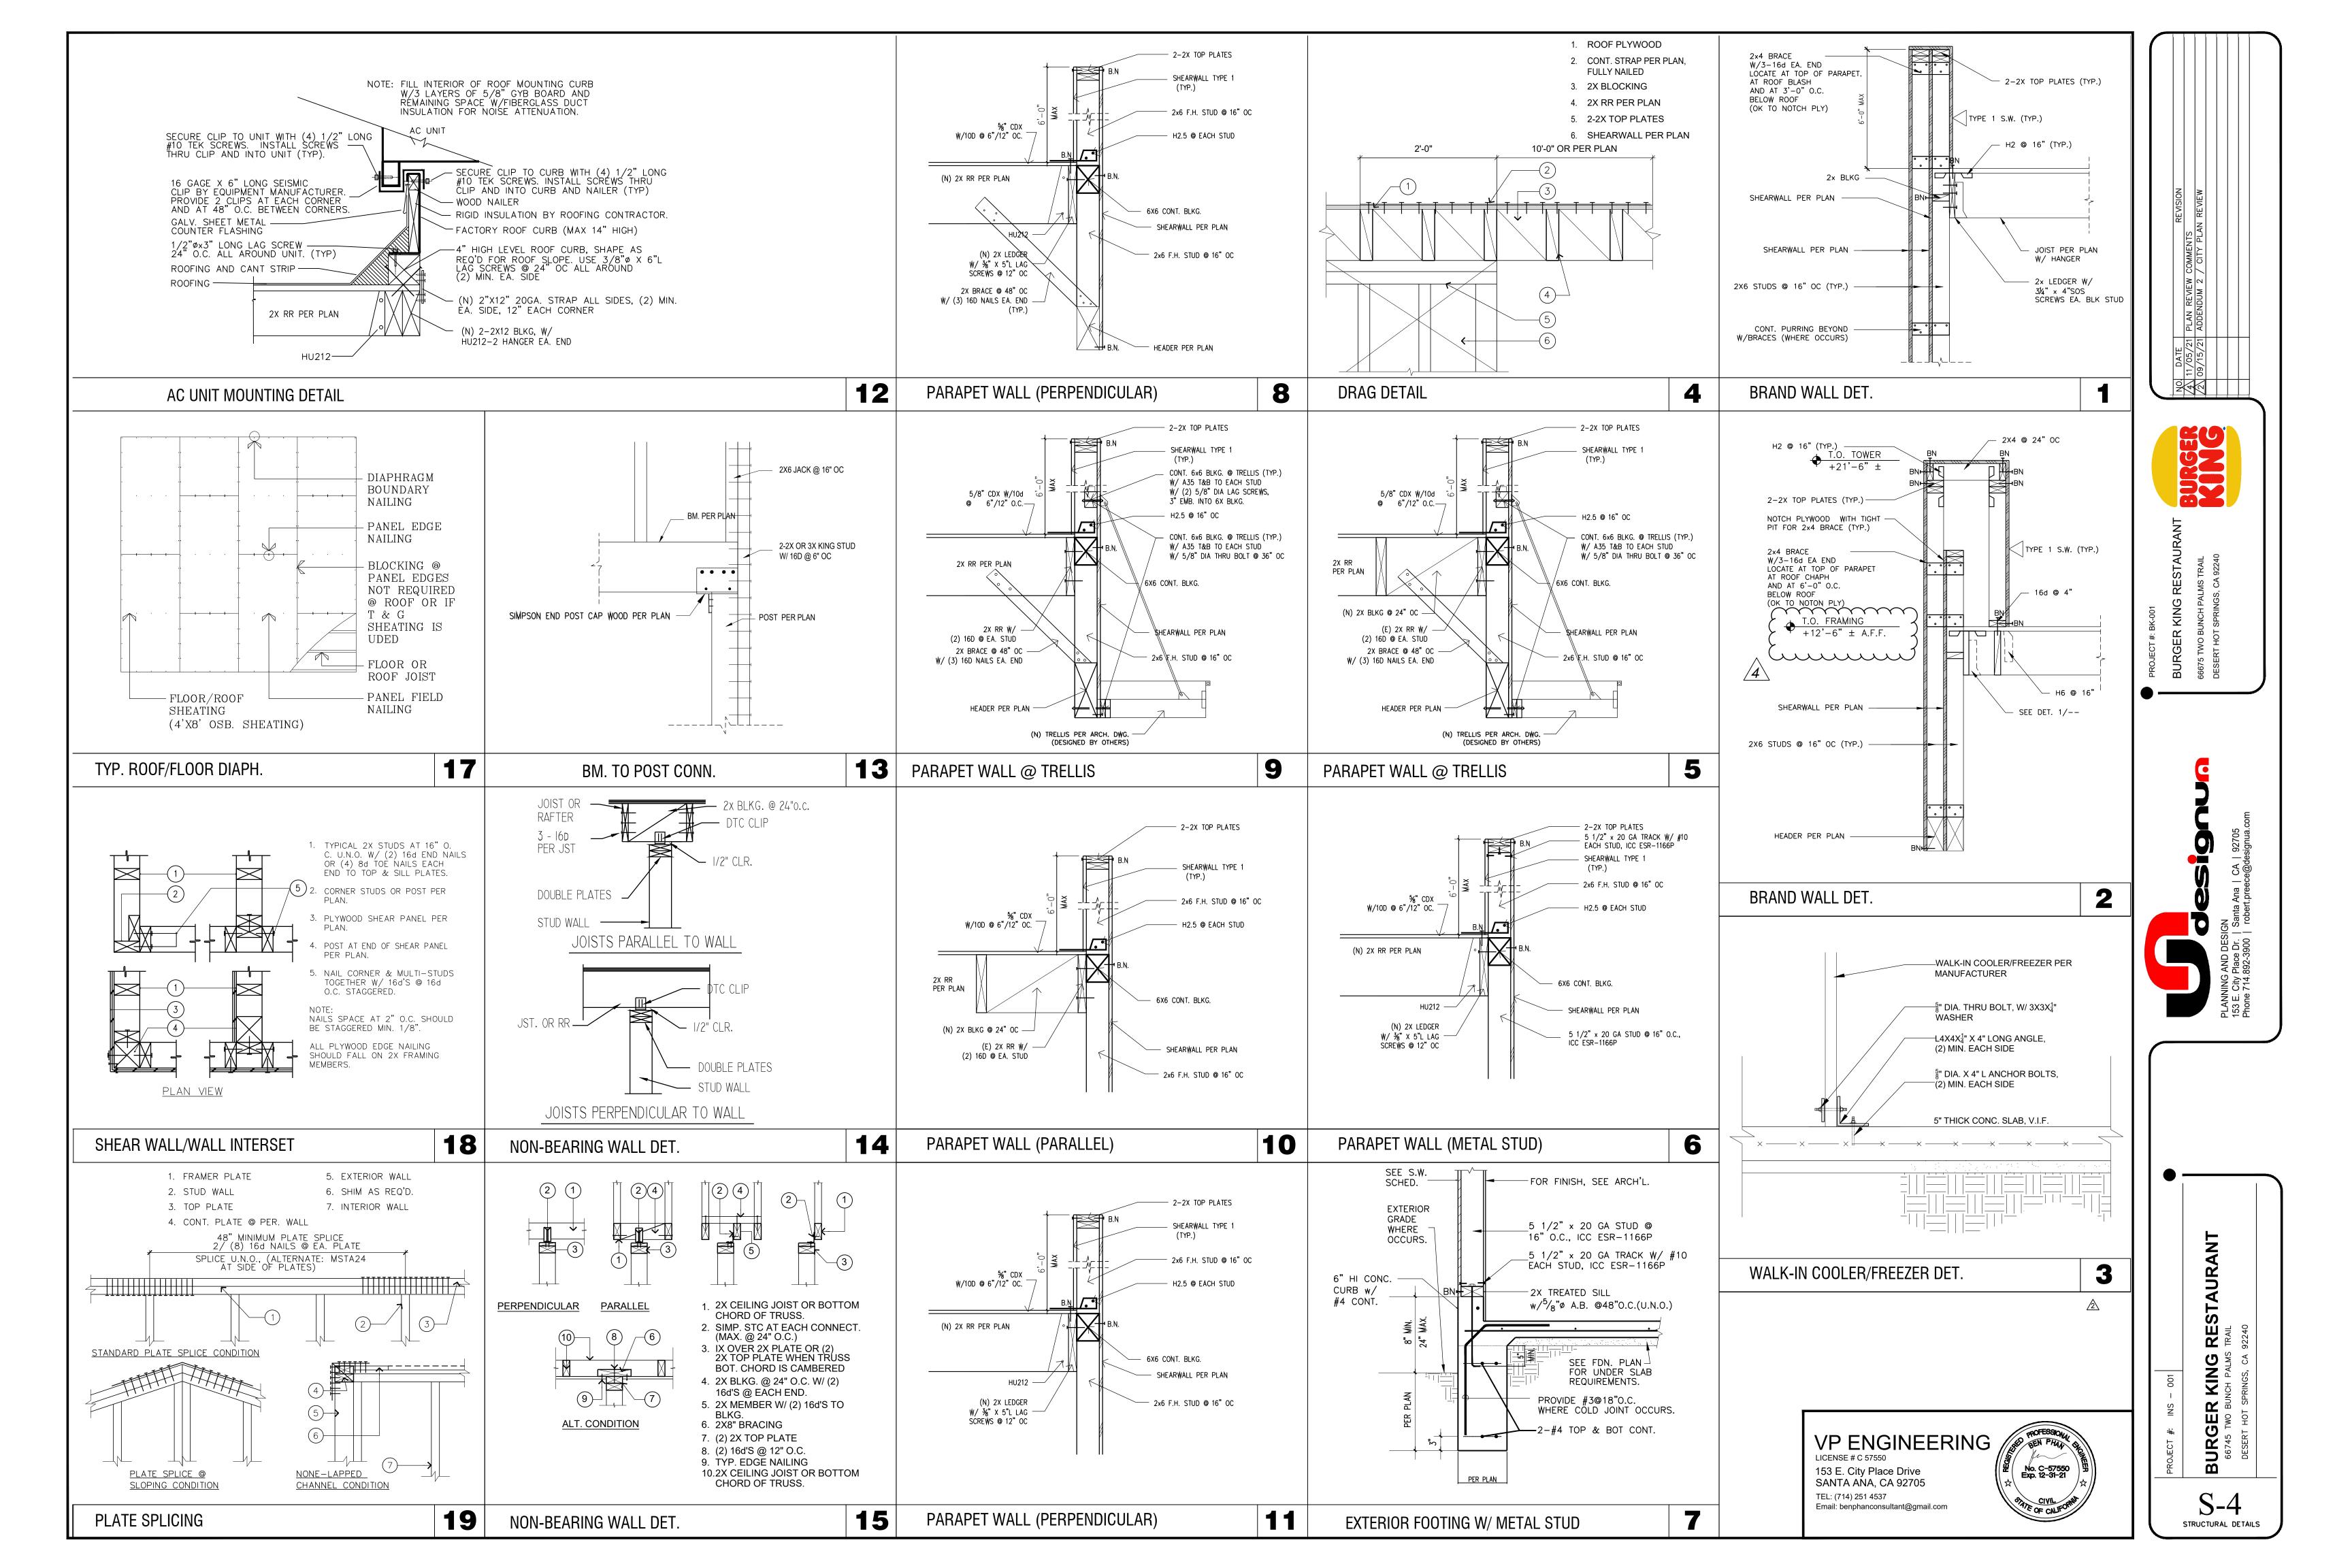



BURGER Burger King

B.K.C. APPROVED

THIS PROJECT HAS BEEN SUBMITTED AND APPROVED BY BURGER KING CORPORATE.

APPROVED DRAWINGS FOR CONSTRUCTION:

ITEMS PROVIDED AND/OR BUILT BY G.C. / INSTALLER / CUSTOMER ARE APPROVED TO BE ORDERED / BUILT PER THIS SET OF PLANS. TEMS BUILT / PROVIDED BY ECC COMMERCIAL FURNITURE SHOULD STILL E CONSIDERED PRELIMINARY UNTIL FINAL DRAWINGS ARE RELEASED



N DIMENSIONS HAVE PRECEDENCE OVER SCAL

DO NOT SCALE OFF PLANS. CONTACT FOO

IESE DOCUMENTS REFLECT SPECIFIC SEATING AND

DESIGN MANAGER: MICKEY HINES T. 800.322.7328 EXT. 210

T. 800.322.7328 EXT. 226

T. 800.322.7328 EXT. 211

T. 800.322.7328 Ext. 268

LEGEND:

REFER TO EACH SHEET FOR ALL NOTES OR CONTRACTOR INFORMATION AND / OR SCHEDULES.

FCC SEATING / DECOR ELEMENT

ITEMS NOT BY FCC & BK CODES

APPROVAL PRINT CC COMMERCIAL FURNITURE IN

PROJECT REVISIONS INITIALS DATE REV. # DESCRIPTION Approved for Construction Λ March 29, 2021 04/13/21 Δ 00/00/00 Δ 00/00/00 Δ 00/00/00 Δ 00/00/00

INDEX OF DRAWINGS:

SHEET DO.0 - COVER SHEET

CUSTOMER INFORMATION, GENERAL NOTES

- SEATING LAYOUT

FURNITURE COMPONENT, SEATING CAPACITY

- PRELIMINARY METALWORK LAYOUT DO NOT CORE DRILL FROM THIS PLAN

SHEET D2.0 THRU D2.2 - INTERIOR BUILDING ELEVATIONS INTERIOR WALL CONDITIONS AND FINISHES

SHEET D3.0 - DECOR ELEVATIONS / DETAILS

ECC DECOR ITEMS SHEET D4.0 - REFLECTED CEILING PLAN

FOR REFERENCE ONLY, DECOR LIGHTING

SHEET D5.0 - FLOOR TILE PLAN

MAIN & ACCENT FLOOR TILE LOCATION SHEET D6.0 - BUILDING FINISH LAYOUT

BUILDING FINISH LOCATIONS

SHEET D7.0 - G.C. PLAN

GC BUILT ITEMS AND ELECTRICAL

SHEET D7.1 - WAY FINDING SIGNAGE SHEET D8.0 THRU D8.3 - DECOR SPECIFICATIONS

FCC FURNITURE ITEMS

SHEET D8.4 THRU D8.6 - FINISH SPECIFICATIONS INTERIOR BUILDING FINISH SPECIFICATIONS

SHEET D9.0 - VERIFICATION PLAN

NOTE: FILL OUT AND RETURN TO ECC

STANDARD STORES PROJECTS:

ALL WORK, CONSTRUCTION, FURNITURE AND MATERIALS SHALL COMPLY WITH ALL . THESE DRAWINGS, SCHEDULES, AND SPECIFICATIONS, AS WELL AS, OTHER PROVISIONS OF LOCAL BUILDING CODES AND WITH OTHER RULES. REGULATIONS SEGMENTS OF SERVICES ARE AND SHALL REMAIN THE PROPERTY OF FCC COMMERCIAL FURNITURE WHETHER OR NOT THE PROJECT THESE DOCUMENTS. WERE PREPARED FOR IS COMPLETED OR EXECUTED. IF THE OWNER/CLIENT HAS COMPENSATED FCC COMMERCIAL FURNITURE UNDER SIGNED CONTRACT THE OWNER IS PERMITTED TO RETAIN COPIES OF THE DRAWINGS. SCHEDULES AND ALLOWED. LICENSED TO PROVIDE SIGNED/SEALED DRAWINGS. FCC COMMERCIAL FURNITURE. SPECIFICATIONS. FCC COMMERCIAL FURNITURE IS NOT RESPONSIBLE FOR ANY LOSS, COSTS OR DAMAGES RELATING TO USE OR APPLICATION. THE OWNER/CLIENT MAY NOT USE THE DRAWINGS. SCHEDULES, SPECIFICATIONS PROVIDED HEREIN FOR ANY PROJECT OTHER THAN THE ORIGINAL PROJECT. FCC COMMERCIAL FURNITURE IS THE OWNER OF THE INTELLECTUAL PROPERTY PROVIDED AND RETAINS ALL STATUTORY AND COMMON LAW COPYRIGHTS. IF OWNER/CLIENT AND FCC COMMERCIAL FURNITURE TERMINATE THIS CONTRACT FOR DESIGN SERVICES. THE OWNER/CLIENT SHALL NO LONGER HAVE THE RIGHTS TO THE DRAWINGS, SCHEDULES, AND SPECIFICATIONS. THE OWNER/CLIENT MAY NOT PERMIT ANY THIRD PARTY TO USE SUCH DRAWINGS, SCHEDULES, AND SPECIFICATIONS FOR DESIGN SERVICES FOR FUTURE ADDITIONS OR ALTERATIONS TO THE PROJECT. THE DESIGN DEPICTED WITHIN THE CONTENTS CONTRACTOR OF ANY SLAB LESS THAN FIVE (5") INCHES THICK. OF THESE DRAWINGS MAY NOT BE USED BY THE OWNER TO SHOP FOR OTHER SEATING AND DECOR MANUFACTURES TO FULFILL THE INTENDED DESIGN. UNAUTHORIZED USE WILL RESULT IN PAYMENT FOR DESIGN SERVICES AT FCC COMMERCIAL FURNITURE'S STANDARD DESIGN RATE. ALL COMPUTER GENERATED IMAGERY, GRAPHICS, DRAWINGS AND ILLUSTRATIONS WITHIN THESE DOCUMENTS

> THE OWNER/CLIENT AND GENERAL CONTRACTOR AGREE THAT ECC COMMERCIAL FURNITURE REPRESENTATIVES MAY VISIT THE SITE AT ANY POINT DURING CONSTRUCTION IN THE INTEREST OF COMPLETING FCC'S WORK.

THE OWNER/CLIENT'S GENERAL CONTRACTOR AGREES TO PROVIDE CONDITIONS CONDUCIVE TO COMPLETE INSTALLATION OF FCC'S WORK UPON DELIVERY OF SEATING AND DECOR ELEMENTS. THE GENERAL CONTRACTOR AGREES TO COOPERATE WITH FCC'S INSTALLATION CREWS IN THE INTEREST OF COMPLETION TABLE TOP/BASE INSTALLATIONS, AISLE WAY CLEARANCES, AND QUEUE LINE AREA OF WORK. THE GENERAL CONTRACTOR WILL NOTIFY FCC IN A TIMELY MANNER, ANY PHYSICAL RESTRICTIONS THAT MAY IMPEDE THE COMPLETION OF THE SEATING AND DECOR PACKAGE.

· WRITTEN DIMENSIONS SUPERSEDE SCALED MEASUREMENTS IN ALL CASES. DO NOT SCALE OFF OF PLANS. FOR ADDITIONAL DIMENSIONS CALL FCC'S GENERAL CONTRACTOR SHALL BE RESPONSIBLE FOR COPYING AND DISTRIBUTING. CLISTOMER SERVICE MANAGER AT 800 322 7328

> FCC REQUIRES VERIFICATION OF FIELD DIMENSIONS FROM THE ARCHITECT / GENERAL CONTRACTOR FOR THE FABRICATION OF COMMERCIAL FURNITURE DECOR, CORE DRILL AND SEATING SPACE PLANS. WHEN FIELD DIMENSIONS CANNOT BE ATTAINED, SHIPMENTS MAY BE SUBJECT TO TIME DELAYS. THE GENERAL CONTRACTOR SHALL VERIEV ALL DIMENSIONS AND CONDITIONS ON SITE AND NOTIFY FCC COMMERCIAL FURNITURE OF ALL DISCREPANCIES PRIOR TO COMMENCING DECOR DESIGN.

THE GENERAL CONTRACTOR WILL BE RESPONSIBLE FOR DISPOSAL OF ALL PACKAGING MATERIAL FROM SEATING AND DECOR PRODUCTS.

THE CREW ROOM AND VESTIBULE FINISHES TO BE THE SAME AS THE MAIN DINING ROOM, UNLESS OTHERWISE STATED BY THE OWNER OR NOTED ON PLANS AND IN THE SPECIFICATION BY FCC.

REMAIN THE PROPERTY OF FCC COMMERCIAL FURNITURE. ALL RIGHTS RESERVED. BACK OF HOUSE TILE. REFER TO ARCHITECTURAL PLAN SET FOR FULL KITCHEN

FCC LIGHTING PLANS ARE GUIDELINES ONLY. FCC WILL NOT BE HELD LIABLE FOR ADDITIONAL COSTS DUE TO ADJUSTING LIGHTING QUANTITIES OR LOCATIONS VARIATIONS WITH ARCHITECTURAL PLANS OR LOCAL CODES. GENERAL CONTRACTOR TO SUPPLY AND CONNECT ELECTRICAL PIGTAILS AT ALL CODED LOCATIONS FOR FCC DECOR PRODUCTS.

ALL ELECTRICAL FIXTURES. WIRING AND INSTALLATION TO BE "U.L. APPROVED." LIGHTING FIXTURES AND/OR HVAC MAY NEED TO BE RELOCATED BY GENERAL CONTRACTOR TO ACCOMMODATE DECOR. REFER TO CEILING PLANS. GENERAL CONTRACTOR TO CONTACT CONSTRUCTION ENGINEER TO VERIFY ALL LIGHTING PLACEMENTS AND FINAL HVAC LOCATIONS.

REBUILDS AND REMODEL PROJECTS:

APPROPRIATE ALLOWANCES FOR NEW FINISH WORK.

FCC'S DECOR AND ELECTRICAL OR HVAC EQUIPMENT.

GENERAL FLOORING NOTES:

IN THE FINISHED FLOOR.

- CASE OF REBUILDING OR REMODELING PROJECTS, ALL EXISTING SEATING,

DECOR, AND WALL FINISHES ARE TO BE PREPPED AND READY TO RECEIVE NEW

FINISHES BY THE OWNER AND/OR GENERAL CONTRACTOR UNI ESS OTHERWISE

- FLOOR AND BASE TILE MUST BE IN GOOD REPAIR BEFORE ANY CORE DRILLING IS

- ALL DIMENSIONS ARE FROM EXISTING FINISHES, UNLESS OTHERWISE NOTED. MAKE

CONTACT FCC'S CUSTOMER SERVICE MANAGERS FOR ANY CONFLICTS BETWEEN

- ALL FLOOR, SCHLUTER STRIP, AND COVE BASE TILE TO BE PROVIDED BY AND

FCC IS NOT LIABLE FOR CORED STEEL THAT MAY BECOME UNSTABLE AS A RESULT

OF DRILLING THROUGH A CONCRETE SLAB. NOTIFY FCC. ARCHITECT, AND GENERAL

- FCC IS NOT RESPONSIBLE FOR DAMAGE OF ANY MECHANICAL ELEMENTS LOCATED

- COVE BASE AND/OR BULLNOSE TILE ON FCC DIVIDER WALLS TO BE SUPPLIED AND

-GENERAL CONTRACTOR IS RESPONSIBLE FOR SUPPLYING AND INSTALLING ALL

GENERAL ELECTRICAL/HVAC/CEILING NOTES:

INSTALLED BY GENERAL CONTRACTOR, UNLESS OTHERWISE NOTED.

INSTALLED BY THE GENERAL CONTRACTOR UNLESS OTHERWISE NOTED.

GENERAL WARRANTIES:

LIMITED WARRANTY: FCC COMMERCIAL FURNITURE WARRANTS TO THE OWNER/CLIENT THAT THE PRODUCTS SOLD WILL BE FREE FROM MATERIAL DEFECTS IN WORKMANSHIP LINDER NORMAL USE AND SERVICE FOR A PERIOD OF ONE YEAR FROM THE DATE OF FCC COMMERCIAL FURNITURE'S DELIVERY OF PRODUCTS TO THE DELIVERED LOCATION. THERE IS NO WARRANTY IN CASES OF DAMAGES IN TRANSIT, NEGLIGENCE, ABUSE, ABNORMAL USAGE, MISUSE, ACCIDENTS, NORMAL WEAR AND TEAR, DAMAGE DUE TO ENVIRONMENTAL OR NATURAL ELEMENTS, FAILURE TO FOLLOW FCC'S INSTRUCTIONS, OR IMPROPER INSTALLATION STORAGE AND/OR MAINTENANCE

THE OWNER/CLIENT SHALL VERIFY THE CONDITIONS OF THE SHIPMENT AND NOTIFY FCC COMMERCIAL FURNITURE OF ANY DAMAGES WITHIN 24 HOURS. TRANSFER OF TITLE OCCURS UPON SHIPMENT FOR FROM ECC'S FACILITY THE OWNER/CLIENT SHALL ACCOMPANY A FCC COMMERCIAL FURNITURE REPRESENTATIVE ON A PROJECT COMPLETION WALK THROUGH TO IDENTIFY INCOMPLETE WORK.

PROJECT CONTACTS:

PLEASE CONTACT ONE OF THE FOLLOWING FCC COMMERCIAL FURNITURE TEAM MEMBERS TO ADDRESS CONCERNS YOU MAY HAVE:

FCC COMMERCIAL FURNITURE, INC. T. 800.322.7328

DRAFTING MANAGER DAVID GALSTER

PROJECT COORDINATOR CHANDRA COUNTS

SALESPERSON. VIRGLE OSBORNE

DESIGNED AND BUILT IN U.S.A.

IMPORTANT

CLIENT:



Burger King 66745 Two Bunch Palms Trail Desert Hot Springs, CA 92240 Decor: Garden Grill **Building Type: Custom**

CUSTOMER F & N Investments

SHEET TITLE: PROJECT **COVER PAGE** WORK ORDER NUMBER:

FINALS BY:

DRAWN BY: AARON McCRAW SCALE NTS

ORIGINAL DATE:

PLOT DATE: April 5, 2021

PROJECT #: 22114-001

GENERAL NOTES: CONTRACTOR / INSTALLER **GENERAL CONSTRUCTION NOTES:**

THE UNIFORM FIRE CODE

SUBCONTRACTORS INVOLVED.

SIGNED AND APPROVED BY OWNER

AND

SPECIFICATIONS

AND ORDINANCES GOVERNING THE LOCATION OF CONSTRUCTION

· FCC COMMERCIAL FURNITURE CONTRACT DOCUMENTS STRIVE TO CONFORM TO

THE INTERNATIONAL BUILDING CODE. FCC COMMERCIAL FURNITURE IS NOT

DRAWINGS AND SPECIFICATIONS THAT MEET LOCAL BUILDING CODES.

COOPERATES WITH OWNER/CLIENT'S LICENSED PROFESSIONALS TO PROVIDE

FCC COMMERCIAL FURNITURE CONTRACT DOCUMENTS STRIVE TO CONFORM TO

THE TITLE III OF THE AMERICANS WITH DISABILITY ACT (ADA). FCC COMMERCIAL

FURNITURE IS NOT LICENSED TO PROVIDE SIGNED/SEALED DRAWINGS. FCC

PROFESSIONALS TO PROVIDE DRAWINGS AND SPECIFICATIONS THAT ARE IN

COMPLIANCE WITH ADA. FCC CANNOT BE RESPONSIBLE FOR CONSTRUCTION

DEVIATIONS BY OTHERS FROM THE DESIGN THAT MAY BE OUT OF COMPLIANCE

· IT IS THE RESPONSIBILITY OF ALL PARTIES SUPPLYING LABOR, MATERIAL, OR

BETWEEN THE CODE REQUIREMENT AND THESE DESIGN INTENT DRAWINGS

BOTH TO BRING TO THE ATTENTION OF ECC'S CUSTOMER SERVICE MANAGER

THE PROJECT ARCHITECT, AND THE OWNER ANY DISCREPANCIES OR CONFLICT

THE APPLICABLE CODES SHOULD INCLUDE, BUT SHALL NOT BE LIMITED TO THE INTERNATIONAL BUILDING CODE, BOCA NATIONAL BUILDING CODE, UNIFORM

GENERAL CONTRACTOR SHALL BE RESPONSIBLE FOR PROVIDING ALL WORK IN

AMERICANS WITH DISABILITIES ACT GUIDELINES, INCLUDING BUT NOT LIMITED TO

· GENERAL CONTRACTOR SHALL BE RESPONSIBLE FOR OBTAINING ALL REQUIRED

ACCORDANCE WITH ALL LOCAL AND CITY BUILDING CODES/ ORDINANCES

GENERAL CONTRACTOR SHALL BE RESPONSIBLE FOR ADHERING TO ALL

ALL FCC COMMERCIAL FURNITURE INC'S PLANS AND DOCUMENTS TO ALL

FCC PROVIDED DIMENSIONS ARE INDICATED FROM INSIDE WALL FACES.

· ALL SEATING, FINISH, AND DECOR ITEMS INDICATED AS BEING SUPPLIED AND OR

INSTALLED BY GENERAL CONTRACTOR ARE THE RESPONSIBILITY OF THE OWNER.

THE OWNER'S RESPONSIBILITIES INCLUDE ALL CONTRACTS WITH THE GENERAL

SUB-CONTRACTORS AND THEIR COMPLIANCE WITH THESE DOCUMENTS AND

THESE DRAWINGS AND DOCUMENTS REPRESENT THE DESIGN INTENT AND


CONCEPTS FOR THIS PROJECT. THE DRAWINGS AND DOCUMENTS MUST BE

BUILDING CONSTRUCTION AND INSTALLATION PERMITS.

PLUMBING CODE, UNIFORM ELECTRICAL CODE, UNIFORM MECHANICAL CODE AND

COMMERCIAL FURNITURE COOPERATES WITH OWNER/CLIENT'S LICENSED

66745 Two Bunch Palms Trail Desert Hot Springs, CA 92240

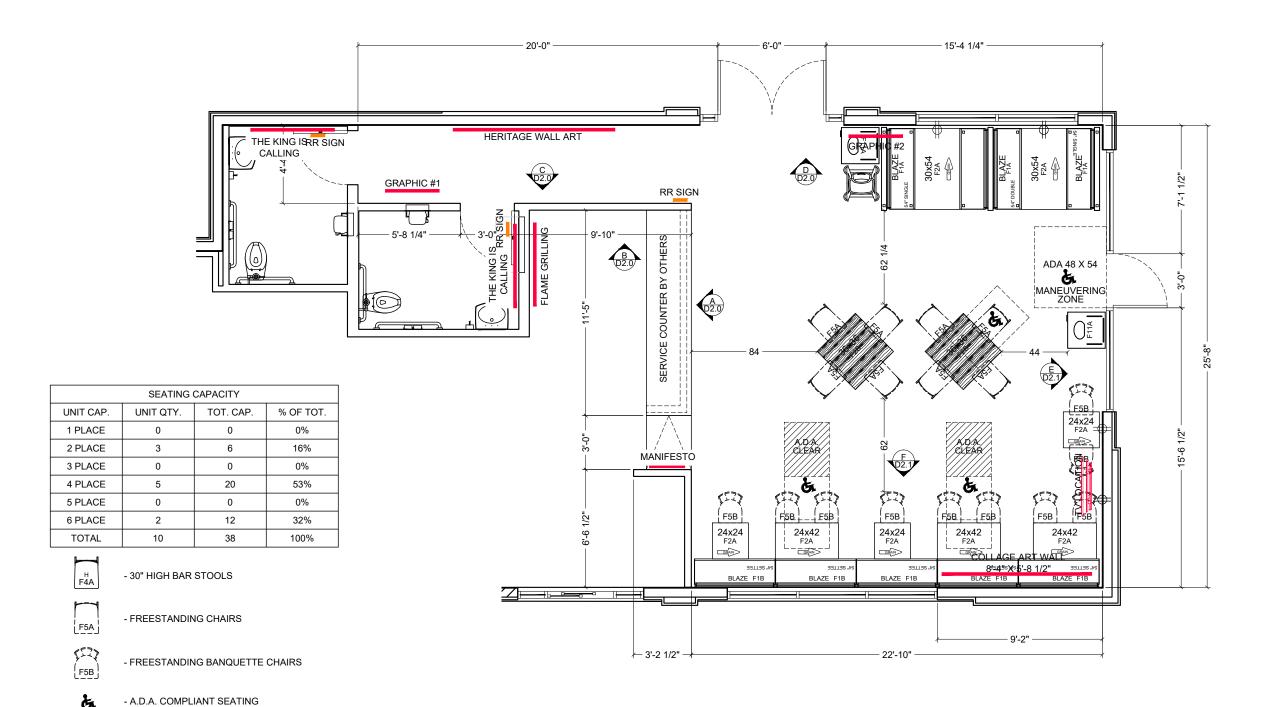

NOTE: ALL ELECTRICAL OUTLETS ARE SHOWN

AS SUGGESTED LOCATIONS ONLY. VERIFY W/

ARCHITECT PRIOR TO INSTALLATION.



FCC COMMERCIAL FURNITURE INC.
452 OLD HWY 99 N, ROSEBURG, OR 97470 USA
800.322.7328 J F. 541.673.7441 J WWW.FCCFURN.CC
DESIGNED AND BUILT IN U.S.A.

PERTY OF FCC COMMERCIAL FURNITURE IS A FOR DESIGN PURPOSE TO EXPRESS DES CEPTS TO THE ARCHITECT, CLIENT, CONTRAC INSTALLER FOR THE PROJECT SHOWN. THIS

ICEPTS TO THE ARCHITECT. CLIENT, CONTRACTOR INSTALLER FOR THE PROJECT SHOWN. THIS DESIGN THE CONCEPTS HEREIN SHALL IS EALTHEAD OF USED AS CONSTRUCTION JUMENTS. DO NOT REPRODUCE OR LEND WITHOUT TITEN PERMISSION FROM FCC COMMERCIAL NITURE INC.

IMPORTANT

WRITTEN DIMENSIONS HAVE PRECEDENCE OVER S IN ALL CASES

> DO NOT SCALE OFF PLANS. CONTACT FCC COMMER FURNITURE'S REPRESENTATIVE TO VERIFY ANY QUESTIONABLE DIMENSIONS AT TELEPHONE # 800.322.7328

HE GENERAL CONTRACTOR MUST VERIFY ALL BUILD IMENSIONS, EQUIPMENT, FURNITURE PLACEMENT, TILITY LOCATIONS, AND CONDITIONS AT THE JOB SIT

THE GENERAL CONTRACTOR MUST NOTIFY FCC COMMERCIAL FURNITURE OF ALL DISCREPANCIES ANDIOR REQUIRED ADJUSTMENTS PRIOR TO STARTING

FCC COMMERCIAL FURNITURE HAS PREPARED THESE DOCUMENTS AS ACCURANTELY AS POSSIBLE WITH THE OF ACCURATE AND AND COMPLETE DIMENSIONED ARCHITECTURAL PLANS, OWNER LINDERSTANDS THAT ADJUSTMENTS TO THE FINAL LOCATIONS OF EQUIPMEN AND OF FURNITURE PLACEMENT MAY BE REQUIRED. AT ON ACTUAL DISS TED BILESTONES AND CONTINUES.

REFER TO ARCHITECTURAL OR ENGINEER DRAWING FOR COMPLETE AND ACCURATE DIMENSIONS OF BUILDING STRUCTURE.

THESE CONTRACT DOCUMENTS AND THE INFORMAT THEY CONTAIN ARE THE PROPERTY OF FCC COMME FURNITURE INC., ROSEBURG, OREGON, 97470.

COPIED, REPRODUCED, USED OR IMPLEMENTED IN ANY WAY, IN PART OR IN WHOLE, WITHOUT THE EXPRESS WRITTEN CONSENT OF FCC COMMERCIAL FURNITURE IN

ANY UNAUTHORIZED USE OF THESE PLANS WILL RESULT IN PAYMENT DUE FOR SERVICES RENDERED BY FCC COMMERCIAL FURNITURE INC.

ANY DEVIATIONS FROM THESE DRAWINGS FOR ANY REASON SHALL NOT BE DONE WITHOUT CONSENT OF FI COMMERCIAL FURNITURE INC., IN ADVANCE, IN WRITING FOC COMMERCIAL FURNITURE IS NOT RESPONSIBLE FO DEVIATIONS, CHANCES, ADDITIONS, OR DELETIONS NOT REVIEWED AND APPROVED IN ADVANCE BY FCC COMMERCIAL FURNITURE INC.

THESE DOCUMENTS REFLECT SPECIFIC SEATING AND DECOR EQUIPMENT ORDERED OF DATE SHOWN BELOW

CLIENT:



Burger King 66745 Two Bunch Palms Trail Desert Hot Springs, CA 92240 Decor: Garden Grill Building Type: Custom

CUSTOMER
F & N Investments

SHEET TITLE:
DINING ROOM
SEATING LAYOUT
WORK ORDER NUMBER:

FINALS BY:

DRAWN BY:
AARON McCRAW
SCALE:

3/16" = 1'-0"

ORIGINAL DATE:

March 29, 2021


PLOT DATE:

April 5, 2021

PROJECT #:

22114-001

SHEET #: **D1.0**

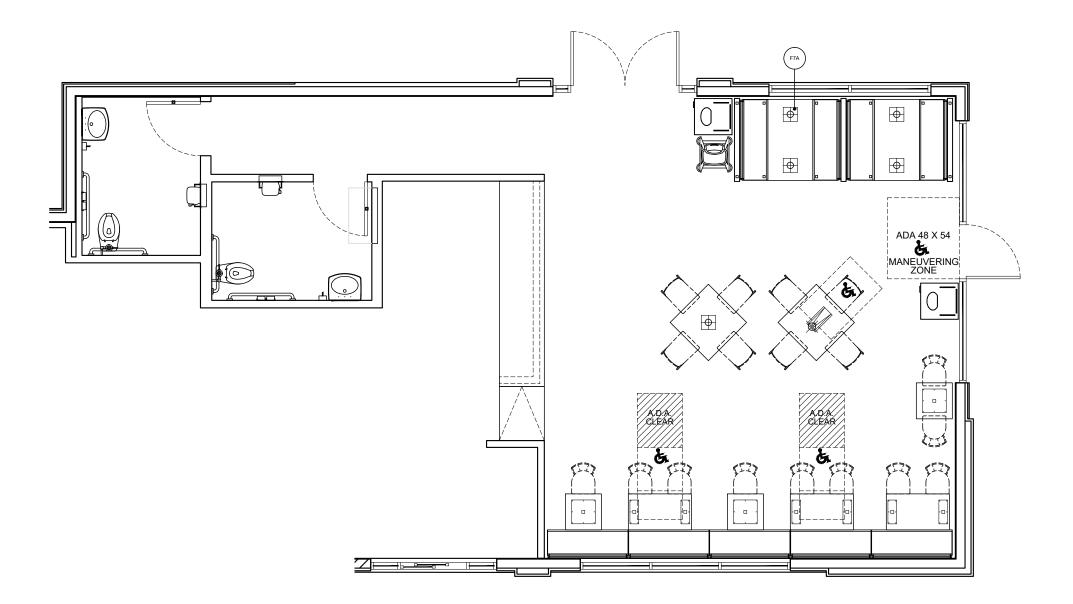

*Note: Preliminary Metalwork.
(DO NOT CORE FROM THIS PLAN)



FCC COMMERCIAL FURNITURE INC. 8452 OLD HWY 99 N, ROSEBURG, OR 97470 USA . 800.322.7328 | F. 541.673.7441 | WWW.FCCFURN.CO DESIGNED AND BUILT IN U.S.A.

ROPERTY OF FCC COMMERCIAL FURNITURE
HIS IS A FOR DESIGN PURPOSE TO EXPRESS DESIG
ONCEPTS TO THE ARCHITECT, CLIENT, CONTRACTO
NO INSTALLER FOR THE PROJECT SHOWN. THIS DE
NOTHE CONCEPTS HEREIN SHALL
OT BE ALTERED OR USED AS CONSTRUCTION

IMPORTANT

WRITTEN DIMENSIONS HAVE PRECEDENCE OVER SCA

INDITION SCALE OF PLANS. CONTROL FOR COMMERCIAL RINITURE'S REPRESENTATIVE TO VERIFY ANY JESTIONABLE DIMENSIONS AT TELEPHONE # 0.322.7328

THE GENERAL CONTRACTOR MUST VERIFY ALL BUILDIMENSIONS, EQUIPMENT, FURNITURE PLACEMENT

THE GENERAL CONTRACTOR MUST NOTIFY FCC
COMMERCIAL FURNITURE OF ALL DISCREPANCIES
ANDIOR REQUIRED ADJUSTMENTS PRIOR TO STAR

FCC COMMERCIAL FURNITURE HAS PREPARED THESE DOCUMENTS AS ACCURATELY AS POSSIBLE WITH THE ARCHITECTURE. IN PROMISTION PROVIDED LUE TO LO FACCURATE AND AND COMPLETE DIMENSIONED ARCHITECTURE. PLANS, OWNER TUNDERSTANDS THAT ADJUSTMENTS TO THE FINAL LOCATIONS OF COUPMENT AND AND CONTINUES THAT THE OWNERS EXPENSE DUE TO DISCREPANCIES BASE ON ACTUAL JOSS PERMENS EDITED THE DIMENSIONS AND CONDITIONS.

REFER TO ARCHITECTURAL OR ENGINEER DRAWINGS FOR COMPLETE AND ACCURATE DIMENSIONS OF BUILDING STRUCTURE

> HESE CONTRACT DOCUMENTS AND THE INFORMATIC HEY CONTAIN ARE THE PROPERTY OF FCC COMMERI URNITURE INC., ROSEBURG, OREGON, 97470.

COPIED, REPRODUCED, USED OR IMPLEMENTED IN ANY WAY, IN PART OR IN WHOLE, WITHOUT THE EXPRESS WRITTEN CONSENT OF FCC COMMERCIAL FURNITURE I

ANY UNAUTHORIZED USE OF THESE PLANS WILL RESUL IN PAYMENT DUE FOR SERVICES RENDERED BY FCC COMMERCIAL FURNITURE INC.

REASON SHALL NOT BE DONE WITHOUT CONSENT OF FIC COMMERCIAL FURNITURE INC. IN AUTOMOSE, IN WITHOUTHER INC. TO FCC COMMERCIAL FURNITURE IS NOT RESPONSIBLE FO DEVIATIONS, CHANGES, ADDITIONS, OR DELETIONS NOT REVIEWED AND APPROYED IN ADVANCE BY FCC COMMERCIAL FURNITURE INC.

DECOR EQUIPMENT ORDERED OF DATE SHOWN BEI

CLIENT:



Burger King 66745 Two Bunch Palms Trail Desert Hot Springs, CA 92240 Decor: Garden Grill Building Type: Custom

CUSTOMER

F & N Investments

SHEET TITLE:
DINING ROOM PRELIM.
METALWORK LAYOUT
WORK ORDER NUMBER:

FINALS BY:

DRAWN BY:
AARON McCRAW
SCALE:

3/16" = 1'-0"

ORIGINAL DATE:

March 29, 2021

PLOT DATE:

April 5, 2021

PROJECT #:

22114-001

SHEET #:

D1.1





DESIGNED AND BUILT IN U.S.A.

IMPORTANT

DO NOT SCALE OFF PLANS. CONTACT FCC FURNITURE'S REPRESENTATIVE TO VERIF

THESE DOCUMENTS REFLECT SPECIFIC SEATING AND DECOR EQUIPMENT ORDERED OF DATE SHOWN BELOW

CLIENT:



Burger King 66745 Two Bunch Palms Trail Desert Hot Springs, CA 92240 Decor: Garden Grill Building Type: Custom

CUSTOMER F & N Investments

SHEET TITLE: INTERIOR BUILDING ELEVATIONS WORK ORDER NUMBER

FINALS BY:

DRAWN BY: AARON McCRAW SCALE:

1/4" = 1'-0"

ORIGINAL DATE:


March 29, 2021 PLOT DATE:


April 5, 2021

PROJECT #: 22114-001

SHEET #:

D2.0

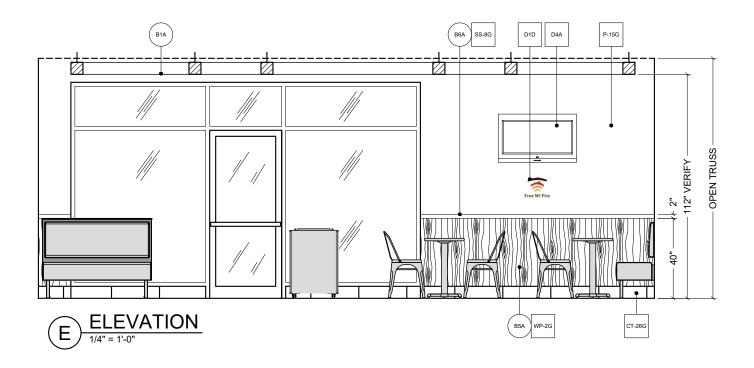

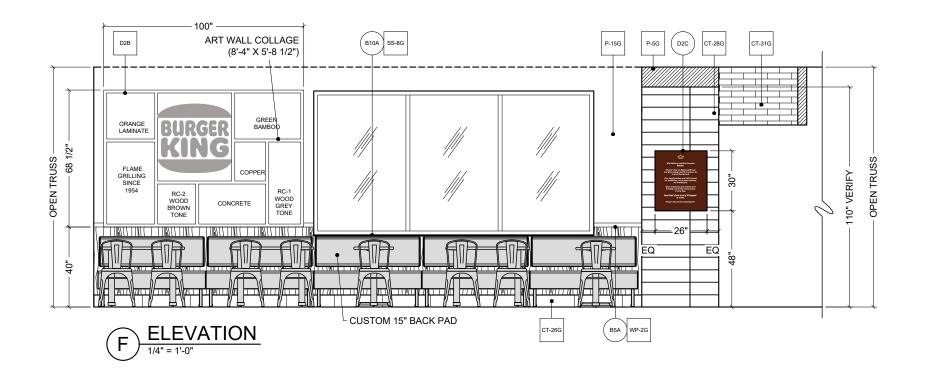



FCC COMMERCIAL FURNITURE INC.
8452 OLD HWY 99 N, ROSEBURG, OR 97470 USA
.800.322.7328 | F. 541.673.7441 | WWW.FCCFURN.CO
DESIGNED AND BUILT IN U.S.A.

PROPERTY OF FCC COMMERCIAL FURNITURE THIS IS A FOR DESIGN PURPOSE TO EXPRESS DESIGN NOCOCEPTS TO THE ARCHITECT, CLIENT, CONTRACTO AND INSTALLER FOR THE PROJECT SHOWN. THIS DESIGN THE CONCEPTS HEREIN SHALL NOT BE ALTERED OR USED AS CONSTRUCTION DOCUMENTS. DO NOT REPRODUCE OR LEND WITHOUT WHITE PREMISSION FROM PCC COMMERCIAL.

IMPORTANT

WRITTEN DIMENSIONS HAVE PRECEDENCE OVER SCAL

DO NOT SCALE OFF PLANS. CONTACT FCC COMMERCIAL FURNITURE'S REPRESENTATIVE TO VERIFY ANY QUESTIONABLE DIMENSIONS AT TELEPHONE # 800.322.7328

THE GENERAL CONTRACTOR MUST VERIFY ALL BUILDIN DIMENSIONS, EQUIPMENT, FURNITURE PLACEMENT, JTILITY LOCATIONS. AND CONDITIONS AT THE JOB SITE

THE GENERAL CONTRACTOR MUST NOTIFY FCC COMMERCIAL FURNITURE OF ALL DISCREPANCIES NADIOR REQUIRED ADJUSTMENTS PRIOR TO STARTING



FOR COMPLETE AND ACCURATE DIMENSIONS OF BUILDING STRUCTURE.

THESE CONTRACT DOCUMENTS AND THE INFORMATION THEY CONTAIN ARE THE PROPERTY OF FCC COMMERC FURNITURE INC., ROSEBURG, OREGON, 97470.

ALL PREPARED CONTRACT DOCUMENTS MAY NOT BE COPIED, REPRODUCED, USED OR IMPLEMENTED IN ANY WAY, IN PART OR IN WHOLE, WITHOUT THE EXPRESS WRITTEN CONSENT OF FCC COMMERCIAL FURNITURE INC

ANY UNAUTHORIZED USE OF THESE PLANS WILL RESULT IN PAYMENT DUE FOR SERVICES RENDERED BY FCC COMMERCIAL FURNITURE INC.

ANY DEVARIONS FROM THESE DRAWINGS FOR ANY REASON SHALL NOT SE DONE WITHOUT CONSENT OF FOR COMMERCIAL PRINTITURE IN, ON ADVANCE, IN WRITING, FCC COMMERCIAL FURNITURE IS NOT RESPONSIBLE FOR DEVARTONS, CHANGES, ADDITIONS, OR DELETIONS NOT REVENTED AND APPROVED IN ADVANCE BY FCC COMMERCIAL PURITURE IN.

THESE DOCUMENTS REFLECT SPECIFIC SEATING AND DECOR EQUIPMENT ORDERED OF DATE SHOWN BELOW

CLIENT:



Burger King 66745 Two Bunch Palms Trail Desert Hot Springs, CA 92240 Decor: Garden Grill Building Type: Custom

CUSTOMER
F & N Investments

SHEET TITLE: INTERIOR BUILDING ELEVATIONS

WORK ORDER NUMBER

FINALS BY:

DRAWN BY:
AARON McCRAW
SCALE:

1/4" = 1'-0"

ORIGINAL DATE:

March 29, 2021


PLOT DATE:

April 5, 2021

PROJECT #:

22114-001

SHEET #: **D2.1**

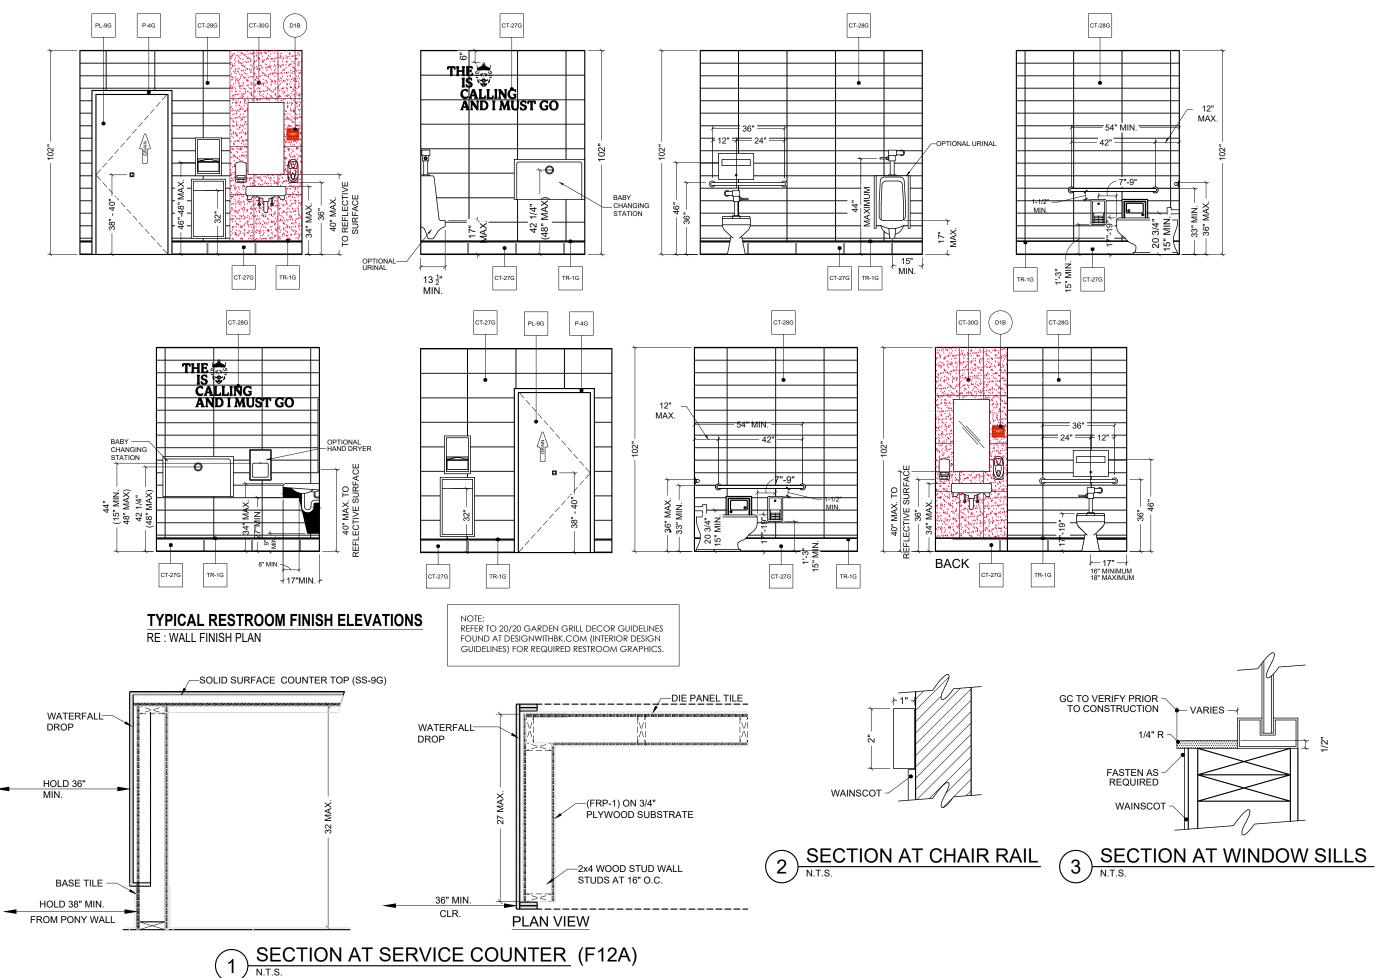



DESIGNED AND BUILT IN U.S.A.

IMPORTANT

CLIENT:



Burger King 66745 Two Bunch Palms Trail Desert Hot Springs, CA 92240 Decor: Garden Grill Building Type: Custom

CUSTOMER

F & N Investments SHEET TITLE: INTERIOR BUILDING

ELEVATIONS WORK ORDER NUMBER

FINALS BY:

DRAWN BY: AARON McCRAW SCALE:

1/4" = 1'-0"

ORIGINAL DATE:


March 29, 2021 PLOT DATE:

April 5, 2021


PROJECT #: 22114-001

SHEET #:

D2.2

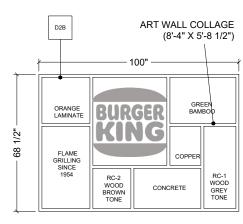



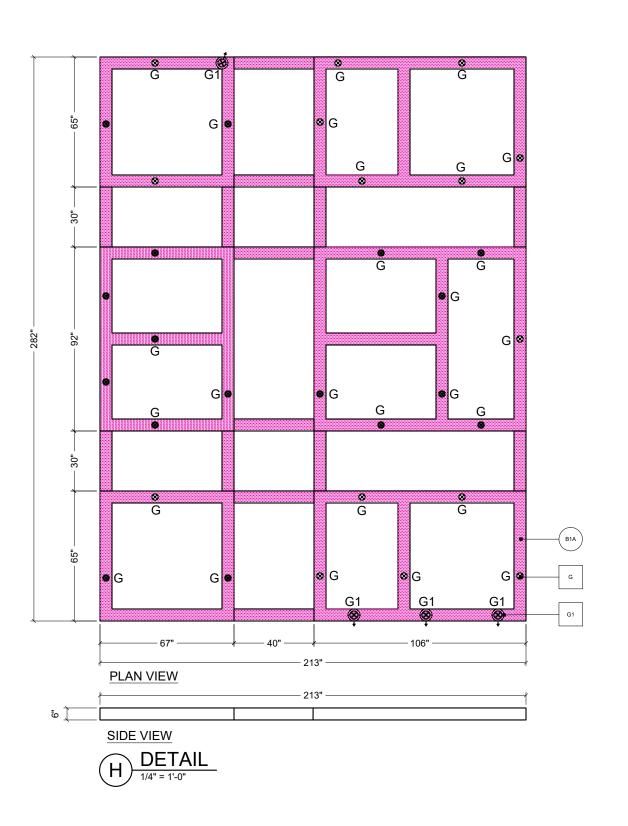



FCC COMMERCIAL FURNITURE INC.
8452 OLD HWY 99 N, ROSEBURG, OR 97470 USA
.800.322.7328 | F. 541.673.7441 | WWW.FCCFURN.CO
DESIGNED AND BUILT IN U.S.A.

PROPERTY OF FCC COMMERCIAL FURNITURE
THIS IS A FOR DESIGN PURPOSE TO EXPRESS DESIGN
CONCEPTS TO THE ARCHITECT, CLIENT, CONTRACTOR
AND INSTALLER FOR THE PROJECT SHOWN. THIS DES

IMPORTANT

WRITTEN DIMENSIONS HAVE PRECEDENCE OVER SCALE IN ALL CASES.

DO NOT SCALE OFF PLANS. CONTACT FCC COMMERCIAL FURNITURE'S REPRESENTATIVE TO VERIFY ANY QUESTIONABLE DIMENSIONS AT TELEPHONE # 800.322.7328

THE GENERAL CONTRACTOR MUST VERIFY ALL BUIL DIMENSIONS, EQUIPMENT, FURNITURE PLACEMENT, LITHLITY LOCATIONS AND CONDITIONS AT THE JOB S

THE GENERAL CONTRACTOR MUST NOTIFY FCC COMMERCIAL FURNITURE OF ALL DISCREPANCIES AND/OR REQUIRED ADJUSTMENTS PRIOR TO START WORK

CC COMMERCIAL FUNDITURE HAS PREPARED THESE DOUBLENTS AS ACCURATELY AS POSSIBLE WITH THE ARCHITECTURAL INFORMATION PROVIDED DUE TO LAC OF ACCURATE AND AND COMPLETE DIMENSIONED ARCHITECTURAL PLANS, OWNER UNDERSTANDES THAT AND ADD COMPLETE DIMENSIONED ARCHITECTURAL PLANS, OWNER UNDERSTANDES THAT AND ADD THAT THAT PLANS PLANS AND ADD THAT THAT PLANS PLANS AND CONTROLLED AND ACTUAL JOSS SITE DIMENSIONS AND CONDITIONS.

REFER TO ARCHITECTURAL OR ENGINEER DRAWING FOR COMPLETE AND ACCURATE DIMENSIONS OF BUILDING STRUCTURE.

THESE CONTRACT DOCUMENTS AND THE INFORMATIO THEY CONTAIN ARE THE PROPERTY OF FCC COMMERC FURNITURE INC., ROSEBURG, OREGON, 97470.

WAY, IN PART OR IN WHOLE, WITHOUT THE EXPRESS WRITTEN CONSENT OF FCC COMMERCIAL FURNITURE IN

IN PAYMENT DUE FOR SERVICES RENDERED BY FCC
COMMERCIAL FURNITURE INC.

ANY DEVIATIONS FROM THESE DRAWINGS FOR ANY REASON SHALL NOT BE DONE WITHOUT COMESHY OF FOR COMMERCIAL FURNITURE IN. ON ADVANCE, IN WRITING, FCC COMMERCIAL FURNITURE IS NOT RESPONSIBLE FOR DEVIATIONS, CHANGES, ADDITIONS, OR DELETIONS NOT REVIEWED WILD APPROVED IN ADVANCE BY FCC COMMERCIAL FURNITURE ME.

THESE DOCUMENTS REFLECT SPECIFIC SEATING AND DECOR EQUIPMENT ORDERED OF DATE SHOWN BELOW

CLIENT:



Burger King 66745 Two Bunch Palms Trail Desert Hot Springs, CA 92240 Decor: Garden Grill Building Type: Custom

CUSTOMER

F & N Investments

SHEET TITLE:

ELEVATIONS
WORK ORDER NUMBER:

FINALS BY:

DECOR

DRAWN BY:
AARON McCRAW
SCALE:

1/4" = 1'-0"

ORIGINAL DATE:


March 29, 2021

PLOT DATE: April 5, 2021

PROJECT #:

22114-001

SHEET #: **D3.0**

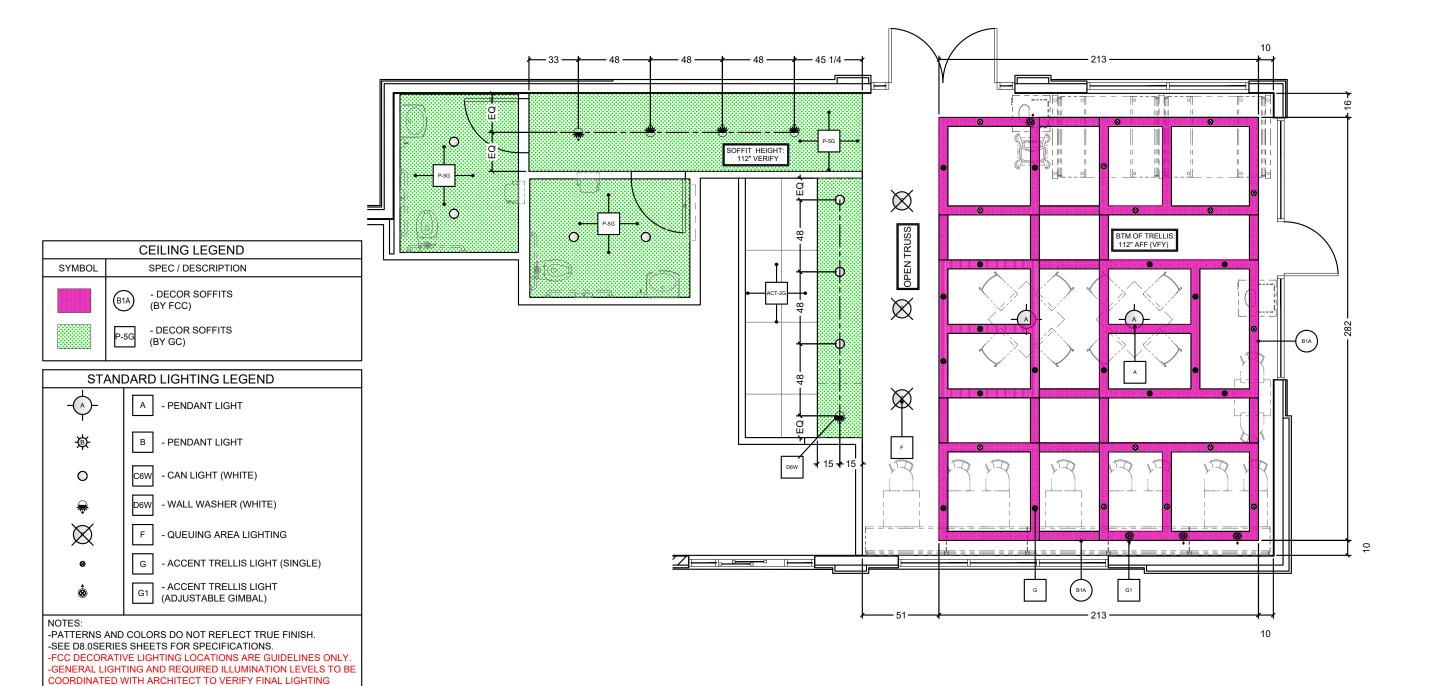



PROPERTY OF FCC COMMERCIAL FURNITURE
THIS IS A FOR DESIGN PURPOSE TO EXPRESS DESIGN
CONCEPTS TO THE ARCHITECT, CLIENT, CONTRACTOR
AND INSTALLER FOR THE PROJECT SHOWN. THIS DESI
AND THE CONCEPTS HEREIN SHALL
NOT BE ALTEREO OR USED AS CONSTRUCTION
DOCUMENTS. DO NOT REPRODUCE OR LEND WITHOUT

IMPORTANT

WRITTEN DIMENSIONS HAVE PRECEDENCE OVER SCAL

DO NOT SCALE OFF PLANS. CONTACT FCC COMMERCIAL FURNITURE'S REPRESENTATIVE TO VERIFY ANY QUESTIONABLE DIMENSIONS AT TELEPHONE # 800.322.7328

THE GENERAL CONTRACTOR MUST VERIFY ALL BUILDIMENSIONS, EQUIPMENT, FURNITURE PLACEMENT

THE GENERAL CONTRACTOR MUST NOTIFY FCC
COMMERCIAL FURNITURE OF ALL DISCREPANCIES

WORK.

FCC COMMERCIAL FURNITURE HAS PREPARED THESE
DOCUMENTS AS ACCURATELY AS POSSIBLE WITH THE
ARCHITECTURAL INFORMATION PROVIDED, DUE TO LAC
OF ACCURATE AND AND COMPLETE DIMENSIONCE
ARCHITECTURAL PLANS, OWNER UNDERSTANDS THAT

REFER TO ARCHITECTURAL OR ENGINEER DRAWINGS FOR COMPLETE AND ACCURATE DIMENSIONS OF

THESE CONTRACT DOCUMENTS AND THE INFORMAT THEY CONTAIN ARE THE PROPERTY OF FCC COMME

ALL PREPARED CONTRACT DOCUMENTS MAY NOT BE COPIED, REPRODUCED, USED OR IMPLEMENTED IN AN

IN PAYMENT DUE FOR SERVICES RENDERED BY FCC COMMERCIAL FURNITURE INC.

ANY DEVIATIONS FROM THESE DRAWINGS FOR ANY REASON SHALL NOT BE DONE WITHOUT CONSENT OF FOCOMMERCIAL FURNITURE IN, OR DAVANCE, IN WRITING, FCC COMMERCIAL FURNITURE IS NOT RESPONSIBLE FOR DEVIATIONS, CHANGES, ADDITIONS, OR DELETIONS NOT REVIEWED AND APPROVED IN ADVANCE BY FCC COMMERCIAL FURNITURE INC.

THESE DOCUMENTS REFLECT SPECIFIC SEATING AND DECOR EQUIPMENT ORDERED OF DATE SHOWN BELOW

CLIENT:



Burger King

66745 Two Bunch Palms Trail Desert Hot Springs, CA 92240 Decor: Garden Grill Building Type: Custom

CUSTOMER

F & N Investments

SHEET TITLE: DINING ROOM

REFLECTED CEILING PLAN WORK ORDER NUMBER:

FINALS BY:

DRAWN BY:
AARON McCRAW
SCALE:

3/16" = 1'-0"

ORIGINAL DATE:

March 29, 2021

PLOT DATE:

April 5, 2021

PROJECT #:

22114-001


SHEET #: **D4.0**

BOH ACT AND LIGHTING ARE REQUIRED. FRP MIGHT BE ADDED.


PLACEMENTS AND HVAC LOCATIONS.

NOTE:

-GENERAL CONTRACTOR IS RESPONSIBLE FOR SUPPLYING AND INSTALLING ALL BACK OF HOUSE TILE. REFER TO ARCHITECTURAL PLAN SET FOR FULL KITCHEN PLANS.

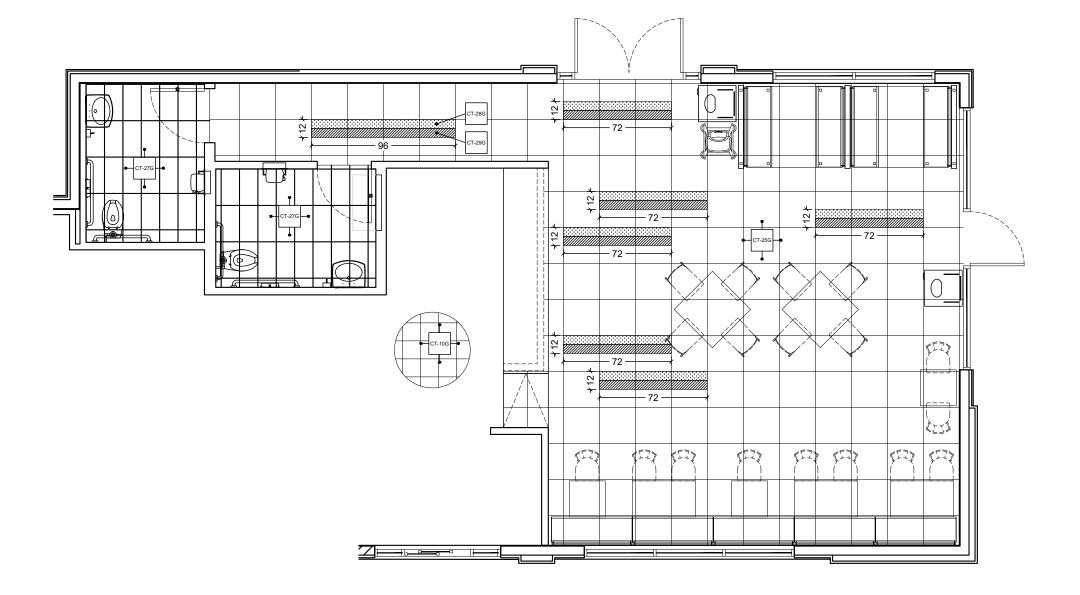




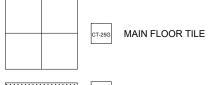







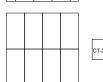

RESTROOM FLOOR TILE (R6A)



FCC COMMERCIAL FURNITURE INC. 8452 OLD HWY 99 N, ROSEBURG, OR 97470 USA 7. 800.322.7328 | F. 541.673.7441 | WWW.FCCFURN.CO

DESIGNED AND BUILT IN U.S.A.


IMPORTANT

WRITTEN DIMENSIONS HAVE PRECEDENCE OVER SCALE IN ALL CASES.

DO NOT SCALE OFF PLANS. CONTACT FCC COMMERCIAL FURNITURE'S REPRESENTATIVE TO VERIFY ANY QUESTIONABLE DIMENSIONS AT TELEPHONE # 800.322.7328

THE GENERAL CONTRACTOR MUST VERIFY ALL BUIL DIMENSIONS, EQUIPMENT, FURNITURE PLACEMENT, LITILITY LOCATIONS AND CONDITIONS AT THE JOB S

THE GENERAL CONTRACTOR MUST NOTIFY FCC
COMMERCIAL FURNITURE OF ALL DISCREPANCIES

FIG. COMMERCIAL FUNDTURE HAS PREPARED THESE OCCUMENTS AS ACCURATELY AS POSSIBLE WITH THE OCCUMENTS AS ACCURATE AND AND COMPETED DIMENSIONED ARCHITECTURAL PLANS, OWNER UNDERSTANDS THAT ADJUSTMENTS TO THE FINAL LOCATIONS OF EQUIPMEN AND OF PURNTURE PLACEMENT MAY BE REQUIRED AT HE OWNERS DEPONSED UET TO DISCREPANCIES BASE

REFER TO ARCHITECTURAL OR ENGINEER DRAWING: FOR COMPLETE AND ACCURATE DIMENSIONS OF BUILDING STRUCTURE.

THESE CONTRACT DOCUMENTS AND THE INFORMATION THEY CONTAIN ARE THE PROPERTY OF FCC COMMERCIA FURNITURE INC., ROSEBURG, OREGON, 97470.

WAY, IN PART OR IN WHOLE, WITHOUT THE EXPRESS WRITTEN CONSENT OF FCC COMMERCIAL FURNITURE

IN PAYMENT DUE FOR SERVICES RENDERED BY FCC COMMERCIAL FURNITURE INC.

ANY DEVIATIONS FROM THESE DRAWINGS FOR ANY REASON SHALL NOT BE DONE WITHOUT CONSENT OF FOR COMMERCIAL FURNITURE IN: ON ADVANCE, IN WRITING, FOC COMMERCIAL FURNITURE IS NOT RESPONSIBLE FOR EVALVATIONS, CHANGES, ADDITIONS, OF DELETIONS NOT REVIEWED AND APPROVED IN ADVANCE BY FOC COMMERCIAL FURNITURE INC.

THESE DOCUMENTS REFLECT SPECIFIC SEATING AND DECOR EQUIPMENT ORDERED OF DATE SHOWN BELOW.

CLIENT:



Burger King 66745 Two Bunch Palms Trail Desert Hot Springs, CA 92240 Decor: Garden Grill Building Type: Custom

CUSTOMER
F & N Investments

SHEET TITLE:
DINING ROOM
FLOOR TILE PLAN
WORK ORDER NUMBER:

FINALS BY:

DRAWN BY:
AARON McCRAW
SCALE:

3/16" = 1'-0"

ORIGINAL DATE:

March 29, 2021

April 5, 2021

PROJECT #: **22114-001**

SHEET #:

D5.0

-GENERAL CONTRACTOR IS RESPONSIBLE FOR SUPPLYING AND INSTALLING ALL BACK OF HOUSE TILE. REFER TO ARCHITECTURAL PLAN SET FOR FULL KITCHEN PLANS.



(WOOD LOOK) TILED WALLS

GRAPHIC & METAL SIGN LOCATION

RESTROOM FULL HEIGHT

DIRECTIONAL SIGNAGE

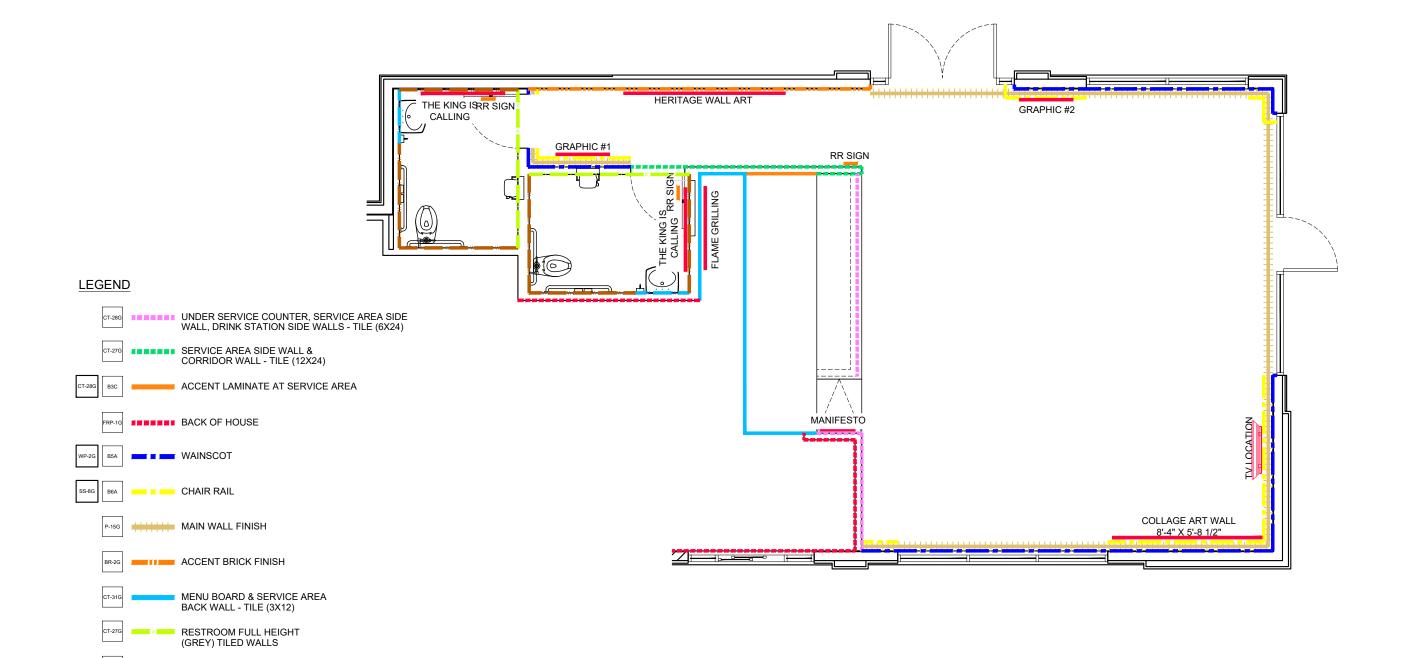



FCC COMMERCIAL FURNITURE INC. 8452 OLD HWY 99 N, ROSEBURG, OR 97470 USA T. 800.322.7328 | F. 541.673.7441 | WWW.FCCFURN. DESIGNED AND BUILT IN U.S.A.

PROPERTY OF FCC COMMERCIAL, FURNITURE
THIS IS A FOR DESIGN PURPOSE TO EXPRESS DESIGN
CONCEPTS TO THE ARCHITECT, CLIENT, CONTRACTOR
AND THE CONCEPTS HEREIN SHAULOWN. THIS DESI

IMPORTANT

WRITTEN DIMENSIONS HAVE PRECEDENCE OVER SC. IN ALL CASES.

DO NOT SCALE OFF PLANS. CONTACT FCC COMMERCIA FURNITURE'S REPRESENTATIVE TO VERIFY ANY QUESTIONABLE DIMENSIONS AT TELEPHONE # 800.322.7328

THE GENERAL CONTRACTOR MUST VERIFY ALL BUILDIN DIMENSIONS, EQUIPMENT, FURNITURE PLACEMENT, LITH ITY LOCATIONS, AND CONDITIONS AT THE JOR SITE

HE GENERAL CONTRACTOR MUST NOTIFY FCC OMMERCIAL FURNITURE OF ALL DISCREPANCIES ND/OR REQUIRED ADJUSTMENTS PRIOR TO STARTIN

FCC COMMERCIAL FURNITURE HAS PREPARED THESE DOCUMENTS AS ACCURATELY AS POSSIBLE WITH THE ACKHITECTURAL INFORMATION PROVIDED DUE TO LACO FACCURATE AND AND COMPLETE DIMENSIONED OF ACCURATE AND AND COMPLETE DIMENSIONED ADJ

REFER TO ARCHITECTURAL OR ENGINEER DRAWING FOR COMPLETE AND ACCURATE DIMENSIONS OF

THESE CONTRACT DOCUMENTS AND THE INFORMATIO
THEY CONTAIN ARE THE PROPERTY OF FCC COMMERCE
FURNITURE INC. PLOSERURG, OREGON, 97470

FURNITURE INC., ROSEBURG, OREGON, 97470.

ALL PREPARED CONTRACT DOCUMENTS MAY NOT BE

ANY UNAUTHORIZED USE OF THESE PLANS WILL RES IN PAYMENT DUE FOR SERVICES RENDERED BY FCC

ANY DEVIATIONS FROM THESE DRAWINGS FOR ANY FREADON SHALL NOT BE DONE WITHOUT CONSENT OF THE COMMERCIAL FURRITURE IN SOME SHALL NOT WITHOUT COMMERCIAL FURRITURE IS NOT RESPONSIBLE FO DEVIATIONS, CHANGES, ADDITIONS, OR DELETIONS NOT REVIEWED AND APPROVED IN ADVANCE BY FCC COMMERCIAL FURRITURE IN COMMERCIAL FURRITURE IN.

THESE DOCUMENTS REFLECT SPECIFIC SEATING AND DECOR EQUIPMENT ORDERED OF DATE SHOWN BELOW

CLIENT:



Burger King 66745 Two Bunch Palms Trail Desert Hot Springs, CA 92240 Decor: Garden Grill Building Type: Custom

CUSTOMER
F & N Investments

SHEET TITLE: INTERIOR WALL FINISHES

WORK ORDER NUMBER:

FINALS BY:

DRAWN BY:
AARON McCRAW
SCALE:

3/16" = 1'-0"

ORIGINAL DATE:

March 29, 2021

PLOT DATE:


April 5, 2021

PROJECT #:

22114-001

SHEET #:

D6.0

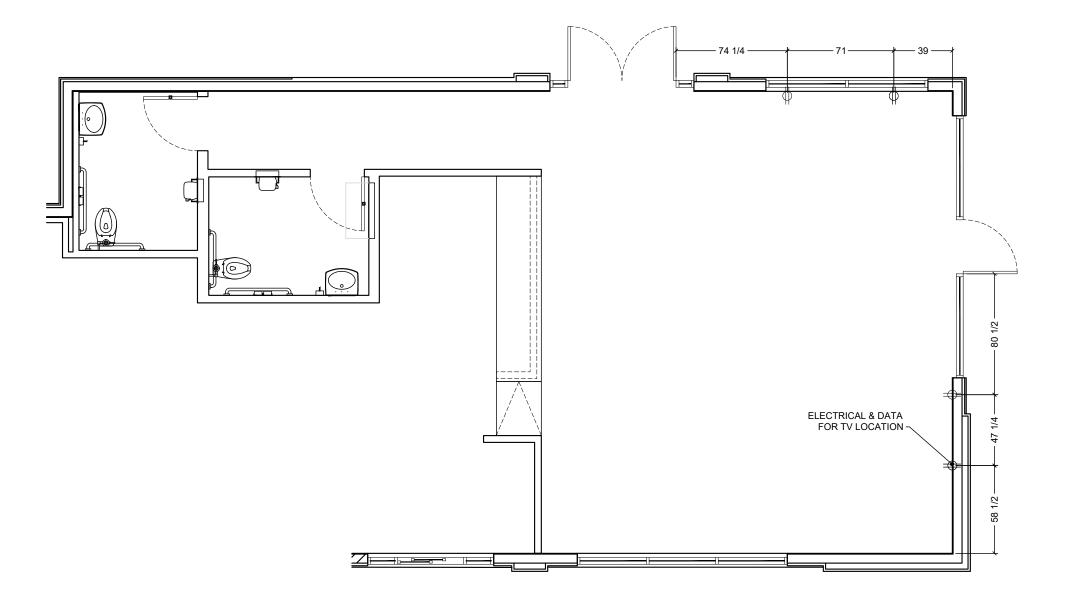

NOTE: ALL ELECTRICAL OUTLETS ARE SHOWN AS SUGGESTED LOCATIONS ONLY. VERIFY W/ARCHITECT PRIOR TO INSTALLATION.



FCC COMMERCIAL FURNITURE INC. 8452 OLD HWY 99 N, ROSEBURG, OR 97470 USA 800.322.7328 | F. 541.673.7441 | WWW.FCCFURN.CO DESIGNED AND BUILT IN U.S.A.

PROPERTY OF FCC COMMERCIAL FURNITURE
THIS IS A FOR DESIGN PURPOSE TO EXPRESS DESIGN
CONCEPTS TO THE ARCHITECT, CLIENT, CONTRACTOR
AND INSTALLER FOR THE PROJECT SHOWN. THIS DESI
AND THE CONCEPTS HEREN SHALL
STRUCTURE
OCCUMENTS ON DOYT REPRODUCE OR LEID WITHOUT
WRITTEN PERMISSION FROM FCC COMMERCIAL
FURNITURE INC.

IMPORTANT

WRITTEN DIMENSIONS HAVE PRECEDENCE OVER SCALE IN ALL CASES.

DO NOT SCALE OFF PLANS. CONTACT FCC COMMERCIAL FURNITURE'S REPRESENTATIVE TO VERIFY ANY QUESTIONABLE DIMENSIONS AT TELEPHONE # 800.322.7328

DIMENSIONS, EQUIPMENT, FURNITURE PLACEMENT UTILITY LOCATIONS, AND CONDITIONS AT THE JOB

THE GENERAL CONTRACTOR MUST NOTIFY FCC COMMERCIAL FURNITURE OF ALL DISCREPANCIES AND/OR REQUIRED ADJUSTMENTS PRIOR TO STAR WORK

REFER TO ARCHITECTURAL OR ENGINEER DRAWING FOR COMPLETE AND ACCURATE DIMENSIONS OF BUILDING STRUCTURE.

THESE CONTRACT DOCUMENTS AND THE INFORMATION THEY CONTAIN ARE THE PROPERTY OF FCC COMMERC FURNITURE INC., ROSEBURG, OREGON, 97470.

WAY, IN PART OR IN WHOLE, WITHOUT THE EXPRESS WRITTEN CONSENT OF FCC COMMERCIAL FURNITURE IN

IN PAYMENT DUE FOR SERVICES RENDERED BY FCC COMMERCIAL FURNITURE INC.

ANY DEVARIONS FROM THESE DRAWINGS FOR ANY REASON SHALL NOT BE DONE WITHOUT CONSENT OF FOR COMMERCIAL PRINTITURE IN, IN AUTHOUT CONSENT OF FCC COMMERCIAL FURNITURE IS NOT RESPONSIBLE FOR DEVARTONS, CHANGES, AUDITIONS, OR DELETIONS NOT REVARDED, CHANGES AUDITIONS, OR DELETIONS NOT REVARDED AND APPROVED IN ADVANCE BY FCC COMMERCIAL PURITURE IN.

THESE DOCUMENTS REFLECT SPECIFIC SEATING AND DECOR EQUIPMENT ORDERED OF DATE SHOWN BELOW.

CLIENT:



Burger King 66745 Two Bunch Palms Trail Desert Hot Springs, CA 92240 Decor: Garden Grill Building Type: Custom

CUSTOMER
F & N Investments

SHEET TITLE: G.C. PROVIDED ITEMS AND DETAILS

WORK ORDER NUMBER:

FINALS BY:

DRAWN BY:
AARON McCRAW
SCALE:

3/16" = 1'-0"

ORIGINAL DATE:

March 29, 2021

PLOT DATE:

April 5, 2021

PROJECT #:

22114-001

SHEET #: **D7.0**

Common Wayfinding Graphics

Required unless noted. Graphics may not always be applicable to all locations. Refer to décor plans for Image specific graphics.





Freshly Sliced Onions

Freshly sliced onions and tomatoes every day.













No Smoking

Restroom Wayfinding (selection varies based on store layout)
























Hours of Operation





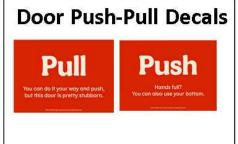

Exterior Billboard





The King is Calling Restroom Graphic



Crew Members Must Wash Hands



Exterior Drive-Thru Panels

(selection varies based on allowable space) (Not Applicable to Pavilion Bldg.)



Approved Graphic Suppliers:

LSI Graphics

Contact: Bob Lucas or Shawn Perry Email: Bk.Graphics@LSI-Industries.com Phone: (800) 436-7800

Moss Retail

2643 West Chicago Ave. Chicago, IL 60622

Contact: DJ Scandiff; (773) 435-7600 ext. 617 Contact: Rob Lorts; (773) 435-7600 Ext. 655

Order e-mail: BK@mossinc.com

VGS, Inc.

1696 Mabry Mill Dr., SW North Canton, OH 44709

Contact: Greg Moroz; (201) 528-9680 Order e-mail: burgerking@vgs-inc.com

APA Color Graphics 2929 Pacific Drive Norcross, GA 30071

Contact: Tony Tantillo; (404) 355-1355 Email: tony@apacolorgraphics.com



DESIGNED AND BUILT IN U.S.A

IMPORTANT

CLIENT:



Burger King 66745 Two Bunch Palms Trail Desert Hot Springs, CA 92240 Decor: Garden Grill Building Type: Custom

CUSTOMER F & N Investments

WAYFINDING SIGNAGE

WORK ORDER NUMBER:

FINALS BY:

DRAWN BY: AARON McCRAW

ORIGINAL DATE:

March 29, 2021 PLOT DATE:

April 5, 2021 PROJECT #:

22114-001

SHEET #: D7.1



Customer: F&N Investments Store: Burger King

Location: Desert Hot Springs, CA Project Number: 22114-001

Designer: ALM Sales: Virgle Orborne Date: April 2021 Décor: Garden Grill

Environn	nentally Friendly Finishes by FCC Standards	Additional Notes
G RENUARD	Greenguard Certified (Low VOC)	V 03.03.21
(8)	SCS Certified Recycled Content	
pvc _{free}	PVC Free Upholstery	
green	Crypton Green Upholstery	

Specifications are for REFERENCE ONLY and are current from the date of the last revision. See architecturals for updated information. Contact FCC immediately with any modifications to building finishes.

Edge Trim: Rehau, Match to Macchiato CP41002 MeB-2G Clipped	Notes Nevamar rain to run vertically
F1A Standard Height Height 1/2" Top Cap (No Drop): Solid Surface Corian, Deep Noctume (matte finish) Booths (wall incl.) Edge Trim: Rehau, Match to Macchiato CP41002 Style: Blaze Booth (40" H Wall) X X SS-8G Wood Gi MEB-2G X MEB-2G X MEB-2G	Nevamar
Height 1/2" Top Cap (No Drop): Solid Surface Perimeter Corian, Deep Noctume (matte finish) Booths (wall incl.) Wood Gi Edge Trim: Rehau, Match to Macchiato CP41002 Meb-2G Meb-2G Meb-2G Meb-2G Meb-2G)
Perimeter Booths (wall incl.) Rehau, Match to Macchiato CP41002 Corian, Deep Noctume (matte finish) SS-8G Wood Gr Well incl.) SS-8G Wood Gr MEB-2G Clipped)
Booths (wall incl.) Booth Wall: Laminate, Nevamar)
(wall incl.) N/WF0011T Macchiato (grain) Edge Trim: Rehau, Match to Macchiato CP41002 PL-15G Wood Grain) MEB-2G Clipped	rain to run vertically
Edge Trim: Rehau, Match to Macchiato CP41002 MEB-2G Clipped	all to full vertically
Macchiato CP41002	Down Hardware
30 M S	Down Hardware
Booth Seat: Vinyl, Maharam	
Lariat 440401, 010 Taupe	
17.5" Back Pad: Vinyl, Maharam	
Lariat 440401, 007 Oyster	
Bottom Trim: 3MM Black PVC	
Bottom Trim. Sixim Black PVC Booth Base: 1/8" Black ABS	
Crumb Trough Trim: Laminate,	
Pionite, Black SE101	
	N
Height Booth Seat: Vinyl, Maharam	Nevamar
Settees Lariat 440401, 010 Taupe	
(no wall) 15" Back Pad: Vinyl, Maharam	
Lariat 440401, 007 Oyster	
	rain to run vertically
	Down Hardware
PL-19G	
Bottom Trim: 3MM Black PVC	
Booth Base: 1/8" Black ABS	
Legs: Powdercoat, Blackened Steel	
MF-1G	
	seams to be placed
	walls where possible
	n floor plan denote
Edge: Rehau 592E Multiplex 1-5/16" MEB-1G table gra	
F2B Table Tops Style: T0027 R (1/8"R) 3 Equal Stripes X X	Pionite/Wilsonart
(center) 1 5/16" Thick Top:	,
	B is only applicable on
(3)	the center of the store
Middle Stripe: Laminate, Nevamar	
N/WF0011T Macchiato (grain)	
Right Stripe: Laminate, Nevamar	
WF0013T Carmel Macchiato Suede (grain)	
Edge: Rehau 592E Multiplex 1-5/16" MEB-1G	
F2C Coffee Not Applicable	
Tables	
(at lounge)	

		Eurniture Items	Sun	nlior	Inct	aller	BK	
Itom	Description	Furniture Items Finish	FCC	plier Others			Codes	Notes
F3A	Community	Not Applicable	FUL	Others	FUL	Outers	Coues	Notes
F3A	Table							
F4A	Bar Height Seats	Not Applicable						
F5A	Standard Height Seats (center)	Style: Isabel Chair Model: 8018-CMC Chair Back & Seat: Laminate, Match PL-17G Caramel Macchiato Frame Finish: Powdercoat, Blackened Steel Glides: Black	Х			Х		Contact: 323.319.2722 Rep: Barry Woon Supplier: Twenty Four 7
F5B	Standard Height Seats (settee seats)	Style: Bronze Gale Standard Chair Model: 80-014-211-9 Chair Back & Seat: Laser Cut Steel with Bronze Powdercoat Glides: Rubber	х			х		Contact: 323.319.2722 Rep: Barry Woon Supplier: Twenty Four 7
F5C	Standard Height Lounge Chairs	Not Applicable						
F6A	High Chairs	Manufacturer: Rubbermaid Style: Sturdy Chair FG-7805, Green Material: Molded Plastic, ASTM F404-04		Х		Х		
F7A	Metal Work	Color: Blackened Steel (Square Steel)	Х			Х	MF-1G	* Tile grout by GC after steel is installed (typ.)
F8A	Walls	Not Applicable						
F9A	Décor Screens (Option A, B)	Not Applicable						
F10A	Low Décor Screen	Not Applicable						



DESIGNED AND BUILT IN U.S.A.

IMPORTANT

DO NOT SCALE OFF PLANS. CONTACT FCC COMMERCIAL FURNITURE'S REPRESENTATIVE TO VERIFY ANY QUESTIONABLE DIMENSIONS AT TELEPHONE # 800.322.7328

THE GENERAL CONTRACTOR MUST VERIFY ALL BUILDING DIMENSIONS, EQUIPMENT, FURNITURE PLACEMENT, UTILITY LOCATIONS, AND CONDITIONS AT THE JOB SITE.

ALL PREPARED CONTRACT DOCUMENTS MAY NOT BE COPIED, REPRODUCED, USED OR IMPLEMENTED IN ANY WAY, IN PART OR IN WHOLE, WITHOUT THE EXPRESS WRITTEN CONSENT OF FCC COMMERCIAL FURNITURE INC

ANY UNAUTHORIZED USE OF THESE PLANS WILL RESULT IN PAYMENT DUE FOR SERVICES RENDERED BY FCC COMMERCIAL FURNITURE INC. ANY DEVIATIONS FROM THESE DRAWINGS FOR AN

CLIENT:



66745 Two Bunch Palms Trail Desert Hot Springs, CA 92240 Decor: Garden Grill Building Type: Custom

CUSTOMER

Burger King

F & N Investments

SHEET TITLE: SPECIFICATIONS

WORK ORDER NUMBER:

FINALS BY:

DRAWN BY: AARON McCRAW SCALE:

NTS

ORIGINAL DATE:

March 29, 2021 PLOT DATE:

April 5, 2021

PROJECT #: 22114-001

SHEET #:

D8.0

		Furniture Items	Sup	plier	Inst	aller	BK	
Item	Description	Finish	FCC	Others		Others	Codes	Notes
F11A	Cabinets (Condiment and Trash)	Style: Cube (33/44gal) Top w/Tray Bumpers: Solid Surface, Corian, Deep Noctume (matte finish) Sides: Laminate, Nevamar WK0017T Venerable Old Oak (grain) Edge: Charter Black Access Door: Laminate, Nevamar WK0017T Venerable Old Oak (grain) Door Edge Pull: Stainless Steel Base Style: Open With Casters - Roll Out Liners Base Color: UFB-551-S2 Matte Black	х			х	SS-8G PL-9G	Interior Trash Cabinet Laminate to Match Exterior Wood Grain to run vertically Corian/Nevamar
F11B		Not Applicable						
	and Condiments							
F11C		Not Applicable						
E445	Free-Style	M . A . II . I .						
F11D	Optional Sauce Bar	Not Applicable						
F12A	Service Counter	Style: Square Face (Eased Edge) Material: Manufactured Silestone, Quartz Volcano Texture Color: Grey Expo Front Drop: 3"		х		Х	or SS-9G	Silestone Contact: 305.398.5700 Rep: Jennifer Ryan, Cosentino Additional supplier available
		Back Edge: 2" Note: Min. 14'-0" L to fit menuboards	X (optional)			Х		Optional Top Finish: Solid Surface Avonite, BK Smoke #7885 Edge: 3" Square Drop Avonite Contact: 423.290.4805 Rep: Bob Dahl, Aristech Surfaces Additional supplier available
F13A	Queue Line	Not Applicable						
F14A	Smoothie Surround	Not Applicable						
F15A	POS Shroud (optional)	Not Applicable						

			Miscellaneous Decor Items	Supp	lier	Instal	ler	BK	
	Item	Description	Finish		Others		Others		Notes
	D1A	ADA RR Signs	Item: ADA/Braille Sign Mounted on Wall Next to Restroom Door	Х			X		
	D1B	Directional Signage (required)	Wayfinding Sign "Restrooms", RR Door Signs-Circle of Man/Woman Restroom - "Crew Members Must Wash" Tray Return (as applicable)	Х			х		Supplier: Refer to Drawings Contact: Refer to Drawings
	D1C	Entry Signage (required)	Door Decal "Hours of Operation" Door Decal "Push/Pull"	Х			X		Supplier: Refer to Drawings Contact: Refer to Drawings
	D1D	Wi-Fi Decal (required)	<i>Item</i> : "Free Wi-Fi" vinyl decal <i>Size</i> : Varies Per Store	Х			Х		Supplier: Refer to Drawings Contact: Refer to Drawings
	D1E	King is Calling RR Decal (required)	Item: "The king is calling and I must go" Size: 55"W x 24"H	Х			х		Supplier: Refer to Drawings Contact: Refer to Drawings
	D2A	Heritage Wall Art (optional)	Style: Framed and Matted BK Heritage Images Color: Black & White	Х			Х		Supplier: Refer to Drawings Contact: Refer to Drawings Total Quantity: 10
	D2B	Wall Art Collage (Option A)	Style: Natural Element Wall Art Collage Materials: Concrete, Grey Wood, Brown Wood, Copper, Green Bamboo IPE w/Logo, Brick, Orange Laminate		Х		Х		Supplier: Nautical Fumishings Contact: 954.771.1100 Rep: Michael Hoglund Size: 8'-4" x 5'-8 1/2"
	D2C	Manifesto Graphic (required)	Frame/Dividers: Black Style: Manifesto Opt. 1 1/8" Aluminum Composite Panel Standoffs: 1/2" Silver	Х			Х		Supplier: Refer to Drawings Contact: Refer to Drawings
	D3A	Drink Station Wall Decals (Optional)	Size: 26"W x 30"H Not Applicable						
L	D4A	Flat Screen	By Owner		Х		Х		
	D5A	Wall Shelves	Not Applicable						
1	D5B	Graphic Panels (required)	Style: Black Metal Framed Print Size: 36"W x 48"H Refer to Drawings for Image Selection	X s			х		Supplier: Refer to Drawings Contact: Refer to Drawings
	D5C	SheIf Artwork (required*)	Not Applicable						
	D5D	Shelf Artwork (required*)	Not Applicable						
1	D7A	Ordering Kiosk (Opt.)	Not Applicable						
	D8A	Metal Signage	Restroom Signage (optional) Flame Grilling Since 1954 (required) (Mount at 70"H AFF on center)		Х		X		Supplier: Nautical Furnishings Contact: Michael Hoglund; 954.771.1100



8452 OLD HWY 99 N, ROSEBURG, OR 97470 USA
T. 800.322.7328 | F. 541.673.7441 | WWW.FCCFURN.CO
DESIGNED AND BUILT IN U.S.A.

ROPERTY OF FCC COMMERCIAL FURNITURE
HIS IS A FOR DESIGN PURPOSE TO EXPRESS DE
CONCEPTS TO THE ARCHITECT, CLIENT, CONTRAIND INSTALLER FOR THE PROJECT SHOWN. THIS

CONCEPTS TO THE ARCHITECT, CLIENT, CONTRACTOR AND INSTALLER FOR THE PROJECT SHOWN. THIS DESIGNAND THE CONCEPTS HEREIN SHALL NOT BE ALTERED OR USED AS CONSTRUCTION DOCUMENTS. DO NOT REPRODUCE OR LEND WITHOUT WRITTEN PERMISSION FROM FCC COMMERCIAL FURNITURE IN COMMERCIAL FURNITURE IN COMMERCIAL

IMPORTANT

ITTEN DIMENSIONS HAVE PRECEDENCE OVER SCA

DO NOT SCALE OFF PLANS, CONTACT FCC COMMERCIAL FURNITURE'S REPRESENTATIVE TO VERIFY ANY QUESTIONABLE DIMENSIONS AT TELEPHONE # 800.322.7328

THE GENERAL CONTRACTOR MUST VERIFY ALL BUILDING DIMENSIONS, EQUIPMENT, FURNITURE PLACEMENT, UTILITY LOCATIONS, AND CONDITIONS AT THE JOB SITE.

THE GENERAL CONTRACTOR MUST NOTIFY FCC COMMERCIAL FURNITURE OF ALL DISCREPANCIES AND/OR REQUIRED ADJUSTMENTS PRIOR TO STARTIN

FCC COMMERCIAL FURNITURE HAS PREPARED THESE DOCUMENTS AS ACCURATELY AS POSSIBLE WITH THE ACHITECTURAL INFORMATION PROVIDED. DUE TO LACK OF ACCURATE AND AND COMPLETE DIMENSIONED ARCHITECTURAL PLANS, COWER TO MEDERSTANDS THAT ADJUSTMENTS TO THE PALL COLCITIONE EQUIPMENT AT THE PALL COLCITIONE EQUIPMENT AT THE PALL COLCITION FOR THE PANCES ASSET THE COWNERS FOR EXPENSE DUE TO DISCREPANCIES RASED

REFER TO ARCHITECTURAL OR ENGINEER DRAWINGS FOR COMPLETE AND ACCURATE DIMENSIONS OF BUILDING STRUCTURE.

THESE CONTRACT DOCUMENTS AND THE INFORMATION THEY CONTAIN ARE THE PROPERTY OF FCC COMMERCIAL FURNITURE INC., ROSEBURG, OREGON, 97470.

ALL PREPARED CONTRACT DOCUMENTS MAY NOT BE COPIED, REPRODUCED, USED OR IMPLEMENTED IN ANY WAY, IN PART OR IN WHOLE, WITHOUT THE EXPRESS WRITTEN CONSENT OF FCC COMMERCIAL FURNITURE INC

ANY UNAUTHORIZED USE OF THESE PLANS WILL RESULT IN PAYMENT DUE FOR SERVICES RENDERED BY FCC COMMERCIAL FURNITURE INC.

ANY DEVIATIONS FROM THESE DRAWINGS FOR ANY

ANY DEVIATIONS FROM THESE DRAWINGS FOR ANY REASON SHALL NOT SEE DONE WITHOUT CONSENT OF FOCOMMERCIAL PRIMITURE IS, IN ADVANCE, IN WRITING, FCC COMMERCIAL FURNITURE IS NOT RESPONSIBLE FOR EVIATIONS, CHANGES, ADDITIONS, OR DELETIONS NOT REVIEWED AND APPROVED IN ADVANCE BY FCC COMMERCIAL PRIMITURE IN.

HESE DOCUMENTS REFLECT SPECIFIC SEATING AND ECOR EQUIPMENT ORDERED OF DATE SHOWN BELOW

CLIENT:



Burger King 66745 Two Bunch Palms Trail Desert Hot Springs, CA 92240 Decor: Garden Grill Building Type: Custom

CUSTOMER

F & N Investments

SHEET TITLE: SPECIFICATIONS

WORK ORDER NUMBER:

FINALS BY:

DRAWN BY: AARON McCRAW SCALE:

NTS

ORIGINAL DATE:

March 29, 2021

PLOT DATE:
April 5, 2021

PROJECT #: **22114-001**

SHEET #: **D8.1**

		Miscellaneous Decor Items	Supp		Instal	ler	BK	
ltem	Description	Finish	FCC	Others	FCC	Others	Codes	Notes
D8B	Metal	Not Applicable						
	Home of the							
	Whopper							
	LED Sign							
D8C	Order	Item: Acrylic Sign with White Metal		Х		Х		Supplier: Nautical Furnishings or
	Here	Lettering						APA, refer to drawings for contact
	& Pick Up	Mounting: Chain						
	Here	Sign 1: Order Here, 18"W x 10"H						
	(optional)	Sign 2: Pick Up Here, 21"W x 10"H						
D8D	Mobile	Item: Acrylic Sign with Neon Lettering		X		X		Supplier: Nautical Furnishings or
	Order							APA, refer to drawings for contact
	Pick Up	Size: 60"W x 20"H						
	Here							
	(optional)							
D9A	Have It Your	Not Applicable						
	Way LED							
	Sign							
	(optional)							
D9B		Not Applicable						
	Grilling							
	Crown Sign							
	(optional)							
D10A	Exterior	Item: 40"W x 54"H Framed Posters	X			Х		Qty: 1, 2 or 3 (as space allows)
	Drive-Thru	Refer to Architecturals for						
	Image Panels	Installation Information						Supplier: Refer to Drawings
	(required)							Contact: Refer to Drawings
								Not Applicable to Pavilion Bldg
D10B	Exterior	Item:120"W x 60"H Vinyl,	X			X		Qty: 1
	Whopper	(size may vary per site)						Supplier: Refer to Drawings
	Billboard	Refer to Architecturals for						Contact: Refer to Drawings
	(Optional)	Installation Information						Not Applicable to Pavilion Bldg

		Ceiling Elements		plier	Installer		BK	
Item	Description	Finish	FCC	Others	FCC	Others	Codes	Notes
B1A	Suspended	Finish: Omnova, 3D Laminate	Х			X		Can lights to be installed by GC
	3D Lam	Almond Cherry 508837						in soffit - See RCP for Details
	Trellis	Size: 6"W x 6"H						
		Shroud/Hardware: Powdercoat, Tiger						
		BLM 38/60400, Sudan Brown						
B2A	Slat	Not Applicable						
	Laminate							
	Soffit							
10000	NAL FINISHES							
B5A	Wainscot	Supplier/Item: Marlite, Allure Panel	Х			X		Install: Wood grain runs vertically
	(Lower Wall	Color: Nevamar, WF001-T Macchiato	(optional)					
	Surface)						WP-2G	Panel Qty (4' x 4'): 17 panels
		Panel Size: 4' x 4'						Divider Trim AP-30N (9'): 6 sticks
		Trim: Match to Marlite Macchiato						Edge Trim AP-28N (9'): 11 sticks
								I/C AP-32N (9'): 2 sticks
								O/C AP-34N (9'): 2 sticks
		Adhesive: By Others		X		Х		
B6A	Chair	Style: FDBC084	Х			Х		Qty. (12'): 4 sticks or 48 LF
	Rail	Material: Solid Surface, Corian,	(optional)			90.00	SS-8G	
		Deep Noctume	, , , , , ,					
		Size: 1" x 2"						
B10A	Window	Material: Solid Surface	Х			Х		Qty. (12'): 3 sticks or 36 LF
	Sills	Corian, Deep Noctume	(optional)				SS-8G	
		Thickness: 1/2"	,					



8452 OLD HWY 99 N, ROSEBURG, OR 97470 USA T. 800.322.7328 | F. 541.673.7441 | WWW.FCCFURN.COI

DESIGNED AND BUILT IN U.S

PROPERTY OF CO COMMERCIAL FURNITURE
THIS IS A FOR DESIGN PURPOSE TO EXPRESS DESIGN
ONCEPTS TO THE ARCHITECT, LUENT, CONTRACTOR
AND INSTALLER FOR THE PROJECT SHOWN. THIS DESIGN
AND THE CONCEPTS HEREIN SHOULD
NOT BE ALTERED OR USED AS CONSTRUCTION
OUTLINESS ON ON TREPRODUCE OR LEND WITHOUT
WRITTEN PERMISSION FROM FCC COMMERCIAL
FUNNITURE AND

IMPORTANT

ITTEN DIMENSIONS HAVE PRECEDENCE OVER SCA

DO NOT SCALE OFF PLANS. CONTACT FCC COMMERCIAL FURNITURE'S REPRESENTATIVE TO VERIFY ANY QUESTIONABLE DIMENSIONS AT TELEPHONE # 800.322.7328

THE GENERAL CONTRACTOR MUST VERIFY ALL BUILDING DIMENSIONS, EQUIPMENT, FURNITURE PLACEMENT, UTILITY LOCATIONS, AND CONDITIONS AT THE JOB SITE.

THE GENERAL CONTRACTOR MUST NOTIFY FCC COMMERCIAL FURNITURE OF ALL DISCREPANCIES AND/OR REQUIRED ADJUSTMENTS PRIOR TO STARTIN

CC COMMERCIAL FURNITURE HAS PREPARED THESE DOCUMENTS AS ACCURATELY AS POSSIBLE WITH THE ARCHITECTURAL INFORMATION PROVIDED DUE TO LACI DEFACCURATE AND AND COMPLETE DIMENSIONED RECHITECTURAL PLANS, OWNER UNDERSTANDS THAT ADJUSTMENTS TO THE FINAL LOCATIONS OF EQUIPMENT MINIOR FURNITURE PLACEMENT MAY BE REQUIRED AT

REFER TO ARCHITECTURAL OR ENGINEER DRAWINGS FOR COMPLETE AND ACCURATE DIMENSIONS OF BUILDING STRUCTURE

THESE CONTRACT DOCUMENTS AND THE INFORMATION THEY CONTAIN ARE THE PROPERTY OF FCC COMMERCIAL FURNITURE INC., ROSEBURG, OREGON, 97470.

ALL PREPARED CONTRACT DOCUMENTS MAY NOT BE COPIED, REPRODUCED, USED OR IMPLEMENTED IN ANY WAY, IN PART OR IN WHOLE, WITHOUT THE EXPRESS WRITTEN CONSENT OF FCC COMMERCIAL FURNITURE INC.

ANY UNAUTHORIZED USE OF THESE PLANS WILL RESULT IN PAYMENT DUE FOR SERVICES RENDERED BY FCC COMMERCIAL FURNITURE INC.

ANY DEVIATIONS FROM THESE DRAWINGS FOR ANY REASON SHALL NOT SE DONE WITHOUT CONSENT OF FOR COMMERCIAL PRIMITURE IS, NO ADVANCE, IN WRITING. FCC COMMERCIAL FURNITURE IS NOT RESPONSIBLE FOR DEVIATIONS, CHANGES, ADDITIONS, OR DELETIONS NOT RESPONSIBLE FOR COMMERCIAL FURNITURE IS ADVANCE BY FCC COMMERCIAL FURNITURE IN ADVANCE BY FCC COMMERCIAL FURNITURE IN C.

THESE DOCUMENTS REFLECT SPECIFIC SEATING AND DECOR EQUIPMENT ORDERED OF DATE SHOWN BELOW.

CLIENT:



Burger King 66745 Two Bunch Palms Trail Desert Hot Springs, CA 92240 Decor: Garden Grill Building Type: Custom

CUSTOMER

F & N Investments

SHEET TITLE: SPECIFICATIONS

WORK ORDER NUMBER:

FINALS BY:

DRAWN BY:
AARON McCRAW
SCALE:

NTS

ORIGINAL DATE:

March 29, 2021

April 5, 2021
PROJECT #:

22114-001

SHEET #: **D8.2**

	Restroom	Interior Finishes	Sup	plier	Inst	aller	BK	
Item	Description	Finish	FCC	Others		Others	Codes	Notes
R1A	Restroom Sink	Style: Custom Trough Corian Sink Finish: Solid Surface, Corian, Summit White Size: 18"D x 22"W x 5"H		х		Х		HJC Corp: barry.bryant@hjcinc.com OR Restroom Remodels Co.: keith@restroomremodels.com
R1B	Faucet	Manufacturer: Grohe Model: Eurosmart Cosmopolitan Finish: Chrome		Х		Х		
R2A	Stall Doors and Frames	Finish: Laminate, Nevamar WK0017T Venerable Old Oak (grain) Frames: Clear Anodized Aluminum Finish: Paint, PPG Primer: 90-712 Pitt Tech Paint: 6-1510XI, Speedhide Int/Ext WB Alkyd Semi Gloss Color: Ashen		X		X		Install: Wood Grain Runs Vertically Nevamar Contact: 877.726.6526 Rep: John Trulock PPG Contact: 616.335.3259 Rep: Kevin Lastacy, klastacy@ppg.com Additional supplier(s) available per BKC Finish Schedule
R3A	Soap Dispenser	Style: Dispenser 6562, Surface Mounted, Tank-type Horizontal Valve Finish: Stainless Steel		Х		Х		HJC Corp: barry.bryant@hjcinc.com OR Restroom Remodels Co.: keith@restroomremodels.com
R3B	Hand Dryer	World Dryer: Q-974A or, Excel Dryer: XL-BW BMC or, ASI: 10-0135-1		Х		Х		
R4A	Urinal	Or Approved Hand Dryer Option Style: Toto UT104E, TopSpud Inlet, Color: #01 Cotton		Х		Х		
R4B	Toilet	Style: American Standard, Madera, 16-1/2"H, 1.6gpf, Flushometer sytem with everclean		Х		Х		
R5A	Wall Mirrors	Style: BOBRICK B-165 2436 Channel Frame Mirror		Х		Х		
R5B	Sanitary Disposal	Style: BOBRICK B-353		Х		Х		
R5C	Seat Cover Dispenser	Style: BOBRICK B-3013 Recessed Seat Cover Dispenser Finish: Stainless Steel		х		Х		
R5D	Waste	Style: BOBRICK B-3644 Recessed Waste Receptacle		Х		X		
R5E	Toilet Paper	Style: BOBRICK B-6997 Recessed Multi-Roll		Х		Х		
R5F	Coat	Style: BOBRICK B-6717 Surface Mounted Single Robe Hook, Stainless		Х		X		
R5G		Style: BOBRICK B-35903 Recessed Mounted Towel Dispenser		х		Х		
R5H	Baby Changing Table	Style: Koala Kare KB110-SSRE Finish: Stainless Steel Optional Style: Koala Kare KB200-05 Finish: Polypropylene Optional Style: Custom Corian Finish: Corian, Summit White		Х		х		



DESIGNED AND BUILT IN U.S.A.

PROPERTY OF ECCOMMERCIAL FIRSTLINE
THIS IS A FOR DESIGN BURFOSE TO EXPRESS DESIGN
THIS IS A FOR DESIGN BURFOSE TO EXPRESS DESIGN
ONCEPTS TO THE ABOUTETC. LIEBRIT CONTRACTOR
AND INSTALLER FOR THE PROJECT SHOWN. THIS DESIGN
AND THE CONCEPTS HERBEN SHATUL
NOT BE ALTERED OR USED AS CONSTRUCTION
DOCUMENTS. DO NOT REPRODUCE OR LEND WITHOUT
WRITTEN PERMISSION FROM FCC COMMERCIAL
FURNITURE M.C.

IMPORTANT

DO NOT SCALE OFF PLANS. CONTACT FCC COMMERCIAL FURNITURE'S REPRESENTATIVE TO VERIFY ANY QUESTIONABLE DIMENSIONS AT TELEPHONE # 800.322.7328

THE GENERAL CONTRACTOR MUST VERIFY ALL BUILDING DIMENSIONS, EQUIPMENT, FURNITURE PLACEMENT, UTILITY LOCATIONS, AND CONDITIONS AT THE JOB SITE.

ALL PREPARED CONTRACT DOCUMENTS MAY NOT BE COPIED, REPRODUCED, USED OR IMPLEMENTED IN ANY WAY, IN PART OR IN WHOLE, WITHOUT THE EXPRESS WRITTEN CONSENT OF FCC COMMERCIAL FURNITURE INC

ANY UNAUTHORIZED USE OF THESE PLANS WILL RESULT IN PAYMENT DUE FOR SERVICES RENDERED BY FCC COMMERCIAL FURNITURE INC.

ANY DEVIATIONS FROM THESE DRAWINGS FOR ANY REASON SHALL NOT BE DONE WITHOUT CONSENT OF FOC COMMERCIAL PRINTINGE IN, IN ADVANCE, IN WRITING, FCC COMMERCIAL FURNITURE IS NOT RESPONSIBLE FOR DEVIATIONS, CHANGES, ADDITIONS, OR DELETIONS NOT RESPONSIBLE FOR COMMERCIAL FURNITURE IN ADVANCE BY FCC COMMERCIAL FURNITURE IN C.

CLIENT:



Burger King 66745 Two Bunch Palms Trail Desert Hot Springs, CA 92240 Decor: Garden Grill Building Type: Custom

CUSTOMER

F & N Investments

SHEET TITLE: SPECIFICATIONS

WORK ORDER NUMBER:

FINALS BY:

DRAWN BY: AARON McCRAW SCALE:

NTS

ORIGINAL DATE:

March 29, 2021 PLOT DATE:

April 5, 2021 PROJECT #:

22114-001

SHEET #:

D8.3

				RILL INTERIOR FINIS			
02.08.21		INTERIOR MATERIA	S & FINISH SCHEE	DULE **TO BE USED WITH 20/20	GARDEN GRILL GUIDELINES DOC.		
CODE ACUSTICAL CEILING	MATERIAL	LOCATION	SOURCE	PRODUCT	COLOR	DIMENSION	ADDITIONAL INFORMATION
ACT-1G	ACOUSTICAL CEILING TILE	DINING	ARMSTRONG	CORTEGA PN91311 #770	PANEL COLOR: SEPIA EDGE: FLAT IN-LAY 15/16 GRID: PRELUDE 15/16" EXPOSED TEE GRID COLOR: SEPIA	2' x 2' x 5/8"	CONTACT: CHERYL SMITH 252-214-4426 CBSMITH@ARMSTRONGCEILINGS.COM ARMSTRONG STRATEGIC ACCOUNTS: (800) 442-4212
ACT-2G	ACOUSTICAL CEILING TILE	BACK OF HOUSE	ANNOTION	#BP672 KITCHEN ZONE	PANEL COLOR: WHITE GRID: PRELUDE 15/16" EXPOSED TEE GRID GRID COLOR: WHITE	2' x 4' x 1/2"	ÁRMSTRONGCSA@ARMSTRONGCEILINGS .COM
ACT-2G	ACOUSTICAL CEILING TILE	BACK OF HOUSE	USG INTERIORS	SHEETROCK BRAND LAY-IN CEILING PANEL CLIMAPLUS #3270	PANEL COLOR WHITE GRID: Donn DX/DXL GRID COLOR WHITE	2' x 4' x 1/2"	CONTACT: JOHN FUNES (312) 436-5841 JFUNES@USG.COM NOTE: USE PROGRAM QUOTE # 00103139 TO
ACT-3G	ACOUSTICAL CEILING TILE	PLAYGROUND		FINE FISSURED #1732	WHITE GRID: 2 x2 ANGLED TEGULAR 15/16 GRID COLOR WHITE	2' x 2' x 3/4"	CONTACT: CHERYL SMITH 252-214-4426 CBSMITH@ARM STRONGCEILINGS.COM ARMSTRONG STRATEGIC ACCOUNTS:
ACT-3G UPGRADE	DE ACOUSTICAL CEILING TILE PLAYGROUND		ARMSTRONG	FINE FISSURED #1732	ADOBE GRID: 2 x2 ANGLED TEGULAR 15/16 GRID COLOR: ADOBE	2' x 2' x 3/4"	(800) 442-4212 ARMSTRONGCSA@ARMSTRONGCEILINGS .COM
ACT-3G	ACOUSTICAL CEILING TILE	PLAYGROUND		WHITE RADAR CLIMA PLUS #2210	PANEL COLOR: WHITE GRID: Donn DX/DXL GRID COLOR WHITE	2' x 2' x 3/4"	CONTACT: JOHN FUNES (312) 436-5841 JFUNES@USG.COM
ACT-3G UPGRADE	ACOUSTICAL CEILING TILE	PLAYGROUND	USG INTERIORS	TAUPE RADAR CLIMA PLUS#2210	PANEL COLOR: TAUPE GRID: Donn DX/DXL GRID COLOR: TAUPE	2' x 2' x 3/4"	NOTE: USE PROGRAM QUOTE # 00103139 TO RECEIVE BK PRICING
LES			GRANITE FIANDRE/ EUROWEST	TCG2424027SQ	SIMPLY GRAY HONED (RECTIFIED)	24" x 24"	CONTACT: JAN DETER (714) 309-9551 JDETER@EUROWEST.COM BK@EUROWEST.COM NOTE: USE WITH GR-15G (1/16" THICK)
			TCL TRANSCERAMIC A, LTD	X600292X8	URBANGRAY HONED (RECTIFIED)	24" x 24"	CONTACT: CHRISTINA MASTRANGELO CMASTRANGELO@TRANSCERAMICA.CO M JOY KLEIN(813)334-3302 NOTE: USE WITH GR-15G (1/16" THICK)
CT-25G	CERAMIC TILE	FIELD FLOOR TILE / BEVERAGE WALL	EMSER	199UPTOGR2424	UPTOWN CUSTOM GRAY#15 (RECTIFIED)	24" x 24"	CONTACT: CRISTINA DUNBAR (713)462-2411 BURGERKING@EMSER COM NOTE: USE WITH GR-15G (1/16" THICK)
			DALTILE	N627BK24241PK	N627 ROYAL GREY	24"×24"	SUPPORT CENTER NATIONAL ACCOUNTS@DALTILE.COM (877) 556-5728
	CERAMIC TILE	BASE TILE (MAINDINING)	GRANITE FIANDRE/ EUROWEST	TCG1224027SQ	SIMPLY GRAY HONED (RECTIFIED)	6" x 24" (CUT TILE)	NOTE: U SE WITH GR-15G (1/16" THICK) CONTACT: JAN DETER (7/14) 309-9551 JDETER@EUROWEST.COM BK@EUROWEST.COM
			TCL TRANSCERAMIC A, LTD	X630292X8	URBANGRAY HONED (RECTIFIED)	6" x 24" (CUT TILE)	NOTE: USE WITH GR-15G (1/16" THICK) CONTACT: CHRISTINA MASTRANGELO CMASTRANGELO@TRANSCERAMICA.CO M JOY KLEIN(813)334-3302 JKLEIN@TRANSCERAMICA.COM
CT-26G			EMSER	CUT BASE TILE (FROM 12" X 24")	UPTOWN CUSTOM GRAY#15 (RECTIFIED)	6" x 24" (CUT TILE)	NOTE: 1 USE MUTHLOR ASSEMBLY THICKS. CONTACT: ORISTINA DUNBAR (713) 452- 2411 BURGERINNG@EMSER.COM NOTE: 4 WEEKS LEAD TIME CUT BASE TILE F PURCHASE DIRECTLY FROM EMSER NOTE: USE WITH GR-15G (1/16" THICK)
			DAL-TILE	CUT BASE TILE N627BK12241PK	N627 ROYAL GREY	6" x 24" (CUT TILE)	SUPPORT CENTER NATIONAL ACCOUNTS@DALTILE.COM (877) 556-5728 NOTE: U SE WITH GR-15G (1/16" THICKNE
			GRANITE FIANDRE/ EUROWEST	TCG1224027SQ	SIMPLY GRAY HONED (RECTIFIED)	12" x 24"	CONTACT: JAN DETER (714) 309-9551 JDETER@EUROWEST.COM BK@EUROWEST.COM NOTE: U SE WITH GR-15G (1/16" THICK)
or or o	OFFILMO TO	CORRIDOR WALL/	TCL TRANSCERAMIC A, LTD	X630292X8	URBAN GRAY HONED (RECTIFIED)	12" x 24"	CONTACT: CHRISTINA MASTRANGELO JOY KLEIN (813)334-3302 JKLEIN@TRANSCERAMICA.COM NOTE: U SE WITH GR-15G (1/16" THICK)
CT-27G	CERAMIC TILE	RESTROOM WALL AND FLOOR	EMSER	199UPTOG12424	UPTOWN CUSTOM GRAY#15 (RECTIFIED)	12" x 24"	CONTACT: CRISTINA DUNBAR (713)462- BURGERKING@EMSER.COM NOTE: U SE WITH GR-15G (1/16" THICK)
			DALTILE	N627BK12241PK	N627 ROYAL GREY (RECTIFIED)	12"X 24"	SUPPORT CENTER NATIONALACCOUNTS@DALTILE.COM (877) 566-5728 NOTE: U SE WITH GR-15G (1/16" THICKNE SS)
			GRANITE FIANDRE/ EUROWEST	Larch US (french wood) IRG 0624123	WOOD TILE (RECTIFIED)	6" x 24"	CONTACT: AND DETER (714) 309-9551 JUDETERGELPROVEST.COM BK@EUROWEST.COM NOTE: U SE WITH GR-15G @ FLOOR (1/16" THICK) DINING WALLS ONLY (1/16" THICK)
CT-28G	CERAMICTILE	DINING / ACCENT TILE LIGHT WOOD/KNEE WALL AND FSC SIDE WALL WAINSCOT TILE (STACKED BOND)	TCL TRANSCERAMIC A, LTD	TCL Larch US (french wood) IRG0624123	WOOD TILE (RECTIFIED)	6" x 24"	CONTACT: CHRISTINA INASTRANCELO LOMASTRANGELO @TRANSCERAMICA CO JOY KLEIN(613)334-3302 JKLEN/@IRANSCERAMICA COM NOTE: USE WITH GR. 156 @ FLOOR (1/16" THICK) NOTE: USE WITH GR. 157 @ DINING WALLS ONLY (1/16" THICK)
			EMSER	D99DEREBE0624	DEREVO BEIGE WOOD TILE (RECTIFIED)	6" x 24"	CONTRACT: CRISTINA DUNBAR (713)462- 2411 NOTE: U SE WITH GR-15G @ FLOOR (1116" THICK) NOTE: U SE WITH GR-17G @ DINING WALLS ONLY (1116" THICK)

CAMPAIN CAMP								
CHARGE COMMONTHS				FIANDRE /	Elm US (french wood) IRG 0624122	WOOD TILE (RECTIFIED)	6" x 24"	JDETER@EUROWEST.COM BK@EUROWEST.COM
CORD CONTROL				TRANSCERAMIC		WOOD TILE (RECTIFIED)	6" x 24"	CMASTRANGELO@TRANSCERAMICA.CO JOY KLEIN (813)334-3302 JKLEIN@TRANSCERAMICA.COM
Double D	CT-29G	CERAMIC TILE		EMSER	D99DEREGR0624		6" x 24"	CONTACT: CRISTINA DUNBAR (713)462- 2411 BURGERKING@EMSER.COM
CRANGE C				DALTILE	N625BK6241PK	N625 BROWN WOOD	6" X 24"	SUPPORT CENTER NATIONALACCOUNTS@DALTILE.COM (877) 556-5728 NOTE: USE WITH GR.15G @ FLOOR (1116" THICK) NOTE: USE WITH GR.17G @
CLUSSON CHARLES CANADOLISE			RESTROOM WALL /	FIANDRE /		SIGN RED NATURAL	12" x 24"	CONTACT: JANDETER (714) 309-9551 JDETER@EUROWEST.COM BK@EUROWEST.COM
CF-9942 CF-9	CT-30G	CT-30G CERAMIC TILE		TRANSCERAMIC		SIGN RED NATURAL	12" x 24"	CONTACT: CHRISTINA MASTRANGELO CMASTRANGELO@TRANSCERAMICA.CO JOY KLEIN (813)334-3302 JKLEIN@TRANSCERAMICA.COM
CF-910 CREMATURE SENICE AREA FOOD TO SET 1982 SENIOR TEST TO					SASSUOLO STONE TONES	WHITE GLOSSY SUBWAY TILE		CONTACT: LYDIA KURTH (954) 520-4283 LKURTH@CERAMIC TECHNICS
CH-10				FIANDRE /	1318GLOSSWHT1	WHITE GLOSSY SUBWAY TILE	3"x12" SUBWAY TILE	CONTACT: JANDETER (714) 309-9551 JDETER@EUROWEST.COM BK@EUROWEST.COM
EMBER OFFICE GLOSSYNETE OFFI OFFI OFFI OFFI OFFI OFFI OFFI OFF	CT-31G	CERAMIC TILE		TRANSCERAMIC	TCG1318	WHITE GLOSSY SUBWAY TILE		CONTACT: CHRISTINA MASTRANGELO CMASTRANGELO@TRANSCERAMICA.CO M
DAI-TILE				EMSER		WHITE GLOSSY SUBWAY TILE		CONTACT: CRISTINA DUNBAR (713)462- 2411 BURGERKING@EMSER.COM
CT-10G TLE BACK OF HOUSE ENDINGER OF HOUSE FAMORE TOGITIZHE CAPTOL GRAYTX 12 % 12				DAL-TILE	WL N524BK3121P2	N524 WHTE		CONTACT: ALEXANDRA STEFAN alexandra.stefan@daltile.com SUPPORT CENTER NATIONALACCOUNTS@DALTILE.COM
TR-1G COVE BASE PROFILE BACK OF HOUSE CONTRET OF WALL TILE TO BE CONTRET ON WHITE WALL THE WALL TILE TO BE CONTRET ON WHITE WALL THE WALL THE WALL TILE TO BE CONTRET ON WHITE WALL THE	CT-10G	TLE	BACK OF HOUSE	FIANDRE /	TCG1212142	CAPITOL GRAY TX	12" X 12"	CONTACT: JANDETER (714) 309-9551 JDETER@EUROWEST.COM
TR-10 TILE BASE BACK OF HOUSE COVE BASE PROFILE BACK OF HOUSE BACK OF HO				LUKUWLST				NOTE: USE WITH GR-6G (1/8" THICK)
CT-32G	CT-11G	TILE BASE		FIANDRE /		CAPITOL GRAYTX		JDETER@EUROWEST.COM BK@EUROWEST.COM
FRP-1G	CT-32G	CERAMIC TILE		EUROWEST	QUARTZITE	ALPESR11	24" x 24"	JDETER@EUROWEST.COM BK@EUROWEST.COM
TR-1G EDGE PROFILE OUTSIDE CORDERS OF WALL THE & BASE THE TRAIL AT RESTROOM TR-2G COVE BASE PROFILE GENERAL RESTROOM TR-3G EDGE PROFILE GENERAL RESTROOM TR-3G EDGE PROFILE BACK OF HOUSE SCHLUTER TR-3G TR-3G EDGE PROFILE BACK OF HOUSE SCHLUTER TR-3G TR-3	FRP-1G	FIBERGLASS REINFORCED PANEL	BACK OF HOUSE	MARLITE	204561B (4x8') 204551 (4x10') WHTE/BLK CORE NO TOP COAT	A916 G312		(330) 343-6621 ANITA CRAIG 330-260-7621
TR-1G EDGE PROFILE BASE TILE TISTA AT RESTROOM TR-2G COVE BASE PROFILE GENERAL RESTROOM TR-2G COVE BASE PROFILE GENERAL RESTROOM SCHLUTER DILEX-AHK100AT DILEX-AHK100AT SATININCKEL ANDDIZED ALLMINUM 38" NOTE: GC TO COORDINATE HEIGHT AS REQUIRED BASED UPON TILE THICKNESS AND SETTING. SYSTEM CONTACT: ROSANNA RUIZ (786) 868-0010 RRALZIAGSCH-LUTERCON RRUIZED BACK OF HOUSE SCHLUTER DILEX-AHK100AT SATININCKEL ANDDIZED ALLMINUM 38" NOTE: GC TO COORDINATE HEIGHT AS REQUIRED BACK OF HOUSE SETTING. CONTACT: ROSANNA RUIZ (786) 868-0010 RRUIZED CONTACT: ROSANN					(GRAY SCORE LINE)			NOTE: USE WITH TR-3G
TR-2G COVE BASE PROFILE GENERAL RESTROOM SCHLUTER DILEX-AHK100AT SATININCKEL ANODIZED ALLMINUM NOTE: GC TOCORDINATE HEIGHT AS REQUIRED BACK DUTYN IILLE HILLKINE SS AND SETTING SYSTEM TR-3G EDGE PROFILE BACK OF HOUSE SCHLUTER OUTSIDE CORNER A560 SATIN ANODIZED ALLMINUM PROFILE EDGE / 8 ELONG SYSTEM NOTE: GC TO COORDINATE HEIGHT AS REQUIRED BACK DUTYN IILLE HILLKINE SS AND SETTING SYSTEM NOTE: GC TO COORDINATE HEIGHT AS REQUIRED BACK OF HOUSE SCHLUTER COMMAN RUZ (786) 858-0010 RRJZ@SCHLUTER COM SYSTEM NOTE: GC TO COORDINATE HEIGHT AS REQUIRED SETTING SYSTEM ANODIZED ALLMINUM AND	TR-1G	EDGE PROFILE	WALLTILE & BASE TILE TRIM AT	SCHLUTER	QUADEC Q100AT	SATINNICKEL ANODIZED ALUMINUM	3/8"	NOTE: GC TO COORDINATE HEIGHT AS REQUIRED BASED UPON TILE THICKNESS AND
TR-3G EDGE PROFILE BACK OF HOUSE SCHLUTER OUTSIDE CORNER A560 SATIN ANODIZED ALLMINUM FINE THICKNESS AND SETTING SYSTEM TS-1G TRANSMONSTRIP CERAMIC TILE TO CERAMIC TILE TO CERAMIC TILE GR-6G GROUT BACK OF HOUSE GR-6G GROUT BACK OF HOUSE LATICRETE SPECTRALOCK 2000 IG FLISION PRO SINGLE (COMPONENT GROUT) CUSTOM BUILDING PRODUED SHOLE (SHOWN ALL ATTORET) CUSTOM BUILDING PRODUED SHOLE (COMPONENT GROUT) FLISION PRO SINGLE (COMPONENT GROUT) REQUIRED SYSTEM NOTE: GC TO COORDINATE HEIGHT AS REQUIRED SETTING SYSTEM NOTE: GC TO COORDINATE HEIGHT AS REQUIRED SETTING SYSTEM CONTACT: ROSANNA RUIZ (786) 868-0010 CONTACT: ROSANNA RUIZ (786) 868-0010 RRUIZ@SCHLUTER COM RRUIZ@SCHLUTER COM RRUIZ@SCHLUTER COM GROUT CONTACT: KRBY DAVIS AT LATICRETE (203) 671-7210 NOTE: USE WITH CT-10G, CT-11G, LATICRETE 
TR-3G EDGE PROFILE BACK OF HOUSE SCHLUTER OUTSIDE CORNER A560 SATIN ANODIZED ALLMINUM PROFILE SERVING SYSTEM NOTE: GC TO COORDINATE HEIGHT AS REQUIRED SYSTEM TS-1G TRANSMONSTRIP CERAMIC TILE TO CERAMIC TILE SCHLUTER FLOORS GROUT GROUT LATICRETE SPECTRALOCK 2000 IG #45 "RAVEN" LATICRETE SPECTRALOCK 2000 IG #45 "RAVEN" CONTACT: KREY DAVIS AT LATICRETE (20) 567-1766, LATICRETE	TR-2G	COVE BASE PROFILE	GENERAL RESTROOM	SCHLUTER	DILEX-AHK100AT	SATINNICKEL ANODIZED ALUMINUM	3/8"	REQUIRED SETTING
TS-1G TRANSITIONSTRIP CERAMIC TILE TO CONTACT: KIRBY DAVIS AT LATICRETE (203) 671-7210 NOTE: 1956-17-7210 NOTE: 1956-17-7	TR3G	EDGE PROFILE	BACK OF HOUSE	SCHLUTER	OUTSIDE CORNER A560	SATIN ANODIZED ALUMINUM	EXPOSED EDGE / 8"	CONTACT: ROSANNA RUZ (786) 858-0010 RRUZ@SCHLUTER COM NOTE: GC TO COORDINATE HEIGHT AS REQUIRED SETTING
LATICRETE SPECTRALOCK 2000 IG #45 "RAVEN" CONTACT: KIRBY DAVIS AT LATICRETE (203) 671-720. NOTE: USE WITH CT-106, CT-116, LATICRETE LATICR	TS-1G	TRANSITION STRIP		SCHLUTER		ANODIZED ALUMINUM AE 100-R, SATINANODIZED		CONTACT: ROSANINA RUIZ (786) 858-0010
GR-6G GROUT BACK OF HOUSE LATICRETE SPECTRALOCK 2000 IG #45 "RAVEN" BACK OF HOUSE CUSTOM BUILDING BUILDING PRODUCTS COMPONENT GROUT H45 "RAVEN" (203) 674-7210 NOTE: US WITH CT-10G, CT-11G, LATICRETE HYDROG MI FOO MATERDROOC CONTACT: LARRY MARKE (651) 543-658 LAZARO MAURA @CEPMAL NET NUIE: USE WITH CL-10G, CL-1-11G, LATICRETE	GROUT							CONTACT. VIDBY DAVIG AT LATIODETE
CUSTOM FUSION PRO SINGLE #370 DOVE GRAY LAZARO MAURA@CBPMALL.NET NUTE: USE WITH CL-TUG., CL-TTG., PRODUCTS PRODUCTS COMPONENT GROUT LATCRETE	GR-6G	GROUT	BACK OF HOUSE	LATICRETE	SPECTRALOCK 2000 IG	#45 "RAVEN"		(203) 671-7210 NOTE: USE WITH CT-10G, CT-11G, LATICRETE
				BUILDING		#370 DOVE GRAY		LAZARO.MAURA@CBPMAIL.NET NOTE: USE WITH CT-10G, CT-11G, LATICRETE



FCC COMMERCIAL FURNITURE INC. 8452 OLD HWY 99 N, ROSEBURG, OR 97470 USA T. 800.322.7328 | F. 541.673.7441 | WWW.FCCFURN.CO DESIGNED AND BUILT IN U.S.A.

PROPERTY OF FCC COMMERCIAL FURNITURE
THIS IS A FOR DESIGN PURPOSE TO EXPRESS DESIGN
CONCEPTS TO THE ARCHITECT, CLIENT, CONTRACTOR
AND INSTALLER FOR THE PROJECT SHOWN. THIS DESIGN
AND THE CONCEPTS HEREIN SHAT
NOT BE ALTERED OR USED AS CONSTRUCTION
DOCUMENTS. DO NOT REPRODUCE OR LEND WITHOUT
WRITTEN PERMISSION FROM FCC COMMERCIAL
FURNITURE INC.

IMPORTANT

ITTEN DIMENSIONS HAVE PRECEDENCE OVER SCA

DO NOT SCALE OFF PLANS. CONTACT FCC COMMERCIAL FURNITURE'S REPRESENTATIVE TO VERIFY ANY QUESTIONABLE DIMENSIONS AT TELEPHONE # 800.322.7328

THE GENERAL CONTRACTOR MUST VERIFY ALL BUILDING DIMENSIONS, EQUIPMENT, FURNITURE PLACEMENT, UTILITY LOCATIONS, AND CONDITIONS AT THE JOB SITE.

THE GENERAL CONTRACTOR MUST NOTIFY FCC COMMERCIAL FURNITURE OF ALL DISCREPANCIES ANDIOR REQUIRED ADJUSTMENTS PRIOR TO STARTING WORK.

NDIOR REQUIRED ADJUSTMENTS PRIOR TO STARTING IORK.

CC COMMERCIAL FURNITURE HAS PREPARED THESE OCUMENTS AS ACCURATELY AS POSSIBLE WITH THE RICHITECTURAL INFORMATION PROVIDED. DUE TO LAC

ARCHITECTURAL INFORMATION PROVIDED. DUE TO LACE
PACCURATE AND AND COMPLETE DIMENSIONED
ARCHITECTURAL PLANS, OWNER UNDERSTANDS THAT
ADJUSTMENTS TO THE FINAL LOCATIONS OF EQUIPMENT
ANDIOR FURNITURE PLACEMENT MAY BE REQUIRED AT
THE OWNERS EXPENSE DUE TO DISCREPANCIES BASED
ON ACTUAL JOB SITE DIMENSIONS AND CONDITIONS.

REFER TO ARCHITECTURAL OR ENGINEER DRAWINGS FOR COMPLETE AND ACCURATE DIMENSIONS OF BUILDING STRUCTURE.

HEY CONTAIN ARE THE PROPERTY OF FCC COMMERCIA URNITURE INC., ROSEBURG, OREGON, 97470.

ALL PREPARED CONTRACT DOCUMENTS MAY NOT BE COPIED, REPRODUCED, USED OR IMPLEMENTED IN ANY WAY, IN PART OR IN WHOLE, WITHOUT THE EXPRESS WRITTEN CONSENT OF FCC COMMERCIAL FURNITURE INC.

ANY UNAUTHORIZED USE OF THESE PLANS WILL RESULT IN PAYMENT DUE FOR SERVICES RENDERED BY FCC COMMERCIAL FURNITURE INC.



DECOR EQUIPMENT ORDERED OF DATE SHOWN BELO

CLIENT:



Burger King
66745 Two Bunch Palms Trail
Desert Hot Springs, CA 92240
Decor: Garden Grill
Building Type: Custom
CUSTOMER

F & N Investments

SHEET TITLE: SPECIFICATIONS

WORK ORDER NUMBER:

FINALS BY:

DRAWN BY: AARON McCRAW SCALE: NTS

ORIGINAL DATE:

March 29, 2021
PLOT DATE:

April 5, 2021 PROJECT #:

22114-001

SHEET #: **D8.4**

00.450	00015	FIELD FLOOR TILE /	CUSTOM BUILDING PRODUCTS	FUSION PRO SINGLE COMPONENT GROUT	#335 WINTER GRAY		CONTACT: LARRY MAURA (561) 543-6558 LAZARO MAURA @CBPMAILNET ""PROLITE® PREMIUM LARGE FORMAT								
GR-15G	GROUT	BEVERAGE WALL	LATICRETE	PERMACOLOR	#60 DUSTY GRAY		TILE MORTAR - RAPID SETTING CONTACT: KIRBY DAVIS AT LATICRETE (203) 671-7210								
			CUSTOM BUILDING	FUSION PRO SINGLE COMPONENT GROUT	#145 LIGHT SMOKE		CONTACT: LARRY MAURA (561) 543-6558 LAZARO.MAURA@CBPMAIL NET								
GR-17G	GROUT	DINING / ACCENT TILE LIGHT WOOD	PRODUCTS	755W 001 0P	#56 DESERT KHAKI		****PROLITE® PREMIUM LARGE FORMAT TILE MORTAR -RAPID SETTING CONTACT: KIRBY DAVIS AT LATICRETE (203) 671-7210								
			LATICRETE	PERMACOLOR			NOTE: U SE WITH CT-28G @ WALLS ONLY CONTACT: KIRBY DAVIS AT LATICRETE								
		SERVICE AREA WALL	LATICRETE	PERMACOLOR	#78 STERLING SILVER		(203) 671-7210								
GR-18G	GROUT	-18G GROUT S	TILE	CUSTOM BUILDING PRODUCTS	FUSION PRO SINGLE COMPONENT GROUT	#543 DRIFTWOOD		CONTRACT: LARRY MAUPA (661) 543-6558 LAZARO.MAURA@CBPMAILNET "PROLITE® PREMIUM LARGE FORMAT TILE MORTAR -RAPID SETTING							
WALL FINISHES AND				l l			NOTE: U SE WITH CT-31G								
		00/55/	PINEHALL BRICK	THIN BRICK (Use WITH EGR-1G)	OLD IRVINGTON	7-5/8" x 3-5/8" x 1/2"	CONTACT: TERESA BEANE (336)-779-6131 TBEANE@PINEHALLBRICK.COM NOTE: U SE WITH EGR-1G CONTACT: GABE POWERS (502) 558-4612								
BR-2G	FACE BRICK	GENERAL DINING/ ACCENT WALLS	EVOLUTION BRICK	THINBRICK (Use WITH EGR-1G)	"Olde Hillsboro" Mod/QS Tumbled (Full Brick) "Sierra Tumbled" (Thin Brick)	7-5/8" x 3-5/8" x 1/2"	gabe@evolutionbrick.com NOTE: USE WITH EGR-1G								
			LEHIGHHANSON		Ohio River Masonry Sand		CONTACT: GABE POWERS (502) 558-4612 gabe@evolutionbrick.com								
EGR-1G	BRICK MORTAR	General Dining/ Accent Walls		(USE WITHBR-2G)	B-12C / B-12		NOTE: U SE WITH BR-2G								
		TTAIS	ARGOS US		LITE BUFF		CONTACT: DONNIE HOWARD (919) 390- 4962 DONNIE HOWARD@ARGOS-US.COM								
P-4G	PAINT	INTERIOR DOOR FRAMES		PRIMER 90-712 PITT TECH PAINT: 6-1510XI SPEEDHDE INT/EXT WB	ASHEN		CONTACT: KEVIN LASTACY KLASTACY@PPG.COM 616-335-3259								
P-5G	PAINT	SOFFITS AND RESTROOM CEILING			ALKYD SEMI-GLOSS PRIMER: 6-4900XI SPEEDHIDE ZERO INT LATEX SATIN PAINT: PPG 6-4310XI	WHITE ON WHITE									
			PPG	SPEEDHIDE ZERO INT ZERO VOC LATEX EGGSHELL											
P-6G	PAINT	EXPOSED DECKING AND BARJOISTS/ WALLS OVERSOFFIT	1					PRIMER 17-921 SEAL GRIP PAINT: PPG 6-417 SPEEDHIDE ZERO INT ZERO VOC LATEX EGGSHELL	CABIN FEVER PPG 1021-7						
P-15G	PAINT	INTERIORWALLS				PRIMER 6-4900XI SPEEDHIDE ZERO INT LATEX SATIN PAINT: 6-4310XI SPEEDHIDE ZERO INT ZERO VOC LATEX EGGSHELL	ASHEN								
P-16G	PAINT	INTERIOR SERVICE AREA DOOR FRAME		PRIMER 90-712 SPEED TECH PAINT: 6-150XI SPEEDHDE INT/EXT WB ALKYD SEMI-GLOSS	CAFÉ SIENNA										
P-17G	PAINT	HVAC AIR RETURN & REGISTERS LOCATED AT ACT-1G		PRIMER: 90-712 PITT TECH PAINT: 6-1540XI SPEEDHDE INT/EXT WB ALKYD SEMI-GLOSS	GRANTE PPG 1022-6										
P4G	PAINT	INTERIOR DOOR FRAMES		PRMER PM 200 V OC B28W2600 PANT: PM 200 0 V OC B20W2600 PRIMER ProCnt B66-310 PANT: Pro Industrial WB Uvethane Alkyd Eramel B53-1150	BUNGALOWBEIGE SW7511		CONTACT: GLENNUJ. REMLER (954) 547-127 GLENNUJ.REMLER@SHERWIN.COM								
P-5G	PAINT	INTERIOR UNDERSIDE OF CORRIDOR SOFFIT AND RESTROOM CEILING					Semi-Gloss	EXTRA WHITE SW 7006							
P-6G	PAINT	EXPOSED DECKING AND BARJOISTS	SHERWIN WILLIAMS	PRIMER: Multi Surface Acrylic B66-560 PAINT: Multi Surface Acrylic B66-560	WELL-BRED BROWN SW 7027										
P-15G	PAINT	INTERIOR WALLS/ SOFFIT	- LEVINO	WILLIAMS	WILLIAMS	WILLIAMS	WILLIAMS	WILLIAMS	WILLAMS			Eggshell PRIMER: PM 200 0 VOC B28W2600 PAINT: PM 200 0 VOC B20W2600 Eggshell	BUNGALOW BEIGE SW 7511		
P-16G	PAINT	INTERIOR SERVICE AREA DOOR FRAME		PRIMER: ProCryl B66-310 PAINT: Pro Industrial Worthane Alkyd Enamel B53-1150 Semi-Gloss	GG ORANGE CUSTOM COLOR										

P-17G	PAINT	HVAC AIR RETURN & REGISTERS LOCATED AT ACT-1G		PRIMER INT/EXT PRO INDUSTRIAL SEMICLOSS PAINT: Pro Industrial WB Urethane Alkyd Enamel IFC 8112NP	ARMSTRONG CELUNG MATCH CUSTOM COLOR		
			MARLITE	Semi-Gloss ALLURE PANEL	Nevamar WF001 Macchiato X-Grain	4" x 4" Panels	CONTACT: CUSTOMER SERVICE (330) 343-6621 ANITA CRAIG 330-260-7621 ACRAIG@MARLITE.COM
WP-2G	WALL PANEL SYSTEM	GENERAL WAINSCOTING	СІМ	MATTAKI CONVERGE	Nevamar WF001 Macchiato X-Grain	32" x 48" 48" x 48" Panels	CONTACT: AUSTIN HOLAN (706)253-4761 AUSTIN@CIMGBIZ.COM
UPHOLSTERY UPH-7G	UPHOLSTERY	SEATING (Booth/Settee) SEAT PADS		LARIAT 440401	010 TALPE		CONTACT: JANELLE AROLZ (404) 909-8444 JARAUZ@MAHARAM.COM
UPH-10G	UPHOLSTERY	SEATING (Booth/Settee) BACK PADS AND LOUNGE CHAIR	MAHARAM	LARIAT 440401	007 OYSTER		
UPH-11G	UPHOLSTERY	LOUNGE CHAIR "COLLECTION OPTION"	C.F.STINSON	CASSIDY	CAS 82 HOSTA		CONTACT: GLENNSTINSON (248) 299-3800 GSTINSON@CFSTINSON.COM
METALS MF-1G	METAL FINISH POWDER COAT	FIXTURES AS NOTED	PERVENDOR		BLACKENED STEEL		PERVENDOR
MF-2G	METAL FINISH ALUMINUM	FIXTURES AS NOTED	PERVENDOR		FLAT BLACK ANODIZED		PERVENDOR
MF-3G	METAL FINISH ALUMINUM	SLAT PERGOLA SUPPORTS	PERVENDOR	POWDER COATED BROWN	MATCH P-6G (SLATE BROWN)		PERVENDOR
MF-4G	METAL FINISH ALUMINUM	DIVIDER SCREEN & SAUCE BAR	PER VENDOR	POWDER COATED	STATUARYBRONZE		PERVENDOR
SPECIALTY FINISHES AND TRIMS							
PL-9G	PLASTIC LAMINATE	PERMITER TABLES, DOORS, TRASH UNIT	NEVAMAR	WK0017T	VERNERABLE OLD OAK		CONTACT: CUSTOMER SERVICE (877)726-6526 JOHN TRULOCK JOHN TRULOCK@PANOLAM.COM (407) 618-3732
PL-15G	PLASTIC LAMINATE	TABLES / BOOTHS	NEVAMAR	WF0011T	MACCHIATO		
PL-16G	PLASTIC LAMINATE	TABLES	NEVAMAR	WZ2001T	SANTA ROSA PLUM TREE		
PL-17G	PLASTIC LAMINATE	TABLES	NEVAMAR	WF0013-T	CARAMEL MACCHIATO SUEDE		
PL-18G	PLASTIC LAMINATE	BEVERAGE STATION CABINET DOORS/ INNER SIDE OF WOOD SLAT PERGOLA/INTERIOR SERVICE AREA ACCENT WALL & DOOR	NEVAMAR	S03300 SD	CAFÉ SIENIVA		
PL-19G	PLASTIC LAMINATE	BOOTHBASE	PIONITE	SE101S	BLACK		
WS-1G	WOOD STAIN	SHELVING LOUNGE AREA	PER VENDOR	BALTIC BIRCH	CLEAR COATED		LOCAL DISTRIBUTOR
WS-2G	WOOD STAIN	COMMUNITY TABLE/ SAUCE BAR	PER VENDOR	WHITE OAK	CLEAR COATED		LOCAL DISTRIBUTOR
WS-3G	WOOD STAIN	TRELLIS SOFFIT	PER VENDOR	STAINED POPLAR WOOD	MATCHNEVAMAR SANTA ROSA PLUM TREE		LOCAL DISTRIBUTOR
TR-01G	DRYWALL REVEAL BEAD	BETWEENP-6G & P-15G WHENPERIMETER SOFFIT IS OMMITED	TRIM-TEX	AS5110S	ARCHITECTURAL SILVER	1/2" X 1/2"	CONTACT: LOCAL SUPPLIER
SL-1G	SURF(X)3D LAMINATE	TRELLIS SOFFIT	OMNOVA SOLUTIONS	SURF (X) 3D LAMINATES ON SUNTRAIT	ALMOND CHERRY	12 MIL (0.12)	CONTACT: CHERI RUKAVINA (404)971-8119 CHERI RUKAVINA @OMNOVA. COM
MEB-1G	MULTIPLEX EDGE BAND	TABLES (STANDARD TABLE THCKNESS)	REHAU	PREMUIM EDGE BAND #592E	MULTIPLEX	1-5/16" THICK	CONTACT: MEG HUIZENGA (616) 666-7932 MEG HUIZENGA@REHAU.COM
MEB-2G	MULTIPLEX EDGE BAND	BOOTH EDGE PROTECTION	REHAU	NEVAMAR MACCHIATO CP41002	MATCHPL-15G (MACCHIATO)		
SOLID SURFACES							CONTACT: TIANA MARIE BRAGG
SS-8G	SOLID SURFACE	FIXTURES AS NOTED TOP CAP! SILL	DUPONT	CORIAN	DEEP NOCTURNE	30" x 144" x 1/2" THICKNESS	CUNIACT: TAINA MARIE BRAGG (925) 337-337 TIANA.MARIE BRAGG@DUPONT.COM
SS-9G	SOLID SURFACE	FSC/BEVERAGE COUNTERTOP	AVONITE	CUSTOM COLOR BK SMOKE	#7885	30" x 144" x 1/2" THICKNESS	CONTACT: SANDRA COHEN (410) 259-8508 scohen@aristechsurfaces.com
		(ALTERNATE TO MS-1G)	US SURFACES	LIVINGSTONE	STORM		CONTACT: ED ROGERS (505) 710-3999 EDR@USSURFACES.COM
MS-1G	MANUFACTURED STONE	FSC/BEVERAGE COUNTERTOP	SILESTONE	QUARTZ, VOLCANO TEXTURE	GREY EXPO	3/4" THCK	CONTACT: JENNFER RYAN (305)-398-5700 JENNFERR@COSENTINO.COM
		SSSWERTOF	US SURFACES	VADARA	BRUSHED CEMENT	2 CM THICK	CONTACT: ED ROGERS (505) 710-3999 EDR@USSURFACES.COM
RESIN R-1G	RESIN	FSC SMOOTHE SCREENS	3-FORM	PUNCH 021	VELLUM F04 FINISH FRONT & BACK	3/8" THCK	CONTACT: JULIANA SHARKEY JULIANA SHARKEY@3FORM.COM (954) 579-6545



FCC COMMERCIAL FURNITURE INC. 8452 OLD HWY 99 N, ROSEBURG, OR 97470 USA T. 800.322.7328 | F. 541.673.7441 | WWW.FCCFURN.C DESIGNED AND BUILT IN U.S.A.

PROPERTY OF FCC COMMERCIAL FURNITURE
THIS IS A FOR DESIGN PURPOSE TO EXPRESS DESIGN
CONCEPTS TO THE ARCHITECT, CLIENT, CONTRACTOR
AND INSTALLER FOR THE PROJECT SHOWN. THIS DESIGN
AND THE CONCEPTS HEREIN SHAT
NOT BE ALTERED OR USED AS CONSTRUCTION
DOCUMENTS. DO NOT REPRODUCE OR LEND WITHOUT
WRITTEN PERMISSION FROM FCC COMMERCIAL
FURNITURE INC.

<u>IMPORTANT</u>

WRITTEN DIMENSIONS HAVE PRECEDENCE OVER S

DO NOT SCALE OFF PLANS. CONTACT FCC COMMERCIAL FURNITURE'S REPRESENTATIVE TO VERIFY ANY QUESTIONABLE DIMENSIONS AT TELEPHONE # 800.322.7328

THE GENERAL CONTRACTOR MUST VERIFY ALL BUILDING DIMENSIONS, EQUIPMENT, FURNITURE PLACEMENT, UTILITY LOCATIONS, AND CONDITIONS AT THE JOB SITE.

THE GENERAL CONTRACTOR MUST NOTIFY FCC COMMERCIAL FURNITURE OF ALL DISCREPANCIES AND/OR REQUIRED ADJUSTMENTS PRIOR TO STARTING WORK.

WORK.

FCC COMMERCIAL FURNITURE HAS PREPARED THESE
DOCUMENTS AS ACCURATELY AS POSSIBLE WITH THE
ARCHITECTURAL INFORMATION PROVIDED. DUE TO LACK
OF ACCURATE AND AND COMPLETE DIMENSIONED
ARCHITECTURAL PLANS, OWNER UNDERSTANDS THAT
ADJUSTMENTS TO THE FINAL LOCATIONS OF EQUIPMENT

REFER TO ARCHITECTURAL OR ENGINEER DRAWINGS FOR COMPLETE AND ACCURATE DIMENSIONS OF

HESE CONTRACT DOCUMENTS AND THE INFORMATION
HEY CONTAIN ARE THE PROPERTY OF FCC COMMERCIA
HERNITHER INC. ROSERING OREGON 97470

L PREPARED CONTRACT DOCUMENTS MAY NOT BE OPIED, REPRODUCED, USED OR IMPLEMENTED IN AN' AY, IN PART OR IN WHOLE, WITHOUT THE EXPRESS RITTEN CONSENT OF FCC COMMERCIAL FURNITURE I

ANY UNAUTHORIZED USE OF THESE PLANS WILL RESULT IN PAYMENT DUE FOR SERVICES RENDERED BY FCC COMMERCIAL FURNITURE INC.


THESE DOCUMENTS REFLECT SPECIFIC SEATING AND DECOR EQUIPMENT ORDERED OF DATE SHOWN BELO

CLIENT:



Burger King
66745 Two Bunch Palms Trail
Desert Hot Springs, CA 92240
Decor: Garden Grill
Building Type: Custom
CUSTOMER

F & N Investments

SHEET TITLE: SPECIFICATIONS

WORK ORDER NUMBER:

FINALS BY:

DRAWN BY: AARON McCRAW SCALE: NTS

ORIGINAL DATE:
March 29, 2021

PLOT DATE: April 5, 2021

PROJECT #: **22114-001**

SHEET #: **D8.5**

			BURGER KING 20/20 GARDEN		RIOR			
00.00.00			INTERIOR LIGHT FIXTURE S	CHEDULE				
06.03.20			STANDARD TRELLIS (6	"v 6"\				
TYPE		VENDOR	CATALOG No.	WATTAGE	COLOR TEMP	REMARKS		
			BK304 & SP30S-18-60D-927-03			SHAKER PENDANT LAMP		
А		NAUTICAL	LED EDISON STYLE 10 WATT	10	2700			
		NAUTICAL	BK-GG-A2 CUSTOM PENDANT LIGHT	10		RED PENDANT LIGHT		
A1			RED		2700K			
			LED CLEAR ANTIQUE STYLE 6 WATT					
	1	NAUTI CAL	BK305 & LED 8 W EDISON INCANDESCENT	6		BRONZE CAGE PENDANT LIGHT		
В			LED CLEAR ANTIQUE STYLE 6 WATT		2700K			
	₩							
	1	NAUTICAL	BK305 & LED 8W EDISON INCANDESCENT	6		BRONZE CAGE WALL SCONCE LIGHT		
B1			LED CLEAR ANTIQUE STYLE 6 WATT		2700K			
	₩		220 022 11/11/10/22 11/11/1		1 27 35 11			
		CREE	LR6-10L-30K-120V-A-DR-RC6-12W-GU24	12.5	3000	6" DIAMETER, WHITE, RECESSED DOWN LIGHT		
	C6w	SECURITY	SLSDBXQL-LB6LEDA3.0KWH	14	3000			
	<u></u>	LSI	LCD6 13 LED 30 48 UE TR6RL HAZ WH	13	3000	1		
C6w		JUNO	SP34505-930-6-WWH	11	3000			
		VAOPTO	VO-DL-6WW20-85E26-110-WHITE	18	3500			
		ENERGYWISE	EWRR61130W-L7	11	3000	1		
	CREE		LEGC-GU24W-RR6-GU24	12	3000	6" DIAMETER, WHITE, RECESSED DOWN LIGHT &		
		LSI	PDL6KADJ-LED-07-30-120-PDL6KADJHSGNC	14	3000	WALL WASHER		
D6w	10	VAOPTO	VO-DL-6WW13-90K90A	13	3000			
Dow		JUNO	SP34506-27K-6WWH	11	3000			
		—	EWRRA61030W	10	3000	1		
		ENERGYWISE	EM UVAQIOSOM	10	3000	TRACK LIGHT		
E		JUNO	R600L3KNBZ	10	2700	N. C.		
	7	CREE	SCG-CM-BL-GU24-CR6-800L-30K-120V-GU24CTGA			PENDANT LIGHT		
	-	SECURITY	LBC6CM-LB6LEDA1030KBL	12	3000	1		
F	797	ENERGYWISE	EWLBCGBLK		3000			
		JUNO	SP34378B-9-F1-SSN	10	3000	2" DIAMETER DOWN LIGHT, SATIN NICKEL FINISH		
G		ZANIBONI	D2LUNA20930A3CSNP0BK0P	9	3000			
_		ZANIBON	BEEGIVIE OSSOVE OSKI		5000	1		
	O#.	JUNO	SP34378A-930-F1-SN	10	3000	2" DIAMETER WALL WASHER, SATIN NICKEL FINISH		
G1		ZANIBONI	D2LUN2O0930A3CSNP0BK0D	9	3000			
			5220120050130011	-	3000	1		
		CREE	CL-E-TFA04A-24R-40N	42	4000	1. TO BE USED IN KITCHEN		
		SECURITY	LJT24-40-MLG-FSA12-EU-C388	45	4000	2. 2x4 RECESSED		
I	[]	LSI	SFP24 LED 50 UE DIM 40	50	4000			
		VAOPTO	VO-PL-2NW4-60	60	4000			
		ENERGYWISE	EWMLFP24EP4841	48	4100			
		CREE	CL-E-TR14L2404U	42	3500	1. FOR REMODELS ONLY		
		SECURITY	LJT14-35LWG-FSA12-EDU-C388	27	3500	2. TO BE USED IN RESTROOMS		
J		LSI	SFP14 LED 40 UE DIM 35 FK14	40	3500	3. 1x4 RECESSED		
		VAOPTO	VO-PL-1XWW4-50	50	3000			
		ENERGYWISE	EWMLFP14EP3535	35	3500			

VCEDTES										
PENDANII			ABLE TOPS. COORDINATE WITH DÉCOR DRAWINGS. FIXTURES IN DINING ROOM AREA & RESTROOM CORRIDO		ON FURDOCED BOOK	TRUCCEC				
				E and OR I HOUSE OF ECIFI	C. II ES AND QUANT					
NOT ALL LI	CHT EIVTI IDES TV	DEC SHOWN ON SCHED	NOTES ULE MAY BE USED ON THIS PROJECT. REFER TO LIGHTING P	I AN EOR BROJECT SPECIEL	TYPES AND OLIANT	TITIES				
			NOTES							
bob.lu	cas@lsi-indu	ıstries.com								
80	00-436-7800 Ex									
	BOB LUCAS	,								
quotatio	ons@securityl	ighting.com	mhoglund@nauticalfurnishings.com	linda@va	opto.com	s outheas tusa@zai	nibonilighting.co			
	630-550-932		954-771-1100	702-51			3-0410			
	WHITNEY WAT	SON	MICHAEL HOGLUND	LIND	A XU	JENNIFER	MORRIS			
9	SECURITY LIGH	TING	NAUTICAL FURNISHINGS	<u>Va</u> C	<u>Opto</u>	ZANIBONI	LIGHTING			
esulj	ic@creeligh	ting.com	wyatt@hlg.co	jennifer@ener	gywis e mail.com	brett.ki nzler@a	cuitybrands.com			
	262-884-333		615-843-3379		5-1336		m 847-312-1578			
	ELVIR SULJI	С	WYATT CULVER		WADDICK		KINZLER			
	CREE		HERMITAGE "MASTER CONSOLIDATOR"	ENERG	YWISE	JUNO / ACU	ITY BRANDS			
	1		CONTACT INFORI	MATION	<u> </u>	I				
01		CREE	LS8-80L-35K-10V	88	3500					
						PLAYGROUNG PENDANT	LIGHT			
o		CREE	LS4-25L-35K-10V	23	3500	PLAYGROUNG PENDANT LIGHT				
		ENERGYWISE	EWMLED-LSV2XT8USE4806		DI AVODOUNG BENDANT					
		VAOPTO	VO-TF-14W	32 36	5000					
WIB		LSI	EG34SLEDHOCWUE	52	5300					
	1	SECURITY	LXEM4-50ML-RFA-EU	53	5000					
		CREE	WS4-50L-57K-10V-FD		55 5300 TO BE USED IN W					
		ENERGYWISE	EWCCR	4	3000					
		VAOPTO	VO-EMX-R1	2	5000					
EMX	FXII	LSI	LPRXRUWBWHLD11R	(2) 1 LED						
	Pilin II	SECURITY	CCRRC	4						
		CREE	EXDMBRWH	11		EXIT / EMERGENCY LIGHT				
		ENERGYWISE	EWCU2	1	3000					
	33)	VAOPTO	VO-EM	2	5000					
EM	200	LSI	LTEMWH	(2) 1 LED						
		SECURITY	CU2	1	3000					
		CREE	EM22RWH	11		EMERGENCY LIGHT				
		ENERGYWISE	EWMLFP22EP3535	36	3500					
		VAOPTO	VO-PL-2XWW2-36	36	3000					
PG		LSI	SFP22 LED 30 UE DIM 35 FK22	30	3500	Z. ZAZ NECESSES				
		CREE SECURITY	CL-E-TFA03A-22R-40N LJT22-35MLG-FSA12 EU	32 35	3500 3500	1. TO BE USED IN PLAYGR 2. 2x2 RECESSED				

AREA AND OVER THE SELF-SERVE DRINK AREA. FIXTURE TYPE "I" WILL REQUIRE A LENS OR TUBE GUARD AT THOSE LOCATIONS.



FCC COMMERCIAL FURNITURE INC.

8452 OLD HWY 99 N, ROSEBURG, OR 97470 USA

T. 800.322.7328 | F. 541.673.7441 | WWW.FCCFURN.0

DESIGNED AND BUILT IN U.S.A.

PROPERTY OF FCC COMMERCIAL FURNITURE
THIS IS A FOR DESIGN PURPOSE TO EXPRESS DESIGN
CONCEPTS TO THE ARCHITECT, LUENT, CONTRACTOR
AND INSTALLER FOR THE PROJECT SHOWN. THIS DESIGN
AND THE CONCEPTS HEREIN SHAT
NOT BE ALTERED OR USED AS CONSTRUCTION
DOCUMENTS. DO NOT REPRODUCE OR LEND WITHOUT
WRITTEN PERMISSION FROM FCC COMMERCIAL
FURNITURE INC.

IMPORTANT

RITTEN DIMENSIONS HAVE PRECEDENCE OVER SCAL

DO NOT SCALE OFF PLANS, CONTACT FCC COMMERCIAL FURNITURE'S REPRESENTATIVE TO VERIFY ANY QUESTIONABLE DIMENSIONS AT TELEPHONE # 800.322.7328

THE GENERAL CONTRACTOR MUST VERIFY ALL BUILDING DIMENSIONS, EQUIPMENT, FURNITURE PLACEMENT, UTILITY LOCATIONS, AND CONDITIONS AT THE JOB SITE.

THE GENERAL CONTRACTOR MUST NOTIFY FCC COMMERCIAL FURNITURE OF ALL DISCREPANCIES AND/OR REQUIRED ADJUSTMENTS PRIOR TO STARTING WORK.

CC COMMERCIAL FURNITURE HAS PREPARED THESE OCUMENTS AS ACCURATELY AS POSSIBLE WITH THE RCHHIECTURAL INFORMATION PROVIDED DUE TO LACKED F ACCURATE AND AND COMPLETE DIMENSIONED RCHIECTURAL PLANS, OWNER UNDERSTANDS THAT DJUSTMENTS TO THE FINAL LOCATIONS OF EQUIPMEN NUIDER FURNITURE PLACEMENT MAY BE REQUIRED AT

REFER TO ARCHITECTURAL OR ENGINEER DRAWINGS FOR COMPLETE AND ACCURATE DIMENSIONS OF

THESE CONTRACT DOCUMENTS AND THE INFORMATION THEY CONTAIN ARE THE PROPERTY OF FCC COMMERCIA FURNITURE INC., ROSEBURG, OREGON, 97470.

ALL PREPARED CONTRACT DOCUMENTS MAY NOT BE COPIED, REPRODUCED, USED OR IMPLEMENTED IN ANY WAY, IN PART OR IN WHOLE, WITHOUT THE EXPRESS WRITTEN CONSENT OF FCC COMMERCIAL FURNITURE INC

ANY UNAUTHORIZED USE OF THESE PLANS WILL RESULT IN PAYMENT DUE FOR SERVICES RENDERED BY FCC COMMERCIAL FURNITURE INC.

ANY DEVIATIONS FROM THESE DRAWINGS FOR ANY REASON SHALL NOT BOTHE WITHOUT CONSENT OF FOC COMMERCIAL FURNITURE INC. IN ADVIACE, IN WRITING, FCC COMMERCIAL FURNITURE IS NOT RESPONSIBLE FOR EVALVIONS, CHAMCES, ADDITIONS, OF DELETIONS NOT EXPLAIN AND HANCES, ADDITIONS, OF DELETIONS NOT COMMERCIAL FURNITURE INC.

HESE DOCUMENTS REFLECT SPECIFIC SEATING AND FCOR FOLIPMENT ORDERED OF DATE SHOWN BELOW.

CLIENT:



Burger King 66745 Two Bunch Palms Trail Desert Hot Springs, CA 92240 Decor: Garden Grill Building Type: Custom

CUSTOMER

F & N Investments

SHEET TITLE: SPECIFICATIONS

WORK ORDER NUMBER:

FINALS BY:

DRAWN BY: AARON McCRAW SCALE:

NTS ORIGINAL DATE:

March 29, 2021

April 5, 2021

PROJECT #:

22114-001

D8.6


PLEASE PROVIDE THE INFORMATION REQUESTED BELOW IN CASE THERE ARE ANY QUESTIONS ABOUT DIMENSIONS.


PHONE #: _____

DIMS ARE FROM:

STUD TO STUD

DRYWALL TO DRYWALL

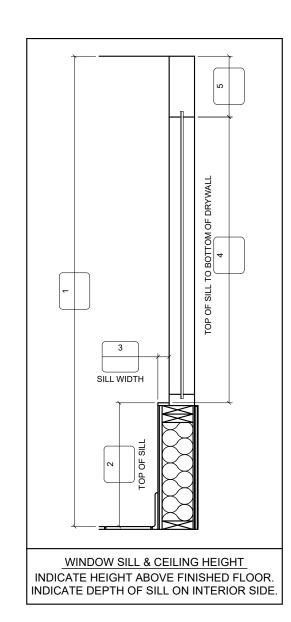

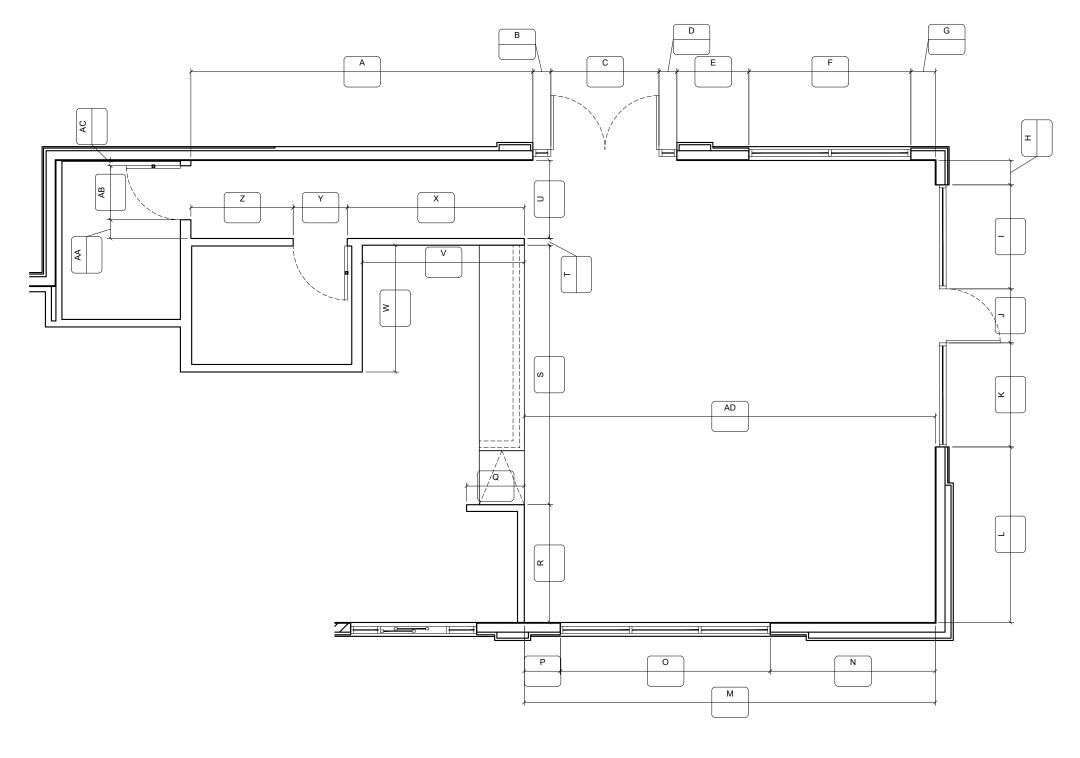

PLACE REQUIRED DIMENSIONS IN LETTERED BOXES.
PLEASE INDICATE OR NOTIFY FCC REGARDING CHANGES
OR MODIFICATIONS TO THE BUILDING; SUCH AS:
DOOR LOCATIONS, VESTIBULE(S), FURRING & WINDOWS.



8452 OLD HWY 99 N, ROSEBURG, OR 97470 USA
T. 800.322.7328 | F. 541.673.7441 | WWW.FCCFURN.C
DESIGNED AND BUILT IN U.S.A.

PROPERTY OF FCC COMMERCIAL FURNITURE THIS IS A FOR DESIGN PURPOSE TO EXPRESS DESIGN CONCEPTS TO THE ARCHITECT, CLIENT, CONTRACT AND INSTALLER FOR THE PROJECT SHOWN. THIS DIMENSION OF THE PROPERTY OF THE PRO

IMPORTANT

WRITTEN DIMENSIONS HAVE PRECEDENCE OVER SCA IN ALL CASES.

ON SCALE OFF FLANS. CONTACT FCC COMMER FURNITURE'S REPRESENTATIVE TO VERIFY ANY QUESTIONABLE DIMENSIONS AT TELEPHONE # 800.322.7328

HE GENERAL CONTRACTOR MUST VERIFY ALL BUILD IMENSIONS, EQUIPMENT, FURNITURE PLACEMENT,

HE GENERAL CONTRACTOR MUST NOTIFY FCC
OMMERCIAL FURNITURE OF ALL DISCREPANCIES
NAMED BEING TO STABTIN

TOTAL COCOMMERCIAL FURNITURE HAS PREPARED THESE DOCUMENTS AS ACCURATELY AS POSSIBLE WITH THE ARCHITECTURE. INFORMATION PROVIDED DUE TO LA JOE ACCURATE AND AND COMPLETE DIMENSIONED ARCHITECTURE JUANS, OWNER UNDERSTANDS THAT ADJUSTMENTS TO THE FINAL LOCATIONS OF EQUIPME MINIOR FURNITURE PLACEMENT MAY BE REQUIRED A:

REFER TO ARCHITECTURAL OR ENGINEER DRAWING: FOR COMPLETE AND ACCURATE DIMENSIONS OF BUILDING STRUCTURE

THESE CONTRACT DOCUMENTS AND THE INFORMATI
THEY CONTAIN ARE THE PROPERTY OF FCC COMMER

ALL PREPARED CONTRACT DOCUMENTS MAY NOT BE COPIED, REPRODUCED, USED OR IMPLEMENTED IN ANY WAY IN PART OR IN WHOLE WITHOUT THE EXPRESS

ANY UNAUTHORIZED USE OF THESE PLANS WILL RESULIN PAYMENT DUE FOR SERVICES RENDERED BY FCC COMMERCIAL FURNITURE INC.

ANY DEVIATIONS FROM THESE DRAWINGS FOR ANY REASON SHALL NOT BE DONE WITHOUT CONSENT OF FC COMMERCIAL FURNITURE INC. IN ADVANCE, IN WITHOUT FCC COMMERCIAL FURNITURE IS NOT RESPONSIBLE FOR DEVIATIONS, CHANCES, ADDITIONS, OR DELETIONS NOT REVIEWED AND APPROVED IN ADVANCE BY FCC COMMERCIAL FURNITURE INC.

HESE DOCUMENTS REFLECT SPECIFIC SEATING AND ECOR EQUIPMENT ORDERED OF DATE SHOWN BELO!

CLIENT:



Burger King 66745 Two Bunch Palms Trail Desert Hot Springs, CA 92240 Decor: Garden Grill Building Type: Custom

CUSTOMER
F & N Investments

SHEET TITLE: VERIFICATION PLAN

WORK ORDER NUMBER:

FINALS BY:

DRAWN BY:
AARON McCRAW
SCALE:

NTS

ORIGINAL DATE:

March 29, 2021

PLOT DATE:

April 5, 2021

PROJECT #: **22114-001**

ELET#:


D9.0



66745 TWO BUNCH PALMS TRL

DESERT HOT SPRINGS, CA 92240-5775

SHEET LIS	ST
SHEET NUM.	SHEET NAME
K0.0	KES COVER SHEET
K1.0	KES EQUIPMENT PLAN
K2.0	KES SCHEDULES
K3.0	KES ELEVATIONS
K4.0	KES NOTES AND DETAILS
K4.1	KES HOOD DETAILS
KE1.0	KES ELECTRICAL PLAN
KM1.0	KES MECHANICAL PLAN
KP1.0	KES PLUMBING PLAN

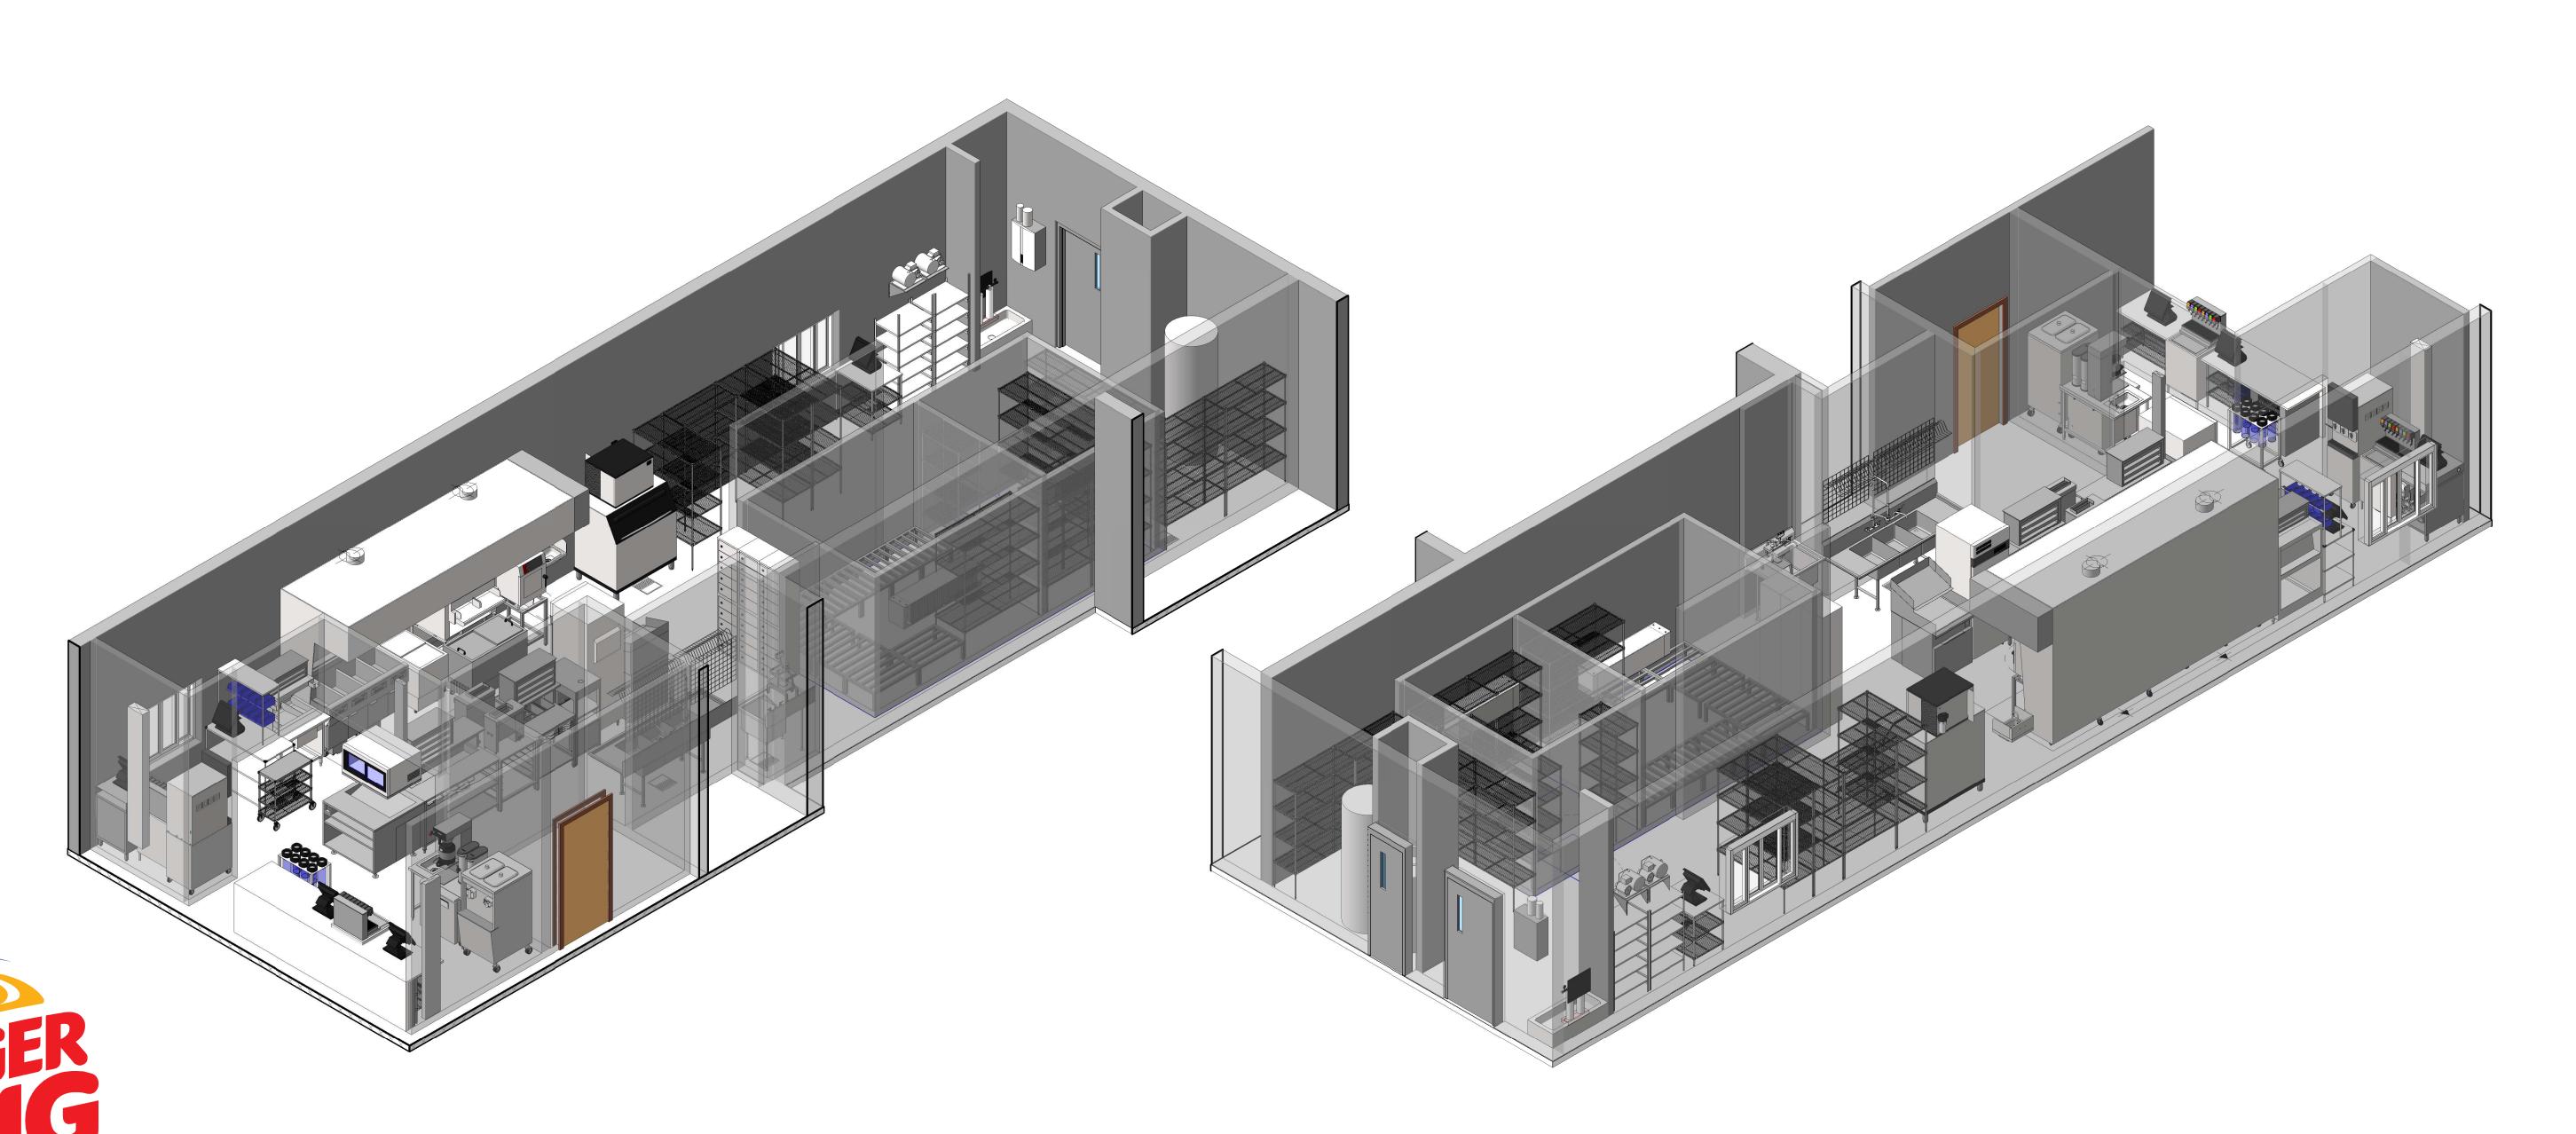

FRANKE CONT	TACT INFORMATION
MARKET MANAGER	ROBERT GERDES
EMAIL	ROBERT.GERDES@FRANKE.COM
PHONE	615-768-1203
PROJECT MANAGER	CANDACE LEATH
EMAIL	CANDACE.LEATH@FRANKE.COM
PHONE	615-462-4255



ACCOUNT **BURGER KING**

KES COVER SHEET

OPERATOR K & K Foods , Inc. 66745 TWO BUNCH PALMS TRL

DESERT HOT SPRINGS ZIP CODE 92240-5775

COUNTRY REGION
USA N. AMERICA

FREESTANDING ELECTRICAL SERVICE 208-230V/60Hz NATURAL

BUILDING TYPE

MARKET MANAGER ROBERT GERDES

FRANKE PROJECT NUMBER 1435354 FRANKE STORE NUMBER

CREATED BY

DK996 DATE ISSUED 08/20/2021

HP033 DRAWING SCALE


As Noted UNITS INCH

DRAWING NUMBER Desert Hot Spring, CA





	EQUIPMENT KEYNOTES
KEY VALUE	KEYNOTE TEXT
K1.1	WALL BACKING BY G.C.
K1.2	WALL BACKING BY G.C. SEE DETAILS ON SHEET K4- G.C. TO EXTEND BACKING BEYOND END OF EQUIPMENT, EACH SIDE.
K1.4	WALK -IN BOX REMOTE COND. UNIT ON ROOF BY G.C.(VERIFY LOCATION SEE NOTE GC7)
K1.6	GC TO MAKE CUT IN FRONT COUNTER.
K1.9	ALL P.O.S SYSTEM SUPPLIED & INSTALLED BY OWNER.

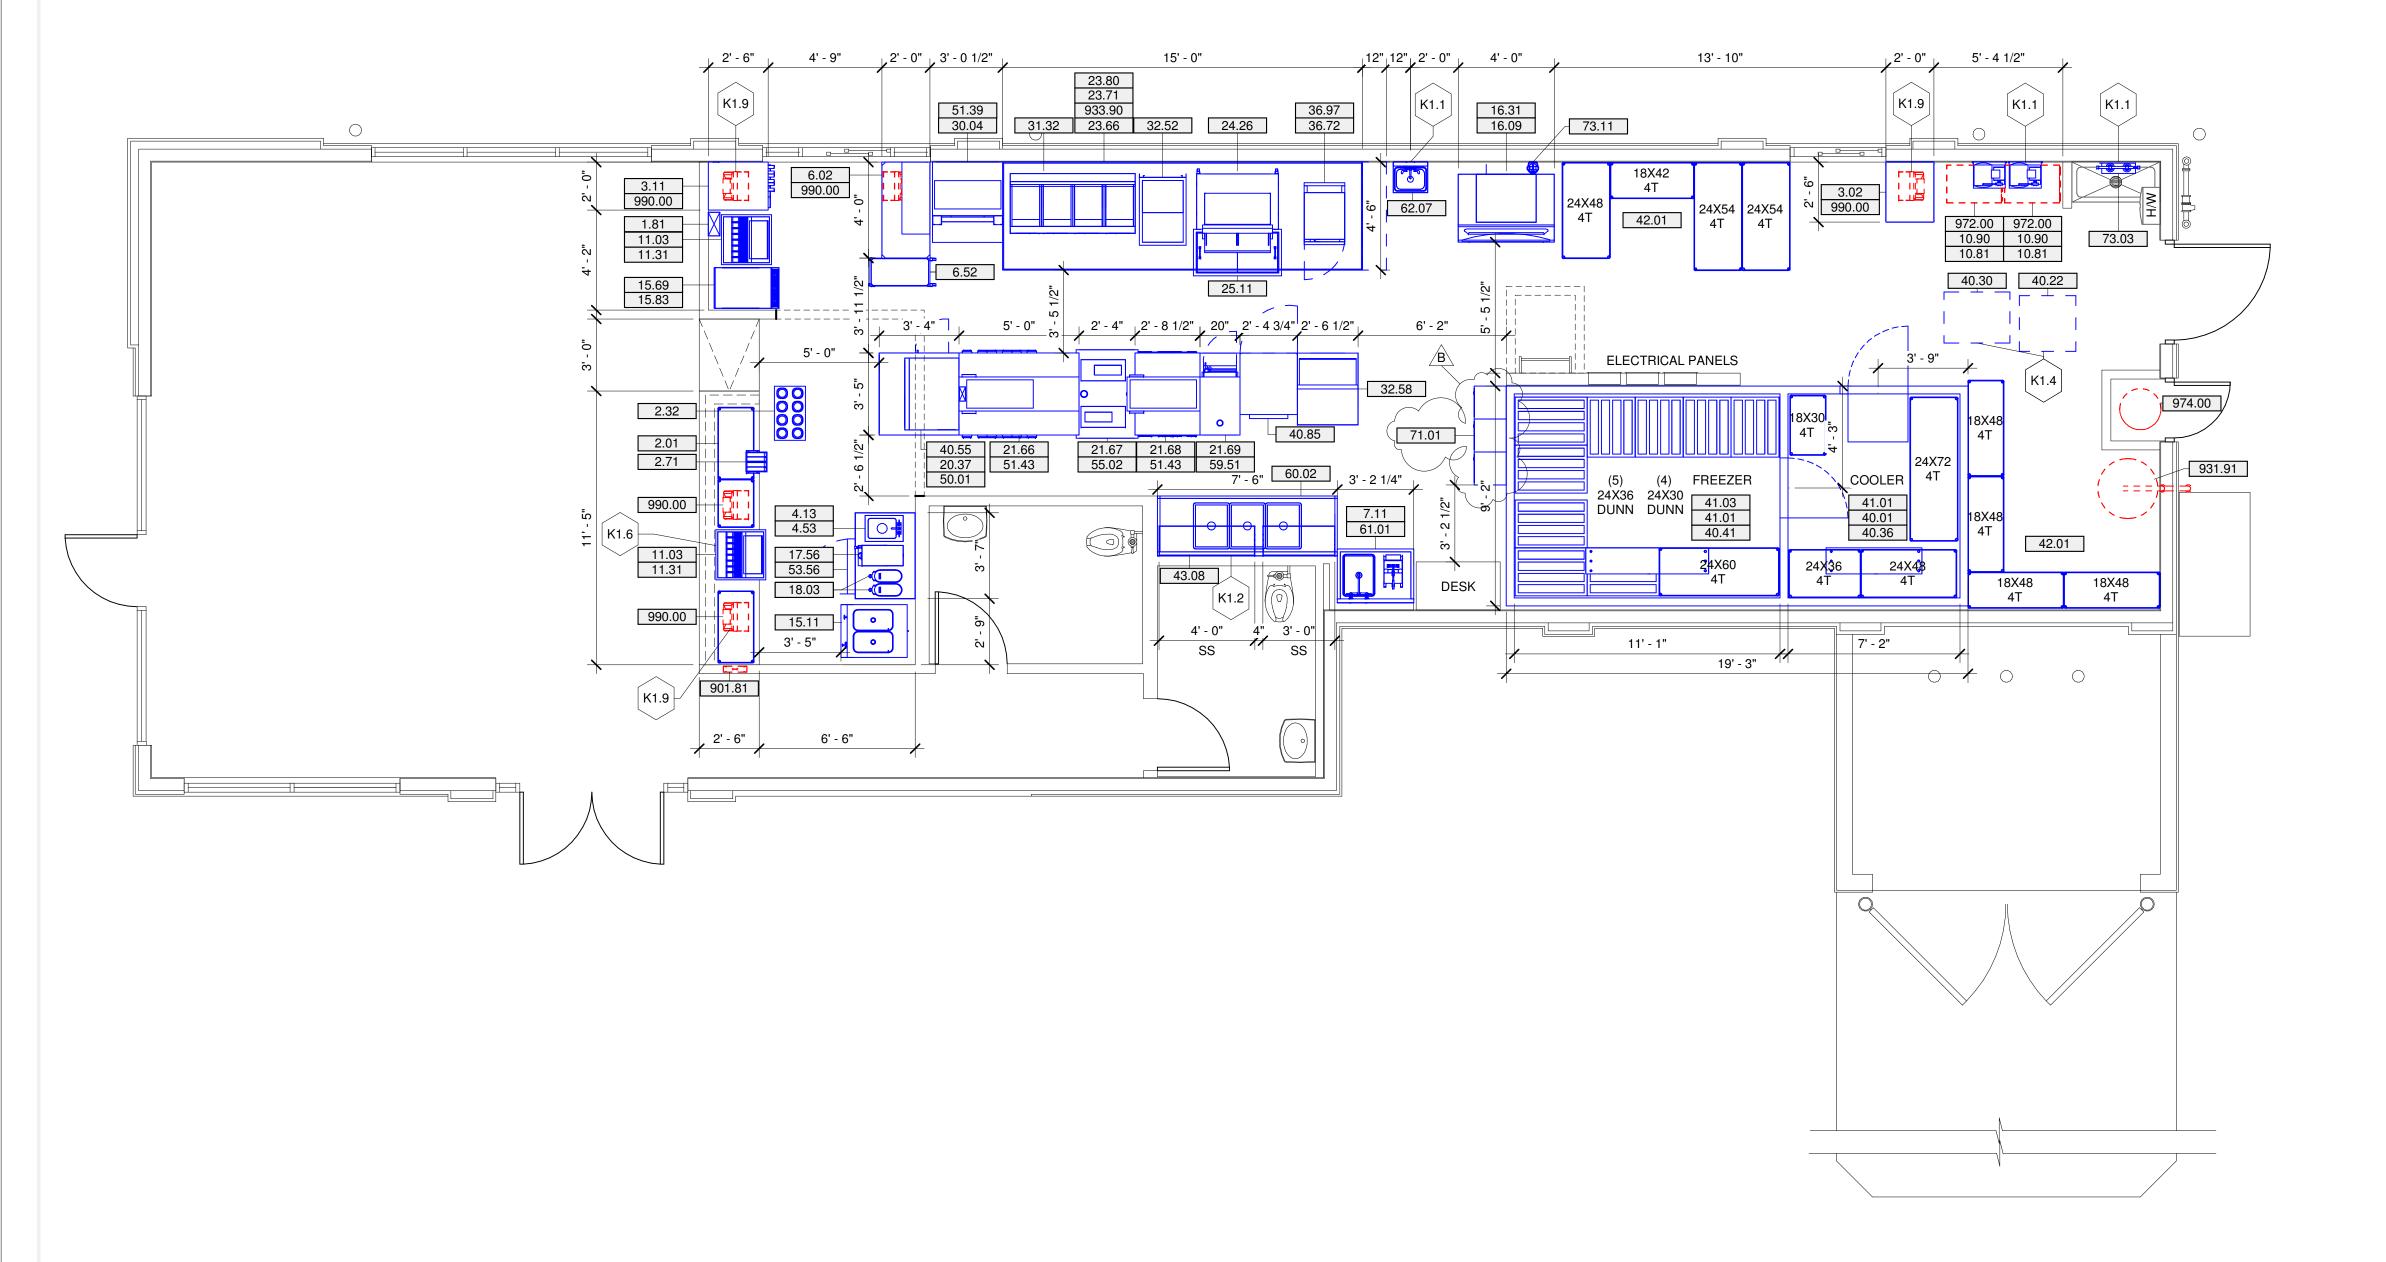

KES Equipment Plan

1/4" = 1'-0"

DRAWING NOTES

- THIS DRAWING REFLECTS THE EQUIPMENT ORDERED AS OF THE DATE SHOWN. ADDITIONS OR DELETIONS MAY BEEN MADE TO THE ORDER, AND THESE CHANGES MAY NOT BE REFLECTED IN THIS DRAWING. PLEASE CONTACT FRANKE, INC. TO ADDRESS ANY QUESTIONS OR TO CONFIRM YOUR ORDER.
- 2 ANY DEVIATIONS FROM THESE PLANS, FOR ANY REASON, SHALL NOT BE DONE WITHOUT PRIOR WRITTEN NOTIFICATION TO FRANKE FOODSERVICE SYSTEMS, INC. FRANKE FOODSERVICE SYSTEMS, INC SHALL NOT BE HELD RESPONSIBLE FOR DEVIATIONS, CHANGES, ADDITIONS OR DELETIONS NOT REVIEWED AND APPROVED IN ADVANCE BY A FRANKE REPRESENTATIVE.
- FRANKE FOODSERVICE SYSTEMS HAS PREPARED THESE PLANS AS ACCURATELY AS POSSIBLE WITH THE ARCHITECTURAL INFORMATION PROVIDED. FRANKE CANNOT BE HELD RESPONSIBLE FOR ADDITIONAL CONSTRUCTION COSTS DUE TO INACCURATE OR INCOMPLETE ARCHITECTURAL INFORMATION. ANY COSTS INCURRED DUE TO ADJUSTMENTS TO THESE PLANS BASED ON-SITE CONDITIONS, SHALL BE AT THE OWNER'S EXPENSE.
- FOR ANY KITCHEN AREAS NOT SHOWING EQUIPMENT, NO WORK IS TO BE PERFORMED IN THAT AREA UNLESS SPECIFICALLY INSTRUCTED OTHERWISE ON THESE DRAWINGS OR BY A FRANKE REPRESENTATIVE IN A WRITTEN COMMUNICATION.

GENERAL CONTRACTOR NOTES

GC1	PRIOR TO CONSTRUCTION START, IT IS RECOMMENDED THAT THE GENERAL CONTRACTOR VERIFY ALL BUILDING DIMENSIONS, EQUIPMENT PLACEMENT,
	FURNITURE PLACEMENT, & UTILITY LOCATIONS. PLEASE NOTIFY A FRANKE REPRESENTATIVE IN WRITING IF ADJUSTMENTS TO THE DRAWINGS ARE REQUIRED.

GC2 ALL WORK SHALL BE PERFORMED BY A QUALIFIED LICENSED CONTRACTOR IN ACCORDANCE WITH ALL COUNTRY, STATE, & LOCAL CODES.

GC3 ALL WORK SHALL BE COMPLETED IN A NEAT, PROFESSIONAL, & SAFE WORKMAN-LIKE MANNER.

GC4 NOTIFY FRANKE IMMEDIATELY IF COMPLIANCE WITH ANY CODES IS IN

CONFLICT WITH THESE DRAWINGS. GC5 NOTIFY FRANKE IMMEDIATELY IF THESES DRAWINGS DIFFER FROM THE

ARCHITECTURAL OR MEP DRAWINGS. THESE DRAWINGS ONLY INCLUDE THE REQUIREMENTS FOR THE ITEMS

PROVIDED BY FRANKE. REFER TO ARCHITECTURAL, STRUCTURAL, OR MEP DRAWING FOR OTHER REQUIREMENTS. G.C. SHALL PROVIDE & INSTALL PLYWOOD WALL BACKING FOR EQUIPMENT

PROVIDED BY FRANKE. G.C. TO VERIFY THE REQUIREMENTS FOR ITEMS NOT

WHERE IT IS REQUIRED.

G.C. TO DETERMINE THE LOCATION OF & SET REMOTE CONDENSERS ON ROOF.

G.C. TO PROVIDE & INSTALL EQUIPMENT STAND & PITCH PANS FOR ROOF MOUNTED CONDENSING UNITS.

G.C. SHALL PROVIDE ACCESS FOR THE EQUIPMENT TRUCK TO WITHIN 10'
(3m) OF THE BUILDING DOORS PRIOR TO THE ARRIVAL OF THE EQUIPMENT TRÚCK AT THE RESTAURANT.

GC11 BY OWNER EQUIPMENT WILL BE LISTED IN THE MAIN EQUIPMENT

SCHEDULE.

EXISTING EQUIPMENT
 DEMOLISHED EQUIPMENT
DEMOCISTICS EQUIT MEN
RELOCATED EQUIPMENT
NEW EQUIPMENT
NEW EGON WEIGH

FUTURE EQUIPMENT

B <



FRANKE

800 Aviation Parkway Smyrna, TN 37167

Tel. +800 472-2954 fs-customerservice.us@franke.com

www.frankesupply.com

© 2020 Franke Foodservice Americas, Inc.
These drawings and specifications are the property of
Franke Technology and Trademark Ltd. and shall not be
reproduced, copied or transferred to any third party
without the prior written permission of Franke
Technology and Trademark Ltd., Hergiswil, Switzerland

Exclusion of Liability:
FRANKE takes no responsibility for the accuracy of the floor plans and constructional drawings. All dimensions and connections specified by FRANKE must be checked by the client prior to installation. Specifications for power consumption and connections are limited to equipment supplied by FRANKE. All third party accessories shown lie within the responsibility of the client. FRANKE reserves the right to change equipment without notice.

ACCOUNT

BURGER KING

RESTAURANT# N/A

KES EQUIPMENT PLAN

OPERATOR

K & K Foods , Inc. SITE ADDRESS

66745 TWO BUNCH PALMS TRL

DESERT HOT SPRINGS STATE ZIP CODE

CA 92240-5775 COUNTRY REGION USA N. AMERICA

BUILDING TYPE FREESTANDING ELECTRICAL SERVICE

208-230V/60Hz GAS SERVICE NATURAL MARKET MANAGER

ROBERT GERDES FRANKE PROJECT NUMBER

1435354 FRANKE STORE NUMBER

5193384

CREATED BY DK996

DATE ISSUED 08/20/2021

MODIFIED BY HP033

DRAWING SCALE As Noted

UNITS INCH

DRAWING NUMBER Desert Hot Spring, CA



				KI	ES EQUIPMENT	SCHEDULE				
EM#	ST.	QTY.	DESCRIPTION	MANUFACTURER	MODEL#	FRANKE PART #	UL#	NSF	FURNISHED BY	REMARKS
1.81	N	1	SERVICE CHASE	FRANKE	-	18000937	-	2	FRANKE	5-3/4" x 11-3/4"- FOR SODA LINES
.01	N	6	DRY STORAGE SHELVING	SPG INTERNATIONAL	-	-	-	2	FRANKE	-
.03	N	12	UNDERCOUNTER POST	SPG INTERNATIONAL	-	-	-	2	FRANKE	NOT SHOWN
.32	N	1	MOBILE CUP DISPENSER CART	FRANKE	-	18006842	-	2	FRANKE	F/(8) CUP DISPENSERS
.71	N	1	4-COMPARTMENT CONDIMENT BIN HOLDER	FRANKE	-	18000982	-	2	FRANKE	-
.88	N	1	EXTREME COUNTERTOP DISPENSER	SERVER PRODUCTS	ECD 07500	620754	-	-	FRANKE	
.02	N	1	DRIVE THRU COUNTER	INTERMETRO	2430FS	70002920	-	-	FRANKE	(2) SHELVES, (4) POSTS
.11	N	1	24"W x 30"D DRIVE THRU TABLE W/CUP DISPENSER	FRANKE	-	18005294	-	2	FRANKE	
.13	N	1	DRIVE THRU TABLE W/ HAND SINK	FRANKE	18006428	FS01505	-	2	FRANKE	•
.53	N	1	DROP-IN-SINK	ADVANCE TABCO	DI-1-5	19000444	-	2	FRANKE	•
.02	N	1	DRIVE THRU WORKSTATION	INTERMETRO	BKROC2448DT	70000517BK	-	2	FRANKE	-
.52	N	1	14" X 30" ORDER ASSEMBLY CART	INTERMETRO	BKBC1430	70004322	-	-	FRANKE	-
.11	N	1	SLICER, SABER KING	PRINCE CASTLE, INC.	980-000-00	622928	-	2	FRANKE	-
0.81	N	2	CARBONATOR	LANCER	85-1923-00	617544	UL403	2	FRANKE	SEE DETAIL ON K4.0
0.90	N	2	SHELF CARBONATOR F/ LANCER	LANCER	82-3876	822999	-	2	FRANKE	-
1.03	N	2	ICE/SODA DISPENSER	LANCER	85-2378T-124	852378T124	-	18	FRANKE	-
.31	N	2	ICE/SODA CONVERSION STAND	LANCER	84-0058	840058		2	FRANKE	•
5.11	N	1	COMBINATION FREEZER	TAYLOR	632D	620916	SA2650	6	FRANKE	•
5.69	N	1	FROZEN BEVERAGE DISPENSER	FBD	12-7361-0010	624559	-	2	FRANKE	-
5.83	N	1	FROZEN BEVERAGE DISPENSER CART	FBD	12-2516-0003	621552	-	2	FRANKE	PRE-PLUMBED
6.09	N	1	ICE MACHINE	MANITOWOC	IYT0750A-261	624679	-	12	FRANKE	-
3.31	N	1	ICE STORAGE BIN	MANITOWOC	D970	616546-1	-	2	FRANKE	970LB [323 KG] ICE BIN F/ S300-S2170C SERIES ICE MACHINES
7.56	N	1	INFUSION TEA COFFEE BREWER	BUNN-O-MATIC	ITCB-DV	622290	-	2	FRANKE	•
3.03	N	2	ICED TEA DISPENSER - SLIM	BUNN-O-MATIC		619935		-	FRANKE	•
).37	N	1	41" EXPEDITER STATION STD FLOW	FRANKE	EXPO5	18016254	E163328	2	FRANKE	-
1.66	N	1	60" PREP MODULE "A" - (ABCD/ACBD)	FRANKE	-	18015498	-	2	FRANKE	•
.67	N	1	28" BUN TOASTER MODULE "B"	FRANKE	-	18008869	-	2	FRANKE	•
.68	N	1	32.5" PREP MODULE "C"	FRANKE	-	18011951	-	2	FRANKE	-
.69	N	1	20" PREP MODULE "D"	FRANKE	-	18011954	-	2	FRANKE	·
3.66	N	1	180" CANOPY HOOD	FRANKE	5424 FR-ND-2	CUSTOM	UL710	2	FRANKE	REFER TO DETAIL SHEET K4.1 FOR INSTALLATION OF HOOD & COMPONENTS
3.71	N	1	EXHAUST FAN	FRANKE	FR-USBI-18DD-RM	CUSTOM	UL 762	2	FRANKE	-
3.80	N	1	ROOF CURB	FRANKE	KEF-1	CUSTOM	-	2	FRANKE	ROOF CURB FOR CANOPY HOOD
1.26	N	1	BROILER	NIECO	JF93G	624882	-	4	FRANKE	-
5.11	N	1	44" MEAT WELL FREEZER	FRANKE	-	18004826	-	2	FRANKE	
0.04	N	1	35" FRY STATION - ROC GEN 3.5 LH	FRANKE	-	18015141	-	4	FRANKE	
.32	N	1	4-BANK FRYER	FRYMASTER	FPGL430CASC	70005105	-	4	FRANKE	-
.89	N	1	PORTABLE FILTER	FRYMASTER	MF-90U/80BK	614708	-	2	FRANKE	NOT SHOWN
2.52	N	1	PRODUCT HOLDING FREEZER	FRANKE	-	18007216	-	7	FRANKE	W/ PORTION PAN & FRY RACK
2.58	N	1	REFRIGERATED BATTER STATION	H&K	52976	626544	-	7	FRANKE	•
5.72	N	1	MINI COMBI OVEN-STEAMER	BLODGETT	BLCT-6E	626513	-	4	FRANKE	-
5.97	N	1	COMBI OVEN STAND	BLODGETT	62648	70008609-1	-	2	FRANKE	-
0.01	N	1	WALK-IN COOLER/FREEZER BOX	ICS	-	-	-	7	FRANKE	SEE DETAIL ON K4
).22	N	1	WALK-IN COOLER CONDENSING UNIT	ICS	RFO080M4SDAALNTQC8	-	-	7	FRANKE	-
0.30	N	1	WALK-IN FREEZER CONDENSING UNIT	ICS	RFO300L4SEANTQC8	-	-	7	FRANKE	•
).36	N	1	WALK-IN COOLER EVAPORATOR	ICS	RL6A066ADAREQC	-	-	7	FRANKE	•
).41	N	1	WALK-IN FREEZER EVAPORATOR	ICS	RFO300L4SEANTQC8	-	-	7	FRANKE	-
.55	N	1	BEVERAGE REFRIGERATOR	H&K	52614-1	624179	-	7	FRANKE	-
.85	N	1	REACH-IN FREEZER	TURBO AIR	M3F24-2-N-L	624280-1	-	7	FRANKE	
.01	N	20	COLD STORAGE SHELVING	SPG INTERNATIONAL	-	-	-	2	FRANKE	• ·
.03	N	9	RACK DUNNAGE - COLD	NEW AGE	-	-	-	2	FRANKE	•
2.01	N	32	DRY STORAGE SHELVING	SPG INTERNATIONAL	-	-	-	2	FRANKE	-
2.10	N	52	POST	SPG INTERNATIONAL	-	70000102BK	-	2	FRANKE	NOT SHOWN
8.08	N	1	DOUBLE SMARTWALL SHELVING	SPG INTERNATIONAL	WST1692E	622719	-	3	FRANKE	SEE DETAIL ON K4
0.01	N	2	MICROWAVE OVEN	ACP	HDC18SD2	614701	-	2	FRANKE	
.39	N	1	MULTI-PRODUCT HOLDING UNIT	PRINCE CASTLE	EHB24	625025	-	4	FRANKE	
.43	N	2	MULTI-PRODUCT HOLDING UNIT	PRINCE CASTLE	EHB34A-2	625033-1	-	4	FRANKE	-
3.56	N	1	REACH-IN UNDERCOUNTER REFRIGERATOR - RH DOOR	TURBO AIR	TUR-28SD-N	624282	-	7	FRANKE	-
5.02	N	2	RAPID VERTICAL TOASTER	ANTUNES	BKT-2V	624462	-	4	FRANKE	
).51	N	1	EGG COOKER	A.J. ANTUNES & CO.	ES-1200	620840-1	E49407	4	FRANKE	-
.02	N	1	3 COMPARTMENT SINK	FRANKE	-	M1334	-	2	FRANKE	-
.01	N	1	ONE COMPARTMENT SINK W/ LH DRAINBOARD	FRANKE	-	18008341	-	2	FRANKE	-
2.07	N	1	HAND SINK	ADVANCE TABCO	7-PS-66-1X	70005004	-	2	FRANKE	-
0.07	N	1	SAFE	1st SAFES	BFD-3020-LO1-L22	70006855	-	2	FRANKE	NOT SHOWN
.01	N	3	LOCKER	PENCO PRODUCTS	EL/10/S/GRAY (GRAY)	EL 10	-	-	FRANKE	• · · · · · · · · · · · · · · · · · · ·
3.03	N	1	WATER FILTER	SELECTO INC	IC620-2	620886	-	2	FRANKE	SEE DETAIL ON K4
3.11	N	1	FILTER FEEDER SCALE INHIBITOR	EVERPURE	SR-X	70002482	-	2	FRANKE	-
1.81	R	1	SERVICE CHASE	VERIFY	VERIFY	VERIFY	-	-	OTHERS	VERIFY W/ OWNER
1.91	R	1	SHORTENING DISPOSAL CADDY SYSTEM	VERIFY	VERIFY	VERIFY	_	-	OTHERS	VERIFY W/ OWNER
3.90	R	1	FIRE PROTECTION SYSTEM	VERIFY	VERIFY	VERIFY	-	_	OTHERS	VERIFY W/ OWNER
2.00	R	2	BAG-N-BOX SYRUP RACK	VERIFY	VERIFY	VERIFY	_	_	OTHERS	VERIFY W/ OWNER
4.00	R	1	CO2 BULK SYSTEM	VERIFY	VERIFY	VERIFY	_	_	OTHERS	VERIFY W/ OWNER
1.00	11	_	P.O.S. SYSTEM	VERIFY	VERIFY	VERIFY			OTHERS	VERIFY W/ OWNER

100 C						I	KES ELI	ECTRI	CAL SCHE	DULE				
10.0 L 2	ITEM#	TAG#	QTY	DESCRIPTION	VOLTS	PH	CYCLE	HP	BRKR SIZE	AMPS	ELEC CONN TYPE	PLUG TYPE		ELECTRICAL REMARKS
1.53 P	10.81	E1	2	CARBONATOR	120 V	1	60 Hz	1/3	20.00 A	6.20 A	PLUG & CORD	NEMA 5-20P	78"	ADDITIONAL ELECTRICAL OUTLETS TO BE PLACED 86" & 94" A.F.F. SEE DETAIL ON K4.0
10.11 E1	11.03	E1	1	ICE/SODA DISPENSER	115 V	1	60 Hz	-	20.00 A	5.00 A	PLUG & CORD	NEMA 5-20P	48"	
1511 E2 1 COMMINION PRECEDED 2009 3 6014 112 2008 1500A PUBBS CORD 1504BBS 12 E.C. TO SIMPLY & RETAILED FOR PAUL PAUL PAUL PAUL PAUL PAUL PAUL PAUL	11.03	E2	1	ICE/SODA DISPENSER	115 V	1	60 Hz	-	20.00 A	5.00 A	PLUG & CORD	NEMA 5-20P	24"	
1	15.11	E1	1	COMBINATION FREEZER	208 V	3	60 Hz	1	20.00 A	14.00 A	PLUG & CORD		12"	E.C. TO SUPPLY & INSTALL 6FT. CORD & PLUG
1090 CI 1 RELMONINE 2007 1 601½ - 1500Å 110Å DIRECT WIRED DIRECT 847 1756 FI 1 BAUSSET IN ECORPHER STATION STID FLOW 1917 1 601½ - 2000Å 1600Å PUIGA CORD NEARA 9.09 0" CORNECTS INTO RESPETACE ON IMPRINGULE "A" 1 1 1 1 1 1 1 1 1	15.11	E2	1	COMBINATION FREEZER	208 V	3	60 Hz	1 1/2	20.00 A	15.00 A	PLUG & CORD		12"	E.C. TO SUPPLY & INSTALL 6FT. CORD & PLUG
1.50	15.69	E1	1	FROZEN BEVERAGE DISPENSER	208 V	1	60 Hz	1/4	30.00 A	30.00 A	PLUG & CORD	NEMA L6-30P	36"	BEATER: (3)1/6 HP FAN: 1/4 HP
1.50	16.09	E1	1	ICE MACHINE	208 V	1	60 Hz	-		11.10 A	DIRECT WIRED		84"	-
20.27 E1	17.56	E1	1	INFUSION TEA COFFEE BREWER	120 V	1	60 Hz	-	20.00 A	14.00 A	PLUG & CORD		24"	-
21.56 E1		E1	1	41" EXPEDITER STATION STD FLOW	120 V	1		-						CONNECTS INTO RECEPTACLE ON PREP MODULE "A" VIA 6' POWER CORD
21.68 E1 1 25.5*PREP MODULE "O" CONNECTS TO LOAD CENTER ON PREP MODULE "A" E. C. TO CONNECTS TO LOAD CENTER ON PREP MODULE	21.66	E1	1		208 V	3	60 Hz		0.00 A	1.08 A	DIRECT WIRED	DIRECT	0"	DOWN THRU SERVICE CHASE; E.C. TO CONNECT TO LOAD CENTER PROVIDED, AS REQ'D FOR 150A- 5 WIRE W/106A FEEDER. AMPERAGE LOAD FOR LOAD CENTER IN THIS CABINET TO BE CALCULATED FROM COMBINED
21.69	21.67	E1	1	28" BUN TOASTER MODULE "B"										CONNECTS TO LOAD CENTER ON PREP MODULE "A"
EL TO COMMENT DUTLITY CARMINETS LECTRICAL SYSTEM ON ROOD PHODOS COMPONENTS & LECTRICAL SYSTEM ON ROOM FROM ROOM RO	21.68	E1	1	32.5" PREP MODULE "C"										CONNECTS TO LOAD CENTER ON PREP MODULE "A"
23.71 E1 1 BROCANOPY HOOD 23.71 E1 1 BROLER 200 3 60 Hz 2 2 200 A 8.30 A DIRECT WIRED REFER TO DETAIL SHEET HIS CRITICAL MICHOR OF HOOD'S COMPONENTS A LIGHT FOR THE PROPERTY AND COMPONENTS AND COMPON	21.69	E1	1	20" PREP MODULE "D"										CONNECTS TO LOAD CENTER ON PREP MODULE "A"
23.71 E1 1 EXHAUSTEAN 288 V 3 80 Hz 2 20.00 A 8.30 A DIRECT WIRED REARING 12° AT BUILDINSS MAN BRAKER PANEL CONNECTION FEMALES. 24.26 E1 1 BROLLER 120 V 1 80 Hz - 20.00 A 3.50 A PLUG & CORD NEMA 5-19° 24° HEIGH 2° B.F.R. 30.04 E1 1 44*MEAT WELL FREEZER 120 V 1 80 Hz - 20.00 A 7.60 A PLUG & CORD NEMA 5-19° 24° —	23.66	E1	1	180" CANOPY HOOD										SYSTEM ON HOOD F/ HOOD'S COMPONENTS & LIGHTS. REFER TO DETAIL SHEET K4.1 FOR INSTALLATION OF
25.11 E1	23.71	E1	1	EXHAUST FAN	208 V	3	60 Hz	2	20.00 A	8.30 A	DIRECT WIRED		12"	
30.04 E1	24.26	E1	1	BROILER	120 V	1	60 Hz	-	20.00 A	3.50 A	PLUG & CORD	NEMA 5-20P	24"	
S1322	25.11	E1	1	44" MEAT WELL FREEZER	120 V	1	60 Hz	-	20.00 A	7.60 A	PLUG & CORD	NEMA 5-15P	24"	-
31.89	30.04	E1	1	35" FRY STATION - ROC GEN 3.5 LH	208 V	1	60 Hz	-	20.00 A	16.00 A	PLUG & CORD	NEMA L14-20P	24"	-


32.58 E1		F1	1		-	1		-					24"	-
36.72		F1	1		-	1		-					0"	










	59.51	E1	1	EGG COOKER	208 V	1	60 Hz	-	20.00 A	11.40 A	PLUG & CORD	NEMA L6-20P	0"	
TIEGOTI LES	931.91	E1	1	SHORTENING DISPOSAL CADDY SYSTEM	0 V	0	60 Hz	-	0.00 A	0.00 A	-	-	0"	VERIFY AND REWORK ALL EXISTING UTILITIES AS REQUIRED

	KES PLUMBING POTABLE WATER SCHEDULE													
ITEM#	Tag #	QTY.	DESCRIPTION	CW SIZE	CW RI HGHT	HW SIZE	HW RI HGHT	FW TYPE	FW SIZE	FW RI HGHT	POT. WATER CONN TYPE	POT. WATER REMARKS		
4.53	P1	1	DROP-IN-SINK	1/2"	18"	1/2"	18"				VIA SHUT OFF VALVE ON WALL	-		
10.81	P1	2	CARBONATOR					FILTERED	3/8"	60"	MALE FLARE	P.C. TO RUN WATER THRU WATER FILTER.		
11.03	P1	2	ICE/SODA DISPENSER					FILTERED	3/8"	18"	MALE BARB	P.C. TO RUN WATER THRU SODA LINES (NOT SHOWN)		
15.69	P1	1	FROZEN BEVERAGE DISPENSER					FILTER	3/8"	36"	MALE FLARE	P.C. TO RUN WATER THRU WATER FILTER AND SODA LINES		
16.09	P1	1	ICE MACHINE					SCALE INHIBITOR	3/8"	48"	FPT	P.C. TO RUN WATER THRU WATER FILTER.		
17.56	P1	1	INFUSION TEA COFFEE BREWER					FILTERED	1/4"	48"	MALE BARB	P.C. TO RUN WATER THRU WATER FILTER		
36.72	P1	1	MINI COMBI OVEN-STEAMER					FILTERED	3/4"	12"	GHT	P.C. TO RUN WATER LINES THRU WATER FILTER.		
60.02	P1	1	3 COMPARTMENT SINK	1/2"	12"	1/2"	12"				VIA SHUT OFF VALVE ON WALL	VERIFY REQ'MTS W/LOCAL CODES		
61.01	P1	1	ONE COMPARTMENT SINK W/ LH DRAINBOARD	1/2"	12"	1/2"	12"				VIA SHUT OFF VALVE ON WALL	VERIFY REQ'MTS W/LOCAL CODES		
62.07	P1	1	HAND SINK	1/2"	12"	1/2"	12"				VIA SHUT OFF VALVE ON WALL	-		
73.03	P1	1	WATER FILTER	3/4"	84"						FNPT	SEE DETAIL ON K4		
73.11	P1	1	FILTER FEEDER SCALE INHIBITOR					FILTER	3/4"	48"	FNPT	P.C. TO RUN WATER THRU WATER FILTER AND CONNECT TO Eco3ICE AS REQ'D.		

	KES MECHANICAL SCHEDULE										
ITEM#	TAG#	QTY.	DESCRIPTION	HOOD LENGTH	FILTER AREA	FILTER QUANTITY/SIZE	EXHAUST ACTUAL	DUCT SIZE	DUCT VELOCITY	STATIC PRESSURE	MECHANICAL REMARKS
23.66	M1	1	180" CANOPY HOOD	180"	19.55 SF	(11)CP-1616	2475 CFM	12"	2258 FPM	0.48 in-wg	FAN SPECS: 2475 CFM @ 2.0"SP. REFER TO DETAIL SHEET K4.1 FOR INSTALLATION OF HOOD & COMPONENTS

	KES PLUMBING WASTE SCHEDULE													
ITEM#	TAG#	QTY.	DESCRIPTION	DIRECT WASTE SIZE	DIRECT WASTE RI HGHT	INDIRECT WASTE SIZE	INDIRECT WASTE CONN HGHT	WASTE CONNECTION TYPE	WASTE REMARKS	(
4.53	P1	1	DROP-IN-SINK	2"	18"			DIRECT	-					
11.03	P1	2	ICE/SODA DISPENSER			3/4"	0"	INDIRECT	P.C. TO EXTEND DRAIN TO FLOOR SINK					
16.09	P1	1	ICE MACHINE			1/2"	0"	INDIRECT	P.C EXTEND DRAIN TO FLOOR SINK	_ (
16.31	P1	1	ICE STORAGE BIN			3/4"	0"	INDIRECT	P.C. TO EXTEND DRAIN TO FLOOR SINK					
36.72	P1	1	MINI COMBI OVEN-STEAMER			2"	0"	INDIRECT	P.C. TO EXTEND DRAIN LINE TO FLOOR DRAIN. DRAIN LINE MUST BE VENTED	E				
40.36	P1	1	WALK-IN COOLER EVAPORATOR			3"	3"	HUB	P.C. TO EXTEND DRAIN TO 3" HUB DRAIN	ŀ				
40.41	P1	1	WALK-IN FREEZER EVAPORATOR			3/4"	3"	HUB	P.C. TO EXTEND DRAIN TO 3" HUB DRAIN	E				
60.02	P1	1	3 COMPARTMENT SINK			2"	0"	INDIRECT	VERIFY REQ'MTS W/LOCAL CODES	2				
61.01	P1	1	ONE COMPARTMENT SINK W/ LH DRAINBOARD			2"	0"	INDIRECT	VERIFY REQ'MTS W/LOCAL CODES	_				
62.07	P1	1	HAND SINK	1/2"	12"			DIRECT	•	C				
931.91	P1	1	SHORTENING DISPOSAL CADDY SYSTEM	0"	0"			-	VERIFY AND REWORK ALL EXISTING UTILITIES AS REQUIRED	1				

				KE	S PLUMBIN	IG GAS SCH	EDULE			
ITEM#	TAG#	QTY.	DESCRIPTION	GAS INPUT	GAS SIZE	GAS TYPE	CO2 SIZE	CO2 RI HGHT	CO2 CONN TYPE	GAS REMARKS
10.81	P1	2	CARBONATOR				1/4"	60"	MALE FLARE	-
15.69	P1	1	FROZEN BEVERAGE DISPENSER				1/4"	36"	MALE FLARE	<u>.</u>
24.26	P1	1	BROILER	58000.0 Btu/h	3/4"	NG				P.C. TO CONNECT TO BROILER, AS REQ'D
31.32	P1	1	4-BANK FRYER	300000.0 Btu/h	1"	NG				P.C. TO CONNECT TO FRYERS AS REQ'D.

			KES PLUMB	BING MISCELLANEOUS SCHEDULE		DA 08
ITEM#	TAG #	QTY.	DESCRIPTION	MISC PLUMBING	MISC PLUMBING REMARKS	UO
15.69	P1	1	FROZEN BEVERAGE DISPENSER	2 (1/4")	2 MALE FLARE LINES FOR SYRUP	MC
15.83	P1	1	FROZEN BEVERAGE DISPENSER CART	· ·	NOT SHOWN; PRE-PLUMBED, SODA SUPPLIER TO MAKE ALL CONNECTIONS AS REQ'D	HF

B 08/20/2021 MOVED DRAIN, CHANGE HUB, ADDED LOCKERS HPC
A 04/08/2021 MOVED DRAIN, CHANGE HUB, ADDED LOCKERS HPC
A 04/08/2021 DATE DESCRIPTION BY





800 Aviation Parkway Smyrna, TN 37167 Tel. +800 472-2954 fs-customerservice.us@franke.com www.frankesupply.com

© 2020 Franke Foodservice Americas, Inc.
These drawings and specifications are the property of Franke Technology and Trademark Ltd. and shall not be reproduced, copied or transferred to any third party without the prior written permission of Franke Technology and Trademark Ltd., Hergiswil, Switzerland Exclusion of Liability:
FRANKE takes no responsibility for the accuracy of the floor plans and constructional drawings. All dimensions and connections specified by FRANKE must be checked by the client prior to installation. Specifications for power

consumption and connections are limited to equipment supplied by FRANKE. All third party accessories shown lie within the responsibility of the client. FRANKE reserves the right to change equipment without notice.

BURGER KING

RESTAURANT # N/A

OPERATOR
K & K Foods , Inc.

66745 TWO BUNCH PALMS TRL
CITY
DESERT HOT SPRINGS

SITE ADDRESS

BUILDING TYPE

STATE ZIP CODE
CA 92240-5775

COUNTRY REGION
N. AMERICA

FREESTANDING

ELECTRICAL SERVICE

208-230V/60Hz

GAS SERVICE

NATURAL

MARKET MANAGER

ROBERT GERDES

FRANKE PROJECT NUMBER
1435354
FRANKE STORE NUMBER
5193384

CREATED BY DK996


DATE ISSUED
08/20/2021
MODIFIED BY

MODIFIED BY
HP033
DRAWING SCALE
AS Noted

UNITS
INCH
DRAWING NUMBER


Desert Hot Spring, CA
SHEET NAME



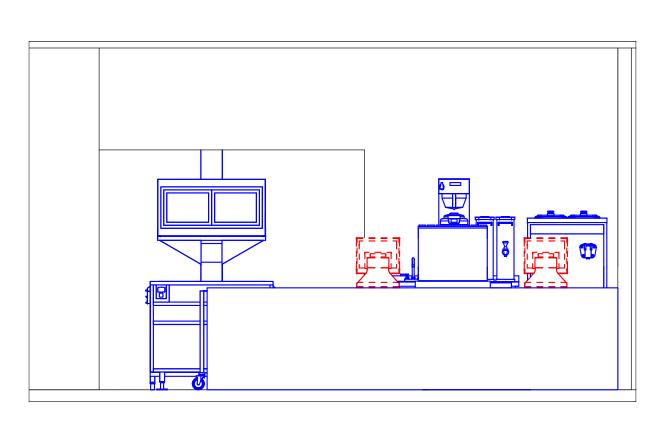


FRONT COUNTER CUSTOMER VIEW ELEVATION

FRONT COUNTER CUSTOMER VIEW ELEVA'
3/8" = 1'-0"

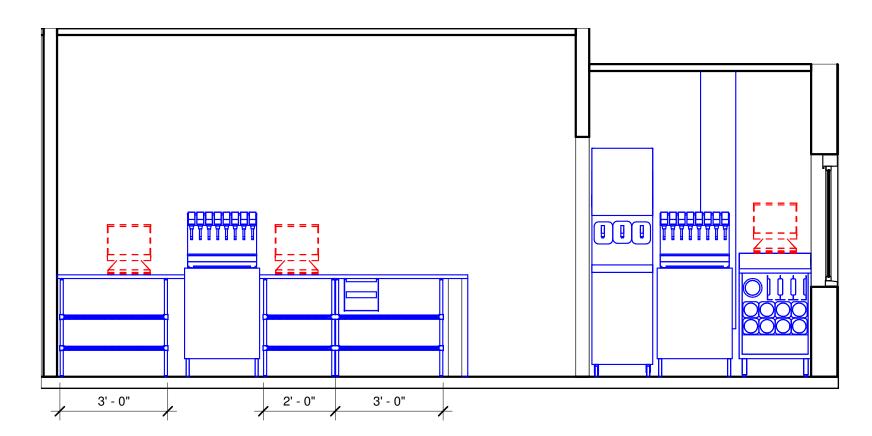


PRONT COUNTER CREW VIEW/DT ELEVATION


3/8" = 1'-0"

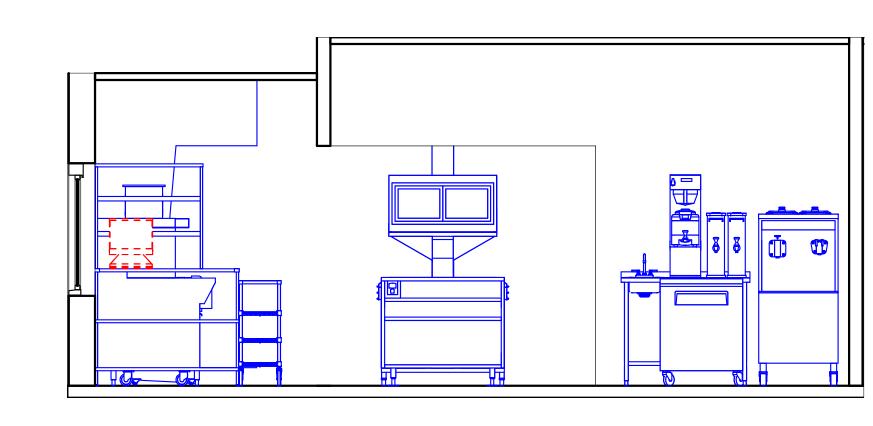

3 DT/EXPO ELEVATION 3/8" = 1'-0"

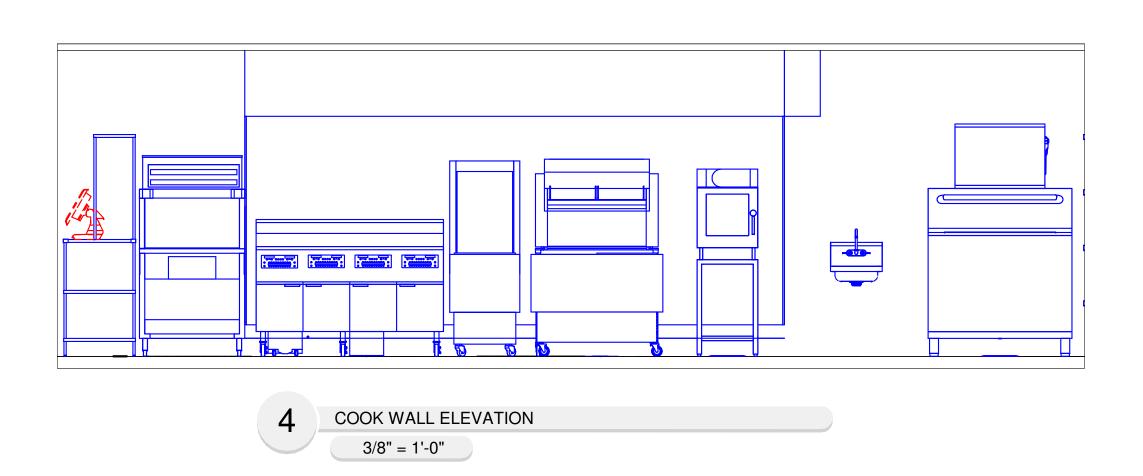


5 MAINBOARD ELEVATION
3/8" = 1'-0"

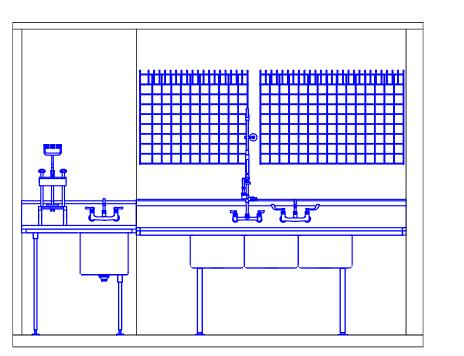

SCULLERY WALL ELEVATION

3/8" = 1'-0"

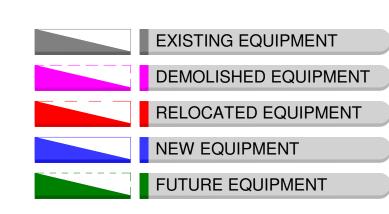

Make Wonderful

FR AN KE

800 Aviation Parkway
Smyrna, TN 37167

Tel. +800 472-2954

fs-customerservice.us@franke.com
www.frankesupply.com

© 2020 Franke Foodservice Americas, Inc.
These drawings and specifications are the property of
Franke Technology and Trademark Ltd. and shall not be
reproduced, copied or transferred to any third party
without the prior written permission of Franke
Technology and Trademark Ltd., Hergiswil, Switzerland
Exclusion of Liability:
FRANKE takes no responsibility for the accuracy of the
floor plans and constructional drawings. All dimensions
and connections specified by FRANKE must be checked
by the client prior to installation. Specifications for power
consumption and connections are limited to equipment
supplied by FRANKE. All third party accessories shown
lie within the responsibility of the client. FRANKE
reserves the right to change equipment without notice.

BURGER KING

RESTAURANT #
N/A
TITLE

OPERATOR
K & K Foods , Inc.

SITE ADDRESS
66745 TWO BUNCH PALMS TRL
CITY
DESERT HOT SPRINGS

USA N. AMERICA

STATE ZIP CODE
CA 92240-5775

COUNTRY REGION

BUILDING TYPE
FREESTANDING
ELECTRICAL SERVICE
208-230V/60Hz
GAS SERVICE

NATURAL

MARKET MANAGER

ROBERT GERDES

FRANKE PROJECT NUMBE

FRANKE PROJECT NUMBER
1435354
FRANKE STORE NUMBER
5193384

CREATED BY
DK996

DATE ISSUED

08/20/2021

MODIFIED BY
HP033

HP033

DRAWING SCALE
AS Noted


UNITS
INCH
DRAWING NUMBER

Desert Hot Spring, CA

SHEET NAME


K3.0



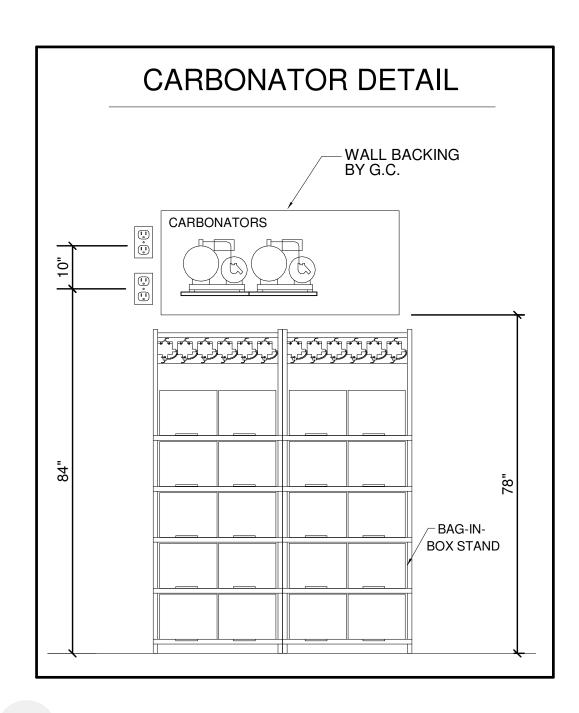


CARBONATOR DETAIL

NTS

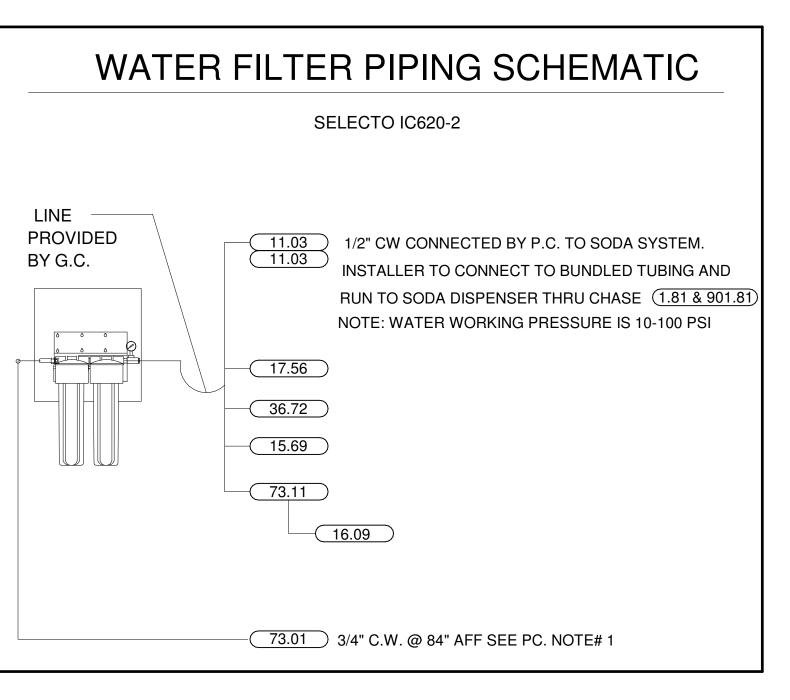

WATER FILTER IC620-2 DETAIL

NTS

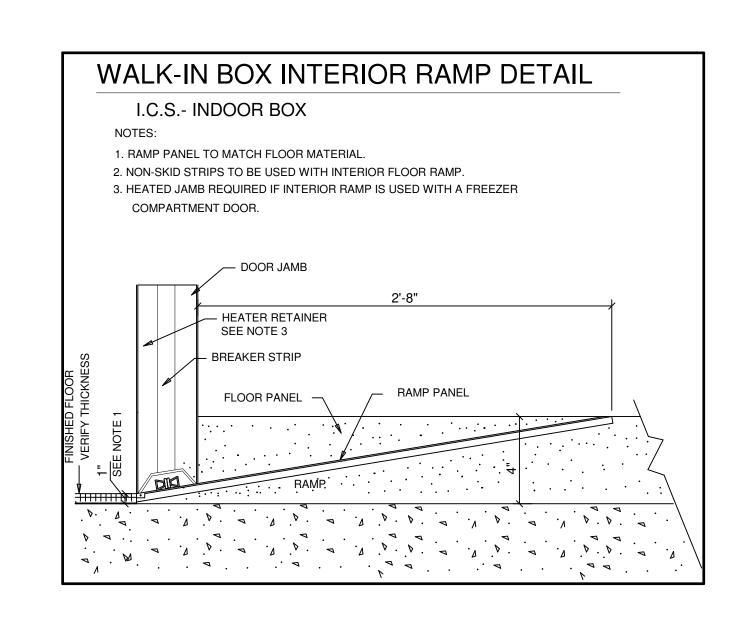

2 WALK-IN-BOX INTERIOR RAMP DETAIL

30" X 48"
GRID

WOOD
BACKING

FINISHED
FLOOR

WOOD BACKING DETAIL 'B'

NTS

/2021 MOVED DRAIN, CHANGE HUB, ADDED LOCKERS HPO.
/2021 INITIAL ISSUE DESCRIPTION BY

B 08/2
A 04/0
(REV D



FR AN KE

800 Aviation Parkway Smyrna, TN 37167 Tel. +800 472-2954

fs-customerservice.us@franke.com
www.frankesupply.com

© 2020 Franke Foodservice Americas, Inc.
These drawings and specifications are the prope

© 2020 Franke Foodservice Americas, Inc.
These drawings and specifications are the property of
Franke Technology and Trademark Ltd. and shall not be
reproduced, copied or transferred to any third party
without the prior written permission of Franke
Technology and Trademark Ltd., Hergiswil, Switzerland
Exclusion of Liability:
FRANKE takes no responsibility for the accuracy of the
floor plans and constructional drawings. All dimensions
and connections specified by FRANKE must be checked
by the client prior to installation. Specifications for power
consumption and connections are limited to equipment
supplied by FRANKE. All third party accessories shown
lie within the responsibility of the client. FRANKE
reserves the right to change equipment without notice.

BURGER KING

RESTAURANT #

TITLE
KES NOTES AND DETAILS

OPERATOR
K & K Foods , Inc.
SITE ADDRESS
66745 TWO BUNCH PALMS TRL

CITY
DESERT HOT SPRINGS
STATE ZIP CODE

CA 92240-5775

COUNTRY REGION
N. AMERICA

FREESTANDING
ELECTRICAL SERVICE
208-230V/60Hz
GAS SERVICE

BUILDING TYPE

NATURAL
MARKET MANAGER
ROBERT GERDES

FRANKE PROJECT NUMBER 1435354

FRANKE STORE NUMBER 5193384

DK996

DATE ISSUED

DATE ISSUED 08/20/2021

MODIFIED BY HP033


DRAWING SCALE
As Noted

UNITS
INCH
DRAWING NUMBER

Desert Hot Spring, CA

K4.0




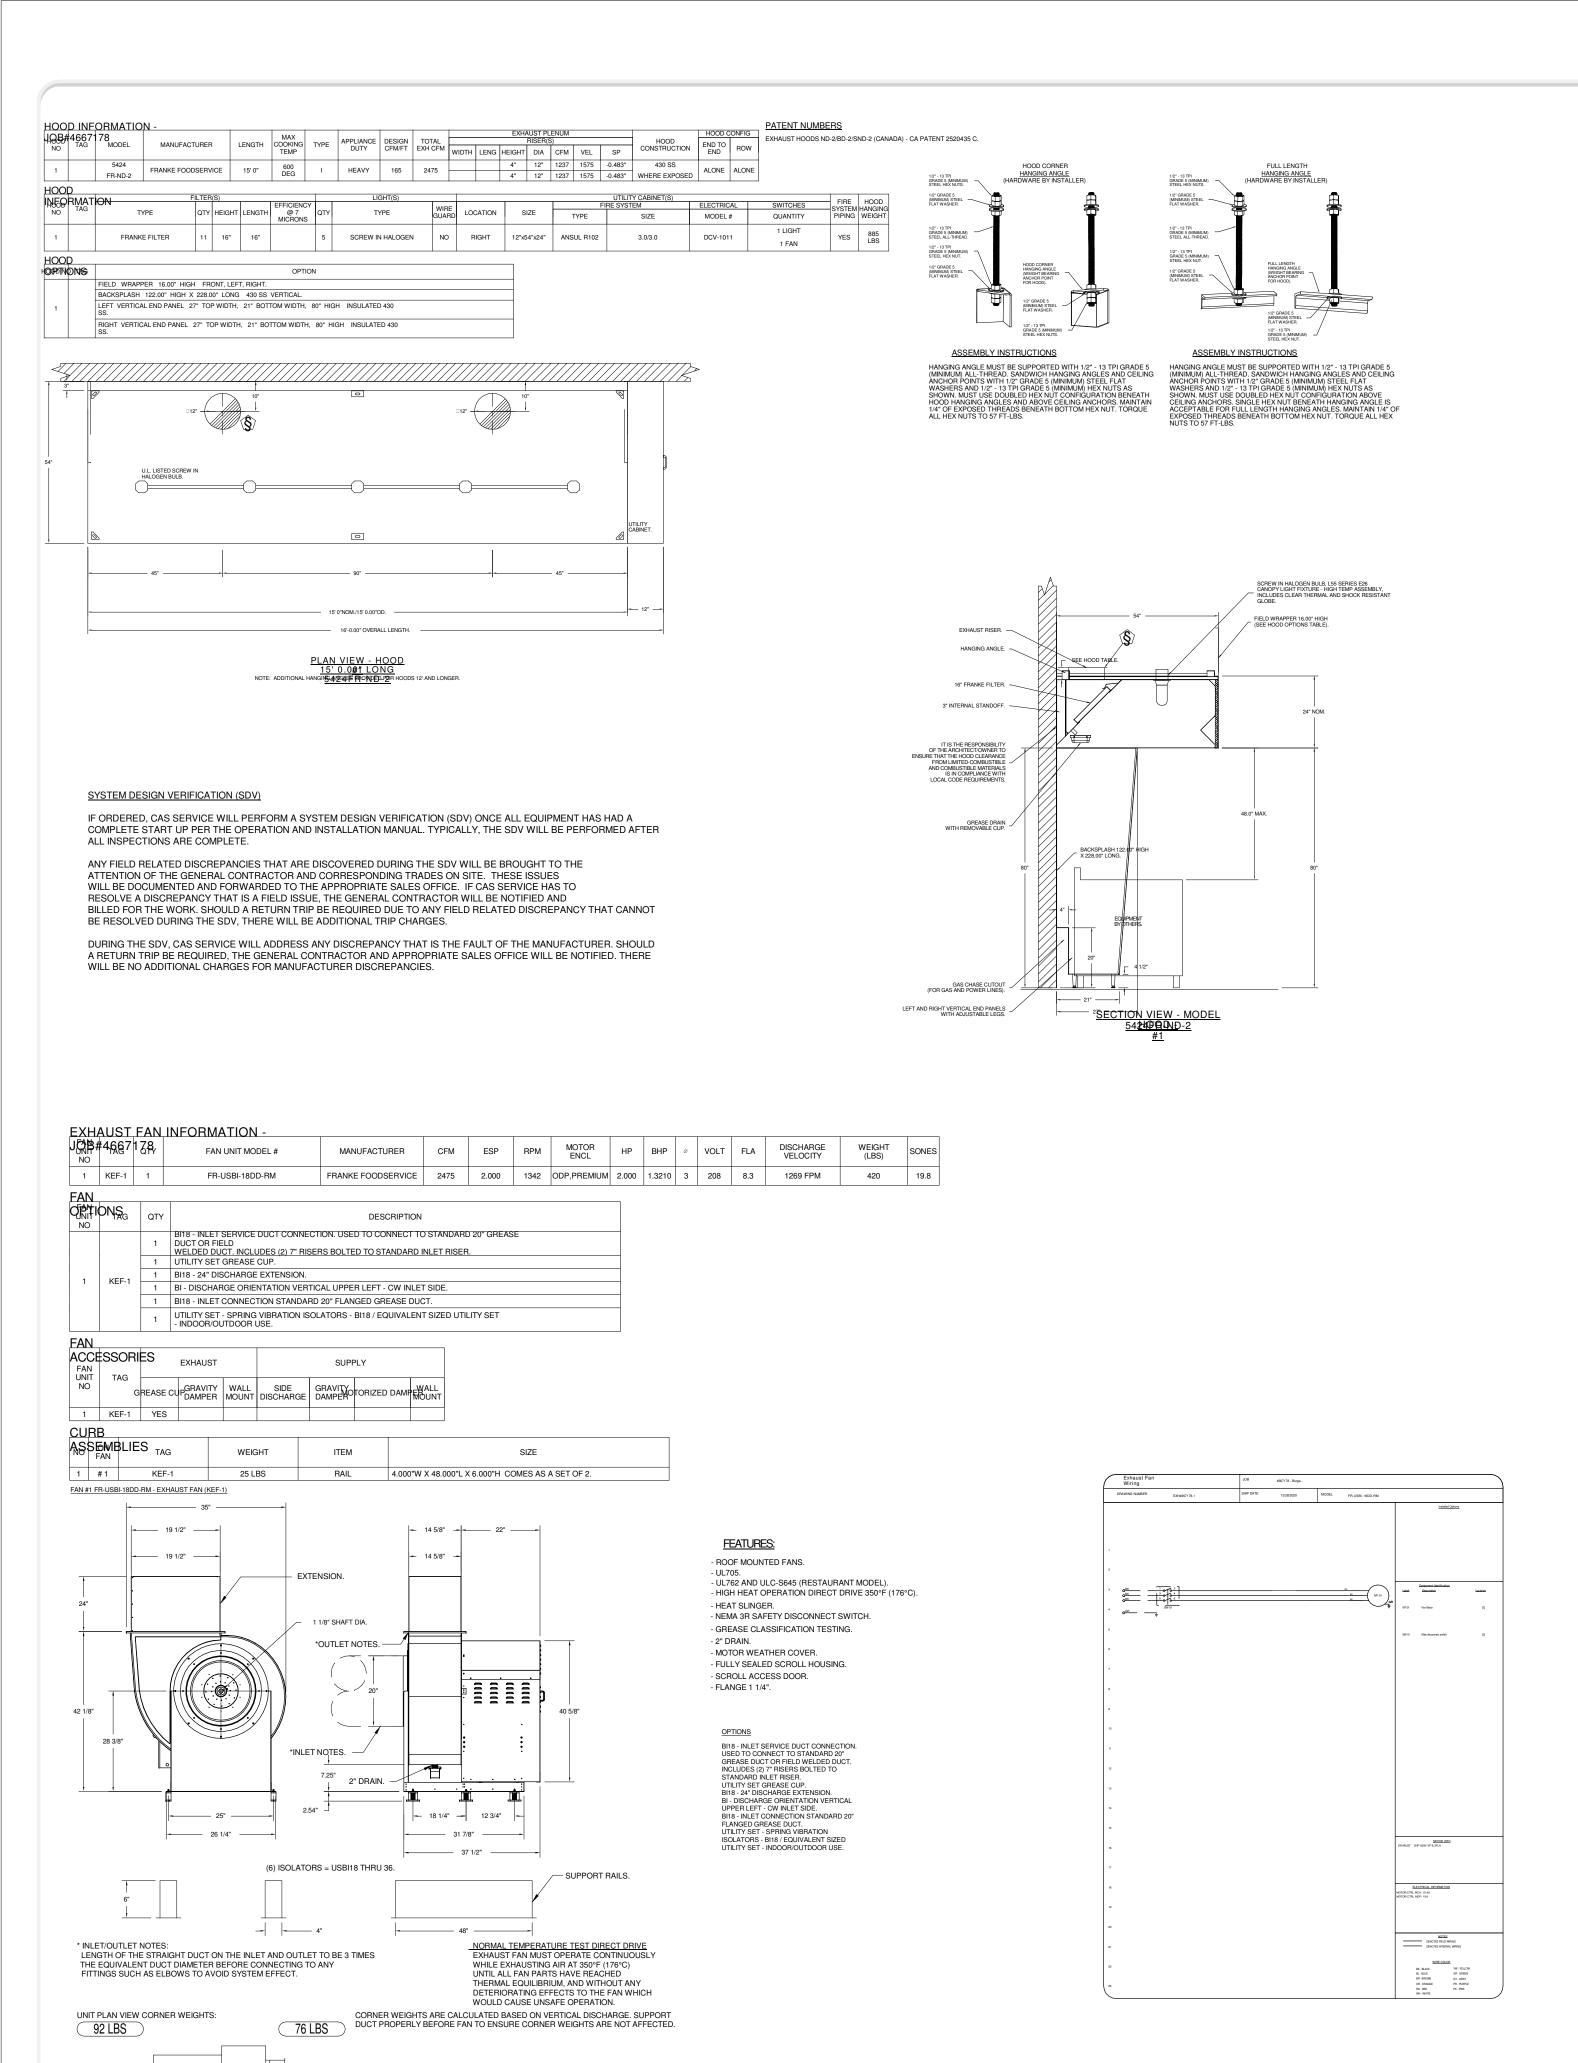

147 LBS

105 LBS



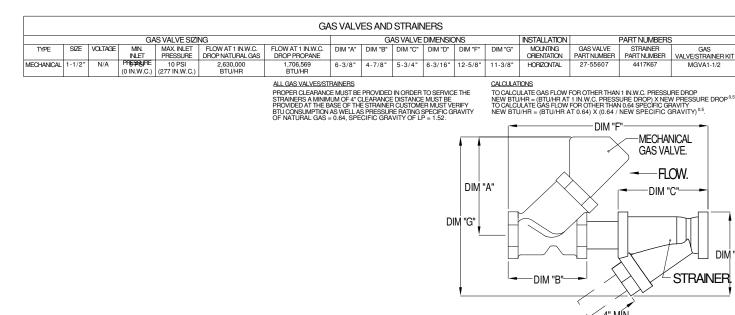




HOOD # 1 JOB # 4667178 MODEL: ND-2 SIZE: 54"x24" LENGTH: 15' 0"

NOTES
- FIELD PIPE DROPS AS SHOWN
SLEEVING, ELBOWS, TEES, AND NOZZLES SUPPLIED BY CAS.
- RELOCATE NOZZLES IF FLOW PATTERN IS BLOCKED BY SHELVING,
SALAMANDERS, ETC.
- MAXIMUM 9 ELBOWS IN SUPPLY LINE. - MIAJINIOM 9 ELBOWS IN SUPPLY LINE.
- MINIMUM 72 INCHES OF AGENT LINE FROM TANK TO FIRST NOZZLE
COVERING A RANGE, FRYER, OR WOK TO REFLECT GENERAL PIPING REQUIREMENTS.
- IF APPLICABLE, PRE-PIPED CHARBROILER DROPS ARE SHIPPED LOOSE.
- FACTORY PIPING EXTENDS A MAXIMUM OF 6" ABOVE THE TOP OF THE HOOD. - APPLIANCE DIMENSIONS LISTED REPRESENT THE COOKING SURFACE SIZE, NOT THE OVERALL APPLIANCE SIZE. - THIS FIRE SYSTEM COMPLIES WITH U.L. 300 REQUIREMENTS.


JOB #: 4667178. JOB NAME: BURGER KING - BRANTFORD, ON. SYSTEM SIZE: ANSUL-3.0/3.0-MANIFOLD TOTAL FP REQUIRED: 18. HOOD # 1 15' 0.00" LONG x 54" WIDE x 24" HIGH. RISER # 1 SIZE: 12" DIA. RISER # 2 SIZE: 12" DIA. HOOD # 1 METAL BLOW-OFF CAPS INCLUDED.

<u>LEGEND - FIRE CABINET ANSUL SYSTEM</u> 1.5 GALLON TANK. 3 GALLON TANK. OEM AUTOMAN RELEASE. OEM REGULATED RELEASE CARTRIDGE (101-20). CARTRIDGE (101-30). CARTRIDGE (LT-A-101-30). DOUBLE TANK CARTRIDGE. TEST LINK.
DOUBLE MICROSWITCH.
HOSE ASSEMBLY. DUCT NOZZLE (430913). DUCT NOZZLE (419337). 30 HIGH TEMP FUSIBLE LINK. MGV MECHANICAL GAS VALVE. EGV ELECTRICAL GAS VALVE.

OEM REGULATED ACTUATOR. ANSULEX LIQUID AGENT (3 GAL.) NOZZLE ASSEMBLY (419336). NOZZLE ASSEMBLY (419333). NOZZLE ASSEMBLY (419335). 1/2N NOZZLE ASSEMBLY (419334). 3N NOZZLE ASSEMBLY (419338). NOZZLE ASSEMBLY (419340). NOZZLE ASSEMBLY (419339). 2120 NOZZLE ASSEMBLY (419343). 290 NOZZLE ASSEMBLY (419342). 260 NOZZLE ASSEMBLY (419341). 28 DETECTOR BRACKET. 29 LOW TEMP FUSIBLE LINK. REMOTE MANUAL PULL STATION. SWIVEL ADAPTOR.

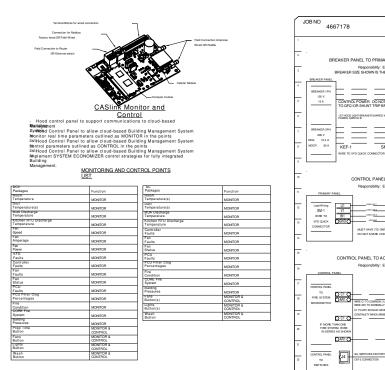

LOCATION

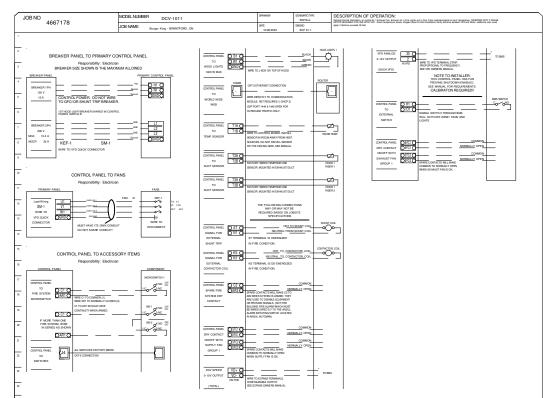

A B C UNLESS SPECIFIED OTHERWISE, ALL FACTORY AC WIRING 16 AWG. ALL FACTORY DC WIRIN		F G	H I MOTOR POWER CIRCUIT	FACTORY WIRING SCHEMATIC CIRCUIT BOARDS
100 100		WINES SCADA SE Was to SCADA SE Was done On SCADA SE Was come on SCADA SE	TOTE HE FOR COME OF THE ACT OF THE THE	ECPM03 DCV Pay-21200 HMI Rev. 2.12200 HMI Rev. 2.12200 B02 B02 B02 B03
. J7 120V		ACTIC Allianne on ECPRES (3) has to deap cleaned of the property of the proper		CX General value CX Consistent value CX CX Consistent value CX
S S S S S S S S S S				CS v Current Sensor ACT-N-IB SC-N-IB S
	$\begin{array}{c} \text{ARI} \triangleright^{\text{SC}} $		DRY CONTACTS (SHOWN DE-ENERGIZED)	FEGEND FELD WIRING FACTORY BE BLOCK WIRING, YELLOW BE BROWN PF. PRIPETE CORNEC FOR
Such IF all restricts to	EFI DESCRIPTION TO THE SECONDARY FACE SEARCH		MANUAL CHOPTE HAND RAD CHOPTENIN MANUAL RA	BLIDL END STIPE MICH. MOLESTERE WHEL. WHILE STIPE X'SH NAME DOWN FOR SH. DOWN FOR
			HANG PAS2	JOB NO DRAWN BY 4867178 TIPE FACTORY 12282020

DEMAND CONTROL VENTILATION HOOD CONTROL PANEL SPECIFICATIONS: CONTROLS SHALL BE LISTED BY ETL (UL 508A) AND SHALL COMPLY WITH DEMAND VENTILATION SYSTEM

THE CONTROL ENCLOSURE SHALL BE NEMA 1 RATED AND LISTED FOR INSTALLATION INSIDE OF THE EXHAUST HOOD UTILITY CABINET. THE CONTROL ENCLOSURE MAY BE CONSTRUCTED OF STAINLESS STEE

TURNDOWN REQUIREMENTS OUTLINED IN IECC 403.2.8 (2015).

CALCULATE THE SPEED REFERENCE SIGNAL.

- TEMPERATURE PROBE(S) LOCATED IN THE EXHAUST DUCT RISER(S) SHALL BE CONSTRUCTED OF
- ON A FIXED DIFFERENTIAL BETWEEN THE AMBIENT AND DUCT TEMPERATURES SENSORS. THIS FUNCTION
- SHALL MEET THE REQUIREMENTS OF IMC 507.1.1. A DIGITAL CONTROLLER SHALL PROVIDE ADJUSTABLE HYSTERESIS SETTINGS TO PREVENT CYCLING OF THE FANS AFTER THE COOKING APPLIANCES HAVE BEEN TURNED OFF AND/OR THE HEAT IN THE EXHAUST
- A DIGITAL CONTROLLER SHALL PROVIDE AN ADJUSTABLE MINIMUM FAN RUN-TIME SETTING TO PREVENT FAN
- VARIABLE FREQUENCY DRIVES (VFDS) SHALL BE PROVIDED FOR FANS AS REQUIRED. THE DIGITAL CONTROLLER SHALL MODULATE THE VFDS BETWEEN A MINIMUM SETPOINT AND A MAXIMUM SETPOINT ON DEMAND. THE DUCT TEMPERATURE SENSOR INPUT(S) TO THE DIGITAL CONTROLLER SHALL BE USED TO
- THE VFD SPEED RANGE OF OPERATION SHALL BE FROM 0% TO 100% FOR THE SYSTEM, WITH THE ACTUAL MINIMUM SPEED SET AS REQUIRED TO MEET MINIMUM VENTILATION REQUIREMENTS. AN INTERNAL ALGORITHM TO THE DIGITAL CONTROLLER SHALL MODULATE SUPPLY FAN VFD SPEED PROPORTIONAL TO ALL EXHAUST FANS THAT ARE LOCATED IN THE SAME FAN GROUP AS THE SUPPLY FAN.
- SUFFICIENT HEAT REMAINS UNDERNEATH THE HOOD SYSTEM AFTER COOKING OPERATIONS HAVE COMPLETED. OPERATION DURING EITHER OF THESE PERIODS WILL DISABLE THE SUPPLY FANS AND PROVIDE AN EXHAUST FAN SPEED THAT IS EQUAL TO THE MINIMUM VENTILATION REQUIREMENT A DIGITAL CONTROLLER SHALL DISABLE THE SUPPLY FAN(S), ACTIVATE THE EXHAUST FAN(S), ACTIVATE THE APPLIANCE SHUNT TRIP, AND DISABLE AN ELECTRIC GAS VALVE AUTOMATICALLY WHEN FIRE CONDITION IS DETECTED ON A COVERED HOOD.
- A DIGITAL CONTROLLER SHALL ALLOW FOR EXTERNAL BMS FAN CONTROL VIA DRY CONTACT (EXTERNAL CONTROL SHALL NOT OVERRIDE FAN OPERATION LOGIC AS REQUIRED BY CODE).
- AN LCD INTERFACE SHALL BE PROVIDED WITH THE FOLLOWING FEATURES: A. ONIOFF PUSH BUTTON FAN & LIGHT SWITCH ACTIVATION.

 B. INTEGRATED GAS VALVE RESET FOR ELECTRONIC GAS VALVES (NO RESET RELAY REQUIRED).

 C. VFD FAULT DISPLAY WITH AUDIBLE & VISUAL ALARM NOTIFICATION.
- F. A SINGLE LOW VOLTAGE CAT-5 RJ45 WIRING CONNECTION. G. AN ENERGY SAVINGS INDICATOR THAT UTILIZES MEASURED KWH FROM THE VFDS.

TYPICAL HOOD CONTROL PANEL INSTALLATION

THE HOOD CONTROL PANEL IS CAPABLE OF OPERATING IN ONE OR MORE OF THE FOLLOWING STATES AT ANY GIVEN TIME: AUTOMATIC: THE SYSTEM OPERATES BASED ON THE DIFFERENTIAL BETWEEN ROOM TEMPERATURE AND THE TEMPERATURE AT THE HOOD CAVITY OR EXHAUST DUCT COLLAR. FANS ACTIVATE AT A CONFIGURABLE TEMPERATURE DIFFERENTIAL THRESHOLD. DEPENDING ON THE JOB CONFIGURATION EACH FAN ZONE CAN BE CONFIGURED AS STATIC OR DYNAMIC. THESE TERMS REFER TO WHETHER A VARIABLE MOTOR (SUCH AS EC MOTORS OR VFD DRIVEN MOTORS) MODULATE WITH TEMPERATURE. IF THE PANEL IS EQUIPPED WITH VARIABLE SPEED FANS AND THE ZONE IS DEFINED AS "DYNAMIC", THESE WILL MODULATE WITHIN A USER-DEFINED PANGE BASED ON THE TEMPERATURE DIFFERENTIAL PANELS EQUIPPED WITH VARIABLE SPEED FANS AND A FAN ZONE DEFINED AS "STATIC", FANS WILL RUN AT A SET SPEED CALCULATED FOR THE DRIVE. DEMAND CONTROL VENTILATION SYSTEMS ARE CAPABLE OF MODULATING EXHAUST AND MAKE UP AIR FAN SPEEDS PER THE REQUIREMENTS OUTLINED IN IECC 403.2.8.

MANUAL: THE SYSTEM OPERATES BASED ON HUMAN INPUT FROM AN HMI.

SCHEDULE: A WEEKLY SCHEDULE CAN BE SET TO RUN FANS FOR A SPECIFIED PERIOD THROUGHOUT THE DAY. THERE ARE THREE OCCUPIED TIMES PER DAY TO ALLOW FOR THE USER TO SET UP A TIME THAT IS SUITABLE TO THEIR NEEDS. ANY TIME THAT IS WITHIN THE DEFINED OCCUPIED TIME, THE SYSTEM WILL RUN

CONTINUE TO TO RUN, THE HOOD MAKEUP AIR WILL SHUTDOWN, AND A SIGNAL WILL BE SENT FOR ACTIVATING THE SHUNT TRIP BREAKER PROVIDED BY THE ELECTRICIAN. FUEL GAS WILL SHUT OFF VIA A

MECHANICAL/ELECTRICAL GAS VALVE ACTUATED BY THE HOOD FIRE SUPPRESSION SYSTEM

OTHER: THE SYSTEM OPERATES BASED ON THE INPUT FROM AN EXTERNAL SOURCE (DDC, BMS OR FIRE: UPON ACTIVATION OF THE HOOD FIRE SUPPRESSION SYSTEM, THE EXHAUST FAN WILL COME ON OR

CANOPY HOOD DETAIL

B ∠

Franke Foodservice Systems Americas, Inc Smyrna, TN 37167

Tel. +800 472-2954 fs-customerservice.us@franke.com www.frankesupply.com

© 2020 Franke Foodservice Americas, Inc. © 2020 Franke Foodservice Americas, inc.
These drawings and specifications are the property of
Franke Technology and Trademark Ltd. and shall not be
reproduced, copied or transferred to any third party
without the prior written permission of Franke
Technology and Trademark Ltd., Hergiswil, Switzerland Exclusion of Liability:
FRANKE takes no responsibility for the accuracy of the floor plans and constructional drawings. All dimensions and connections specified by FRANKE must be checked by the client prior to installation. Specifications for power consumption and connections are limited to equipment supplied by FRANKE. All third party accessories shown lie within the responsibility of the client. FRANKE

reserves the right to change equipment without notice. ACCOUNT

BURGER KING

RESTAURANT# N/A TITLE

KES HOOD DETAILS

OPERATOR K & K Foods, Inc.

SITE ADDRESS 66745 TWO BUNCH PALMS TRL

DESERT HOT SPRINGS

STATE ZIP CODE 92240-5775 COUNTRY REGION

BUILDING TYPE FREESTANDING ELECTRICAL SERVICE

USA N. AMERICA

208-230V/60Hz GAS SERVICE

NATURAL MARKET MANAGER

ROBERT GERDES FRANKE PROJECT NUMBER

1435354 FRANKE STORE NUMBER

5193384

CREATED BY DK996

DATE ISSUED 08/20/2021

MODIFIED BY HP033


DRAWING SCALE As Noted

UNITS INCH DRAWING NUMBER

Desert Hot Spring, CA SHEET NAME

K4.1



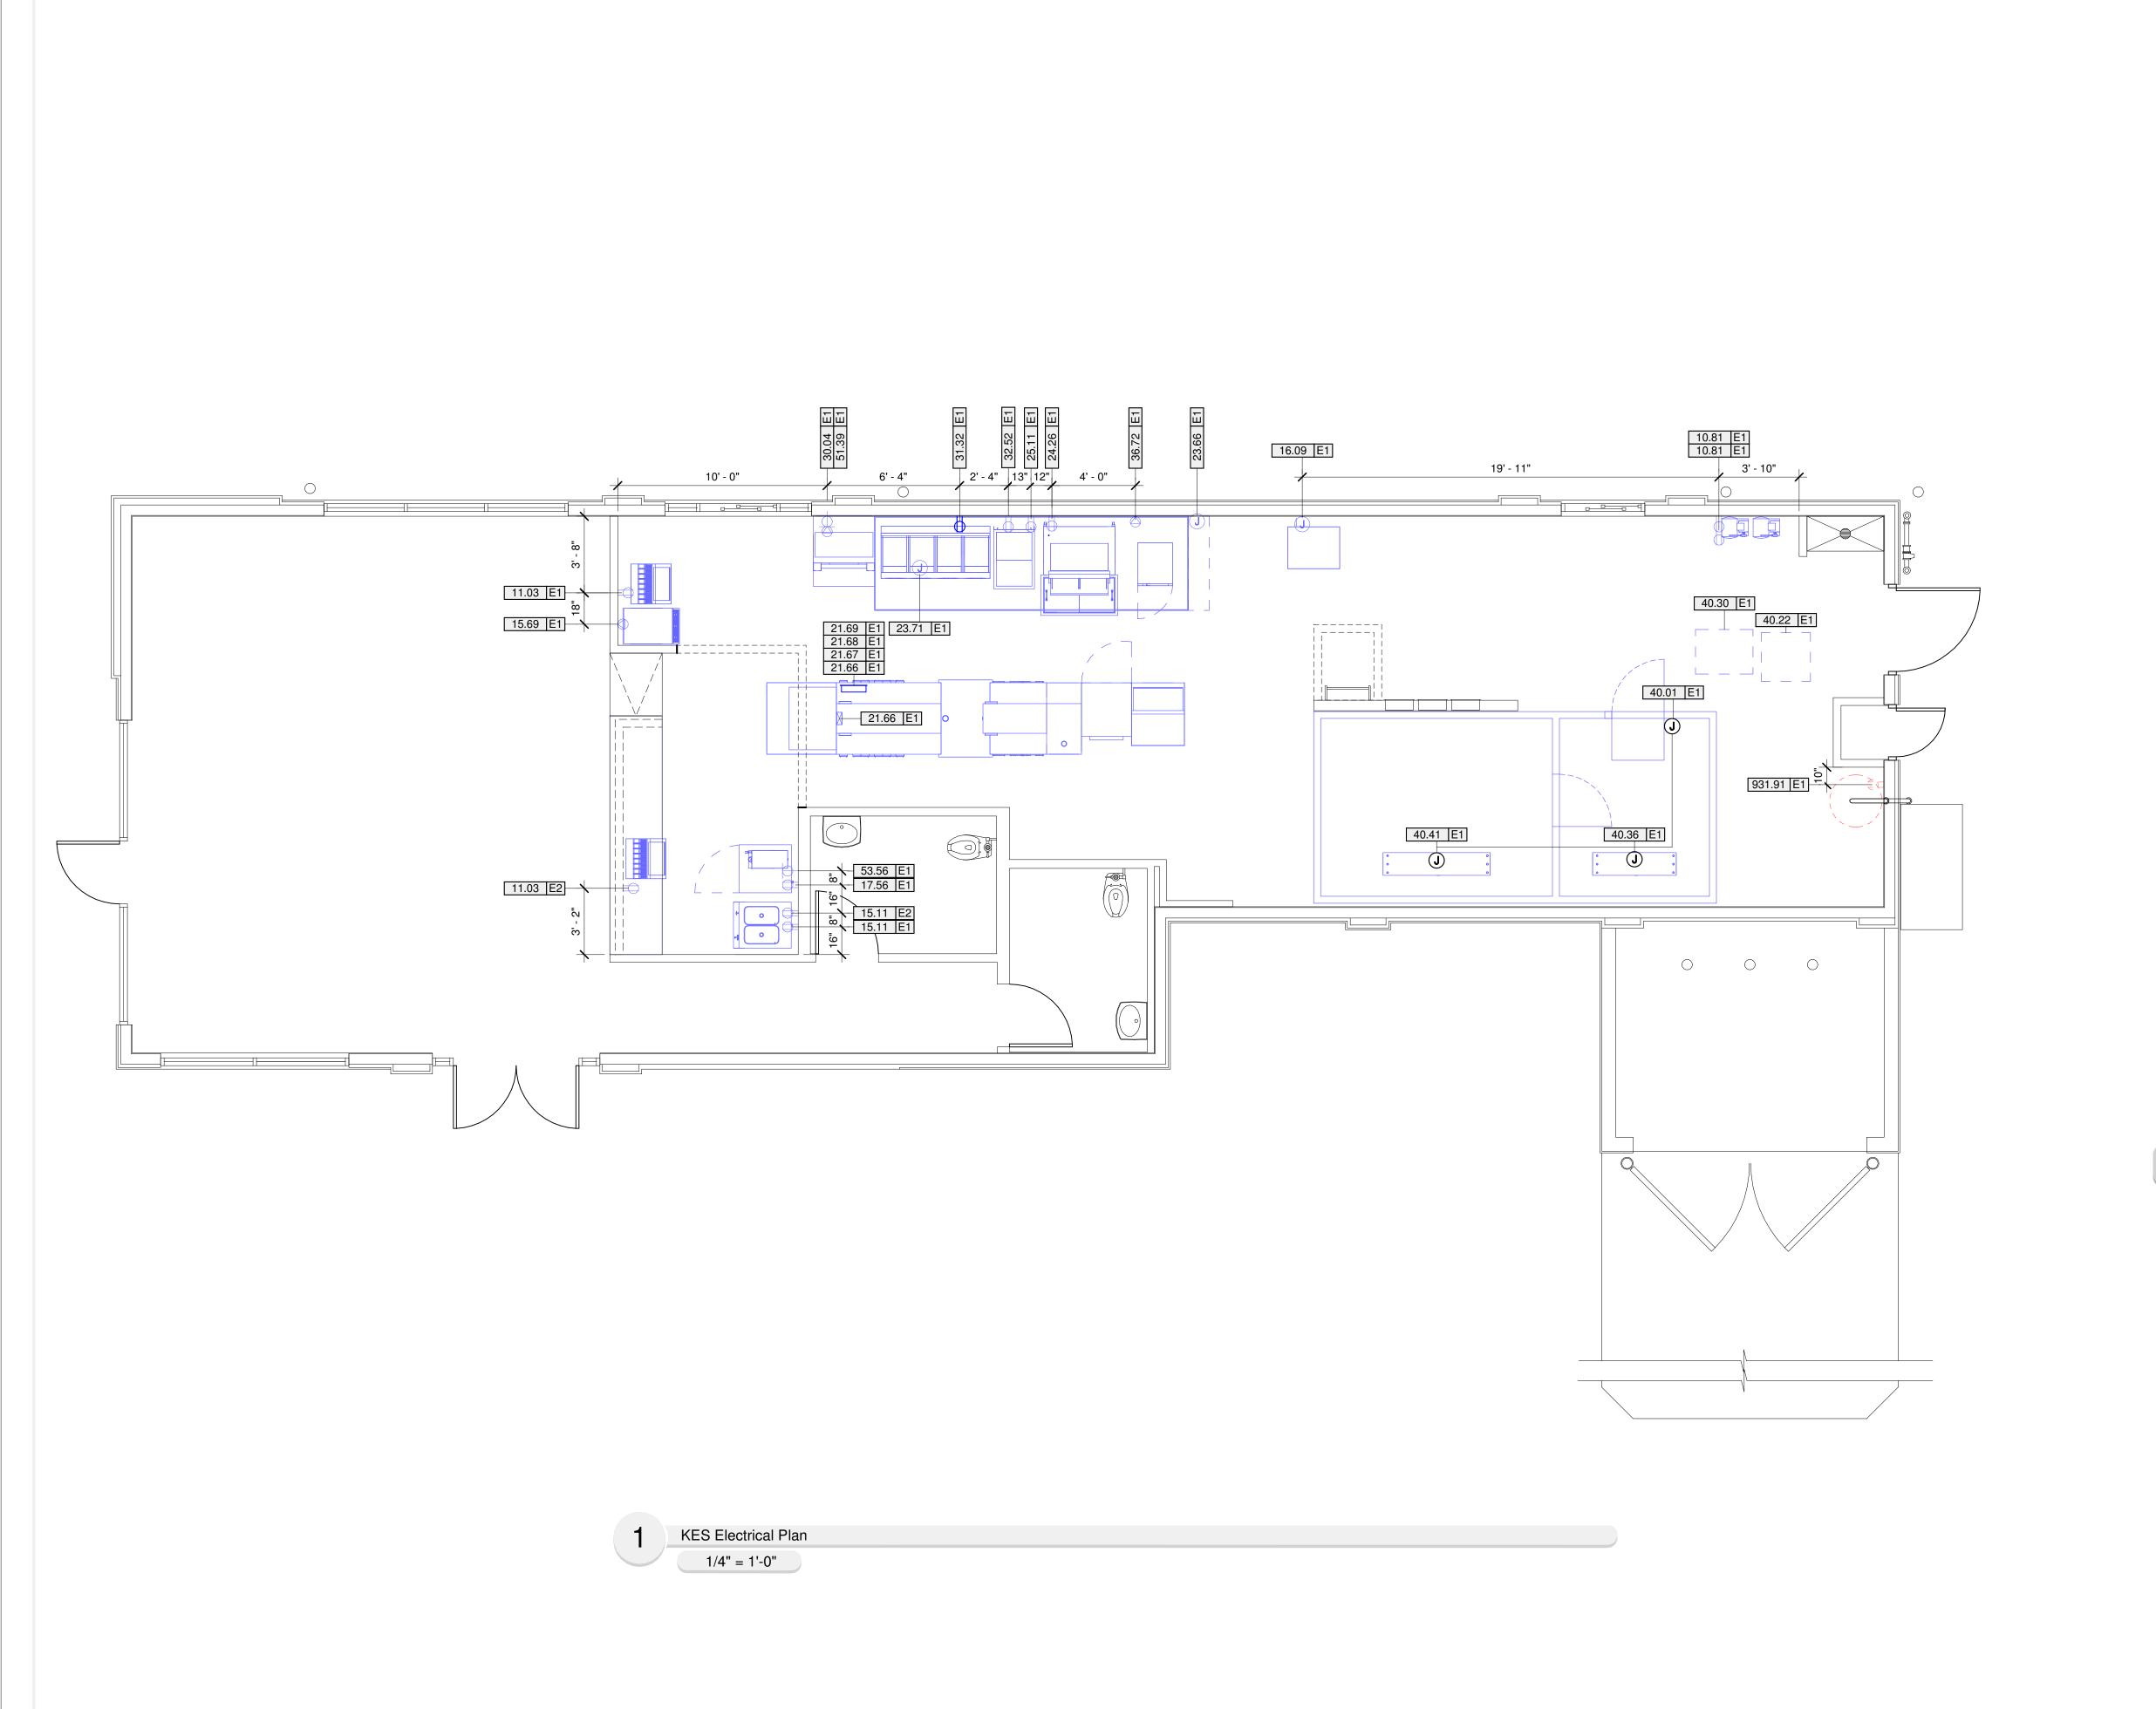

ELECTRICAL CONTRACTOR NOTES

E.C. TO PROVIDE AND INSTALL RECEPTACLES, CAPS, AND CORDS AS REQUIRED. CAPS AND CORDS ARE TO BE INSTALLED ACCORDING TO THE MANUFACTURER'S INSTRUCTIONS AND COMPLY WITH ALL APPLICABLE

2 E.C. TO CONNECT ELECTRICAL SERVICE DIRECTLY TO EQUIPMENT ACCORDING TO THE MANUFACTURER'S INSTRUCTIONS. ELECTRICAL CONNECTIONS SHALL COMPLY WITH ALL APPLICABLE CODES

E.C. TO RE-CONNECT ELECTRICAL CIRCUITS ON ALL PRE-WIRED EQUIPMENT DISASSEMBLED FOR SHIPMENT.

WHERE EQUIPMENT IS NOT PRE-WIRED, E.C. TO CONNECT THE ELECTRICAL

SERVICE AND PROVIDE INTER-WIRING AS REQUIRED. WHERE RECEPTACLES ` PROVIDED WITH THE EQUIPMENT, E.C. TO EXTEND

ELECTRICAL SERVICE AS REQUIRED TO PROVIDED RECEPTACLES FRANKE KITCHEN DRAWINGS ONLY INCLUDE RECEPTACLES REQUIRED FOR

SPECIFIC KITCHEN EQUIPMENT. REFER TO BUILDING FLOOR PLANS FOR THE LOCATIONS OF UTILITY AND GENERAL PURPOSE RECEPTACLES. E.C. TO VERIFY UTILITY REQUIREMENTS FOR ITEMS NOT PROVIDED BY

NOTIFY FRANKE PROJECT MANAGER IMMEDIATELY IN WRITING IF THESE DRAWINGS ARE IN CONFLICT WITH ANY LOCAL, STATE OR NATIONAL CODES.

WALK-IN COOLER/FREEZER NOTES

E.C. TO PROVIDE AND INSTALL A HEATING ELEMENT ON THE COOLER AND FREEZER CONDENSATE DRAIN LINE.

2 E.C. TO CONNECT THE PRIMARY ELECTRICAL SERVICE TO THE CONDENSING UNITS, AND INTER-WIRE SERVICE TO THE EVAPORATOR COIL(S), CONTROLS, LIGHT FIXTURES AND DOOR PERIMETER HEATERS."

ABBREVIATIONS

AFC ABOVE FINISHED CEILING

AFF ABOVE FINISHED FLOOR

AFR ABOVE FINISHED ROOF

BFC BELOW FINISHED CEILING

WIB WALK-IN BOX (COOLER/FREEZER)

SYMBOL LEGEND

SINGLE RECEPTACLE		XXX.XX	EQUIPMENT TAG
DUPLEX RECEPTACLE)	XXX.XX E1	ELECTRICAL ROUGH-IN TAG
SPECIAL RECEPTACLE		XXX.XX P1	PLUMBING ROUGH-IN TAG
JUNCTION BOX		XXX.XX M1	MECHANICAL ROUGH IN TAG
CIRCUIT BREAKER PANELS		W	ASTE DRAINS (FLOOR SINK)

COLD WATER

HOT WATER

HOT & COLD WATER HOT & COLD POTABLE WATER/ DIRECT WASTE DRAIN COMBO

DIRECT WASTE DRAIN (HUB)

WASTE DRAINS (INDIRECT & DIRECT) EXHAUST DUCT (BOILER OR FRY HOOD)

SERVICE CHASE

EXISTING EQUIPMENT DEMOLISHED EQUIPMENT RELOCATED EQUIPMENT

NEW EQUIPMENT

FUTURE EQUIPMENT

KE1.0 REVISION B

B A BEV

FR ANKE

Franke Foodservice Systems Americas, Inc

fs-customerservice.us@franke.com

© 2020 Franke Foodservice Americas, Inc.
These drawings and specifications are the property of
Franke Technology and Trademark Ltd. and shall not be
reproduced, copied or transferred to any third party
without the prior written permission of Franke
Technology and Trademark Ltd., Hergiswil, Switzerland

Exclusion of Liability:
FRANKE takes no responsibility for the accuracy of the floor plans and constructional drawings. All dimensions and connections specified by FRANKE must be checked by the client prior to installation. Specifications for power

consumption and connections are limited to equipment supplied by FRAINKE. All third party accessories shown lie within the responsibility of the client. FRAINKE reserves the right to change equipment without notice.

BURGER KING

KES ELECTRICAL PLAN

66745 TWO BUNCH PALMS TRL

ZIP CODE 92240-5775

DESERT HOT SPRINGS

USA N. AMERICA

800 Aviation Parkway Smyrna, TN 37167

Tel. +800 472-2954

ACCOUNT

RESTAURANT#

OPERATOR

SITE ADDRESS

STATE

K & K Foods , Inc.

COUNTRY REGION

BUILDING TYPE FREESTANDING ELECTRICAL SERVICE 208-230V/60Hz GAS SERVICE NATURAL

MARKET MANAGER ROBERT GERDES FRANKE PROJECT NUMBER

FRANKE STORE NUMBER

1435354

5193384

CREATED BY DK996

DATE ISSUED 08/20/2021

MODIFIED BY HP033

UNITS INCH

DRAWING SCALE As Noted

DRAWING NUMBER

Desert Hot Spring, CA

www.frankesupply.com

1.81

901.81

G.C. TO PROVIDE CHASE INSIDE STUD

- WALL F/ SODA LINE @ FRONT COUNTER. VERIFY SIZE & LOCATION.

KES Mechanical Plan

1/4" = 1'-0"

ALL WORK SHALL BE PERFORMED BY A QUALIFIED LICENSED MECHANICAL CONTRACTOR IN ACCORDANCE WITH ALL COUNTRY, STATE AND LOCAL

HVACR CONTRACTOR SHALL PROVIDE AND INSTALL EXHAUST FANS AND ROOF CURBS UNLESS OTHERWISE STATED IN THE EQUIPMENT SCHEDULE

HOODS

HVACR CONTRACTOR SHALL INSTALL EXHAUST AND INDUCTION AIR DUCT WORK PROVIDED WITH THE EXHAUST HOOD(S). NOTE: THE EXHAUST DUCTS PROVIDED WITH THE HOODS ARE DESIGNED FOR INSTALLATION IN SINGLE STORY, STANDARD BK STRUCTURES. IN OTHER APPLICATIONS, HVACR CONTRACTOR SHALL PROVIDE AND INSTALL SUPPLEMENTAL DUCT WORK

OTHERWISE.

PROVIDED AND INSTALLED BY THE SYSTEM INSTALLER. HVACR CONTRACTOR TO INSTALL PRE-CHARGED REFRIGERATION LINES

COOLER/FREEZER REFRIGERATION SYSTEM(S) AND ANY OTHER REFRIGERATION SYSTEMS WITH REMOTE CONDENSING UNIT(S)

BUILDING PLANS FOR LOCATIONS OF OTHER HVACR SERVICES.

NOTIFY FRANKE PROJECT MANAGER IMMEDIATELY IN WRITING IF THESE DRAWINGS ARE IN CONFLICT WITH ANY LOCAL, STATE OR NATIONAL CODES

FROM THE TOP OF THE HOOD TO THE BOTTOM OF THE FAN (OR TOP OF THE ROOF CURB), BEFORE IT IS NECESSARY TO CHANGE FAN REQUIREMENTS. IF THERE ARE ELBOWS IN THE DUCT RUN, ADD .2" SP FOR EVERY ELBOW (THIS MAY CHANGE THE REQUIREMENTS FOR THE FAN AS WELL). HVACR CONTRACTOR IS RESPONSIBLE FOR DETERMINING HVACR REQUIREMENTS

CFM CUBIC FEET PER MINUTE

SYMBOL LEGEND

₽	SINGLE RECEPTAGLE	XXX.XX	EQUIPMENT TAG
\rightarrow	DUPLEX RECEPTACLE	XXX.XX E1	ELECTRICAL ROUGH-IN TAG
	SPECIAL RECEPTACLE	XXX.XX P1	PLUMBING ROUGH-IN TAG
J	JUNCTION BOX	XXX.XX M1	MECHANICAL ROUGH IN TAG
_	CIRCUIT BREAKER PANELS		WASTE DRAINS (FLOOR SINK)
 	COLD WATER		DIRECT WASTE DRAIN (HUB)
+	HOT WATER	+	WASTE DRAINS (INDIRECT & DIRECT)

HOT & COLD POTABLE WATER/ DIRECT WASTE DRAIN COMBO

NEW EQUIPMENT FUTURE EQUIPMENT



 \bigcirc

 \bigcirc

MECHANICAL CONTRACTOR NOTES

ALL WORK SHALL BE COMPLETED IN A NEAT, SAFE, AND WORKMAN-LIKE

HVACR CONTRACTOR SHALL INSTALL CEILING SUSPENDED EXHAUST

AS REQUIRED. THE PROVIDED SUPPLEMENTAL DUCT WORK SHALL MEET ALL APPLICABLE CODES.

6 ALL EXHAUST, MAKE-UP AND INDUCTION AIR QUANTITIES AND SPECIFICATIONS ARE AT THE DUCT COLLAR UNLESS SPECIFIED

THE FIRE SUPPRESSION SYSTEM IS TO BE INSTALLED BY AN INSTALLER CERTIFIED AND LICENSED BY THE SYSTEM MANUFACTURER. ALL SYSTEM COMPONENTS NOT INCLUDED WITH THE EXHAUST HOODS ARE TO BE

PROVIDED BY FRANKE FOR THE WALK-IN COOLER/FREEZER. HVACR CONTRACTOR SHALL START UP AND ADJUST THE WALK-IN

FRANKE KITCHEN DRAWINGS INCLUDE ONLY THOSE REQUIREMENTS FOR THE SPECIFIC EQUIPMENT PROVIDED BY FRANKE. REFER TO OTHER

HVACR CONTRACTOR SHALL VERIFY THE REQUIRMENTS FOR ITEMS NOT

THE MAXIMUM STRAIGHT DUCT RUN FOR THE FANS SPECIFIED IS 60'-0"

ABBREVIATIONS

FPM FEET PER MINUTE

HOT & COLD WATER

EXHAUST DUCT (BOILER OR FRY HOOD) SERVICE CHASE

> **EXISTING EQUIPMENT** DEMOLISHED EQUIPMENT RELOCATED EQUIPMENT

SHEET NAME **KM1.0**

B A BEV

FRANKE

Franke Foodservice Systems Americas, Inc

fs-customerservice.us@franke.com

© 2020 Franke Foodservice Americas, Inc.
These drawings and specifications are the property of
Franke Technology and Trademark Ltd. and shall not be
reproduced, copied or transferred to any third party
without the prior written permission of Franke
Technology and Trademark Ltd., Hergiswil, Switzerland

Exclusion of Liability:
FRANKE takes no responsibility for the accuracy of the floor plans and constructional drawings. All dimensions and connections specified by FRANKE must be checked by the client prior to installation. Specifications for power

consumption and connections are limited to equipment supplied by FRANKE. All third party accessories shown lie within the responsibility of the client. FRANKE reserves the right to change equipment without notice.

BURGER KING

KES MECHANICAL PLAN

66745 TWO BUNCH PALMS TRL

ZIP CODE 92240-5775

DESERT HOT SPRINGS

USA N. AMERICA

800 Aviation Parkway Smyrna, TN 37167

Tel. +800 472-2954

ACCOUNT

N/A

OPERATOR

SITE ADDRESS

STATE

K & K Foods , Inc.

COUNTRY REGION

BUILDING TYPE FREESTANDING ELECTRICAL SERVICE 208-230V/60Hz GAS SERVICE NATURAL MARKET MANAGER ROBERT GERDES FRANKE PROJECT NUMBER

1435354

5193384

CREATED BY DK996

DATE ISSUED

08/20/2021

MODIFIED BY HP033

UNITS INCH

DRAWING SCALE As Noted


DRAWING NUMBER Desert Hot Spring, CA

FRANKE STORE NUMBER

RESTAURANT#

www.frankesupply.com

	PLUMBING KEYNOTES
KEY VALUE	KEYNOTE TEXT
P2.2	2" DIA OUTLET PIPE STUB THROUGH WALL @ 20"-24" ABOVE GRADE. INSTALLER TO VERIFY HEIGTH AND LOCATION TO ENSURE NO OBSTRUCTIONS ON INSIDE OR OUTSIDE OF WALL. VERIFY REQ,MTS W/ OWNER.
P3.2	HOLD HUB DRAIN TIGHT TO WALL GC TO MAKE CONNECTION THROUGH WALL. INCLUDE HUB STRAINER. GC TO VERIFY LOCATION OF HUB DRAIN WITH WIB MANUFACTURER.

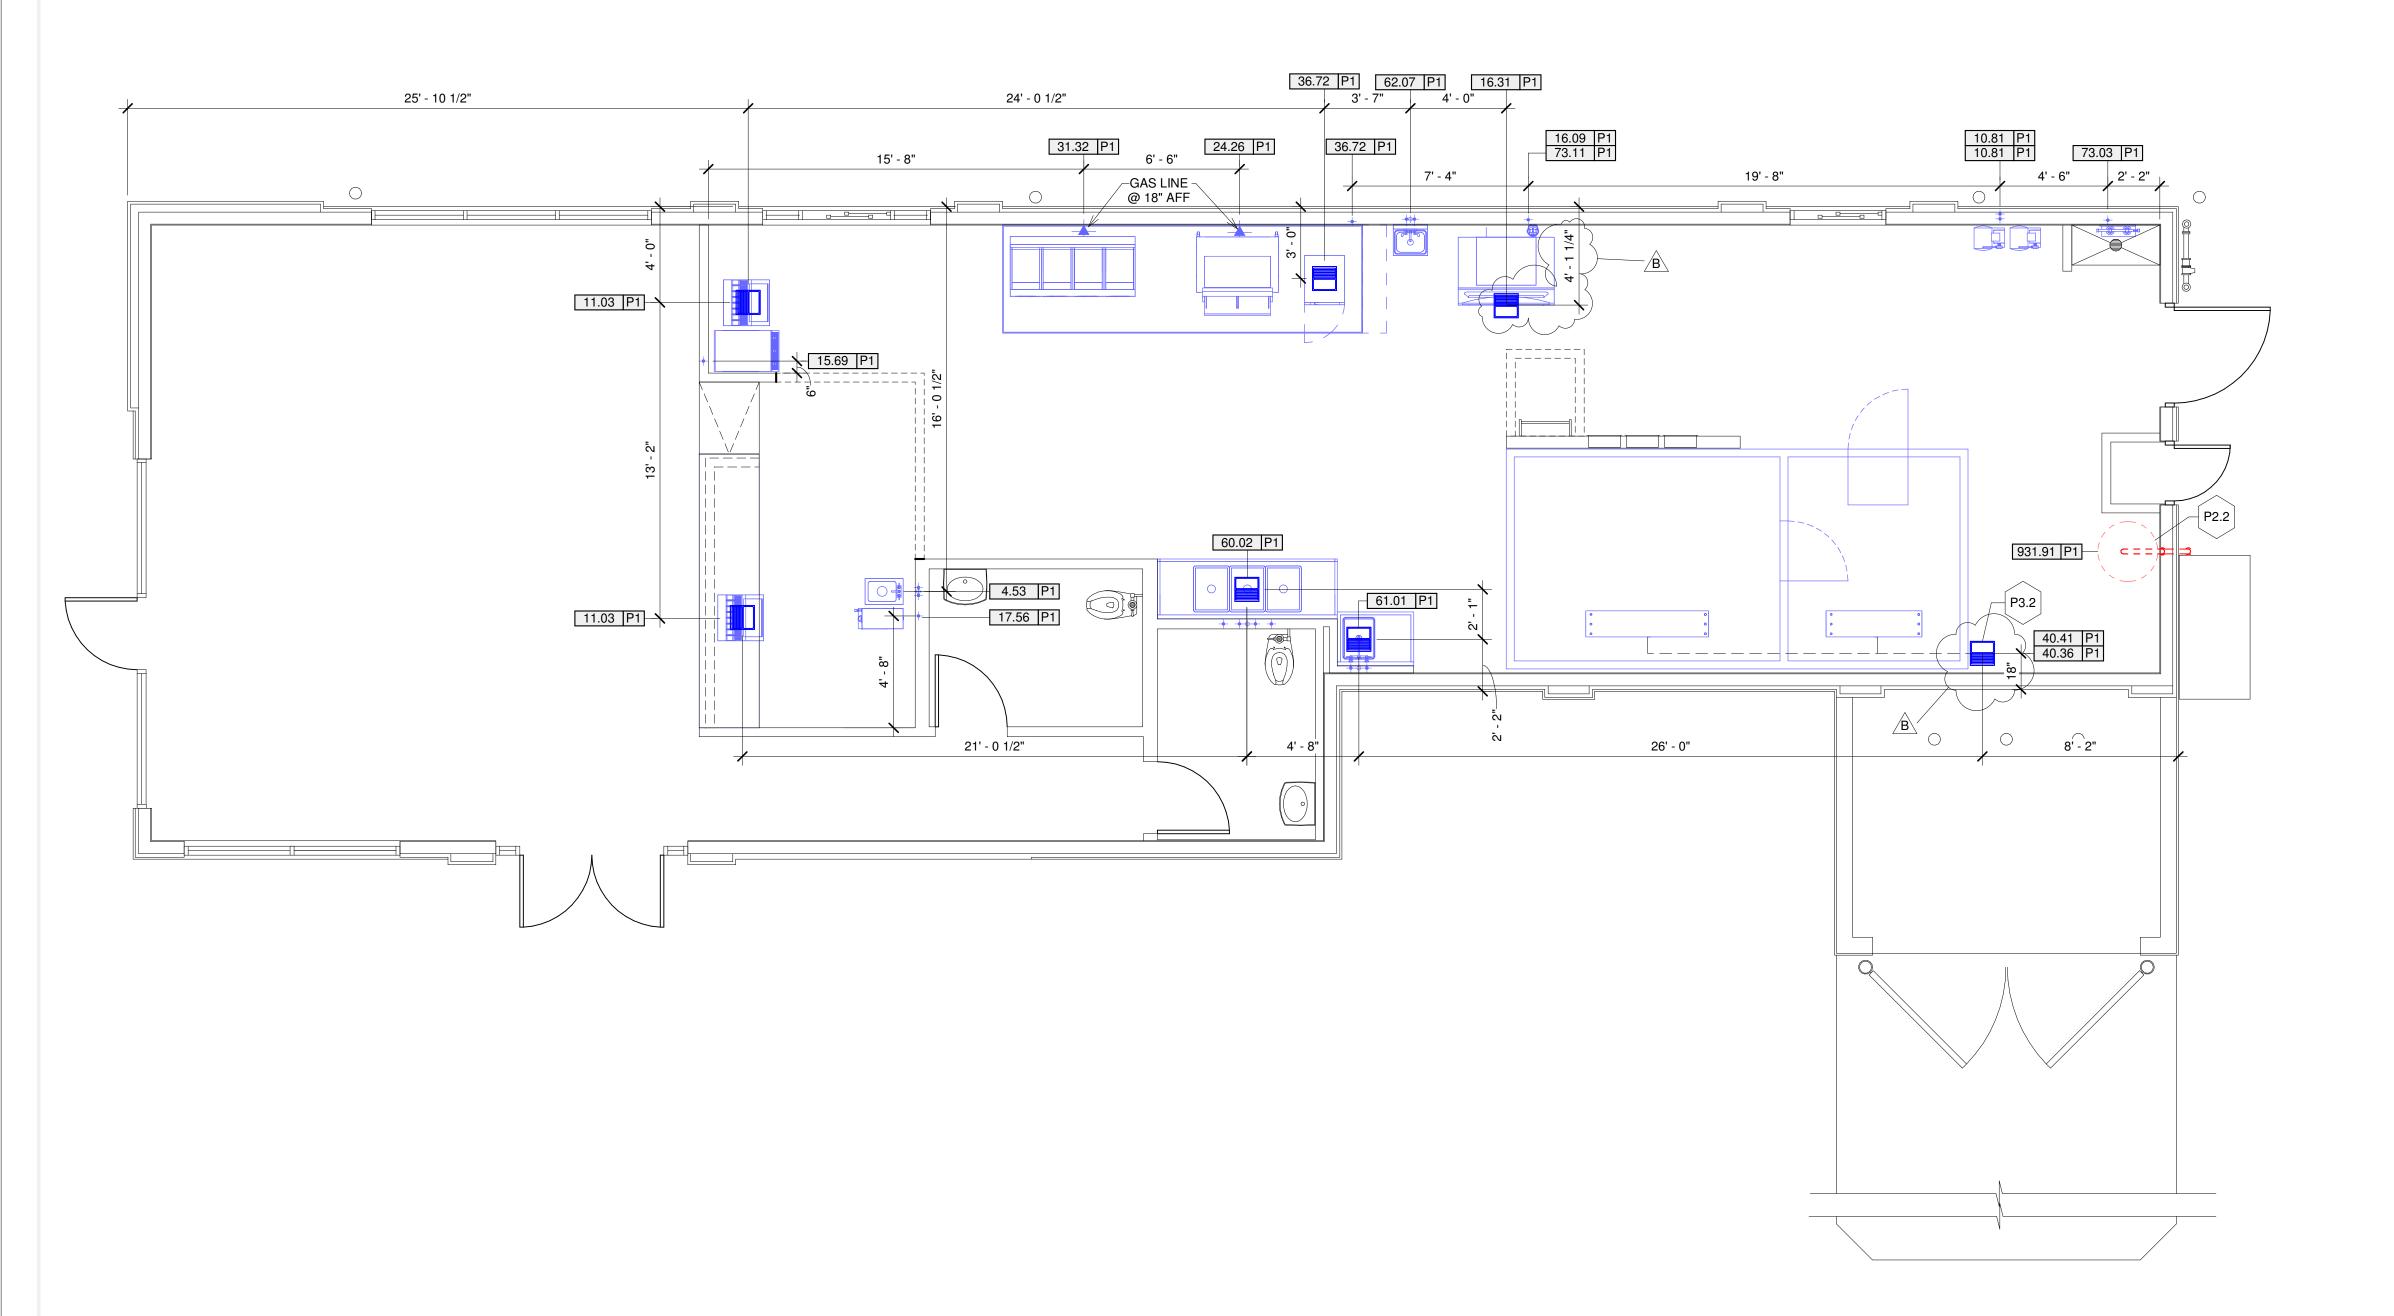

KES Plumbing Plan

1/4" = 1'-0"

PLUMBING CONTRACTOR NOTES

- P.C. SHALL PROVIDE AND INSTALL SHUT-OFF VALVES ON ALL POTABLE WATER AND GAS SUPPLY LINES AT EACH PIECE OF EQUIPMENT WHERE REQUIRED BY CODES. VALVES AND INSTALLATION SHALL MEET ALL APPLICABLE CODES.
- P.C. SHALL CONNECT POTABLE WATER AND GAS SERVICE DIRECTLY TO THE EQUIPMENT ACCORDING TO THE MANUFACTURER'S INSTRUCTIONS. CONNECTIONS SHALL MEET ALL APPLICABLE CODES.
- P.C. TO CONNECT EQUIPMENT TO THE BUILDING WASTE DRAINAGE SYSTEM ACCORDING TO THE MANUFACTURER'S INSTRUCTION. CONNECTIONS SHALL
- MEET ALL APPLICABLE CODES.
- P.C. TO RECONNECT PLUMBING AND GAS PIPING ON PRE-PLUMBED EQUIPMENT DISASSEMBLED FOR SHIPMENT.
- WHERE EQUIPMENT IS NOT PRE-PLUMBED, P.C. SHALL CONNECT THE PLUMBING AND GAS SERVICE AND PROVIDE INTER-PIPING AS REQUIRED.
- P.C. TO INSTALL FAUCETS, DRAIN ASSEMBLIES AND ACCESSORIES PROVIDED WITH EQUIPMENT.
- WHERE A SERVICE CHASE IS PROVIDED WITH THE EQUIPMENT, THE P.C. SHALL INSTALL THE PLUMBING AND/OR GAS SERVICE THROUGH THE SERVICE CHASE TO THE CONNECTION POINT(S) ON THE EQUIPMENT AS REQUIRED. ALL CONNECTIONS AND PIPING SHALL MEET ALL APPLICABLE
- P.C. SHALL PROVIDE AND INSTALL CONDENSATE DRAIN LINES FROM THE WALK-IN COOLER AND FREEZER EVAPORATOR COILS.
- P.C. SHALL PROVIDE AND INSTALL BACK-FLOW PREVENTION DEVICES WHEN REQUIRED BY THE AUTHORITY HAVING JURISDICTION.
- P.C. SHALL PROVIDE AND INSTALL AUTOMATIC GAS SHUT-OFF VALVES WHEN REQUIRED BY THE AUTHORITY HAVING JURISDICTION.
 - FRANKE KITCHEN DRAWINGS INCLUDE ONLY THOSE REQUIREMENTS FOR SPECIFIC KITCHEN EQUIPMENT. REFER TO BUILDING FLOOR PLANS FOR OTHER PLUMBING REQUIREMENTS AND LOCATIONS.
- NOTIFY FRANKE PROJECT MANAGER IMMEDIATELY IN WRITING IF THESE DRAWINGS ARE IN CONFLICT WITH ANY LOCAL, STATE OR NATIONAL CODES.

ABBREVIATIONS

AFF ABOVE FINISHED FLOOR

FPM FEMALE PIPE THREAD

SYMBOL LEGEND

\Diamond	SINGLE RECEPTACLE	XXX.XX	EQUIPMENT TAG
	DUPLEX RECEPTACLE	XXX.XX E1	ELECTRICAL ROUGH-IN TAG
\bigcirc	SPECIAL RECEPTACLE	XXX.XX P1	PLUMBING ROUGH-IN TAG
J	JUNCTION BOX	XXX.XX M1	MECHANICAL ROUGH IN TAG
_	CIRCUIT BREAKER PANELS		WASTE DRAINS (FLOOR SINK)
+	COLD WATER		DIRECT WASTE DRAIN (HUB)
+	HOT WATER	-	WASTE DRAINS (INDIRECT & DIRECT)
+ +	HOT & COLD WATER		EXHAUST DUCT (BOILER OR FRY HOOD)
+	HOT & COLD POTABLE WATER/ DIRECT WASTE DRAIN COMBO		SERVICE CHASE

EXISTING EQUIPMENT DEMOLISHED EQUIPMENT RELOCATED EQUIPMENT NEW EQUIPMENT FUTURE EQUIPMENT



B A



FRANKE

Franke Foodservice Systems Americas, Inc

800 Aviation Parkway Smyrna, TN 37167 Tel. +800 472-2954

> fs-customerservice.us@franke.com www.frankesupply.com

© 2020 Franke Foodservice Americas, Inc.
These drawings and specifications are the property of
Franke Technology and Trademark Ltd. and shall not be
reproduced, copied or transferred to any third party
without the prior written permission of Franke
Technology and Trademark Ltd., Hergiswil, Switzerland Exclusion of Liability:
FRANKE takes no responsibility for the accuracy of the floor plans and constructional drawings. All dimensions and connections specified by FRANKE must be checked by the client prior to installation. Specifications for power

consumption and connections are limited to equipment supplied by FRANKE. All third party accessories shown lie within the responsibility of the client. FRANKE reserves the right to change equipment without notice.

ACCOUNT **BURGER KING**

RESTAURANT#

KES PLUMBING PLAN

N/A

OPERATOR K & K Foods , Inc.

SITE ADDRESS 66745 TWO BUNCH PALMS TRL

DESERT HOT SPRINGS STATE ZIP CODE 92240-5775

COUNTRY REGION USA N. AMERICA BUILDING TYPE FREESTANDING

ELECTRICAL SERVICE 208-230V/60Hz GAS SERVICE NATURAL

MARKET MANAGER ROBERT GERDES FRANKE PROJECT NUMBER

1435354 FRANKE STORE NUMBER 5193384

CREATED BY DK996


DATE ISSUED 08/20/2021


MODIFIED BY HP033 DRAWING SCALE As Noted


UNITS INCH


DRAWING NUMBER Desert Hot Spring, CA

SHEET NAME **KP1.0**

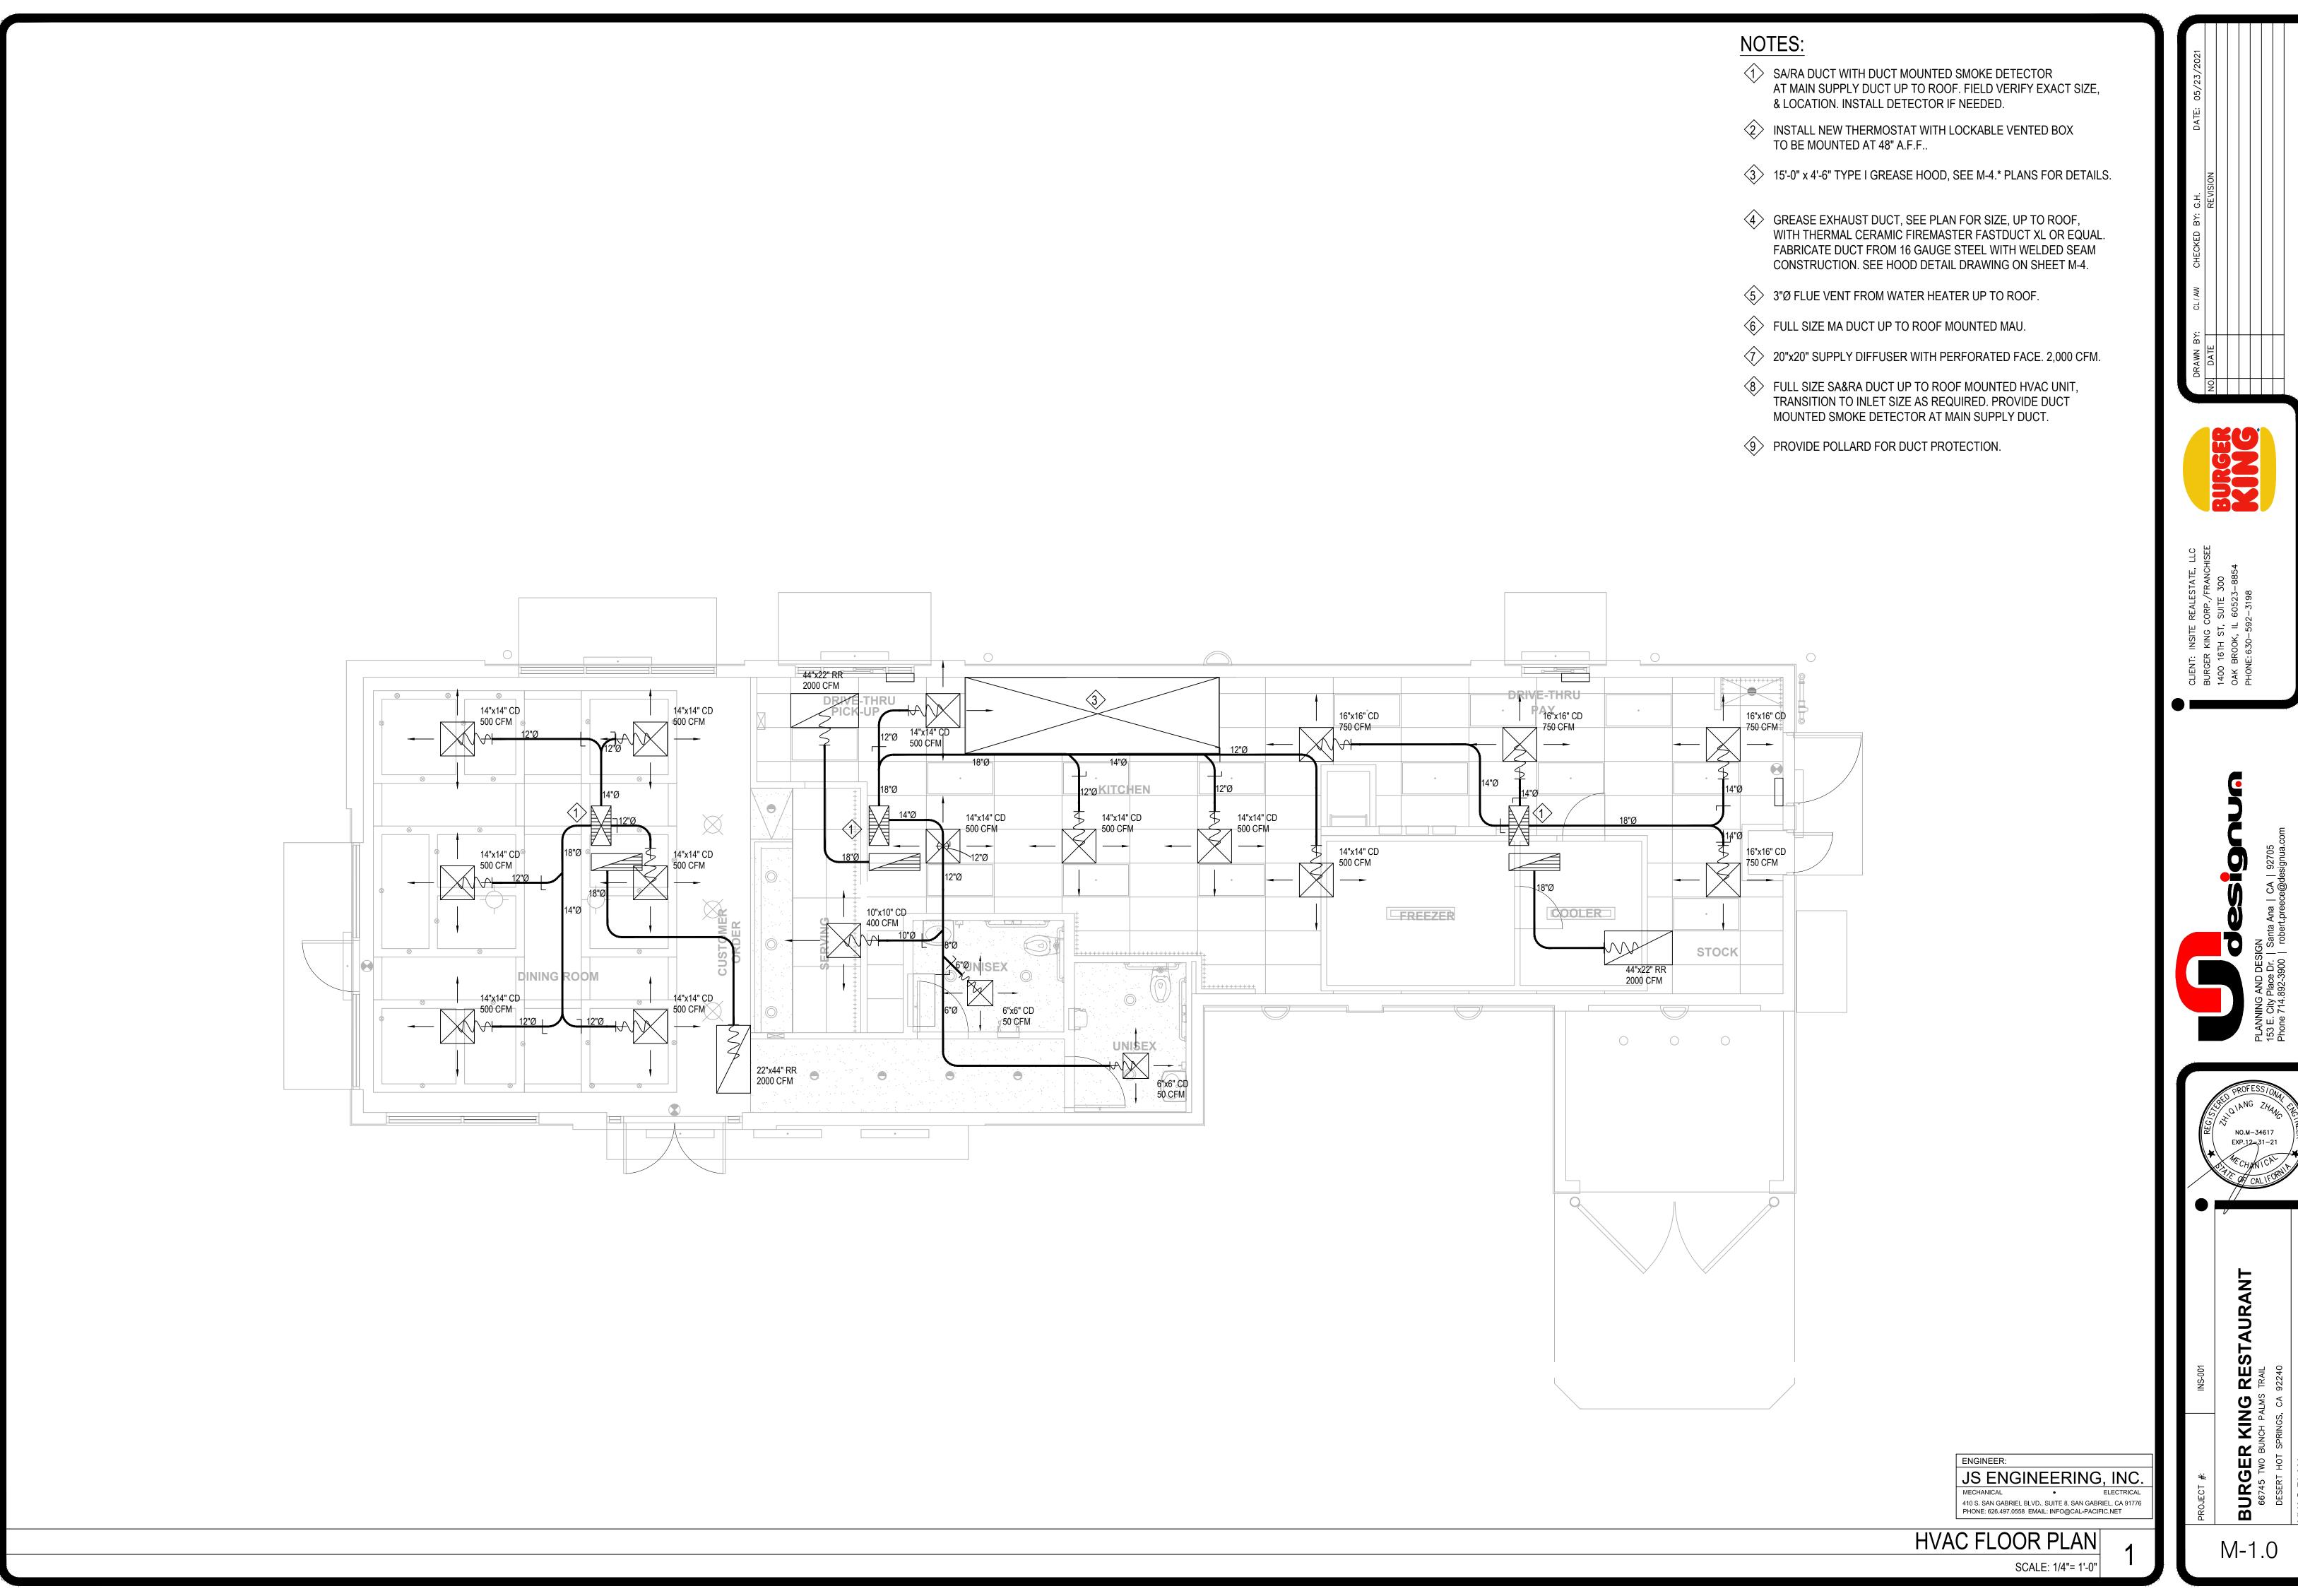

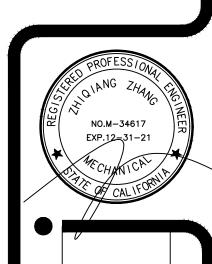

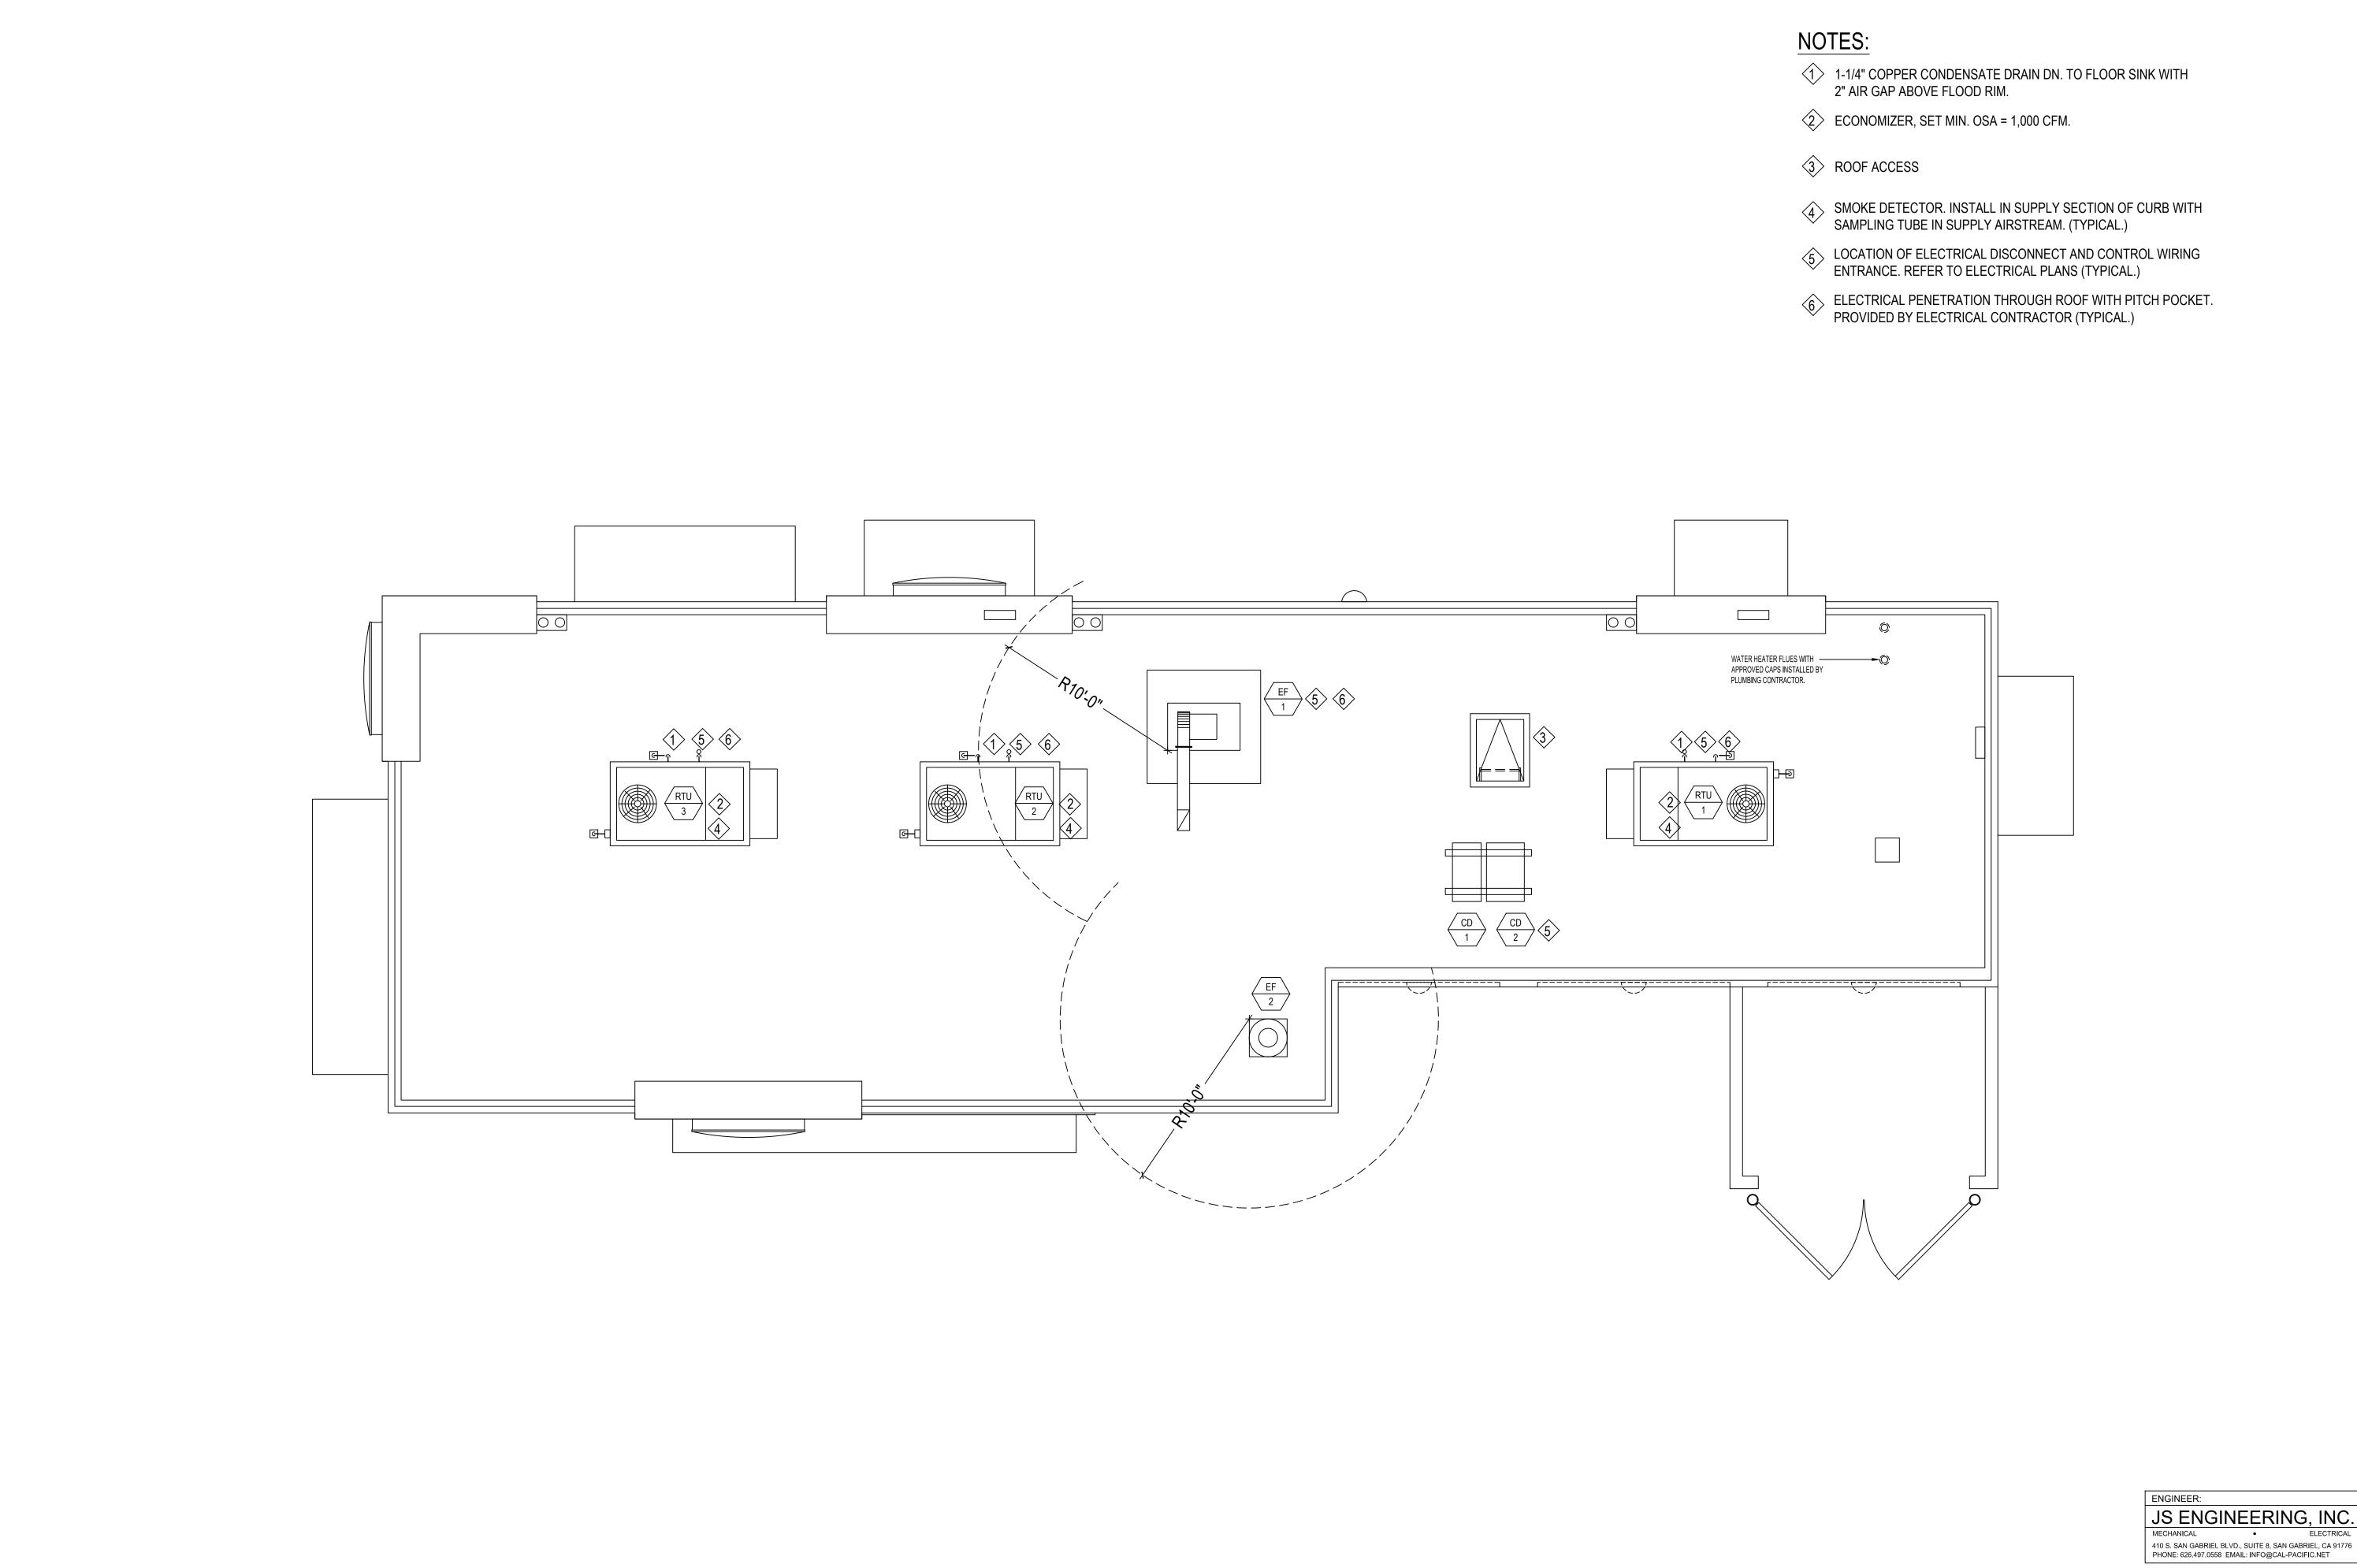

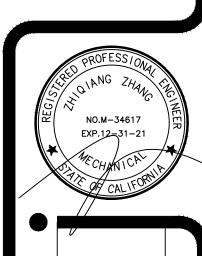

HVAC ROOF PLAN SCALE: 1/4"= 1'-0"

- . KITCHEN EXHAUST FANS SHALL BE ELECTRICALLY
- INTERLOCKED WITH AC UNIT. . FOR WIRING DIAGRAM, SEE FRANKE SHOP DWG

208V/3PH, BY E.C CIRCUIT BREAKER, BY E.C. DISCONNECT HOOD CONTROL PANEL SWITCH, BY E.C. AT KITCHEN -. — — — — — — — — — — — — — — — — ______ EXTRA RELAY -1/2" CONDUIT ONLY BY E.C., M.C. SHALL PULL LOW VOLTAGE WIRES PER AC UNIT MFR'S INSTRUCTIONS DUCT MOUNTED IONIZATION TYPE SMOKE DETECTOR ON AC UNIT RETURN DUCT MAINS TO SHUT DOWN UNIT IN CASE OF FIRE. SMOKE DETECTOR SHALL BE UL LISTED, SFM CERTIFIED, 24 VAC, BY ARRIER PROVIDED/CONTRACTOR EDWARDS, DH 500 HOUSING WITH 1551F STALLED THERMOSTAT. WALL ROOM T'STAT SENSOR OUNTED @+48" WITH LOCKING \bigcirc \bigcirc \bigcirc BY M.C. COVER. SEE FLOOR PLAN SHEET M-1.0 OR LOCATION -

AC CONTROL WIRING DIAGRAM

PLENUMIZED CURB INSTALLATION NOTES

I. CAREFULLY LOCATE AND MARK ROOF CURB LOCATIONS SO THAT DUCT WORK CAN BE INSTALLED IN THE APPROXIMATE LOCATIONS AS SHOWN BY THE FLOOR PLAN. PAY ATTENTION TO THE LOCATION OF THE ROOF STRUCTURE IN ORDER TO ACCOMMODATE THE DUCT DROPS.

2. MARK THE EXACT LOCATION OF EACH ROOF CURB. LAY OUT ALL EQUIPMENT LOCATIONS IN ORDER TO MAINTAIN PROPER CLEARANCES FROM EXHAUST FANS AND VENTS AS WELL AS PROVIDING FOR PROPER SERVICE CLEARANCES.

INSTALL ANY NECESSARY FRAMING OR BLOCKING AT OPENINGS. 4. WITH ROOF CURB UPSIDE DOWN (SOLID METAL BOTTOM UP) MEASURE AND MARK THE LOCATION OF ANY JOISTS OR OTHER FRAMING MEMBERS THAT MUST BE AVOIDED.

3. GENERAL CONTRACTOR SHALL CUT ROOF DECKING MATERIAL TAKING CARE TO AVOID CUTTING ANY STRUCTURAL COMPONENTS. GENERAL CONTRACTOR SHALL ALSO

MEASURE AND MARK THE LOCATION OF ALL THE DUCT TAPS. 5. CUT ALL DUCT TAPS INTO THE BOTTOM PANEL OF THE ROOF CURB. BE CAREFUL NOT TO DAMAGE THE ROOFING SURFACE WHILE MAKING THESE CUTS.

6. INSTALL DUCT TAP FITTINGS AND MANUAL DAMPERS INTO THE OPENINGS PREVIOUSLY CUT. SEAL ALL CONNECTIONS ON BOTH THE BOTTOM AND THE TOP SIDES OF THE

8. APPLY DUCT SEALER TO OPEN END OF COLLAR, SLIDE INNER CORE OF FLEXIBLE DUCT ONTO COLLAR, AND CONNECT PANDUIT STRAP PER MANUFACTURERS

7. FLATTEN TAB OF START COLLAR INSIDE CURB, TIGHT AGAINST INSULATION. SEAL INSIDE OF COLLAR AND TABS TO INSULATION USING MASTIC DUCT SEALER. ALLOW SEALER

9. SLIDE OUTER INSULATION SLEEVE OF FLEX TIGHT TO BOTTOM OF CURB. SEAL INSULATION TO BOTTOM OF CURB WITH PRESSURE-SENSITIVE FOIL TAPE, DO NOT USE TAPE MEANT FOR RIGID DUCTBOARD. SQUEEGEE OUT ALL AIR BUBBLES FOR PROPER ADHESION.

10. TURN CURB RIGHT SIDE UP, LEVEL CURB BETWEEN BOTTOM OF CURB AND DECK, INSTALL IN ROOF OPENING. SECURE CURB TO ROOF FRAMING AS REQUIRED.

11. GENERAL CONTRACTOR OR ROOFING CONTRACTOR SHALL FLASH AND ROOF IN THE CURB AS DETAILED ON THE DRAWINGS. 12. INSIDE BUILDING, THE DUCT RUNS SHALL BE INSTALLED FROM THE TAPS TO THE DIFFUSER LOCATIONS AS SHOWN ON THE PLANS. SUPPORT PER SMACNA AND LOCAL

13, NOTE: IF NECESSARY, FLEX DROPS MAY BE CONNECTED TO TAPS AFTER CURB HAS BEEN INSTALLED, REFER TO STEPS #8 AND #9.

		AIR E	BALANCE	SCHE	DULE	
TAG	SUPPLY AIR	OUTSIDE AIR	RETURN AIR	EXHAUST AIR	BLDG. PRESSURE	% OUTSIDE AIR
RTU-1	3000 CFM	1000 CFM	2000 CFM		+ 0 CFM	25
RTU-2	3000 CFM	1000 CFM	2000 CFM		+ 0 CFM	25
RTU-3	3000 CFM	1000 CFM	2000 CFM		+ 0 CFM	25
EF-1				2475 CFM	- 2475 CFM	
EF-2				300 CFM	- 300 CFM	
TOTAL	9000 CFM	3000 CFM	6000 CFM	2775 CFM	+ 2775 CFM	225
* NOTE: UPO	ON START-UP VERIF	Y THAT THE EXHAL	JST FAN CURRENT S	SENSOR IS SET TO T	HE MOTOR AMPERAGE.	F IT IS NECESSARY

TO ADJUST THE AMPERAGE OF THE EXHAUST HOOD FAN MOTOR, THE FAN MOTOR CURRENT SENSOR MUST BE RESET BY THE ELECTRICAL CONTRACTOR AS FOLLOWS: ADJUST UNDERCURRENT POTENTIOMETER TO MINIMUM (CLOCKWISE IS MAXIMUM.) APPLY CURRENT, ONCE CURRENT IS STABILIZED, INCREASE UNDERCURRENT POT UNTIL RED LED LIGHTS, WITHIN SEVEN SECONDS TURN DOWN UNTIL RED LIGHT TURNS OFF. IF A LIGHT REMAINS ON FOR MORE THAN TEN SECONDS, DISCONNECT SUPPLY VOLTAGE TO RESET. SEE MANUFACTURERS OPERATION-INSTALLATION INSTRUCTIONS THAT SHIP WITH THE FAN. WITH LIMITED BUILDING PRESSURE, THE ±10% TOLERANCE IS NOT ACCEPTABLE. SET CFM AS SPECIFIED. ENSURE THAT EXHAUST FAN PULLEY IS ADJUSTED. FOR PROPER ALIGNMENT.

wo Layers of FireMaster FastWrap XL Blanket for Grease Duct Enclosures

Min. 3" overlap on perimeter and between adjacent blanket on outside layer

Min. 1-1/2" x 1-1/2" x 1/8" angle or SMACNA Equivalent for Air Ventilation

Steel banding minimum 1/2" wide by 0.015" thick.

Min. 2" x 2" x 1/8" angle for Grease Duct Enclosures

Tight butt joints on inner layer

Min. 3/8" diameter hanger rod

Optional 6" FireMaster FastWrap XL collar


e integrity of Firemaster duct systems is limited to the quality of the installation

Duct Enclosures

One Layer of FireMaster FastWrap XL Blanket for Air Ventilation Duct Enclosures

Label Required "Access Door" Do Not Obstruct

FireMaster F2-HT-XL3 Door System

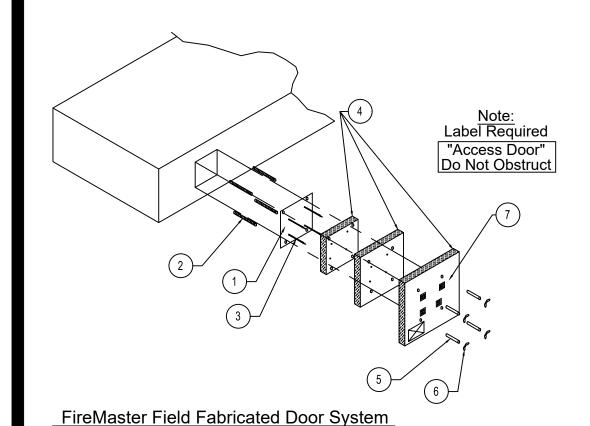


LEGEND DuctMate F2-HT Access Door or 16 Gage Field Fabricated Access Door. All Thread Rods. Installation Pins with Speed Clips Three Layers of FireMaster FastWrap XL Blanket with Minimum 1" Overlaps and All Edges Sealed with Aluminum Tape Spool Pieces for Threaded Rods Wing Nuts and Washers

Outer Cover Plate Labled "ACCESS DOOR - DO NOT OBSTRUCT" e integrity of the duct wrap insulation product is limited to the quality of the installation

THERMAL CERAMIC FIREMASTER ACCESS DOOR N.T.S.

10 1/2" **BUTT-JOINT/3"OVERLAP** BUTT-JOINT/COLLAR

LEGEND

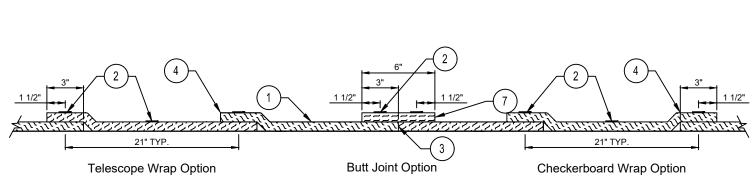

SINGLE LAYER OR OUTSIDE LAYER INSTALLATION OPTIONS

THERMAL CERAMIC FIREMASTER FASTWRAP XL

	T	T	T
TAG	EF-1	EF-2	EF-3
MANUFACTURER	COOK	COOK	COOK
MODEL	120 CPS	100 CPS	100C10DH
LOCATION	ROOF	ROOF	ROOF
AREA SERVED	BROILER	FRYERS	RESTROOM
CFM	1100*	800*	300
STATIC PRESSURE, "WG	1.85"	2.5"	0.25
FAN HORSEPOWER	1.0	1.0	1/25
FAN RPM	1957	2675	9833
DRIVE	BELT	BELT	DIRECT
ELECTRICAL REQUIREMENT, V/ø/HZ	208-230/1/60	208-230/1/60	120/1/60
ROOF OPENING, INCHES	22X22	22X22	13.5X13.5
ROOF CURB	YES	YES	YES
BACKDRAFT DAMPER	NO	NO	YES
BIRDSCREEN	NO	NO	YES
GREASE TROUGH	YES	YES	NO
DISCHARGE DESIGNATION	UP BLAST	UP BLAST	CENTRF. DOV
INTERLOCK	YES	YES	NO

NCA HVAC EQUIPMENT PACKAGE

NOTE: VERIFY ALL INFORMATION WITH MANUFACTURER PRIOR TO ORDERING AND INSTALLATION

PLAN AND SPECIFICATIONS AS PER P.E. SEAL

BURGER KING CORPORATION HAS A NATIONAL ACCOUNT AGREEMENT WITH THE NCA GROUP. NCA SHALL VISIT THE SITE, AS AUTHORIZED, TO VERIFY ALL MATERIALS, EQUIPMENT, AND INSTALLATION ARE PER THE PROFESSIONAL ENGINEER SEAL. PLANS ARE NCA DESIGN COPYRIGHT 2019.

FOR COMPLETE INFORMATION AND PRICING ON THE FOLLOWING PACKAGE OF EQUIPMENT AND ACCESSORIES CONTACT THE NCA GROUP MARKETING DEPARTMENT TOLL-FREE AT (877) 530-0078.

HEATING COOLING EQUIPMENT PACKAGE

INCLUDES ALL ROOFTOP (OR SPLIT SYSTEM) AIR CONDITIONING EQUIPMENT WITH ALL ACCESSORIES AS SPECIFIED ON THESE PLANS.

INCLUDES ALL FANS WITH ALL ACCESSORIES AS SPECIFIED ON THESE PLANS.

INSTALLATION PER THE PROPOSED DESIGN.

2. NCA PLENUMIZED CURB. TO ORDER CALL TOLL-FREE (877) 530-0078.

4. ADDITIONAL FOUR YEAR PARTS WARRANTY COVERING COMPRESSORS

3. ONE YEAR COMPLETE PARTS AND LABOR WARRANTY

5. SMOKE DETECTOR (SEE HVAC ROOF PLAN, SHEET M-1.1) 6. AQUAGUARD AG-3180E MOISTURE SENSOR FOR PRIMARY PAN

INCLUDES ALL GRILLES, REGISTERS AND DIFFUSERS PER PLANS, SQUARE TO ROUND TRANSITIONS PROVIDED WHERE REQUIRED,

INCLUDES ONE-PIECE, FULLY WELDED NCA PLENUMIZED ROOF CURBS FOR ALL ROOF MOUNTED HEATING/COOLING EQUIPMENT, AND ALL FAN CURBS. ALTERNATIVES T NCA PLENUMIZED CURBS MAY NOT BE USED.

NCLUDES EXHAUST FANS, HOODS, SHROUDS AND ANSUL SYSTEM, AS CODE REQUIRES.

INCLUDES PRESET DIGITAL THERMOSTATS, THERMOSTAT WIRE, LOCKING COVERS, AND AS CODE REQUIRES SMOKE DETECTORS AND AUDIBLE-VISUAL DEVICES; OCCUPIED/UNOCCUPIED PANEL, AND INTERLOCK PANEL, IF REQUIRED.

NOTE: "RE-ENGINEERING" DEVIATIONS FROM THE SHOWN DESIGN AND REQUIRED HVAC EQUIPMENT MUST BE APPROVED IN ADVANCE BY THE ARCHITECT AND PROFESSIONAL ENGINEER. UNAUTHORIZED SUBSTITUTIONS OR ALTERATIONS WILL VOID THE SIGNATURE AND SEAL OF THE PROFESSIONAL ENGINEER AND LEAVE VIOLATORS RESPONSIBLE FOR RESUBMISSION OF SIGNED AND SEALED DRAWINGS

AIR DEVICE SCHEDULE DUCT SIZE MODEL# | FINISH BOOT SIZE OPENING SIZE QTY. SYM. SIZE TYPE A* 24X24 SUPPLY 4 WAY 12"ø NCA12 WHITE 12"ø T-BAR B* 24X24 SUPPLY 2 WAY (PARALLEL) 12"Ø NCA12-2P WHITE 12"Ø T-BAR C* 24X24 SUPPLY 3 WAY 10"Ø NCA12-2C WHITE 10"Ø T-BAR <u>D* 24X24 SUPPLY 2 WAY (CORNER) 10"ø NCA10-3 WHITE 12"ø T-BAR</u> 6"ø 630 WHITE 12X12 SIZE + 1/4" 2 12X12 SUPPLY 1 WAY W/O.B.D. 24X24 RETURN <u>18"ø |630TB </u> WHITE 22X22 T-BAR 12X12 EXHAUST | WHITE | 12X12 | SIZE + 1/4" | 4 <u>J** | 26"ø | SUPPLY ROUND |</u> 12"ø** 3100-14** WHITE | 12X12 | SIZE + 1/4" 7 ALL DIFFUSERS SHALL BE MANUFACTURED BY METALAIRE OR EQUIVALENT AND 100% ALUMINUM

* PROVIDE WITH PVCR9 SLIDING-BLADE DAMPER AND THREE 24X24 LAY-IN FRAMES FOR INSTALLATION IN SHEETROCK CEILING

** PROVIDE WITH SEVEN 14"Ø-TO-12"Ø REDUCERS FOR INSTALLATION ON TOP OF DIFFUSERS NOTE: LOCATION AND ORIENTATION OF DIRECTIONAL BLOW PATTERN DIFFUSERS IN THE KITCHEN IS CRITICAL. INSTALLER WILL ENSURE PROPER INSTALLATION OF DIFFUSERS. CONTACT THE NCA CONSULTANTS PROJECT COORDINATOR IMMEDIATELY WITH ANY CONFLICTS THAT PREVENT

PACKAGE ROOFTOP UNIT SCHEDULE (RTU-1,2,3) CARRIER MANUFACTURER 48HCED08 (7.5 TON) LOCATION, CURB DIMENSIONS ROOF, 88" X 60" TYPE OF HEAT NATURAL GAS TOTAL COOLING CAPACITY, MBTU/HR SENSIBLE COOLING CAPACITY, MBTU/HR ENTERING AIR CONDITIONS, DB°F/WB°F AMBIENT AIR DB TEMPERATURE, °F SUPPLY AIR, CFM SEE SCHEDULE OUTSIDE AIR, CFM EXTERNAL STATIC PRESSURE, "WG BHP - MEDIUM STATIC MOTOR GAS INPUT MBTU/HR GAS OUTPUT MBTU/HR UNIT WEIGHT, LBS. ELECTRICAL REQUIREMENT, V/PHASE/HZ 208-230/3/60 MINIMUM CIRCUIT AMPERAGE MAXIMUM OVER CURRENT PROTECTION ACCESSORIES:
1. 100% ECONOMISER WITH BAROMETRIC RELIEF

NOTE: COORDINATE RTU PLACEMENT ON SITE PRIOR TO SETTING EQUIPMENT. IF ADJUSTMENT IS NECESSARY MAINTAIN FRESH AIR INTAKE CLEARANCES

HVAC SYSTEM



CONSULTANTS/GROUP NATIONAL CORPORATE ACCOUNT SERVICES, INC.

DRAWINGS SHOWN ARE FOR PROTOTYPICAL CONSIDERATIONS ONLY. SITE—SPECIFIC DESIGN IS REQUIRED BY BURGER KING CORPORATION. AS A COURTESY, NCA CONSULTANTS PROVIDES SITE—SPECIFIC DESIGN WITH SITE—SPECIFIC PROFESSIONAL ENGINEER SEAL UNDER AN AGREEMENT BETWEEN NCA CONSULTANTS AND BURGER KING CORPORATION.

FOR SITE-SPECIFIC DESIGN, ARCHITECTS EMAIL REFLECTED CEILING PLAN, ELEVATIONS, KITCHEN PLANS, FLOOR PLAN, SITE PLAN, EXTERIOR ELEVATIONS, AND ROOF STRUCTURAL PLAN I DESIGN@NCACONSULTANTS.COM

TO CONTACT THE NCA CONSULTANTS BY PHONE, CALL TOLL-FREE (877) 530-0078.

ATTENTION GENERAL CONTRACTOR: "RE-ENGINEERING" DEVIATIONS FROM THE SHOWN DESIGN AND REQUIRED HVAC EQUIPMENT MUST BE APPROVED IN ADVANCE BY THE ARCHITECT AND PROFESSIONAL ENGINEER, UNAUTHORIZED SUBSTITUTIONS OR ALTERATIONS WILL VOID THE SIGNATURE AND SEAL OF THE PROFESSIONAL ENGINEER AND LEAVE VIOLATORS RESPONSIBLE FOR RESUBMISSION OF SIGNED AND SEALED DRAWINGS.

CONTRACTORS NOTES

1. THE HVAC CONTRACTOR SHALL FURNISH AND INSTALL THE HVAC SYSTEM AS SHOWN IN THE NCA HVAC EQUIPMENT PACKAGE NOTE, THIS SHEET. ALL FANS SHALL BE U.L. LISTED. 2. THE HVAC CONTRACTOR SHALL INSTALL THE EXHAUST HOOD, REFER TO MOST RECENT KITCHEN PLANS ON SITE, HOOD EXHAUST DUCT IS FACTORY-MANUFACTURED, NON-WELD.

DOUBLE-WALLED DUCT WITH ZERO-CLEARANCE TO COMBUSTIBLES RATING. MANUFACTURED BY METAL-FAB. INSTALL ALL HOOD EXHAUST DUCT PER MANUFACTURERS PUBLISHED REQUIREMENTS THAT SHIP WITH THE DUCTWORK, VERIFY LOCATION ON SITE WITH MOST RECENT KITCHEN EQUIPMENT PLAN. 3. ALL AIR CONDITIONING UNIT CURBS SHALL BE SUPPLIED BY NCA CONSULTANTS.

4. ALL AIR CONDITIONING UNIT CURBS SHALL BE FABRICATED BY NCA CONSULTANTS FROM 18 GA. GALVANIZED METAL WITH WELDED SEAMS, WATER TIGHT AND INTERNALLY INSULATED. 5. SHIMS SHALL BE PROVIDED BY HVAC CONTRACTOR BETWEEN THE ROOF DECK AND THE CURB AS NEEDED TO COMPENSATE FOR ROOF PITCH.

6. ALL FLEX DUCT SHALL BE FOIL-BACKED, R-6. U.L. LISTED, CLASSIFIED AS A CLASS 1 AIR DUCT, AND MEET LOCAL CODE REQUIREMENTS.

7. EXCLUDING ANY EXPOSED DUCTWORK, ALL NON-FLEXIBLE DUCT AND ALL AIR DISTRIBUTION DEVICES SHALL BE INSULATED WITH R-6, 2" X .75 DENSITY FOIL-BACKED INSULATION, WITH FIRE AND SMOKE RATING [25]-[50].

8. ALL DUCTWORK SHALL BE INDEPENDENTLY HUNG FROM STRUCTURAL MEMBERS. 9. ALL DUCTWORK SHALL BE FABRICATED AND INSTALLED PER SMACNA LOW-VELOCITY DUCT MANUAL (LATEST ISSUE).

10, UNLESS OTHERWISE NOTED, EVERY SUPPLY TAP COLLAR SHALL HAVE A LOCKING MANUAL VOLUME DAMPER.

11. THE HVAC CONTRACTOR SHALL COORDINATE DIFFUSER LOCATIONS ON SITE WITH THE MOST RECENT REFLECTED CEILING PLAN.

12. THE HVAC CONTRACTOR SHALL FURNISH A WRITTEN GUARANTEE COVERING A ONE-YEAR PERIOD FOR ALL EQUIPMENT AND AN ADDITIONAL FOUR-YEAR PERIOD FOR THE COMPRESSORS IN THE AIR CONDITIONING UNITS.

13, UPON COMPLETION OF PROJECT THE HVAC CONTRACTOR SHALL HIRE AN A.A.B.C. OR N.E.B.B. CERTIFIED, INDEPENDENT TEST AND BALANCE COMPANY TO CONDUCT A COMPLETE, CERTIFIED TEST AND BALANCE OF ALL HVAC EQUIPMENT. PROVIDE A WRITTEN REPORT TO NCA CONSULTANTS. ALL CAPACITIES MUST BE SET TO AMOUNTS INDICATED ON THE FLOOR 14. THE HVAC CONTRACTOR SHALL VERIFY LOCATIONS OF THE EXHAUST HOOD AND EF-1 FROM MOST RECENT KITCHEN EQUIPMENT PLANS ON SITE. THIS IS TO ENSURE NO OFFSETS IN

15. HVAC CONTRACTOR IS TO MAKE ALL LOW-VOLTAGE WIRING FINAL CONNECTIONS FOR ALL HVAC EQUIPMENT INCLUDING SENSORS, THERMOSTATS, AUDIO-VISUAL ANNUNCIATORS,

ROOF-TOP UNITS, SMOKE DETECTORS, CONTACTOR PANEL, AND CONTROL PANEL.

1. IT IS THE RESPONSIBILITY OF THE GENERAL CONTRACTOR TO RECEIVE, OFFLOAD, AND STORE ALL HVAC MATERIALS WHICH ARRIVE AT THE JOB SITE. JOINT EFFORT BETWEEN G.C. AND M.C. SHALL BE UNDERTAKEN TO POSITION HOODS IN THE KITCHEN, FOR INSTALLATION.

2. IT IS VERY IMPORTANT THAT ACCURATE MEASUREMENTS ARE USED WHEN LOCATING EXHAUST FAN ROOF OPENING TO ENSURE THAT NO OFFSETS ARE REQUIRED IN THE EXHAUST DUCTWORK FROM THE KITCHEN HOOD. COORDINATE ROOF OPENINGS WITH THE KITCHEN EQUIPMENT PLAN AND EXHAUST HOOD PLANS, OBTAIN THE CORRECT PLANS FROM THE KITCHEN

3. RTU ROOF OPENING SIZES AND ROOF CURBS ARE BASED ON EQUIPMENT SHOWN, IF OTHER EQUIPMENT IS USED, VERIFY ROOF OPENING REQUIREMENTS, MAKE PENETRATION AS NEEDED FOR INSTALLATION OF NEW CURB AND RTU. COORDINATE ON SITE WITH HVAC CONTRACTOR, ENSURE THAT ROOFING MATERIAL DOES NOT COVER THE TOP OF ANY HVAC

4. ANY FRAMING REQUIRED FOR HVAC WORK SHALL BE BY THE GENERAL CONTRACTOR.

5. GENERAL CONTRACTOR IS TO PROVIDE ANY SCREENING, GUARD RAILS, ETC. FOR ROOF-MOUNTED HVAC EQUIPMENT PER IBC AND LOCAL CODES. 6, ANY EXPOSED HVAC WORK IN THE DINING ROOM IS TO BE PREPARED, PRIMED, AND PAINTED BY THE GENERAL CONTRACTOR.

7. NOTE: EXCLUDING THE DUCT THAT SHIPS WITH THE HOODS, THE EXHAUST RISERS CANNOT HAVE ADDITIONAL, 'FIELD' OFFSETS. TRUSSES CLOSEST TO THE EXHAUST RISERS MUST BE SPACED SO THAT NO ADDITIONAL OFFSETS ARE NEEDED. FIELD VERIFY AND COORDINATE WITH GENERAL CONTRACTOR.

ELECTRICAL CONTRACTOR 1. THE ELECTRICAL CONTRACTOR SHALL FURNISH AND INSTALL PITCH POCKETS FOR POWER AND CONTROL WIRING TO MAINTAIN 12" MINIMUM CLEARANCE FROM BACK PANEL OF AIR CONDITIONING UNITS AND EXHAUST FANS. ELECTRICAL CONTRACTOR SHALL NOT PENETRATE BOTTOM OF RTU CURB AND EXHAUST FANS.

2. THE ELECTRICAL CONTRACTOR SHALL INSTALL THE CONTACTOR PANEL, ON-OFF PANEL, AND LOW-VOLTAGE CONTROL WIRING FOR ALL AIR CONDITIONING UNITS AND CONTROLS. COORDINATE AIR CONDITIONING AND ELECTRICAL PLANS, REFER TO SHEET E-5 FOR PANEL INFORMATION. FOR PROJECTS WITHOUT A PANEL THE ELECTRICAL CONTRACTOR WILL INTERLOCK THE COOKING APPLIANCE AND HVAC EQUIPMENT PER NFPA96.

3. THE ELECTRICAL CONTRACTOR SHALL FURNISH AND INSTALL DISCONNECTS FOR ALL HVAC EQUIPMENT.

USED, PROVIDE ADDITIONAL RECEPTACLES IN MANAGERS OFFICE FOR THERMOSTATS.

4. THE ELECTRICAL CONTRACTOR SHALL USE A MINIMUM OF 4-6" SEALTITE FLEXIBLE CONDUIT WHEN WIRING KITCHEN HOOD EXHAUST FANS ON ROOF SO THAT FANS MAY BE REMOVED FROM CURBS AND PLACED ON ROOF FOR CLEANING EXHAUST DUCTWORK. 5. THE ELECTRICAL CONTRACTOR SHALL PROVIDE ANY ADDITIONAL INTERLOCK REQUIRED BY LOCAL CODE BETWEEN THE HVAC EQUIPMENT, SMOKE DETECTORS, EXHAUST FANS, AND

6. ELECTRICAL CONTRACTOR SHALL RUN LINE VOLTAGE FROM THE CURRENT SENSOR LOCATED IN THE GREASE EXHAUST FAN TO THE CONTACTOR PANEL LOCATED BY THE SWITCHGEAR. FOR EACH UNIT. THE ELECTRICAL CONTRACTOR SHALL PROVIDE ONE SINGLE-GANG RECEPTACLE FOR THE THERMOSTAT AND/OR REMOTE SENSOR. AND ONE DOUBLE-GANG RECEPTACLE FOR THE ANNUNCIATOR AND TEST STATION, WITH GREEN AND RED LIGHT INDICATORS, THE FIRE AND MECHANICAL INSPECTORS WILL DETERMINE SUITABLE LOCATION FOR TEST STATIONS, ANNUNCIATORS AND TEST STATION WILL BE LOOPED IN THE CIRCUITRY OF THE SMOKE DETECTION DEVICES, WIRING WILL BE INSTALLED BY ELECTRICAL CONTRACTOR, IF

PLUMBING CONTRACTOR 1. THE PLUMBING CONTRACTOR IS TO PROVIDE AND INSTALL PITCH POCKETS FOR CONDENSATE DRAINS/GAS PIPING FOR ALL A/C UNITS AND EXHAUST FANS, PLUMBING CONTRACTOR SHALL NOT PENETRATE BOTTOM OF RTU CURB

2. THE PLUMBING CONTRACTOR TO COORDINATE PLUMBING VENT STACKS WITH OUTSIDE AIR INTAKES OF A/C UNITS. MAINTAIN 10'-0" MINIMUM CLEARANCE OR PER LOCAL CODE. 3. THE PLUMBING CONTRACTOR SHALL PROVIDE AND INSTALL FLUE GAS EXHAUST VENT FOR WATER HEATER. MAINTAIN 10'-0" MINIMUM HORIZONTAL OR 3' VERTICAL CLEARANCE TO AIR

 \bigcirc Copyright 2019- Drawings, specifications, notes, database, computer files, field data, and reports as instruments of service prepared by the Design of Record. As instruments of services, these items remain the property of the Design of Record, who shall retain all statutory and other reserved rights, including the copyright thereto. Any use, reproduction or changes to these documents without written consent of NCA Consultants is a violation of federal copyright laws.


JS ENGINEERING, INC.

PHONE: 626.497.0558 EMAIL: INFO@CAL-PACIFIC.NET

410 S. SAN GABRIEL BLVD., SUITE 8, SAN GABRIEL, CA 91776



M-2.0

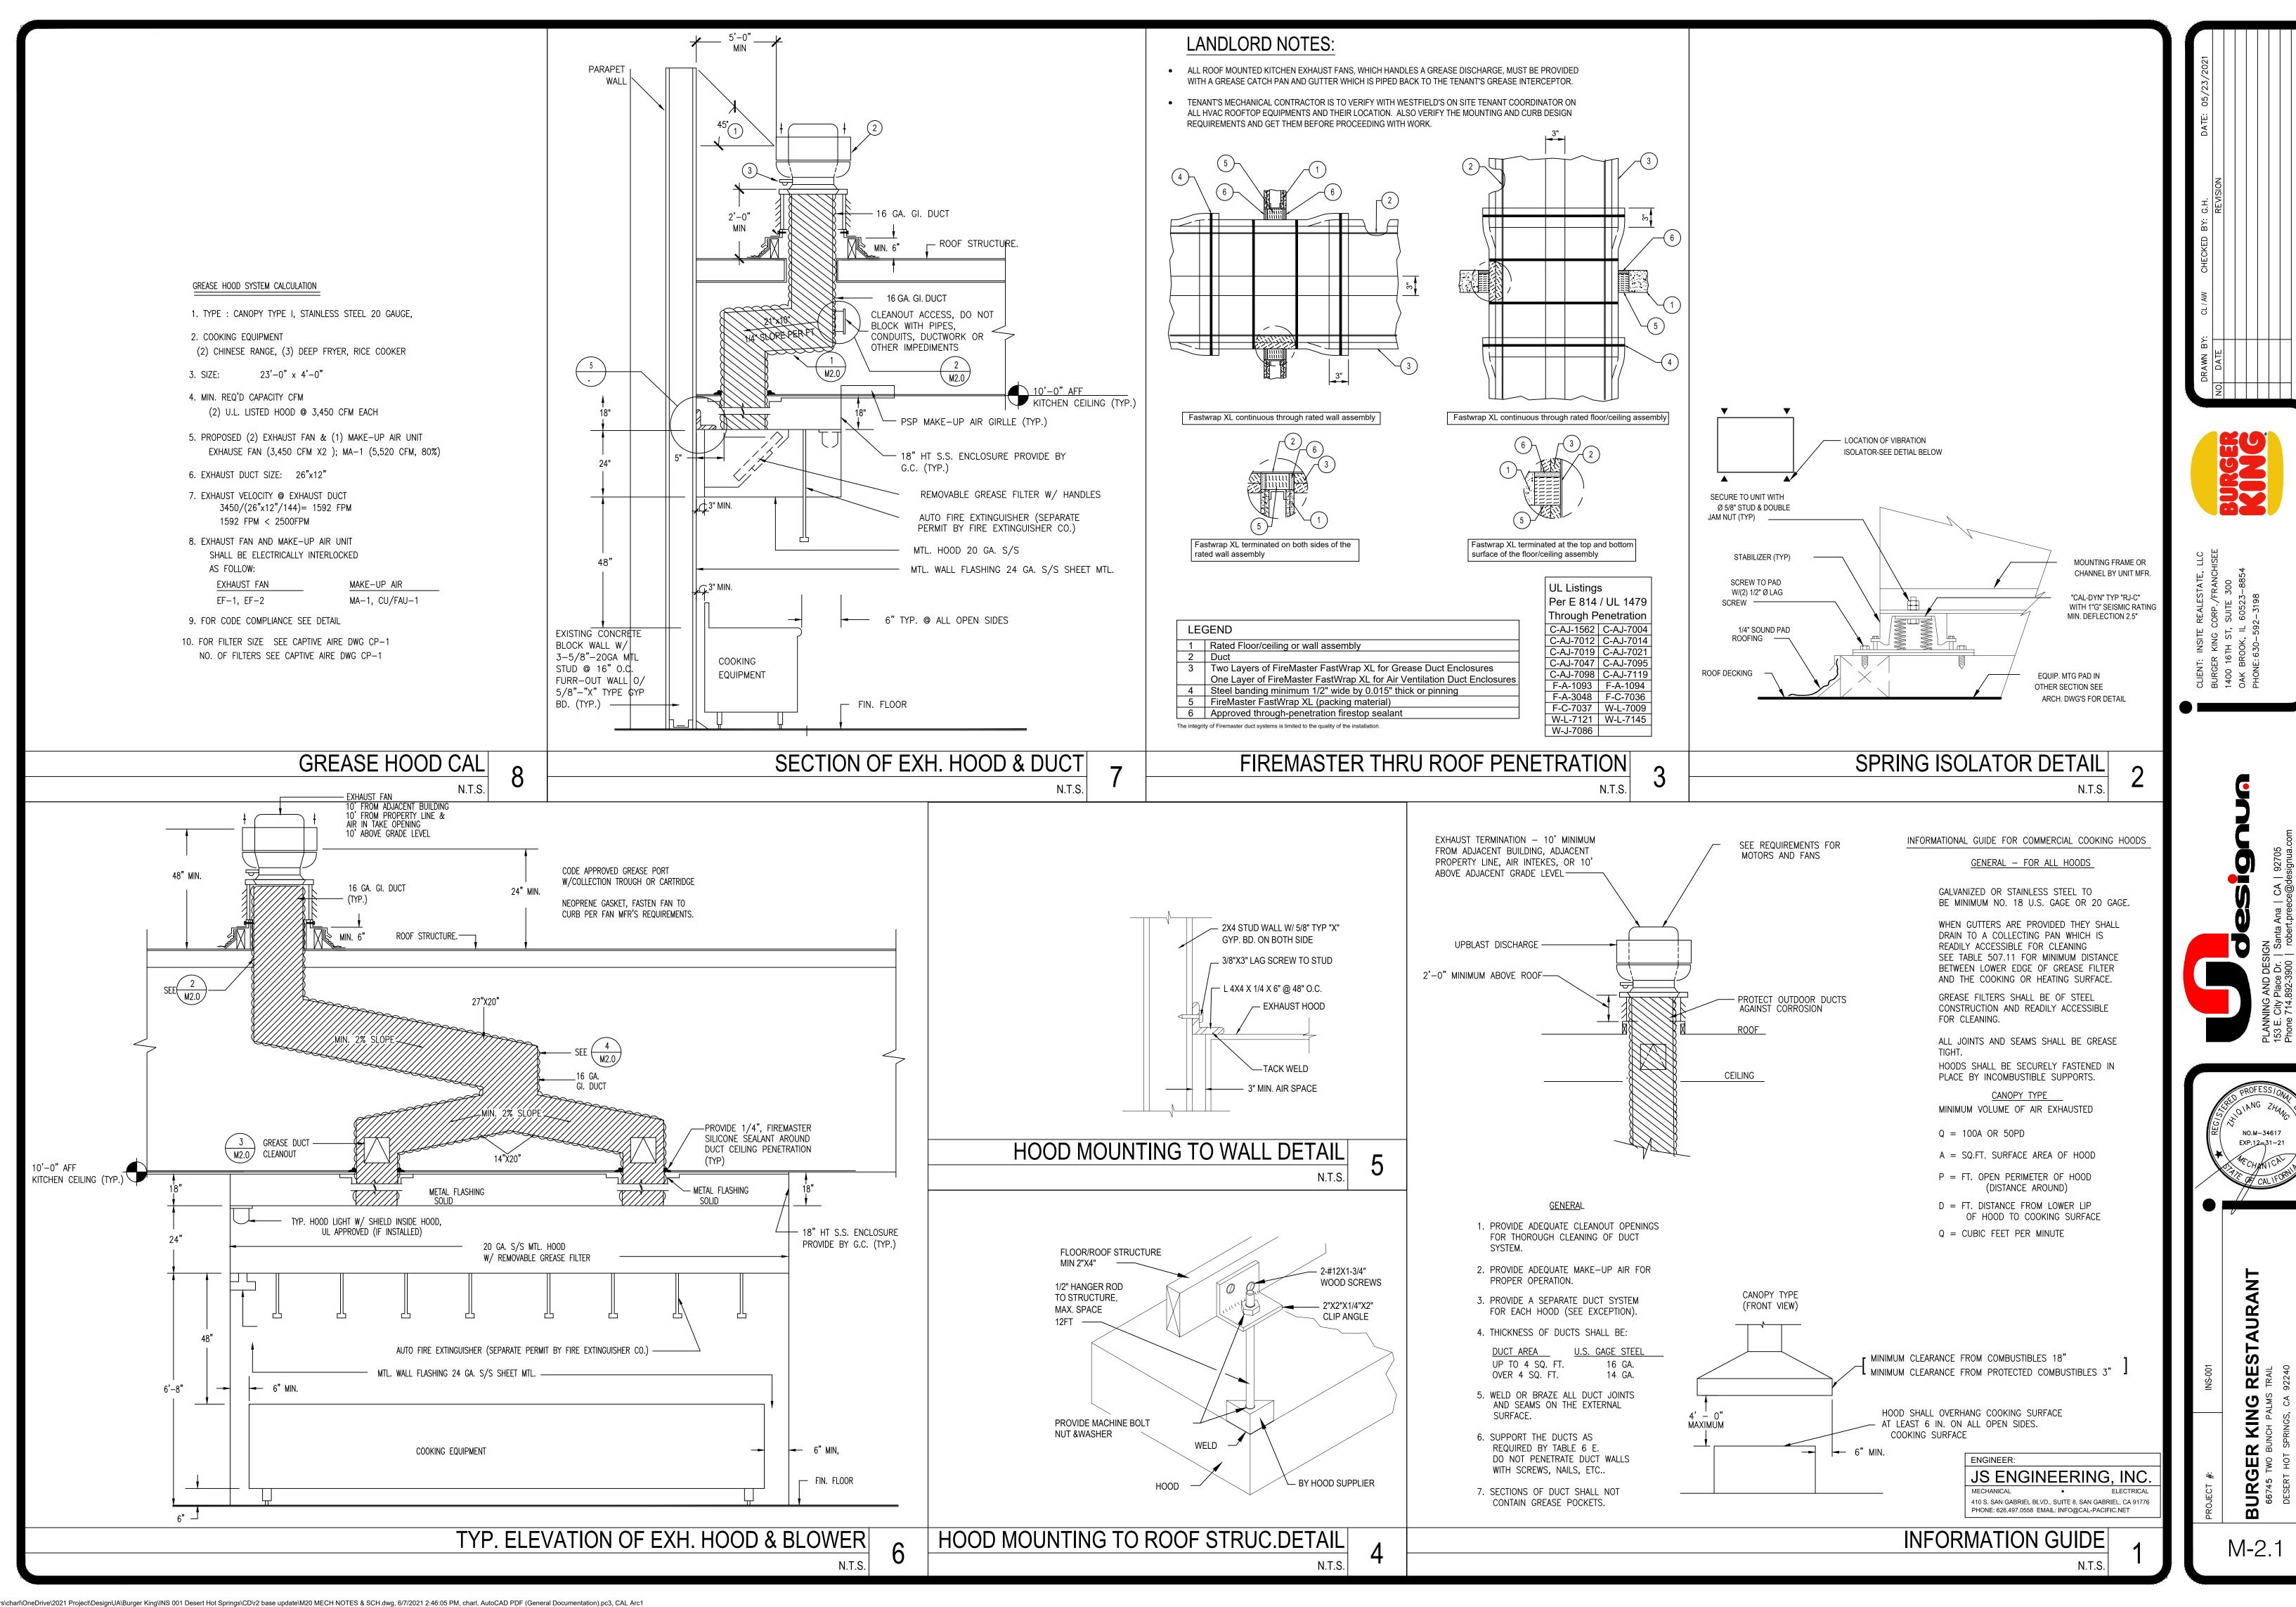

Project Address: 66745 T Input File Name: BK DHS. K9. EVAPORATIVE COOLER SUI This Section Does Not Apply L. DOMESTIC/SERVICE HOT WA L1. DHW EQUIPMENT SUMMA 1 2 DHW Name Heater Elen Type	TER SYSTEM SUMMAR		PRING 92240	6	alculation Date/Tii	me: 15:39, Wed	, May 19, 2021		
DHW Name	ent Tank Tyne		1	-	7	8	9	10	11
	Turk Type	Qty	Tank Vol (gal)	Rated Input (kBtu/h)	Efficiency	Tank Insulation R-value (Int/Ext)	Standby Loss Fraction	Heat Pump Type	Tank Location or Ambient Condition
RINNAI RU98i2 Gas	Instantaneous	2	1.00	199	UEF: 0.95	NA	SBLF: NA	NA	NA
LO BALLITI FARALIV CENTRAL DI	NAV CVCTERA DETAIL C								
L2. MULTI-FAMILY CENTRAL DE	IW SYSTEM DETAILS								
This Section Does Not Apply									
L3. SOLAR HOT WATER HEATIN	G SUMMARY								
This Section Does Not Apply									
M. COVERED PROCESS SUMMA	ARY §140.9								
This Section Does Not Apply									
N. INDOOR LIGHTING SUMMA	RY §140.6								
This Section Does Not App	ılv								
This section Boes Not App	···								

Project Name:	BURGER KING RESTAURANT				NRCC-PRF-01-E	Page 8 of 12			
Project Address:	6674'5 TWO BUNCH PALM TR	AIL DES	ERT HO	OT SPRING 92240	Calculation Date/Time:	15:39, Wed, May 19, 2021			
Input File Name:	BK DHS.cibd19x								
O. DECLARATION C	OF REQUIRED CERTIFICATES OF	INSTA	LLATIC	DN					
compliance. These	documents bust be retained an	d prov	ided to	Author to indicate which Certifi o the building inspector during c oliance_documents/Nonresiden	construction and can be	st be submitted for the features to be recognize found online at:	ed for		
Buile	ding Component	YES	NO		Form/Tit	le	Insp	eld ector	
	Formier			NIDCLENIA OLE MANALES IN THE	- d £ II b !! d!		Pass	Fail	
	Envelope Mechanical		\Box	NRCI-ENV-01-E - Must be submitted NRCI-MCH-01-E - Must be submitted NRCI-M			믐	片	
	Mechanical		<u> </u>	NRCI-PLB-01-E - Must be submitte			片	H	
		-	-			and hotel/ motel central hot water distribution	├─	┝	
	Plumbing				systems to be recognized for comp		and notely motel central not water distribution		
			Ø	NRCI-PLB-03-E - Must be submitted for high-rise residential and hotel/motel single dwelling unit hot water system distribution systems to be recognized for compliance					
			\boxtimes	NRCI-PLB-21-E - Must be HERS ver	rified for central systems ir	n high-rise residential hotel/ motel application			
			×	NRCI-PLB-22-E - Must be HERS ver application	rified for single dwelling ur	nit systems in high-rise residential, hotel/motel			
			\boxtimes	NRCI-STH-01-E - Must be submitte	ed for solar hot water heat	ing systems			
			\boxtimes	NRCI-LTI-01-E - Must be submitted	d for all buildings				
			×	NRCI-LTI-02-E - Must be submitted (EMCS) to be recognized for comp		em, or for an Energy Management Control System			
Ir	ndoor Lighting		×	NRCI-LTI-04-E - Must be submitted conference room, a multipurpose		ms serving an auditorium, a convention center, a ecognized for compliance			
			\boxtimes	NRCI-LTI-05-E - Must be submitted	d for a Power Adjustment I	Factor (PAF) to be recognized for compliance			
			×	NRCI-LTI-06-E - Must be submitted recognized for compliance	d for additional wattage in	stalled in a video conferencing studio to be			
Co	overed Process	П	Ø	NRCI-PRC-01-E - Must be submitte	ed for all Covered Processe	es .	П	П	

Project Name:	BURGER KING RESTAURANT			NRCC-PRF-01-I		Page 9 of 12		
Project Address:	6674'5TWO BUNCH PALM TF	AIL DES	ERT H	OT SPRING 92240 Calculation Da	te/Time:	15:39, Wed, May 19, 2021		
Input File Name:	BK DHS.cibd19x							
P. DECLARATION O	F REQUIRED CERTIFICATES OF	ACCEP	TANCE					
compliance. These o Provider (ATTCP). Fo	documents must be provided t or more information visit:https	o the b	uilding	Author to indicate which Certificates of Accep i inspector during construction and must be co gy.ca.gov/title24/2019standards/2019_comp	mpleted	through an Acceptance Test Technician Ceri cuments/Nonresidential_Documents/NRCA	tification	ield ector
Bulle	aing Component	YES	NO		Form/ IIt	le	Pass	Fail
Envelope				NRCA-ENV-02-F - NRFC label verification for fenes	tration			
	Envelope		NRCA-ENV-03-F - Daylighting Design PAFs					
		\boxtimes	NRCA-LTI-02-A - Occupancy Sensors and Automatic Time Switch Controls					
In	ndoor Lighting		\boxtimes	NRCA-LTI-03-A - Automatic Daylight Controls				
""	ECLARATION OF REQUIRED CERTIFICATES Of a Instructions: Selections shall be made by I pliance. These documents must be provided ider (ATTCP). For more information visit:htt		\boxtimes	NRCA-LTI-04-A - Demand Responsive Lighting Con	trols			
			\boxtimes	NRCA-LTI-05-A - Institutional Tuning Power Adjust	ment Fact	or (PAF)		
			\boxtimes	NRCA-PRC-02-F - Kitchen Exhaust				
			\boxtimes	NRCA-PRC-03-F - Garage Exhaust				Τ⊏
Co	worod Process		\boxtimes	NRCA-PRC-12-F – Elevator Lighting and Ventilation	n Controls			
CC	overed Process		\boxtimes	NRCA-PRC-13-F –Escalator and Moving Walkways	Speed Co	ntrol		
			×	NRCA-PRC-14-F — Lab Exhaust Ventilation System				
			Ø	NRCA-PRC-15-F - Fume Hood Automatic Sash Clos	ures Syste	em .	\neg	ТЕ

CA Building Energy Efficiency Standards- 2019 Nonresidential Compliance Report Version: NRCC-PRF-01-E-04282020-6206

CA Building Energy Efficiency Standards- 2019 Nonresidential Compliance Report Version: NRCC-PRF-01-E-04282020-6206

Report Generated at: 2021-05-19 15:39:35

Report Generated at: 2021-05-19 15:39:35

roject Name:	BURGER KING	RESTAURANT	N	RCC-PRF-01-E	Page 4 o	f 12				
roject Address:	6674'5TWO BL	JNCH PALM TRAIL DESERT H	OT SPRING 92240 Ca	alculation Date/Tim	e: 15:39, W	/ed, May 19, 2	021			
put File Name:	BK DHS.cibd19	ix								
ENVELOPE DETAIL	C 5120 7 9 5140	2								
. OPAQUE SURFACE										
1	AGGENTIDET GOTVITA	2	3	4	5	6	7	8		
Surface I	Name	Surface Type	Description of Assembly Layers	Area (ft²)	Framing Type	Cavity R-Value	,		Continuous R-Value	U-Factor / F-Factor / C-Factor
R-30 Roof F	AFTER8	Roof	Asphalt shingles - 1/4 in. Vapor permeable felt - 1/8 in. Plywood - 1/2 in. Air - Ceiling - 3/4 in. Wood framed roof, 16in. OC, 9.25ii R-30 Gypsum Board - 1/2 in.	2080 n.,	Wood	30	NA	U-Factor: 0.035		
Slab On G	rade10	UndergroundFloor	Slab Type = UnheatedSlabOnGrade groundFloor Insulation Orientation = None 2080 NA C Insulation R-Value = R0			0	NA	F-Factor: 0.730		
R-21 Wa	all12	ExteriorWall	Stucco - 7/8 in. Vapor permeable felt - 1/8 in. Metal framed wall, 24in. OC, 7.25ii R-22 Gypsum Board - 1/2 in.	n., 2640	Metal	22	NA	U-Factor: 0.149		

12. OVERHANG DETAILS	
This Section Does Not Apply	
13. OPAQUE DOOR SUMMARY	
This Section Does Not Apply	
J. CRRC ROOFING PRODUCT SUMMARY S140.3	
This Section Does Not Apply	
K. HVAC SYSTEM SUMMARY §110.1 & §110.2	

CA Building Energy Efficiency Standards- 2019 Nonresidential Compliance	Report Version: NRCC-PRF-01-E-04282020-6206	Report Generated at: 2021-05-19 15:39

Project Name:	BURGER KIN	g restauran	Т			N	IRCC-PRF-01-E		Page 5 of 12			
Project Address:	6674'5 TWO	BUNCH PALM	TRAIL DE	SERT HOT SPRI	NG 92240	C	alculation Date	e/Time:	15:39, Wed, May	19, 2021		
Input File Name:	BK DHS.cibd	19x										
K1. Dry System Eq	uipment (furnac	es. air handl	ing units	. heat pumps	s. VRF. etc	:.)						
				• • •	<u> </u>	an & Economizer inf	fo included bel	ow in Tal	ole N)			
1	2		3	4		5	6		7 8		9	10
						Heati	ing			Coo	ng	
Equipment Name	Equipme	nt Type	Qty	Total Heating (kBtu/		Supp Heat Source (Y/N)	Supp Heat O (kBtuh)		Efficiency	Total Cooling Output (kBtu/h)	Efficiency	Status
AC-1 AC-2 AC-3	SZAC (Packa	ged3Phase)	3	59		No	0		AFUE-82.0	83	EER-11.0	N
1	& FAN SYSTEMS	SUMMARY 9	§140.4¹ 4	5	6	7	8	9	10	11	12	<u> </u>
	System Type	Design OA		S	upply Fan	•			Return Fan		Facultina To	
Name or Item Tag	packaged, DOAS etc.	, CEW	CFM	ВНР	Watts	Control	CFM	ВНР	Watts	Control	Economizer Ty (if present)	=
	+	_		4	843.5	ConstantVolum	e NA	NA	NA.	NA NA	NoEconomize	r
AC-1 AC-2 AC-3	SZAC	347	3000	1.000	043.3	Constantivolum	c I IVA	1 ""	1	1 11/1		
		347	3000	1.000	645.5	Constantivolum		107		147		
Status: N - New, A – Altero	ed, E – Existing	347	3000	1.000	645.5	Constantivolum	e NA	10.0				
Status: N - New, A – Altero	ed, E – Existing	347	3000	1.000	045.3	Constantivolum	e NA	1 1111				
Status: N - New, A - Altere	SUMMARY	347	3000	1.000	045.3	Constantivolum	e NA					
AC-1 AC-2 AC-3 Status: N - New, A - Altere K3. EXHAUST FAN This Section Does No. K4. Wet System Ec	summary ot Apply				045.5	Constant	e NA					

K4. Wet System Equipment (boilers, chillers, coolir	ng towe	rs, etc.)							
1	2	3	4	5	6	7	8	9	10	11
Name or Itom Tag	Equipment Type	041/	Vol (gal)	Rated Capacity	Efficiency	Standby Loss	nps			
Name or Item Tag	Equipment Type	Qty	voi (gai)	(kBtu/h)	Efficiency	Standby Loss	Qty	GPM	HP	VSD (Y/N)

CA Building Energy Efficiency Standards- 2019 Nonresidential Compliance	Report Version: NRCC-PRF-01-E-04282020-6206	Report Generated at: 2021-05-19 15:39:35

Project Name:	BURGER K	NG RESTAURANT				NRCC-PRF-01	-E	Page 6 c	of 12				
Project Address:	6674'5TW	O BUNCH PALM TRAIL	DESERT HOT	SPRING 92240		Calculation D	ate/Time:	15:39, V	Ved, May 19,	2021			
Input File Name:	BK DHS.cib	d19x											
K5. SYSTEM FEATURE	S §120.2												
1		2		3		4		5			6		
System Name		Optimum Start		nterlocks per 10.4(n)	Evaporati	ve Cooling	н	eat Reco	very		Other Co	ontrols	
AC-1 AC-2 AC-3		No Optimum Start		NA	No Evapora	ative Cooler	No DCV Controls No Heat Recovery No Supply Air Tem		Heat Recovery No Econ		omizer		
DHW System1 - SH	w	NA		NA	N	IA		NA		Fixe	ed Temperature	Control, No DDC	
otes: This table includes contro	ls related to the	performance path only. For p	projects using th	e prescriptive path, n	nandatory and pres	riptive controls requ	iirements are do	cumented (on the NRCC-MCF	I-E.			
(6. MECHANICAL VEN	ITILATION A	AND REHEAT §120.1											
1		2		3	4	5	6		7		8	9	
				Mechanical Ventilation					·				
Zone Nam	ie	Ventilation F	unction	# hotel rooms	# of people	# of bedrooms	Supply O	A CFM	Exhaust CFM		Conditioned Area (sf)	Sensor Contro or Both	
1-RESTAURANT			Food Service - Cafeteria/fast-food dining		69.34	0	1040)	0		2080	NA	
1-RESTAURA	AINI	Cafeteria/fast-fo	ood dining										
		· · · · · · · · · · · · · · · · · · ·	ood dining										
(7. DISTRIBUTION SU	MMARY §1	· · · · · · · · · · · · · · · · · · ·	ood dining										
1-RESTAURA (7. DISTRIBUTION SU This Section Does Not A	MMARY §1	· · · · · · · · · · · · · · · · · · ·	ood dining										
7. DISTRIBUTION SU	MMARY §1	.20.4/140.4(I)										No	

oes the Project include	Zonai Systems:										No
8. ZONAL SYSTEM AN	ND TERMINAL UNIT	SUMMARY § 140.4									
1	2	3	4	5	6	7	8	9	10	11	1
System ID	Zone Name	System Type	1	Capacity tuh)			an				
System ID	Zone Name	Зузсені туре	Heating	Cooling	Design	Min.	Min. Ratio	ВНР	Watts	Cycles	M
1-RESTAURANT-Trm	1-RESTAURANT	Uncontrolled	NA	NA	9000	NA	0.00	NA	NA	NA	

CA Building Energy Efficiency Standards- 2019 Nonresidential Compliance	Report Version: NRCC-PRF-01-E-04282020-6206	Report Generated at: 2021-05-19 15:39:35

Proje	ct Name:	BURGER KING RESTAURA	NT		NRCC-PRF-01-E	Page 1 of 12		
Proje	ct Address:	6674'5 TWO BUNCH PALM	/I TRAIL DESERT HOT SPRING 92240		Calculation Date/Time:	15:39, Wed, May 19, 2021		
Input	File Name:	BK DHS.cibd19x						
A. GE	NERAL INFORMA	TION						
1.	Project Location (c	ity)	DESERT HOT SPRING	8.	Standards Version		Compliance2019	
2.	CA Zip Code		92240	9.	Compliance Software (version)		EnergyPro 8.1	
3.	Climate Zone		15	10.	Weather File		PALM-SPRINGS-INTL_722868_CZ2010.epw	
4.	Total Conditioned	Floor Area in Scope	2,080 ft ²	11.	Building Orientation (deg)	(W) 270 deg	
5.	Total Unconditione	ed Floor Area	0 ft²	12.	Permitted Scope of Work		NewEnvelopeAndMechanical	
6.	Total # of Stories (I	Habitable Above Grade)	1	13	Building Type(s)		Nonresidential	
7.	Total # of dwelling	units	0	14	Gas Type		NaturalGas	

٠.	Total ii of Stories (Habitasi	C / 100	re diade,			Lo Danaing 17P	, C (5)	Trom colucition		
7.	Total # of dwelling units		0		:	14 Gas Type		NaturalGas		
B. PF	ROJECT SUMMARY									
	nstructions: Table B shows it application.	which	h building compo	nents are included in the performance co	alcula	tion. If indicated	as not included, the projec	t must show compliance	prescriptively if within	
		Build	ling Components	Complying via Performance			Building C	omponents Complying P	rescriptively	
			Performance			Performance	The following building components are ONLY eligible for prescriptive			
Envel	lope		Not Included	Covered Process: Commercial Kitchens		Not Included	compliance and should be documented on the NRCC form listed if with scope of the permit application (i.e. compliance will not be shown on the NRCC-PRF-E).			
Mack	nanical		Performance	Covered Process: Computer Rooms		Performance	Indoor Lighting (Uncondit	ioned)§140.6	NRCC-LTI -E is required	
Meci	iailicai		Not Included	Covered Frocess. Computer Rooms	×	Not Included	Outdoor Lighting §140.7 NRCC-		NRCC-LTO-E is required	
Dame	estic Hot Water		Performance	Covered Dreeses Laboratory Exhaust		Performance	Sign Lighting §140.8 NRCC -LTS		NRCC -LTS-E is required	
DOM	estic not water		Not Included	Covered Process: Laboratory Exhaust		Not Included		Mandatory Measures		
Lighti	ing (Indoor Conditioned)		Performance				Electrical power systems, mandatory and should be (i.e. compliance will not b	documented on the NRC	CC form listed if applicable	
			Not Included	1			Electrical Power Distribut	ion S110.11	NRCC-ELC-E is required	

CA Building Energy Efficiency Standards- 2019 Nonresidential Compliance	Report Version: NRCC-PRF-01-E-04282020-6206	Report Generated at: 2021-05-19 15:39:35

Commissioning S120.8

Solar Ready S110.10

NRCC-CXR-E is required

NRCC-SRA-E is required

Project Name:	BURGER KING RESTAURANT		NRCC-PRF-01	L-E	Page 2 of 12		
Project Address:	6674'5TWO BUNCH PALM TRAIL DESERT HOT SPRING 92240			Calculation Date/Time: 15:39, Wed, May 19, 20			
Input File Name:	BK DHS.cibd19x						
C1. COMPLIANCE F	RESULTS FOR PERFORMANCE COMPONENTS (Annua	al TDV Energy Use, kBtu	u/ft ²-yr)				
		COMPLI	ES				
Energy Component		Standard Design	(TDV) Propo		osed Design (TDV)	Compliance Margin (TDV) ¹	
Space Heating			0.01		1.18	-1.17	
Space Cooling			475.21		659.59	-184.38	
Indoor Fans			462.32		270.47	191.85	
Heat Rejection							
Pumps & Misc.							
Domestic Hot Water			69.56		53.37	16.19	
Indoor Lighting			55.90		55.90		
ENERGY STAN	IDARDS COMPLIANCE TOTAL	:	1,063.00		1,040.51	22.49 (2.1%)	
¹ Notes: The numbe	er in parenthesis following the Compliance Margin in	n column 4. represents t	he Percent B	etter than S	Standard.		

☐ This project is pursuing CalGreen Tier 1 ☐ This project is pursuing CalGreen Tier 2								
Miscellaneous Energy Component	Standard Design (TDV)	Proposed Design (TDV)	Compliance Margin (TDV) ¹					
Receptacle	74.23	74.23						
Process	1,086.26	1,086.26						
Other Ltg								
Process Motors								
COMPLIANCE TOTAL PLUS MISCELLANEOUS COMPONENTS	2,223.49	2,201.00	22.5 (1.0					

Miscellaneous Energy Component	Standard Design (TDV)	Proposed Design (TDV)	Compliance Margin (TDV) ¹
Receptacle	74.23	74.23	
Process	1,086.26	1,086.26	
Other Ltg			
Process Motors			
COMPLIANCE TOTAL PLUS MISCELLANEOUS COMPONENTS	2,223.49	2,201.00	22.5 (1.0%)
Notes: This table is used to document compliance with programs OTH	ER THAN Title 24 Part 6, if applicable		

D. EXCEPTIONAL CONDITIONS	
This project includes partial performance compliance scope options. The building must show compliance with all oth occupying.	er applicable compliance scope options (performance or prescriptively) before
This project uses the Simplified Geometry Performance Modeling Approach which is not capable of modeling daylight requirements are met. PRESCRIPTIVE COMPLIANCE documentation (form NRCC-LTI-02-E) for the requirements of sec	

CA Building Energy Efficiency Standards- 2019 Nonresidential Compliance	Report Version: NRCC-PRF-01-E-04282020-6206	Report Generated at: 2021-05-19 15:39:35

Project Name: B	Burger King Restauran	VI.	NRCC-PRF-01-E	Page 3 of 12		
Project Address: 6	66745 TWO BUNCH PALM	TRAIL DESERT HOT SPRING 92240	Calculation Date/Time:	15:39, Wed, May 19, 2021		
Input File Name: B	BK DHS.cibd19x					
•						
E. HERS VERIFICATION						
This Section Does Not Apply	у					
F. ADDITIONAL REMARK	KS .					
This Section Does Not Apply	у					
G. ENVELOPE GENERAL I	INFORMATION					
G. ENVELOPE GENERAL I	INFORMATION	2	3		4	
		2 Total Gross Surface Area (ft²)	3 Total Fenestration Are	ea (ft²)	4 Window to Wall Ratio (%)	
1				ea (ft²)		21.2
1	& Orientation	Total Gross Surface Area (ft²)		· ·		
1	A Orientation North-Facing ¹	Total Gross Surface Area (ft²) 312 ft²		66 ft ²		11.7
1	A Orientation North-Facing ¹ East-Facing ²	Total Gross Surface Area (ft²) 312 ft² 1,008 ft²		66 ft ² 118 ft ²		21.2° 11.7° 21.2° 10.3°
1	A Orientation North-Facing ¹ East-Facing ² South-Facing ³	Total Gross Surface Area (ft²) 312 ft² 1,008 ft² 312 ft²		66 ft ² 118 ft ² 66 ft ²		11.7 ¹ 21.2 ¹


	7		
Notes:			
¹ North-Facing is oriented to within 45 degree	es of true north, including 45°00'00" east of north (NE), but a	excluding 45°00'00" west of r	orth (NW).
² East-Facing is oriented to within 45 degrees	of true east, including 45°00'00" south of east (SE), but excl	luding 45°00'00" north of eas	t (NE).
³ South-Facing is oriented to within 45 degree	es of true south, including 45°00'00" west of south (SW), but	t excluding 45°00'00" east of s	south (SE).
4 West-Facing is oriented to within 45 degree	s of true west, including 45°00'00" north of due west (NW),	but excluding 45°00'00" south	h of west (SW).

1.	2.	3.	4.	5.	6.	7.	8.	9
enestration Assembly Name / Tag or I.D.	Fenestration Type / Product Type / Frame Type	Certification Method ¹	Assembly Method	Area ft ²	Overall U-factor	Overall SHGC	Overall VT	Status
Double Metal Clear	VerticalFenestration FixedWindow MetalFraming	Default Performance	Manufactured	354	0.71	0.73	0.77	N

of verification. Site-built fenestration values are calculated per Nonresidential Appendix NA6 and are used in the analysis. ² Status: N - New, A - Altered, E - Existing

CA Building Energy Efficiency Standards- 2019 Nonresidential Compliance Report Version: NRCC-PRF-01-E-04282020-6206 Report Generated at: 2021-05-19 15:39:35

> ENGINEER: JS ENGINEERING, INC. 410 S. SAN GABRIEL BLVD., SUITE 8, SAN GABRIEL, CA 91776 PHONE: 626.497.0558 EMAIL: INFO@CAL-PACIFIC.NET

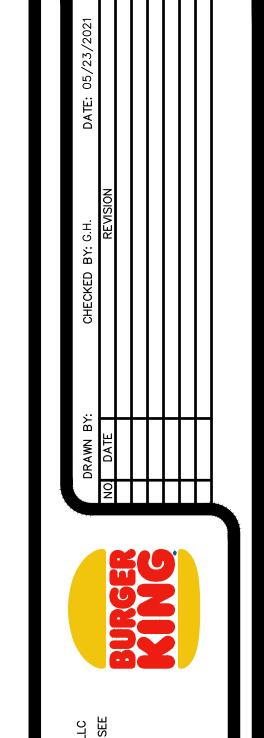



BURGER KING
66745 TWO BUNCH PALMS

Project Name BURGER KING RESTAU	RANT					Date 5/2	20/2021
System Name AC-1, AC-2, AC-3						Floor	Area 2,080
ENGINEERING CHECKS		SYSTEM LOAD					2,000
Number of Systems	3		COIL	COOLING F	PEAK	COIL H	TG. PEAK
Heating System		1	CFM	Sensible	Latent	CFM	Sensible
Output per System	59,000	Total Room Loads	8,994	142,997	5,200	1,655	30,61
Total Output (Btuh)	177,000	Return Vented Lighting		0			
Output (Btuh/sqft)	85.1	Return Air Ducts		7,150			1,5
Cooling System		Return Fan		0			
Output per System	83,000	Ventilation	156	5,701	2,107	156	7,42
Total Output (Btuh)	249,000	Supply Fan		0			
Total Output (Tons)	20.8	Supply Air Ducts		7,150			1,53
Total Output (Btuh/sqft)	119.7						
Total Output (sqft/Ton)	100.2	TOTAL SYSTEM LOAD		162,998	7,307		41,10
Air System							
CFM per System	3,000	HVAC EQUIPMENT SELECTION					
Airflow (cfm)	9,000			163,094	58,102		177,00
Airflow (cfm/sqft)	4.33						
Airflow (cfm/Ton)	433.7						
Outside Air (%)	1.7%	Total Adjusted System Output		163,094	58,102		177,00
Outside Air (cfm/sqft)	0.08	1				_	
Note: values above given at ARI	conditions	TIME OF SYSTEM PEAK			Jul 4 PM		Jan 1 A
24 °F 69 °F Outside Air	69 °F →	88 °F					ļ
156 cfm Supply Fan 9,000 cfm	Heating	COII			Re	MOC	70 °F
COOLING SYSTEM PSYCHR	OMETRICS	(Airstream Temperatures at Time	of Cooling	Peak)			
110/77 °F 75/6	4 °F 75	5 / 64 °F 58 / 57 °F					ļ
Outside Air 👢	Supply Fan	Cooling Coil				59	/ 58 °F
156 cfm 75 / 64 °F	9,000 cfm	Cooling Coil		56.19	% RC	OOM 74	/ 63 °F

		1	OTALS	0	0	0	156	Jul 4 i	DM	148,822	8,144		38,06
		_											
		-											
		-											
		+											
		+											
		+											
		_											
ZONE NAME RESTAURANT	SYSTEM NAME	Mult. 1.0	CFM	Sensible	Latent	Heating	OA CFM 156	Peak Hr Jul 4 PM	CFM 8,994	Sensible 148,822	Latent 8,144	CFM 1,655	Sensible 38,06
			l		SYSTEM					NG PEAK			NG PEAK
ZONE LOAD SUMMARY													
AC-1, AC-2, AC-3											1100	2,08	30
BURGER KING RESTAURAN System Name	IT										Floor	5/20/2 or Area	021
oject Name	IT										Date	5/20/2	021

Project Name:	BURGER KING RESTAURANT	NRCC-PRF-01-E	Page 10 of 12
Project Address:	66745 TWO BUNCH PALM TRAIL DESERT HOT SPRING 92240	Calculation Date/Time:	15:39, Wed, May 19, 2021
Input File Name:	BK DHS.cibd19x		

P. DECLARATION OF REQUIRED CERTIFICATES OF ACCEPTANCE

Table Instructions: Selections shall be made by Documentation Author to indicate which Certificates of Acceptance must be submitted for the features to be recognized for compliance. These documents must be provided to the building inspector during construction and must be completed through an Acceptance Test Technician Certification Provider (ATTCP). For more information visit:https://www.energy.ca.gov/title24/2019standards/2019_compliance_documents/Nonresidential_Documents/NRCA/

Building Component	YES	NO	Form/Title	Inspe	eid
				Pass	Fa
	\boxtimes		NRCA-MCH-02-A Outdoor Air must be submitted for all newly installed HVAC units. Note: MCH02-A can be performed in conjunction with MCH-07-A Supply Fan VFD Acceptance (if applicable) since testing activities overlap		
			NRCA-MCH-03-A Constant Volume Single Zone HVAC		
	\boxtimes		NRCA-MCH-04(a)-H Air Distribution Duct Leakage - HERS Verification required		
			NRCA-MCH-04(b)-A Air Distribution Duct Leakage - ATT only		
		\boxtimes	NRCA-MCH-05-A Air Economizer Controls		
			NRCA-MCH-06-A Demand Control Ventilation Systems Acceptance must be submitted for all systems required to employ demand controlled ventilation (refer to §120.1(c)3) can vary outside ventilation flow rates based on maintaining interior carbon dioxide (CO2) concentration setpoints		ı
		\boxtimes	NRCA-MCH-07-A Supply Fan Variable Flow Controls		T
Madada		\boxtimes	NRCA-MCH-08-A Valve Leakage Test		
Mechanical		\boxtimes	NRCA-MCH-09-A Supply Water Temperature Reset Controls		
		\boxtimes	NRCA-MCH-10-A Hydronic System Variable Flow Controls		
		\boxtimes	NRCA-MCH-11-A Automatic Demand Shed Controls		
		\boxtimes	NRCA-MCH-12-A FDD for Packaged Direct Expansion Units		
		\boxtimes	NRCA-MCH-13-A Automatic FDD for Air Handling Units and Zone Terminal Units Acceptance		
		\boxtimes	NRCA-MCH-14-A Distributed Energy Storage DX AC Systems Acceptance		
		\boxtimes	NRCA-MCH-15-A Thermal Energy Storage (TES) System Acceptance		
		\boxtimes	NRCA-MCH-16-A Supply Air Temperature Reset Controls		[
		\boxtimes	NRCA-MCH-17-A Condenser Water Temperature Reset Controls		[
		\boxtimes	NRCA-MCH-18 Energy Management Control Systems		
		\boxtimes	NRCA-MCH-19 Occupancy Sensor Controls		[

CA Building Energy Efficiency Standards- 2019 Nonresidential Compliance Report Version: NRCC-PRF-01-E-04282020-6206

Report Generated at: 2021-05-19 15:39:35

Project Name:	BURGER KING RESTAURANT			_	NRCC-PRF-01-E	Page 11 of 12			
Project Address:	66745 TWO BUNCH PALM TR	AIL DES	SERT HO	OT SPRING 92240	Calculation Date/Time:	15:39, Wed, May 19, 2021			
Input File Name:	BK DHS.cibd19x								
Q. DECLARATION O	F REQUIRED CERTIFICATES OF	VERIF	ICATIO	PN .				_	
compliance. These on the compliance. These of the complete the complet	documents bust be retained an	d provi	ided to	Author to indicate which Certifi o the building inspector during c pliance_documents/Nonresiden	onstruction and can be		Fie		
Duik	ang component	11.3	"		romy nu	•	Pass	_	
		⊠		NRCV-MCH-04-H Duct Leakage Te	st			Г	
	Mechanical		\boxtimes	NRCV-MCH-24-H Enclosure Air Lea	akage			Γ	
	IVIECTIATIICAI		\boxtimes	NRCV-MCH-27 Indoor Air Quality & Mechanical Ventilation					

☐ NRCV-MCH-32-H Local Mechanical Exhaust

NRCV-PLB-21-H - HERS verified central systems in high-rise residential, hotel/motel application

NRCV-PLB-22-H - HERS verified single dwelling unit systems in high-rise residential, hotel/motel application

R. UNMET LOAD HOURS

This Section Does Not Apply


CA Building Energy Efficiency Standards- 2019 Nonresidential Compliance Report Version: NRCC-PRF-01-E-04282020-6206 Report Generated at: 2021-05-19 15:39:35

Project Name:	BURGER KING RESTAURANT		NRCC-PRF-01-E	Page 12 of 12					
Project Address:	66745 TWO BUNCH PALM TRAIL DESE	RT HOT SPRING 92240	Calculation Date/Time:	15:39, Wed, May 19, 2021					
Input File Name:	BK DHS.cibd19x								
DOCUMENTATION (ULTUODIS DESI ADATION STATEMENT		•						
	AUTHOR'S DECLARATION STATEMENT te of Compliance documentation is accurate an	d complete.							
Documentation Autho	r Name: Zhiqiang Zhang	G:							
Company: JS ENGINI	EERING , INC.	Signat	ure:						
Address: 410 S. San	Gabriel Blvd., #8	Signat	ure Date: 2021-05-19	//					
City/State/Zip: San G	abriel, CA 91776	CEA/	HERS Certification Identifica	tion (if applicable): M-34617					
Phone: 626.497.055	8								
RESPONSIBLE PERSO	ON'S DECLARATION STATEMENT								
	rt 6 of the California Code of Regulations.								
4. The building design fe plans and specifications5. I will ensure that a cor	atures or system design features identified on t submitted to the enforcement agency for appr mpleted signed copy of this Certificate of Comp d that a completed signed copy of this Certifica	oval with this building permit application. liance shall be made available with the buil te of Compliance is required to be included	ding permit(s) issued for the bu	on other applicable compliance documents, worksheets, calculations, silding, and made available to the enforcement agency for all applicable silder provides to the building owner at occupancy.					












4. The building design fe plans and specifications 5. I will ensure that a cor inspections. I understant Responsible Envelope Company: Design UA Address: 153 E. CITY Pl City/State/Zip: SANTA APhone: Responsible Lighting D Company: Address: City/State/Zip: Phone: Responsible Mechanic Company: JS ENGINEE	atures or system design features identified on too submitted to the enforcement agency for liance shall be made available with the buil te of Compliance is required to be included Signat Date S Title: Signat Date S Title: Signat	ding permit(s) issued for the buwith the documentation the buwith the documentation the buwies: 5/20/2021 ure: NOT IN SCOPE igned:	lilding, and made available to the enforcement agency for all applicable uilder provides to the building owner at occupancy. License #:					

CA Building Energy Efficiency Standards- 2019 Nonresidential Compliance Report Version: NRCC-PRF-01-E-04282020-6206

Report Generated at: 2021-05-19 15:39:35

ENGINEER: JS ENGINEERING, INC. 410 S. SAN GABRIEL BLVD., SUITE 8, SAN GABRIEL, CA 91776 PHONE: 626.497.0558 EMAIL: INFO@CAL-PACIFIC.NET

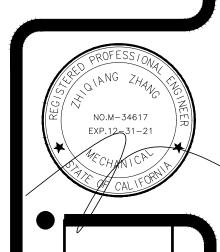

BURGER KING

HOOD INFORMATION - JOR#4667178

FIELD WRAPPER 16.00" HIGH FRONT, LEFT, RIGHT.

BACKSPLASH 122.00" HIGH X 228.00" LONG 430 SS VERTICAL.

LEFT VERTICAL END PANEL 27" TOP WIDTH, 21" BOTTOM WIDTH, 80" HIGH INSULATED 430

RIGHT VERTICAL END PANEL 27" TOP WIDTH, 21" BOTTOM WIDTH, 80" HIGH INSULATED 430

HOOD OPTIONS

OOD NO TAG


	T				MAX		APPLIANCE DUTY					EXHA	AUST PL	.ENUM				HOOD C	ONFIG
HOOD NO	TAG	MODEL	MANUFACTURER	LENGTH	COOKING	TYPE			TOTAL		_		RISER(S	3)			HOOD	END TO	
	1710		WINTER TOTOTICE		TEMP			CFM/FT	EXH CFM	WIDTH	LENG	HEIGHT	DIA	CFM	VEL	SP	CONSTRUCTION	END	ROW
		5424	FRANKE FOODSERVICE	15' 0"	600	1	HEAVY	165	2475			4"	12"	1237	1575	-0.483"	430 SS	ALONE	ALONE
		FR-ND-2	FRANKE FOODSERVICE	15 0	DEG	Ĭ	пенит	165	2475			4"	12"	1237	1575	-0.483"	WHERE EXPOSED	ALONE	ALONE

PATENT NUMBERS

EXHAUST HOODS ND-2/BD-2/SND-2 (CANADA) - CA PATENT 2520435 C.

Н	000	INFO	ORMATION															
			F	ILTER	R(S)				LIGHT(S)					UTILITY CABINET(S)			FIDE	11000
Н	OOD	TAG					EFFICIENCY			WIRE			FI	RE SYSTEM	ELECTRICAL	SWITCHES	FIRE SYSTEM	
NO	170	TYPE	QTY HEIGHT LEI		LENGTH @ 7 MICRONS		QTY			LOCATION	SIZE	TYPE	SIZE	MODEL#		PIPING		
	1		FRANKE FILTER	11	16"	16"		5	SCREW IN HALOGEN	NO	RIGHT	12"x54"x24"	ANSUL R102	3.0/3.0	DCV-1011	1 LIGHT	YES	885 LBS
						1										1 FAN	1 /	LBS

HOOD CORNER HANGING ANGLE GRADE 5 (MINIMUM STEEL HEX NUTS 1/2" - 13 TPI GRADE 5 (MINIMUM) STEEL ALL-THREAD. GRADE 5 (MINIMUM) STEEL HEX NUT. 1/2" GRADE 5 HANGING ANGLE (WEIGHT BEARIN ANCHOR POINT FOR HOOD). GRADE 5 (MINIMUM) STEEL HEX NUTS.

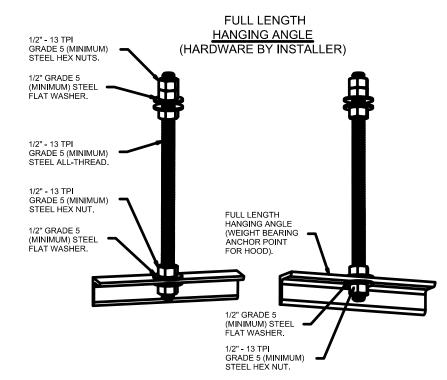


ASSEMBLY INSTRUCTIONS

HANGING ANGLE MUST BE SUPPORTED WITH 1/2" - 13 TPI GRADE 5 (MINIMUM) ALL-THREAD. SANDWICH HANGING ANGLES AND CEILING ÀNCHOR POINTS WITH 1/2" GRADE 5 (MINIMUM) STEEL FLAT WASHERS AND 1/2" - 13 TPI GRADE 5 (MINIMUM) HEX NUTS AS SHOWN. MUST USE DOUBLED HEX NUT CONFIGURATION BENEATH HOOD HANGING ANGLES AND ABOVE CEILING ANCHORS. MAINTAIN 1/4" OF EXPOSED THREADS BENEATH BOTTOM HEX NUT. TORQUE ALL HEX NUTS TO 57 FT-LBS.

ASSEMBLY INSTRUCTIONS

HANGING ANGLE MUST BE SUPPORTED WITH 1/2" - 13 TPI GRADE 5 (MINIMUM) ALL-THREAD. SANDWICH HANGING ANGLES AND CEILING ÀNCHOR POINTS WITH 1/2" GRADE 5 (MINIMUM) STEEL FLAT WASHERS AND 1/2" - 13 TPI GRADE 5 (MINIMUM) HEX NUTS AS SHOWN. MUST USE DOUBLED HEX NUT CONFIGURATION ABOVE CEILING ANCHORS. SINGLE HEX NUT BENEATH HANGING ANGLE IS ACCEPTABLE FOR FULL LENGTH HANGING ANGLES. MAINTAIN 1/4" OF EXPOSED THREADS BENEATH BOTTOM HEX NUT. TORQUE ALL HEX NUTS TO 57 FT-LBS.

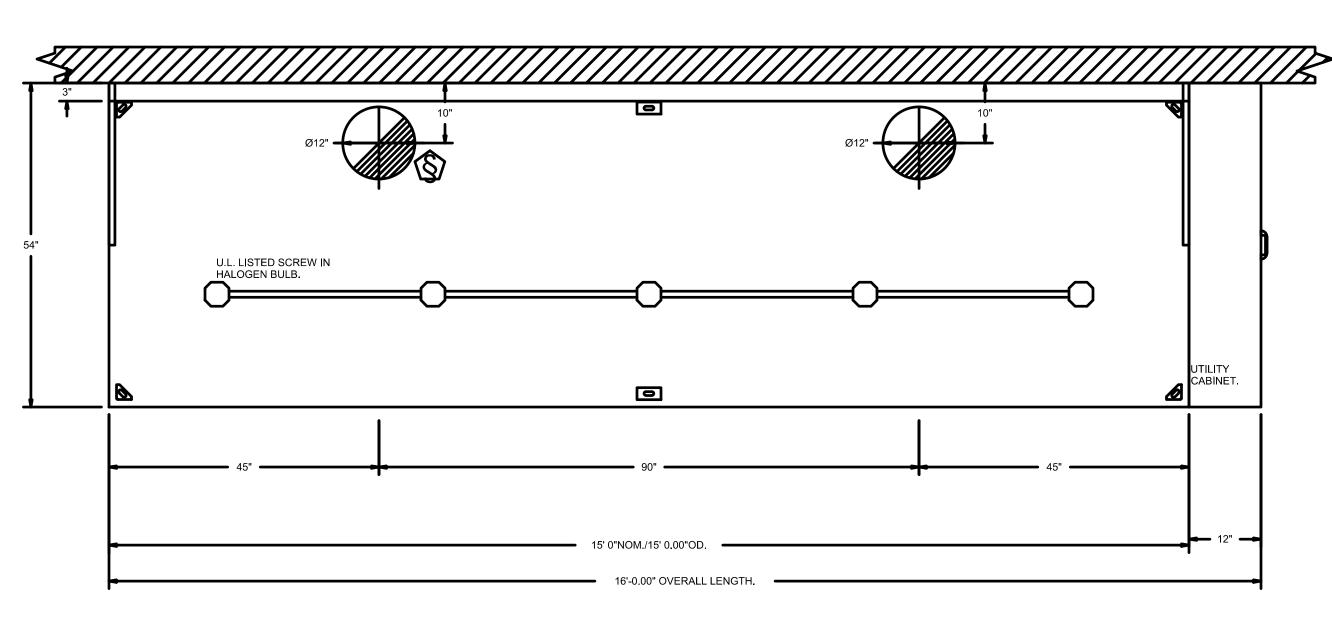

OPTION




SYSTEM DESIGN VERIFICATION (SDV)

IF ORDERED, CAS SERVICE WILL PERFORM A SYSTEM DESIGN VERIFICATION (SDV) ONCE ALL EQUIPMENT HAS HAD A COMPLETE START UP PER THE OPERATION AND INSTALLATION MANUAL. TYPICALLY, THE SDV WILL BE PERFORMED AFTER ALL INSPECTIONS ARE COMPLETE.


ANY FIELD RELATED DISCREPANCIES THAT ARE DISCOVERED DURING THE SDV WILL BE BROUGHT TO THE ATTENTION OF THE GENERAL CONTRACTOR AND CORRESPONDING TRADES ON SITE. THESE ISSUES WILL BE DOCUMENTED AND FORWARDED TO THE APPROPRIATE SALES OFFICE. IF CAS SERVICE HAS TO RESOLVE A DISCREPANCY THAT IS A FIELD ISSUE, THE GENERAL CONTRACTOR WILL BE NOTIFIED AND BILLED FOR THE WORK. SHOULD A RETURN TRIP BE REQUIRED DUE TO ANY FIELD RELATED DISCREPANCY THAT CANNOT BE RESOLVED DURING THE SDV, THERE WILL BE ADDITIONAL TRIP CHARGES.

DURING THE SDV, CAS SERVICE WILL ADDRESS ANY DISCREPANCY THAT IS THE FAULT OF THE MANUFACTURER. SHOULD A RETURN TRIP BE REQUIRED, THE GENERAL CONTRACTOR AND APPROPRIATE SALES OFFICE WILL BE NOTIFIED. THERE WILL BE NO ADDITIONAL CHARGES FOR MANUFACTURER DISCREPANCIES.

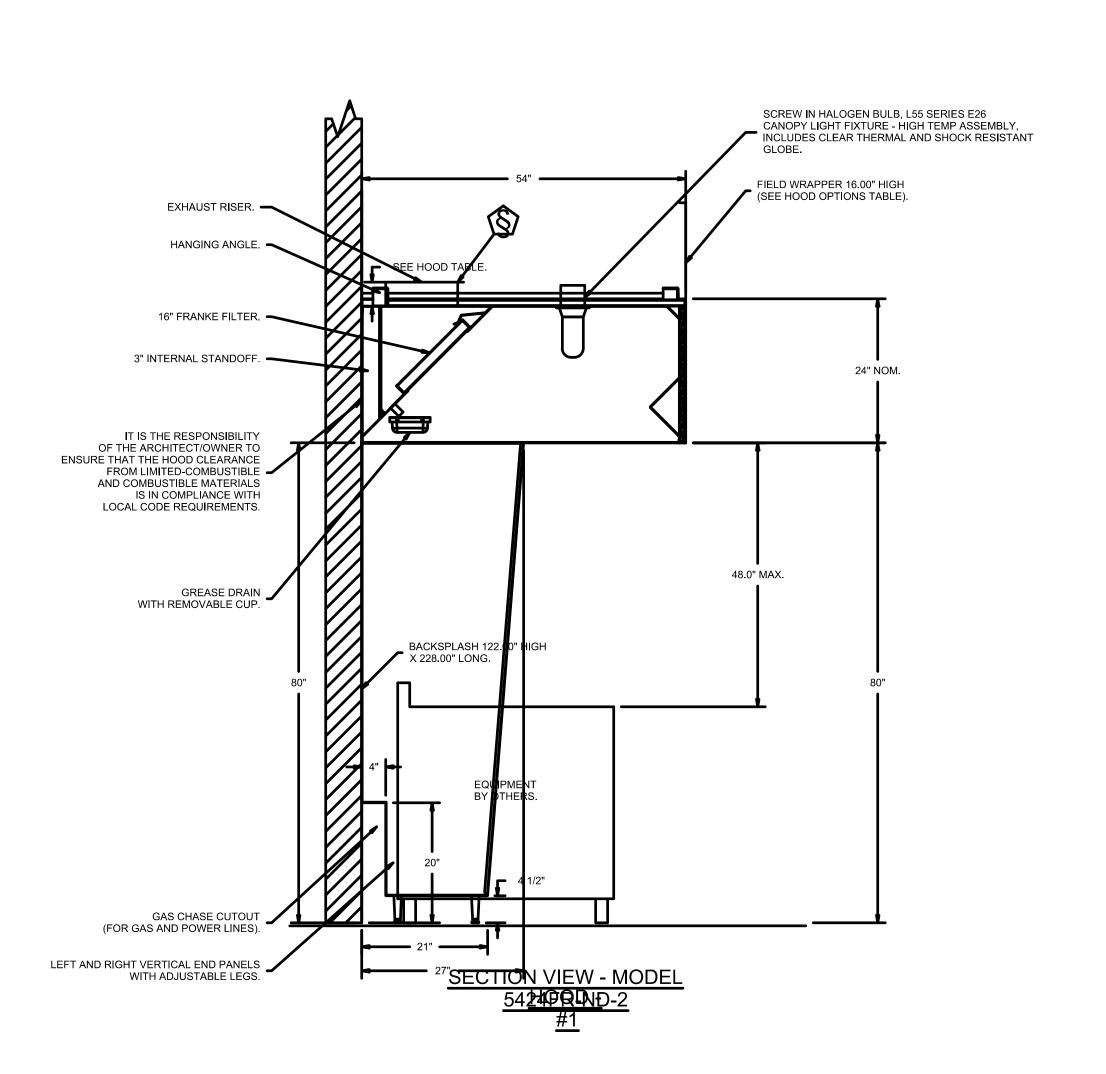

ENGINEER: JS ENGINEERING, INC. 410 S. SAN GABRIEL BLVD., SUITE 8, SAN GABRIEL, CA 91776 BURG

PHONE: 626.497.0558 EMAIL: INFO@CAL-PACIFIC.NET

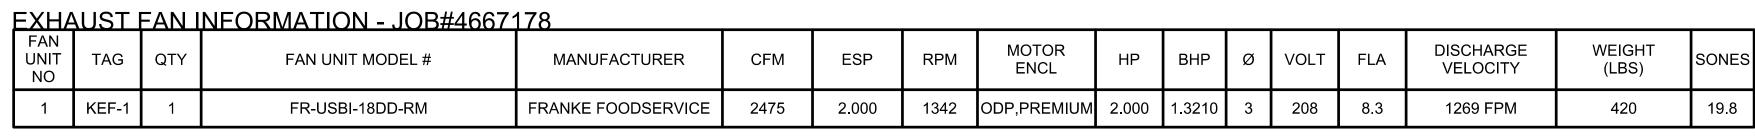

FAN OPTIONS

FAN UNIT NO	TAG	QTY	DESCRIPTION
		1	BI18 - INLET SERVICE DUCT CONNECTION, USED TO CONNECT TO STANDARD 20" GREASE DUCT OR FIELD WELDED DUCT, INCLUDES (2) 7" RISERS BOLTED TO STANDARD INLET RISER. UTILITY SET GREASE CUP.
1	KEF-1	1	BI18 - 24" DISCHARGE EXTENSION.
ı	NEF-I	1	BI - DISCHARGE ORIENTATION VERTICAL UPPER LEFT - CW INLET SIDE.
		1	BI18 - INLET CONNECTION STANDARD 20" FLANGED GREASE DUCT.
			UTILITY SET - SPRING VIBRATION ISOLATORS - BI18 / EQUIVALENT SIZED UTILITY SET - INDOOR/OUTDOOR USE.

FAN ACCESSORIES

FAN UNIT	TAG		EXHAUST		SUPPLY						
NO		REASE CU	GRAVITY DAMPER	WALL MOUNT	SIDE DISCHARGE	GRAVITY DAMPER	TORIZED DAMF	WALL MOUNT			
1	KEF-1	YES									

CURB ASSEMBLIES

* INLET/OUTLET NOTES:


92 LBS

147 LBS

UNIT PLAN VIEW CORNER WEIGHTS:

NO	ON FAN	TAG	WEIGHT	ITEM	SIZE
1	# 1	KEF-1	25 LBS	RAIL	4.000"W X 48.000"L X 6.000"H COMES AS A SET OF 2.

FAN #1 FR-USBI-18DD-RM - EXHAUST FAN (KEF-1)

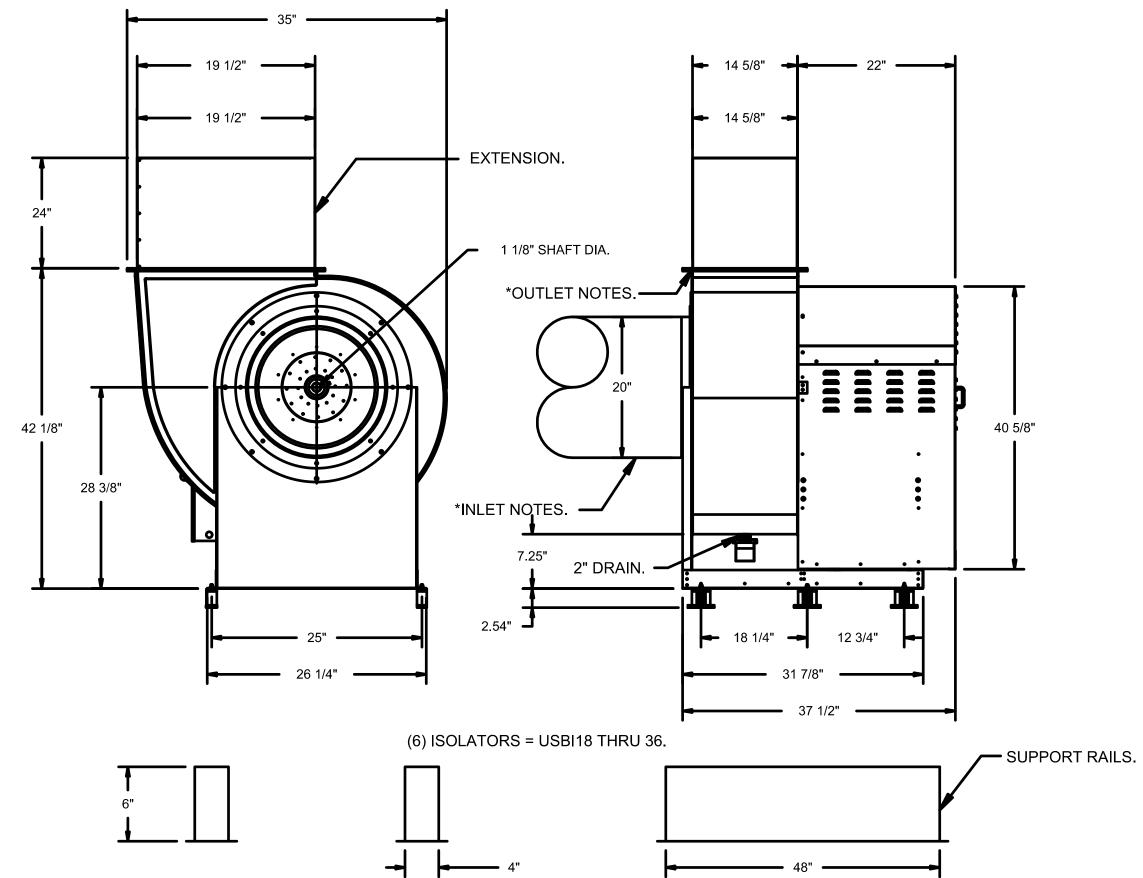

NORMAL TEMPERATURE TEST DIRECT DRIVE EXHAUST FAN MUST OPERATE CONTINUOUSLY WHILE EXHAUSTING AIR AT 350°F (176°C) UNTIL ALL FAN PARTS HAVE REACHED THERMAL EQUILIBRIUM, AND WITHOUT ANY DETERIORATING EFFECTS TO THE FAN WHICH

CORNER WEIGHTS ARE CALCULATED BASED ON VERTICAL DISCHARGE. SUPPORT DUCT PROPERLY BEFORE FAN TO ENSURE CORNER WEIGHTS ARE NOT AFFECTED.

WOULD CAUSE UNSAFE OPERATION.


- ROOF MOUNTED FANS.


FEATURES:

- UL705.
- UL762 AND ULC-S645 (RESTAURANT MODEL).
- HIGH HEAT OPERATION DIRECT DRIVE 350°F (176°C).
- HEAT SLINGER.
- NEMA 3R SAFETY DISCONNECT SWITCH.
- GREASE CLASSIFICATION TESTING.
- 2" DRAIN.
- MOTOR WEATHER COVER.
- FULLY SEALED SCROLL HOUSING.
- SCROLL ACCESS DOOR.
- FLANGE 1 1/4".

<u>OPTIONS</u>

BI18 - INLET SERVICE DUCT CONNECTION. USED TO CONNECT TO STANDARD 20" GREASE DUCT OR FIELD WELDED DUCT. INCLUDES (2) 7" RISERS BOLTED TO STANDARD INLET RISER. UTILITY SET GREASE CUP. BI18 - 24" DISCHARGE EXTENSION. BI - DISCHARGE ORIENTATION VERTICAL UPPER LEFT - CW INLET SIDE. BI18 - INLET CONNECTION STANDARD 20" FLANGED GREASE DUCT. UTILITY SET - SPRING VIBRATION ISOLATORS - BI18 / EQUIVALENT SIZED UTILITY SET - INDOOR/OUTDOOR USE.

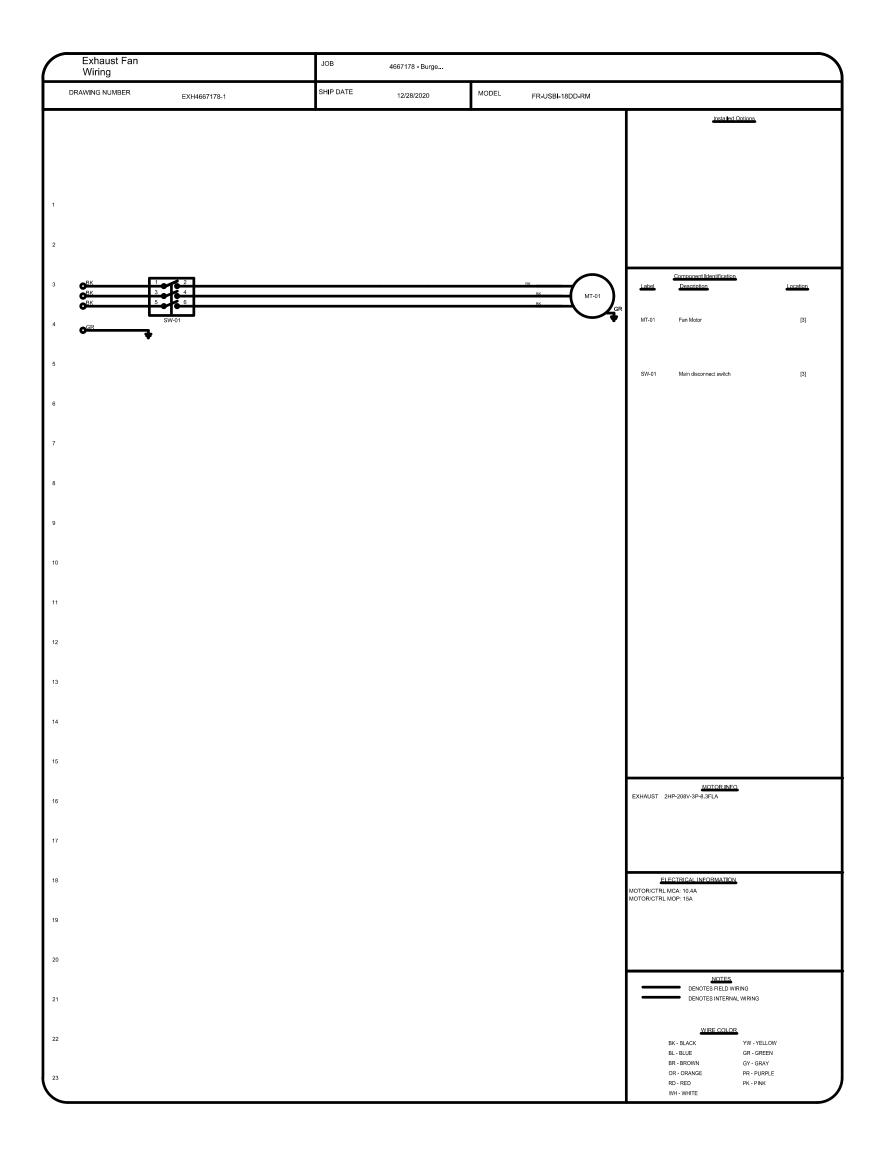

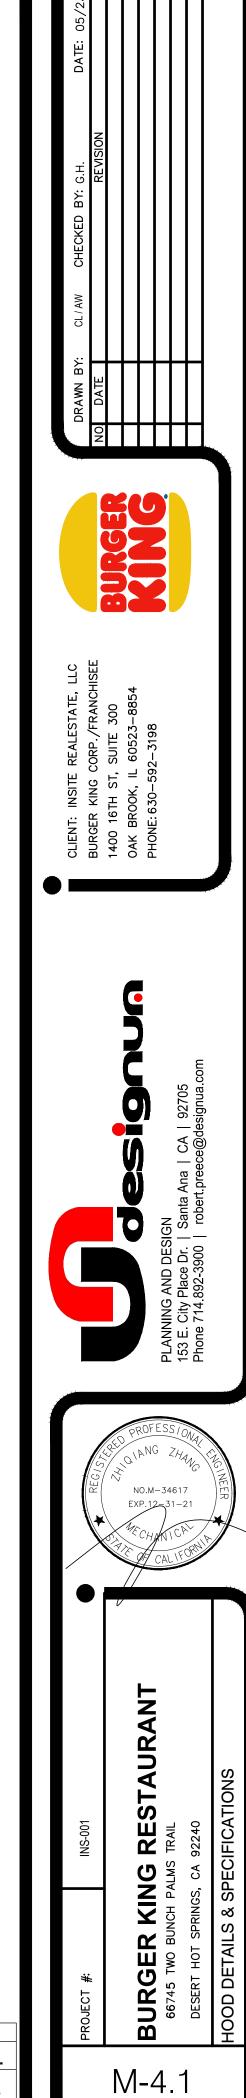

ENGINEER: JS ENGINEERING, INC. 410 S. SAN GABRIEL BLVD., SUITE 8, SAN GABRIEL, CA 91776 PHONE: 626.497.0558 EMAIL: INFO@CAL-PACIFIC.NET


← INLET

105 LBS

LENGTH OF THE STRAIGHT DUCT ON THE INLET AND OUTLET TO BE 3 TIMES

THE EQUIVALENT DUCT DIAMETER BEFORE CONNECTING TO ANY


FITTINGS SUCH AS ELBOWS TO AVOID SYSTEM EFFECT.

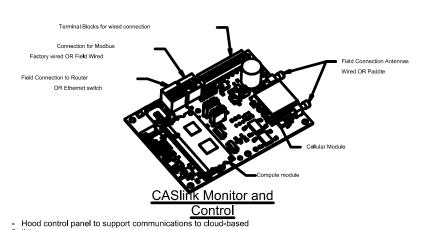


- Hood control panel to support communications to cloud-based Maintagement
System Control Panel to allow cloud-based Building Management System toonitor real time parameters outlined as MONITOR in the points listHood Control Panel to allow cloud-based Building Management System toontrol parameters outlined as CONTROL in the points listHood Control Panel to allow cloud-based Building Management System tooplement SYSTEM ECONOMIZER control strategies for fully integrated Building Management.

MONITORING AND CONTROL POINTS

Packages	Function	Packages	Function
Koom Temperature	MONITOR	Room Temperature(s)	MONITOR
Duct Temperature(s)	MONITOR	Temperature(s)	MONITOR
MOA Discharge Temperature	MONITOR	Temperature	MONITOR
Kitchen KTO Discharge Temperature	MONITOR	Temperature	MONITOR
Fan Speed	MONITOR	Controller Faults	MONITOR
ran Amperage	MONITOR	Fan Faults	MONITOR
Fan Power	MONITOR	Fan Status	MONITOR
VFD Faults	MONITOR	PCU Faults	MONITOR
Controller Faults	MONITOR	Percentages	MONITOR
Fan Faults	MONITOR	Fire Condition	MONITOR
Fan Status	MONITOR	System	MONITOR
PCU Faults	MONITOR	Building Pressures	MONITOR
Percentages	MONITOR	Fans Button(s)	MONITOR & CONTROL
Fire Condition	MONITOR	Lights Button(s)	MONITOR & CONTROL
System	MONITOR	Wash Button	MONITOR & CONTROL
Pressures	MONITOR		
Button	MONITOR & CONTROL		
Fans Button	MONITOR & CONTROL		
Eights Button	MONITOR & CONTROL		

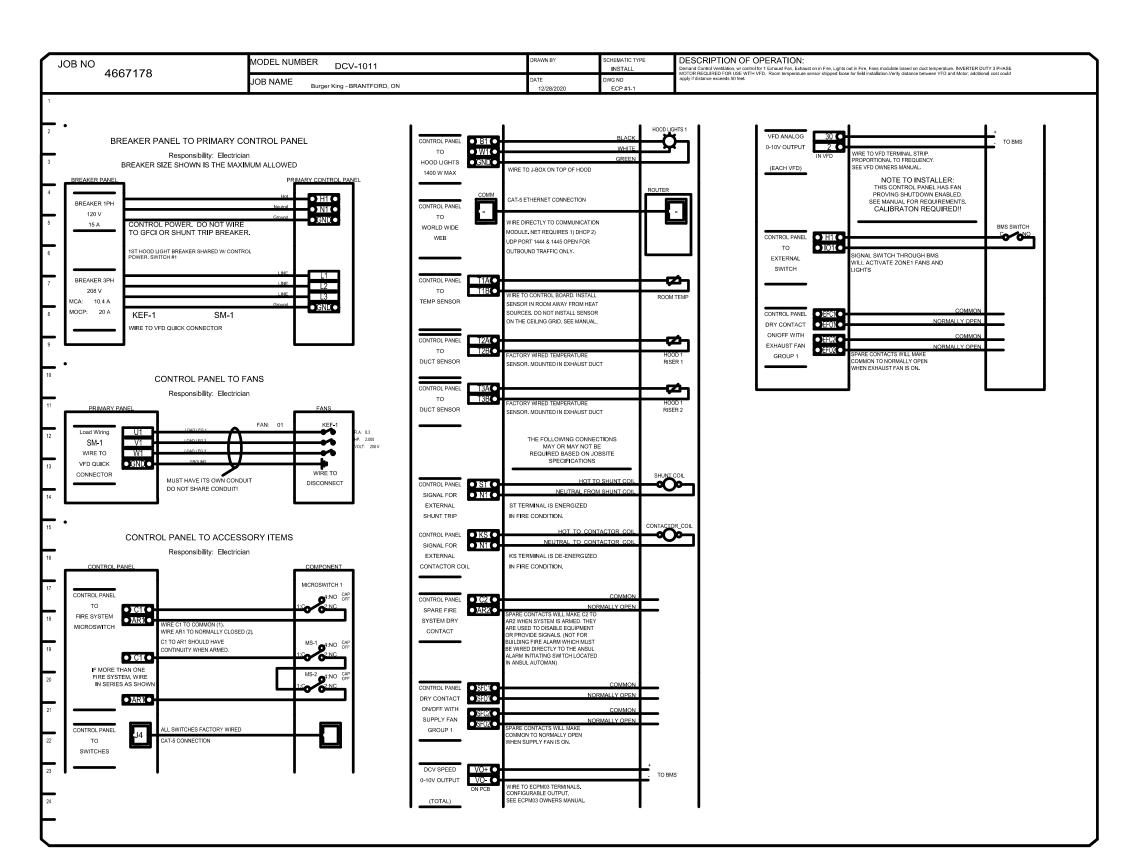

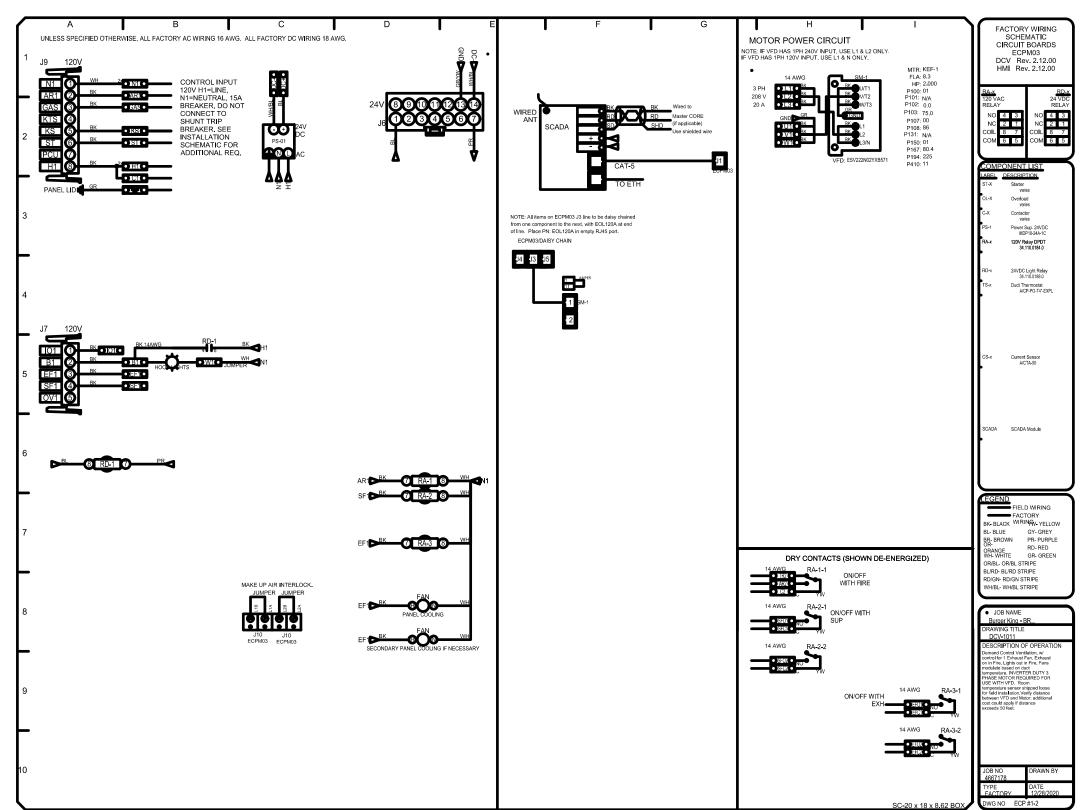

DEMAND CONTROL VENTILATION HOOD CONTROL PANEL SPECIFICATIONS:

- CONTROLS SHALL BE LISTED BY ETL (UL 508A) AND SHALL COMPLY WITH DEMAND VENTILATION SYSTEM TURNDOWN REQUIREMENTS OUTLINED IN IECC 403.2.8 (2015).
- THE CONTROL ENCLOSURE SHALL BE NEMA 1 RATED AND LISTED FOR INSTALLATION INSIDE OF THE EXHAUST HOOD UTILITY CABINET. THE CONTROL ENCLOSURE MAY BE CONSTRUCTED OF STAINLESS STEEL OR PAINTED STEEL.
- TEMPERATURE PROBE(S) LOCATED IN THE EXHAUST DUCT RISER(S) SHALL BE CONSTRUCTED OF STAINLESS STEEL.
- A DIGITAL CONTROLLER SHALL BE PROVIDED TO ACTIVATE THE HOOD EXHAUST FANS DYNAMICALLY BASED ON A FIXED DIFFERENTIAL BETWEEN THE AMBIENT AND DUCT TEMPERATURES SENSORS. THIS FUNCTION SHALL MEET THE REQUIREMENTS OF IMC 507.1.1.
- A DIGITAL CONTROLLER SHALL PROVIDE ADJUSTABLE HYSTERESIS SETTINGS TO PREVENT CYCLING OF THE FANS AFTER THE COOKING APPLIANCES HAVE BEEN TURNED OFF AND/OR THE HEAT IN THE EXHAUST
- A DIGITAL CONTROLLER SHALL PROVIDE AN ADJUSTABLE MINIMUM FAN RUN-TIME SETTING TO PREVENT FAN CYCLING.

VARIABLE FREQUENCY DRIVES (VFDS) SHALL BE PROVIDED FOR FANS AS REQUIRED. THE DIGITAL CONTROLLER SHALL MODULATE THE VFDS BETWEEN A MINIMUM SETPOINT AND A MAXIMUM SETPOINT ON DEMAND. THE DUCT TEMPERATURE SENSOR INPUT(S) TO THE DIGITAL CONTROLLER SHALL BE USED TO CALCULATE THE SPEED REFERENCE SIGNAL.

- THE VFD SPEED RANGE OF OPERATION SHALL BE FROM 0% TO 100% FOR THE SYSTEM, WITH THE ACTUAL MINIMUM SPEED SET AS REQUIRED TO MEET MINIMUM VENTILATION REQUIREMENTS.
- AN INTERNAL ALGORITHM TO THE DIGITAL CONTROLLER SHALL MODULATE SUPPLY FAN VFD SPEED PROPORTIONAL TO ALL EXHAUST FANS THAT ARE LOCATED IN THE SAME FAN GROUP AS THE SUPPLY FAN.
- THE SYSTEM SHALL OPERATE IN PREP MODE DURING LIGHT COOKING LOAD OR COOL DOWN MODE WHEN SUFFICIENT HEAT REMAINS UNDERNEATH THE HOOD SYSTEM AFTER COOKING OPERATIONS HAVE COMPLETED. OPERATION DURING EITHER OF THESE PERIODS WILL DISABLE THE SUPPLY FANS AND PROVIDE AN EXHAUST FAN SPEED THAT IS EQUAL TO THE MINIMUM VENTILATION REQUIREMENT.
- A DIGITAL CONTROLLER SHALL DISABLE THE SUPPLY FAN(S), ACTIVATE THE EXHAUST FAN(S), ACTIVATE THE APPLIANCE SHUNT TRIP, AND DISABLE AN ELECTRIC GAS VALVE AUTOMATICALLY WHEN FIRE CONDITION IS DETECTED ON A COVERED HOOD.
- A DIGITAL CONTROLLER SHALL ALLOW FOR EXTERNAL BMS FAN CONTROL VIA DRY CONTACT (EXTERNAL CONTROL SHALL NOT OVERRIDE FAN OPERATION LOGIC AS REQUIRED BY CODE).
- AN LCD INTERFACE SHALL BE PROVIDED WITH THE FOLLOWING FEATURES:

 A. ON/OFF PUSH BUTTON FAN & LIGHT SWITCH ACTIVATION.

 B. INTEGRATED GAS VALVE RESET FOR ELECTRONIC GAS VALVES (NO RESET RELAY REQUIRED).


 C. VFD FAULT DISPLAY WITH AUDIBLE & VISUAL ALARM NOTIFICATION.

 D. DUCT TEMPERATURE SENSOR FAILURE DETECTION WITH AUDIBLE & VISUAL ALARM NOTIFICATION.

 E. MIS-WIRED DUCT TEMPERATURE SENSOR DETECTION WITH AUDIBLE & VISUAL ALARM NOTIFICATION.

 F. A SINGLE LOW VOLTAGE CAT-5 RJ45 WIRING CONNECTION.

G. AN ENERGY SAVINGS INDICATOR THAT UTILIZES MEASURED KWH FROM THE VFDS.

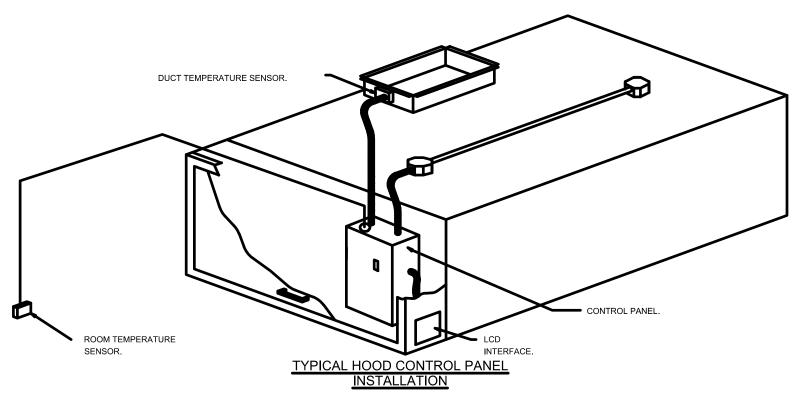

SEQUENCE OF OPERATIONS

THE HOOD CONTROL PANEL IS CAPABLE OF OPERATING IN ONE OR MORE OF THE FOLLOWING STATES AT ANY GIVEN TIME:

- AUTOMATIC: THE SYSTEM OPERATES BASED ON THE DIFFERENTIAL BETWEEN ROOM TEMPERATURE AND THE TEMPERATURE AT THE HOOD CAVITY OR EXHAUST DUCT COLLAR. FANS ACTIVATE AT A CONFIGURABLE TEMPERATURE DIFFERENTIAL THRESHOLD. DEPENDING ON THE JOB CONFIGURATION EACH FAN ZONE CAN BE CONFIGURED AS STATIC OR DYNAMIC. THESE TERMS REFER TO WHETHER A VARIABLE MOTOR (SUCH AS EC MOTORS OR VFD DRIVEN MOTORS) MODULATE WITH TEMPERATURE. IF THE PANEL IS EQUIPPED WITH VARIABLE SPEED FANS AND THE ZONE IS DEFINED AS "DYNAMIC", THESE WILL MODULATE WITHIN A USER-DEFINED RANGE BASED ON THE TEMPERATURE DIFFERENTIAL. PANELS EQUIPPED WITH VARIABLE SPEED FANS AND A FAN ZONE DEFINED AS "STATIC", FANS WILL RUN AT A SET SPEED CALCULATED FOR THE DRIVE. DEMAND CONTROL VENTILATION SYSTEMS ARE CAPABLE OF MODULATING EXHAUST AND MAKE UP AIR FAN SPEEDS PER THE REQUIREMENTS OUTLINED IN IECC 403.2.8.
- MANUAL: THE SYSTEM OPERATES BASED ON HUMAN INPUT FROM AN HMI.
- SCHEDULE: A WEEKLY SCHEDULE CAN BE SET TO RUN FANS FOR A SPECIFIED PERIOD THROUGHOUT THE DAY. THERE ARE THREE OCCUPIED TIMES PER DAY TO ALLOW FOR THE USER TO SET UP A TIME THAT IS SUITABLE TO THEIR NEEDS. ANY TIME THAT IS WITHIN THE DEFINED OCCUPIED TIME, THE SYSTEM WILL RUN AT MODULATION MODE AND FOLLOW THE FAN PROCEDURE ALGORITHM BASED ON TEMPERATURE DURING THIS TIME. DURING UNOCCUPIED TIME, THE SYSTEM WILL HAVE AN EXTRA OFFSET TO PREVENT UNINTENDED ACTIVATION OF THE SYSTEM DURING A TIME WHERE THE SYSTEM IS NOT BEING OCCUPIED.
- OTHER: THE SYSTEM OPERATES BASED ON THE INPUT FROM AN EXTERNAL SOURCE (DDC, BMS OR HARD-WIRED INTERLOCK).

MECHANICAL/ELECTRICAL GAS VALVE ACTUATED BY THE HOOD FIRE SUPPRESSION SYSTEM.

FIRE: UPON ACTIVATION OF THE HOOD FIRE SUPPRESSION SYSTEM, THE EXHAUST FAN WILL COME ON OR CONTINUE TO TO RUN, THE HOOD MAKEUP AIR WILL SHUTDOWN, AND A SIGNAL WILL BE SENT FOR ACTIVATING THE SHUNT TRIP BREAKER PROVIDED BY THE ELECTRICIAN. FUEL GAS WILL SHUT OFF VIA A



ENGINEER:

JS ENGINEERING, INC.


MECHANICAL • ELECTRICAL


410 S. SAN GABRIEL BLVD., SUITE 8, SAN GABRIEL, CA 91776
PHONE: 626.497.0558 EMAIL: INFO@CAL-PACIFIC.NET


FIRE S	YSTE	M INFORMATIO	N - JOB#4667178							
FIRE				FLOW	INSTALLATION					
SYSTEM NO	TAG	TYPE	SIZE	POINTS	SYSTEM	LOCATION ON HOOD				
1		ANSUL R102	3.0/3.0	18	FIRE CABINET RIGHT	RIGHT, HOOD 1				

						GAS	S VALVE	ES AND	STRAI	NERS						
	GAS VALVE SIZING							GAS VALVE DIMENSIONS NSTALLATION PART NUMBERS							S	
TYPE	TYPE SIZE VOLTAGE MIN. MAX. INLET FLOW AT 1 IN.W.C. FLOW AT 1 IN.W.						DIM "A"	DIM "B"	DIM "C"	DIM "D"	DIM "F"	DIM "G"	MOUNTING ORIENTATION	GAS VALVE PART NUMBER	STRAINER PART NUMBER	GAS VALVE/STRAINER KIT
MECHANICAL	1-1/2"	N/A	PR 6 \$84RE (0 IN.W.C.)	10 PSI (277 IN.W.C.)	1,706,569 BTU/HR	6-3/8"	4-7/8"	5-3/4"	6-3/16"	12-5/8"	11-3/8"	HORIZONTAL	27-55607	4417K67	MGVA1-1/2	

PROPER CLEARANCE MUST BE PROVIDED IN ORDER TO SERVICE THE TO CALCULATE GAS FLOW FOR OTHER THAN 1 IN.W.C. PRESSURE DROP STRAINERS A MINIMUM OF 4" CLEARANCE DISTANCE MUST BE NEW BTU/HR = (BTU/HR AT 1 IN.W.C. PRESSURE DROP) X NEW PRESSURE DROP PROVIDED AT THE BASE OF THE STRAINER CUSTOMER MUST VERIFY TO CALCULATE GAS FLOW FOR OTHER THAN 0.64 SPECIFIC GRAVITY BTU CONSUMPTION AS WELL AS PRESSURE RATING SPECIFIC GRAVITYNEW BTU/HR = (BTU/HR AT 0.64) X (0.64 / NEW SPECIFIC GRAVITY) 0.5. OF NATURAL GAS = 0.64, SPECIFIC GRAVITY OF LP = 1.52

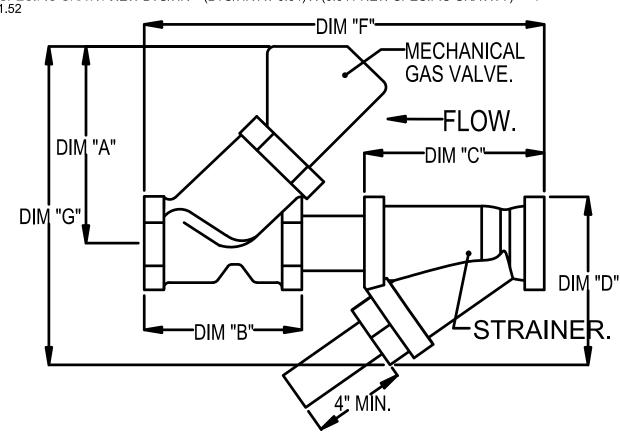

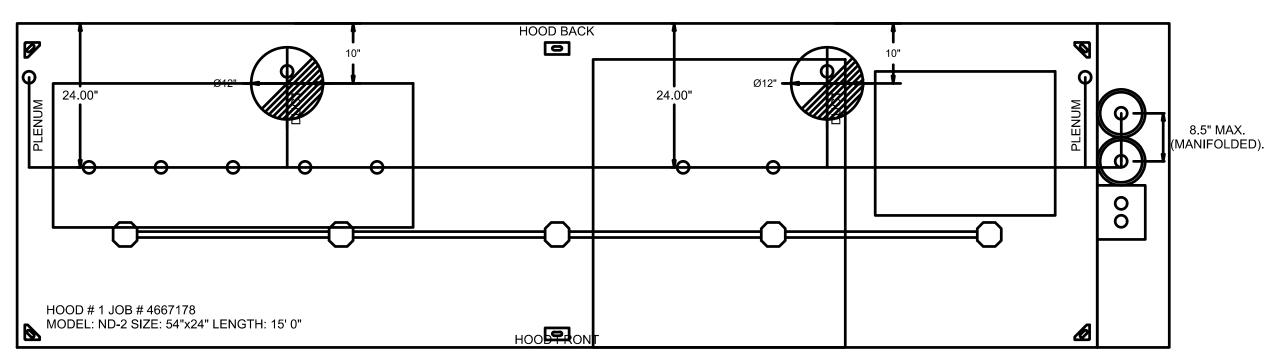

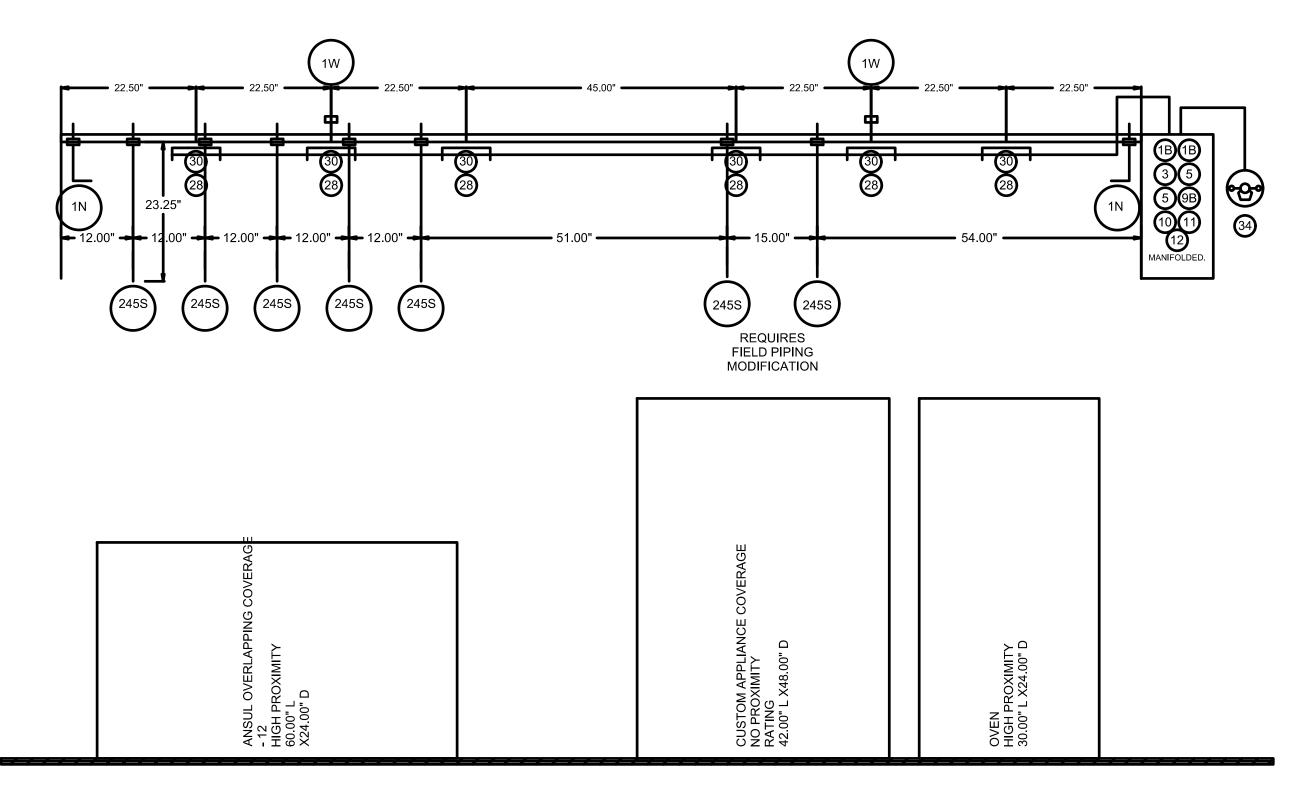

Į	ELECTRICAL F	PACKAGE -										
	JOE#4667178 NO TAG	PACKAGE#	LOCATION	SWITCH	HES	OPTION	FAN	IS CONTROLLED	כ			
ı				LOCATION	QUANTITY		FAN TAG	TYPE	ф	HP	VOLT	FL
I	1	DCV-1011	UTILITY CABINET RIGHT	04 - UTILITY CABINET RIGHT	1 LIGHT	SMART CONTROLS DCV	KEF-1	EXHAUST	3	2,000	208	Q
ı	' 	DCV-1011	OTILITI CABINET RIGHT	HOOD # 1	1 FAN	GIVIANT CONTROLS DOV	NET-1	LAHAUST		2.000	200	0.

FIRE SYSTEM PARTS LIST KEY

FIRE SYSTEM NO	TAG	KEY NUMBER - PART DESCRIPTION	QTY BY FACTORY	QTY BY DIST
		0 - 0 - 43-15733 AIR CYLINDER ASSEMBLY - AIR CYLINDER AND TUBING FOR MECHANICAL GAS VALVES (ANSUL PART #15733).	1	0
		0 - 0 - 439861 LARGE BLOWOFF CAP, METAL, TO FIT NEW LASER-ETCHED ANSUL NOZZLES, A0024201.	11	0
		0 - 0 - DISC UNION BURSTING DISC UNION ASSEMBLY FOR MANIFOLD SYSTEM.	1	0
		0 - 0 - TANK STRAP TANK STRAP - USED FOR ANSUL TANKS.	2	0
		0 - 0 - UCTANKBRACKET TANK BRACKET FOR FIRE SYSTEM TANK INSTALLATION IN UTILITY CABINETS.	2	0
		1 - 1 - AT - 3.0 TANK(#1B) - 3.0 GALLON SS TANK (FOR USE WITH AUTOMAN RELEASE, ACTUATOR, OR SS ENCLOSURE (UL/ULC)) MACOLA # 01-429862.	2	0
		3 - 3 - ANS-OEM REGULATED RELEASE - ANSUL REGULATED MECHANICAL RELEASE/BRACKET ASSEMBLY, OEM, R-102, CARTRIDGE DETECTION INCLUDED. ANSUL PART # 79493.	1	0
		5 - 5 - LIQ-3.0 AGENT - ANSULEX LOW PH WET CHEMICAL AGENT, 3 GALLON (UL) 79372.	0	2
		9 - 9 - DT-CART DOUBLE TANK NITROGEN CARTRIDGE.	0	1
		10 - 10 - TLINK LINK - TEST LINK (1 TEST LINK) ANSUL PART # 24916, MACOLA # 20-24916.	0	1
1		11 - 11 - MICRO-SDA MICROSWITCH KIT- INCLUDES 2 SWITCHES AND MOUNTING HARDWARE. SINGLE DUAL ELECTRIC SWITCH, ONE STANDARD SWITCH, ONE ALARM DUTY SWITCH ANSUL PART # 437155, MACOLA # 08-437155.	1	0
		12 - 12 - HOSE HOSE - RUBBER HOSE.	1	0
		14 - 14 - 419336 NOZZLE - 1W NOZZLE, DUCT/APPLIANCE (REPLACES ANSUL PART# 419347, CAS PART# 419336) A0001266.	2	0
		16 - 16 - 419335 NOZZLE - 1N NOZZLE, PLENUM/APPLIANCE (REPLACES ANSUL PART# 419346, CAS PART# 419335) A0001265.	2	0
		20 - 20 - 419340 NOZZLE - 245 NOZZLE, APPLIANCE (REPLACES ANSUL PART# 419351, PART# 419340) A0001270.	7	0
		25 - 25 - 418569 NOZZLE ADAPTOR - SWIVEL NOZZLE ADAPTOR (REPLACES CAS PART # 418569) A0001274.	7	0
		26 - 26 - QSA-3/8 QUIK SEAL - 3/8" (UL).	11	0
		27 - 27 - QPSA-1/2 PULLEY SEAL - 1/2" HOOD SEAL (UL) ANSUL PART # 423253, MACOLA # 32-79768.	1	0
		28 - 28 - S-DET DETECTOR - SERIES (SCISSOR LINKAGE) ANSUL PART # 435547/435548 (OLD # 417369/434480); MACOLA # 05-417369.	6	0
		30 - 30 - ANS-500FL FUSIBLE LINK - 500DEG F, R-102 AND PIRANHA, ANSUL PART # 439232.	6	0
		34 - 34 - RPS-A REMOTE PULL STATION - RED COMPOSITE (WITHOUT WIRE ROPE) 434618 (OLD MACOLA #06-4835).	1	0
		35 - 35 - PE-LT PULLEY ELBOW - LOW TEMP. PULLEY ELBOW, SET SCREW TYPE ANSUL PART # 415670, MACOLA # 11-415671.	2	0
		36 - 36 - PE-HT PULLEY ELBOW - HIGH TEMP PULLEY ELBOW, COMPRESSION TYPE, ANSUL PART # 423251, MACOLA # 10-45771.	1	0

- FIELD PIPE DROPS AS SHOWN

SLEEVING, ELBOWS, TEES, AND NOZZLES SUPPLIED BY CAS.

- RELOCATE NOZZLES IF FLOW PATTERN IS BLOCKED BY SHELVING, SALAMANDERS, ETC.

- MAXIMUM 9 ELBOWS IN SUPPLY LINE.

- MINIMUM 72 INCHES OF AGENT LINE FROM TANK TO FIRST NOZZLE

COVERING A RANGE, FRYER, OR WOK TO REFLECT GENERAL PIPING REQUIREMENTS. - IF APPLICABLE, PRE-PIPED CHARBROILER DROPS ARE SHIPPED LOOSE.

- FACTORY PIPING EXTENDS A MAXIMUM OF 6" ABOVE THE TOP OF THE HOOD.

- APPLIANCE DIMENSIONS LISTED REPRESENT THE COOKING SURFACE

- THIS FIRE SYSTEM COMPLIES WITH U.L. 300 REQUIREMENTS.

JOB #: 4667178.

SIZE, NOT THE OVERALL APPLIANCE SIZE.

JOB NAME: BURGER KING - BRANTFORD, ON.

SYSTEM SIZE: ANSUL-3.0/3.0-MANIFOLD TOTAL FP REQUIRED: 18.

HOOD # 1 15' 0.00" LONG x 54" WIDE x 24" HIGH. RISER # 1 SIZE: 12" DIA.

RISER # 2 SIZE: 12" DIA.

HOOD # 1 METAL BLOW-OFF CAPS INCLUDED.

LEGEND - FIRE CABINET ANSUL

1.5 GALLON TANK.

3 GALLON TANK.

OEM AUTOMAN RELEASE.

OEM REGULATED RELEASE.

OEM REGULATED ACTUATOR.

ANSULEX LIQUID AGENT (3 GAL.).

ANSULEX LIQUID AGENT (1.5 GAL.).

CARTRIDGE (101-20).

CARTRIDGE (101-10).

CARTRIDGE (101-30).

CARTRIDGE (LT-A-101-30). DOUBLE TANK CARTRIDGE.

TEST LINK.

DOUBLE MICROSWITCH. HOSE ASSEMBLY.

DUCT NOZZLE (430913).

2W DUCT NOZZLE (419337).

NOZZLE ASSEMBLY (419336).

NOZZLE ASSEMBLY (419333). NOZZLE ASSEMBLY (419335).

NOZZLE ASSEMBLY (419334).

NOZZLE ASSEMBLY (419338).

NOZZLE ASSEMBLY (419340).

230 NOZZLE ASSEMBLY (419339). NOZZLE ASSEMBLY (419343).

NOZZLE ASSEMBLY (419342).

NOZZLE ASSEMBLY (419341).

DETECTOR BRACKET.

LOW TEMP FUSIBLE LINK.

HIGH TEMP FUSIBLE LINK. MECHANICAL GAS VALVE.

ELECTRICAL GAS VALVE.


REMOTE MANUAL PULL STATION. SWIVEL ADAPTOR.

> ENGINEER: JS ENGINEERING, INC. 410 S. SAN GABRIEL BLVD., SUITE 8, SAN GABRIEL, CA 91776 PHONE: 626.497.0558 EMAIL: INFO@CAL-PACIFIC.NET


KING

BURGER

M-4.3

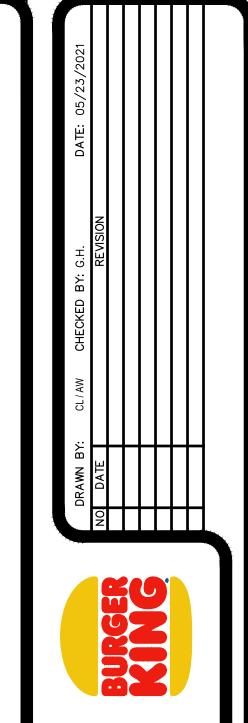

C:\Users\charl\OneDrive\2021 Project\DesignUA\Burger King\BK001 Desert Hot Springs\CD\r1\M40 Hood Details.dwg, 5/21/2021 3:23:26 AM, charl, AutoCAD PDF (General Documentation).pc3, CAL Arc1

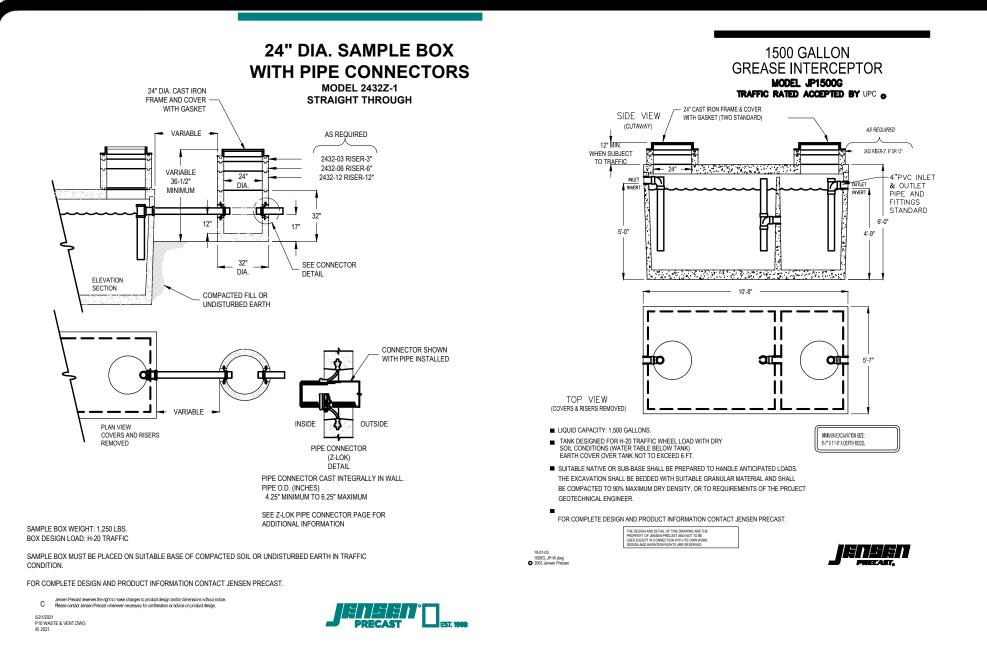



- 1. PLUMBING CONTR. TO COORDINATE VENT STACKS WITH OUTSIDE AIR INTAKES OF A/C UNITS AND SUPPLY FANS & MAINTAIN AT LEAST 10'-0" MIN. CLEARANCE OR AS PER LOCAL CODE REQUIREMENTS. FLAT VENTS ARE NOT ALLOWED.
- 2. INCREASE V.T.R.'S TO SIZE REQUIRED BY LOCAL CODES AND CONDITIONS AS REQUIRED FOR FROST ENCLOSURE. FLAT VENTS ARE NOT ALLOWED.
- 3. RUN SYRUP LINES FROM SODA FACTORY TO DRINK DISPENSER ABOVE CEILING.
- 4. CAST IRON PIPE MAY BE USED UNDER SLAB IN LIEU OF PVC ONLY IF REQUIRED BY CODE.
- 5. PROVIDE CONDENSATE LINES FROM A/C UNITS ABOVE CEILING ACCORDING TO LOCAL CODE REQUIREMENTS.
- 6. RESEAL FLOOR DRAINS ACCORDING TO LOCAL REQUIREMENTS.
- 7. SAFEWASTE PIPING ABOVE AND ALONG FLOOR SHALL BE SIZED IN ACCORDANCE WITH LOCAL CODE REQUIREMENTS.
- 8. COORDINATE SAFEWASTE LINE CONNECTIONS WITH EQUIPMENT ROUGH-IN.
- 9. P.V.C. (SCHEDULE 40) PIPE CAN BE USED FOR VENTS AND WASTE ONLY IF APPROVED BY LOCAL BUILDING CODES. SEE SPECS. FOR ADD'L. INFO.
- 10. SEE FOUNDATION PLAN FOR EXACT LOCATION OF FLOOR DRAINS AND FLOOR SINKS.
- 11. IF WALK-IN-BOX CONDENSATE LINE IS REQUIRED BY LOCAL CODE, PLUMBING CONTRACTOR SHALL FURNISH AND INSTALL 1" CONDENSATE LINE, AND SEAL AROUND ALL PENETRATIONS THROUGH THE WALK-IN-BOX.
- 12. HEAT TAPE IS PROVIDED BY WALK-IN-BOX MANUFACTURER AND INSTALLED BY ELECTRICAL CONTRACTOR. IT IS TO BE SELF-LIMITING TYPE, "FROSTEX" OR EQUAL.

(#) KEY NOTES:

- 1. SODA CONDUIT: PROVIDE 4" PVC CONDUIT AND SYRUP LINES FROM SODA FACTORY TO DRINK DISPENSER ABOVE CEILING.
- 2. CONDENSATE: ROUTE SHARED CONDENSATE LINE THROUGH WALK-IN COOLER. DO NOT RUN THROUGH WALK-IN FREEZER. PROVIDE 1" INSULATED CONDENSATE DRAIN PIPE FROM THE EVAPORATIVE COIL. DISCHARGE TO FLOOR SINK OR MOP SINK WITH AIR GAP OF TWICE PIPE DIAMETER. INSTALL AT MINIMUM 76" HEIGHT A.F.F. REFER TO DETAIL #3 ON SHEET P-3.0.
- 3. COMBINATION WASTE/VENT
- 4. 3" PVC ROOF DRAIN WITH 3" PVC LAMB'S TONGUE NOZZLE, COLOR ANTIQUE BRONZE, ARKMANN MODEL #PDN-3. OVERFLOW ACHIEVED WITH SCUPPER AT THIS CONDITION. REFER TO DETAIL #18 ON SHEET P-3.0
- 5. TRAP PRIMER REFER TO DETAIL #17 ON SHEET P-3.0
- 6. 3/4" CONDENSATE DRAIN FROM AIR COMPRESSOR DN. TO MOP SINK WITH 2" AIR GAP ABOVE FLOOD RIM.
- 7. PROVIDED 3" VENT THROUGH ROOF


-				
	FIXTURE		WAS	TE FU
	FIXTURE TYPE	QTY	EACH	TOTAL
WC 1	WATER CLOSET	2	4	8
L 1	LAVATORY	2	1	2
HS 1	HAND SINK	1	2	2
HS 2	HAND SINK (COUNTERTOP)	1	2	2
MS 1	MOP SINK	1	3	3
S 1	3 COMP. SINK	1	3	3
<u>S</u> 2	1 COMP. SINK	1	3	3
FS 1			1	4
			3	9
			2	4
FD 2			3	15
TOTAL				55

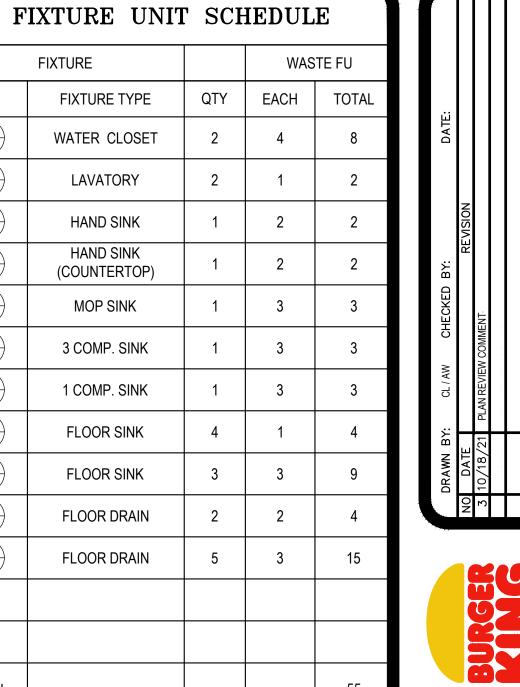


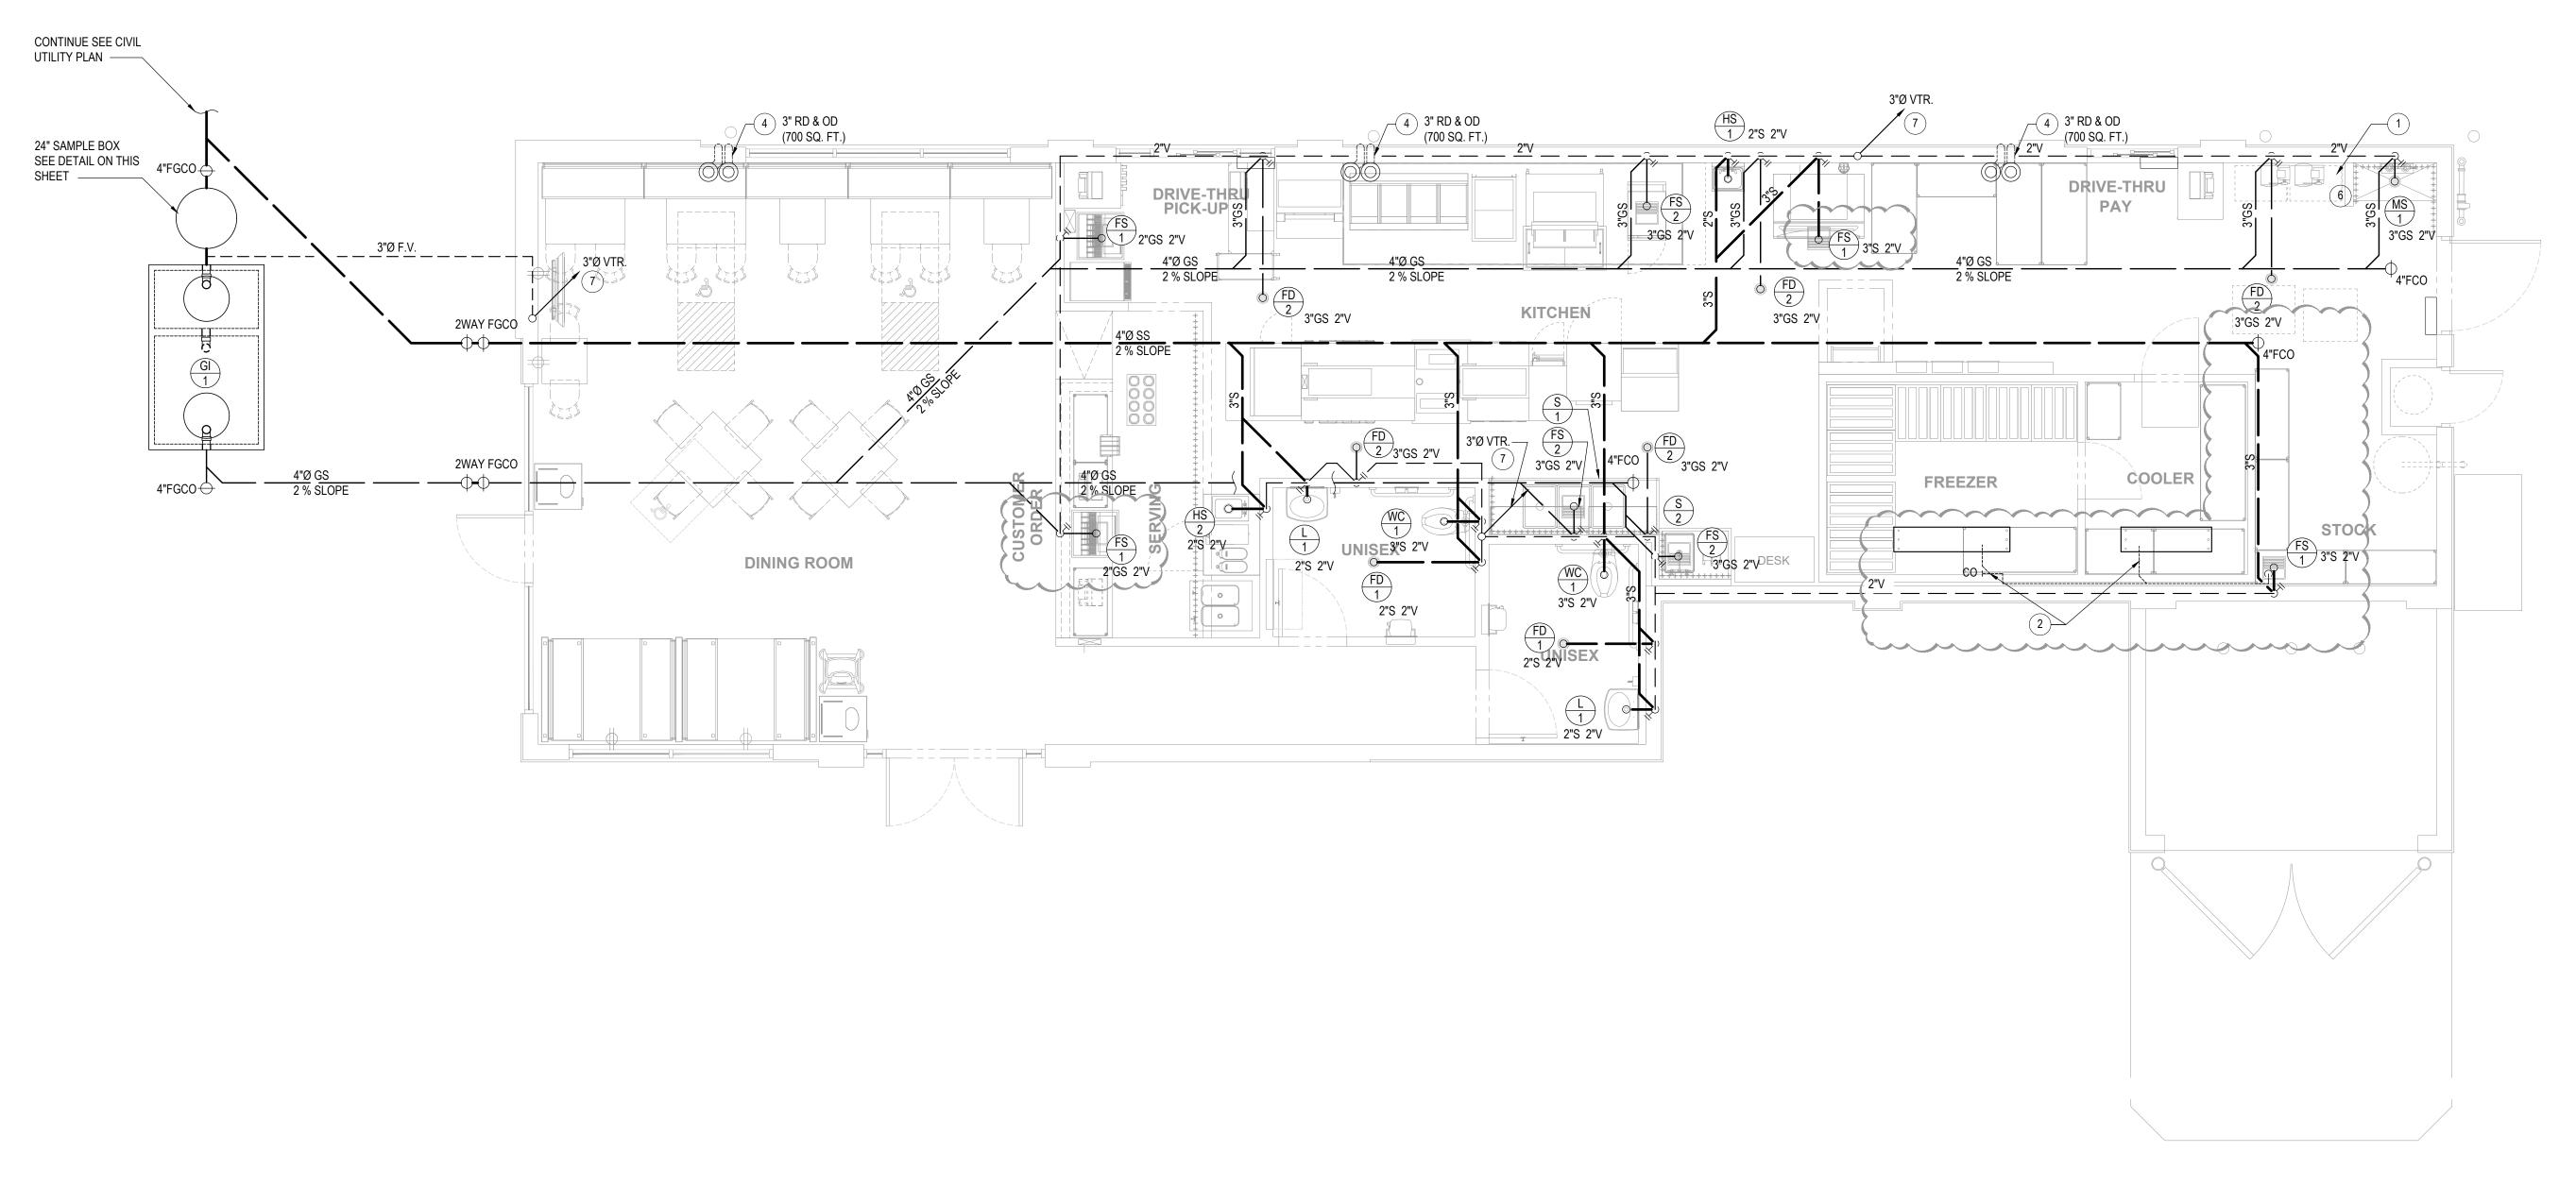


ENGINEER: JS ENGINEERING, INC. 410 S. SAN GABRIEL BLVD., SUITE 8, SAN GABRIEL, CA 91776 PHONE: 626.497.0558 EMAIL: INFO@CAL-PACIFIC.NET

SANITARY AND GREASY WASTE PLAN

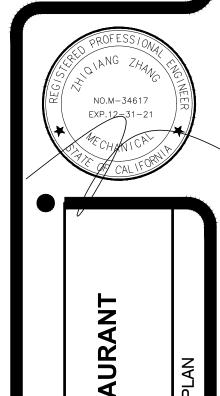

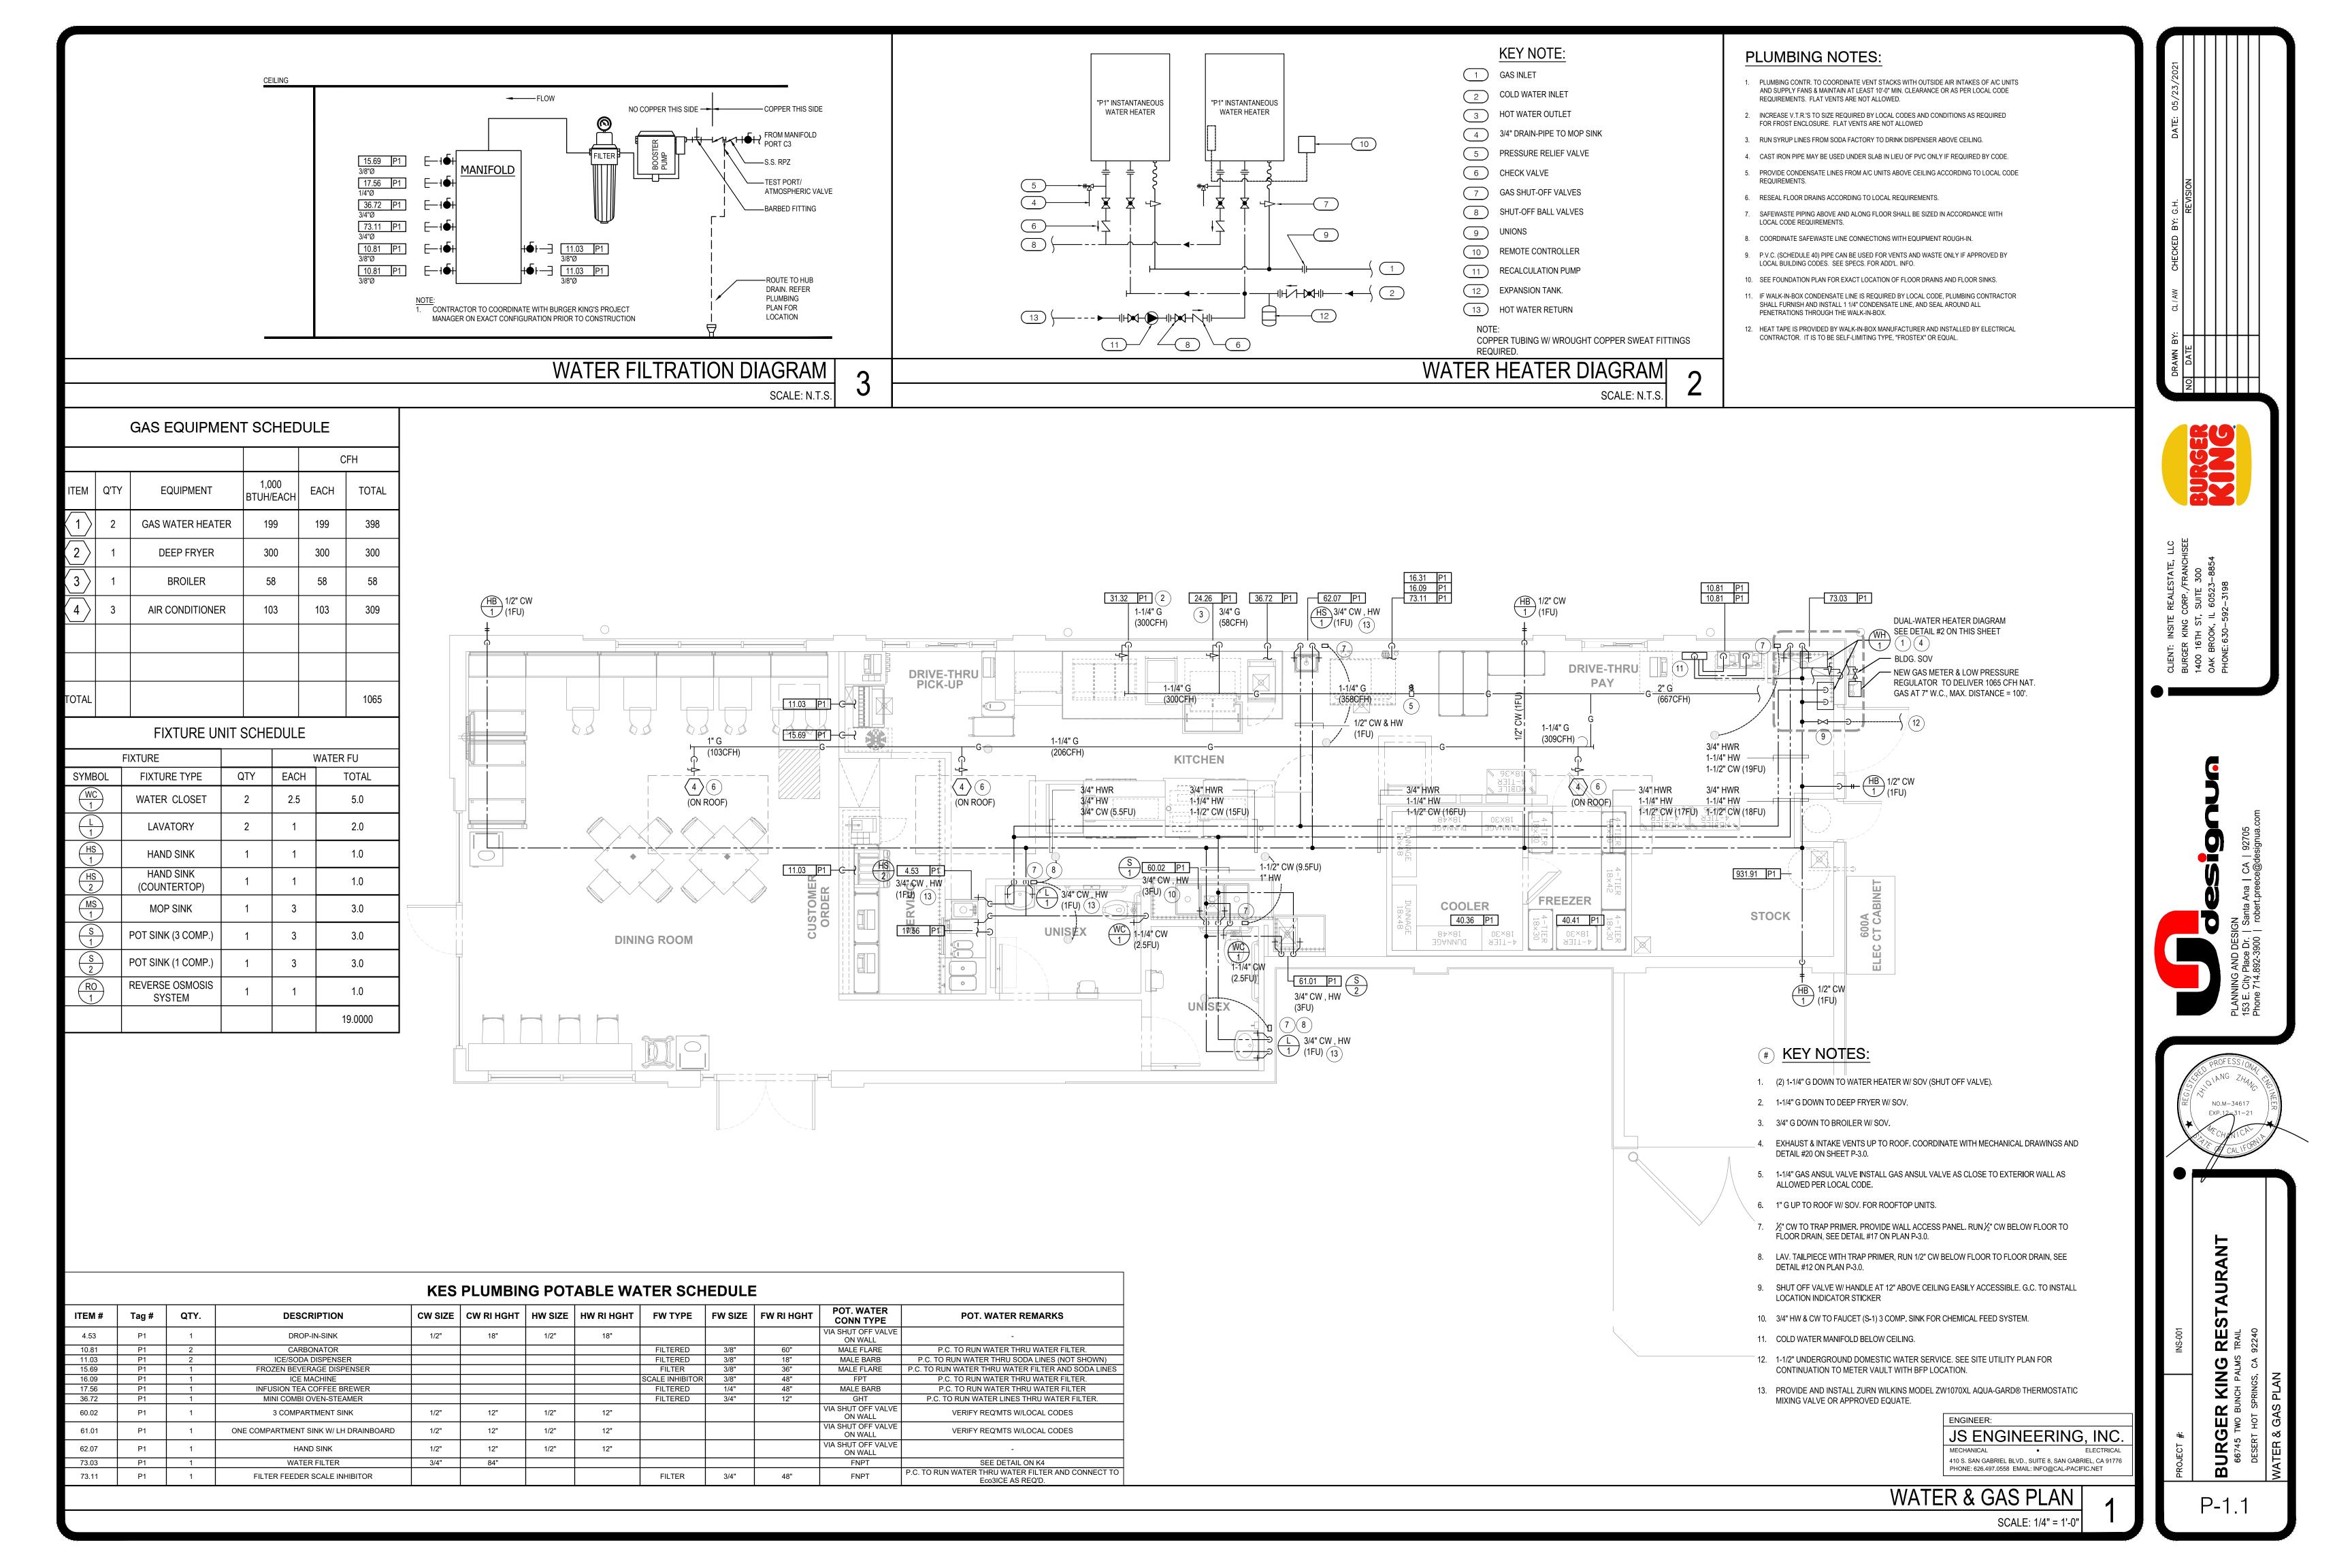

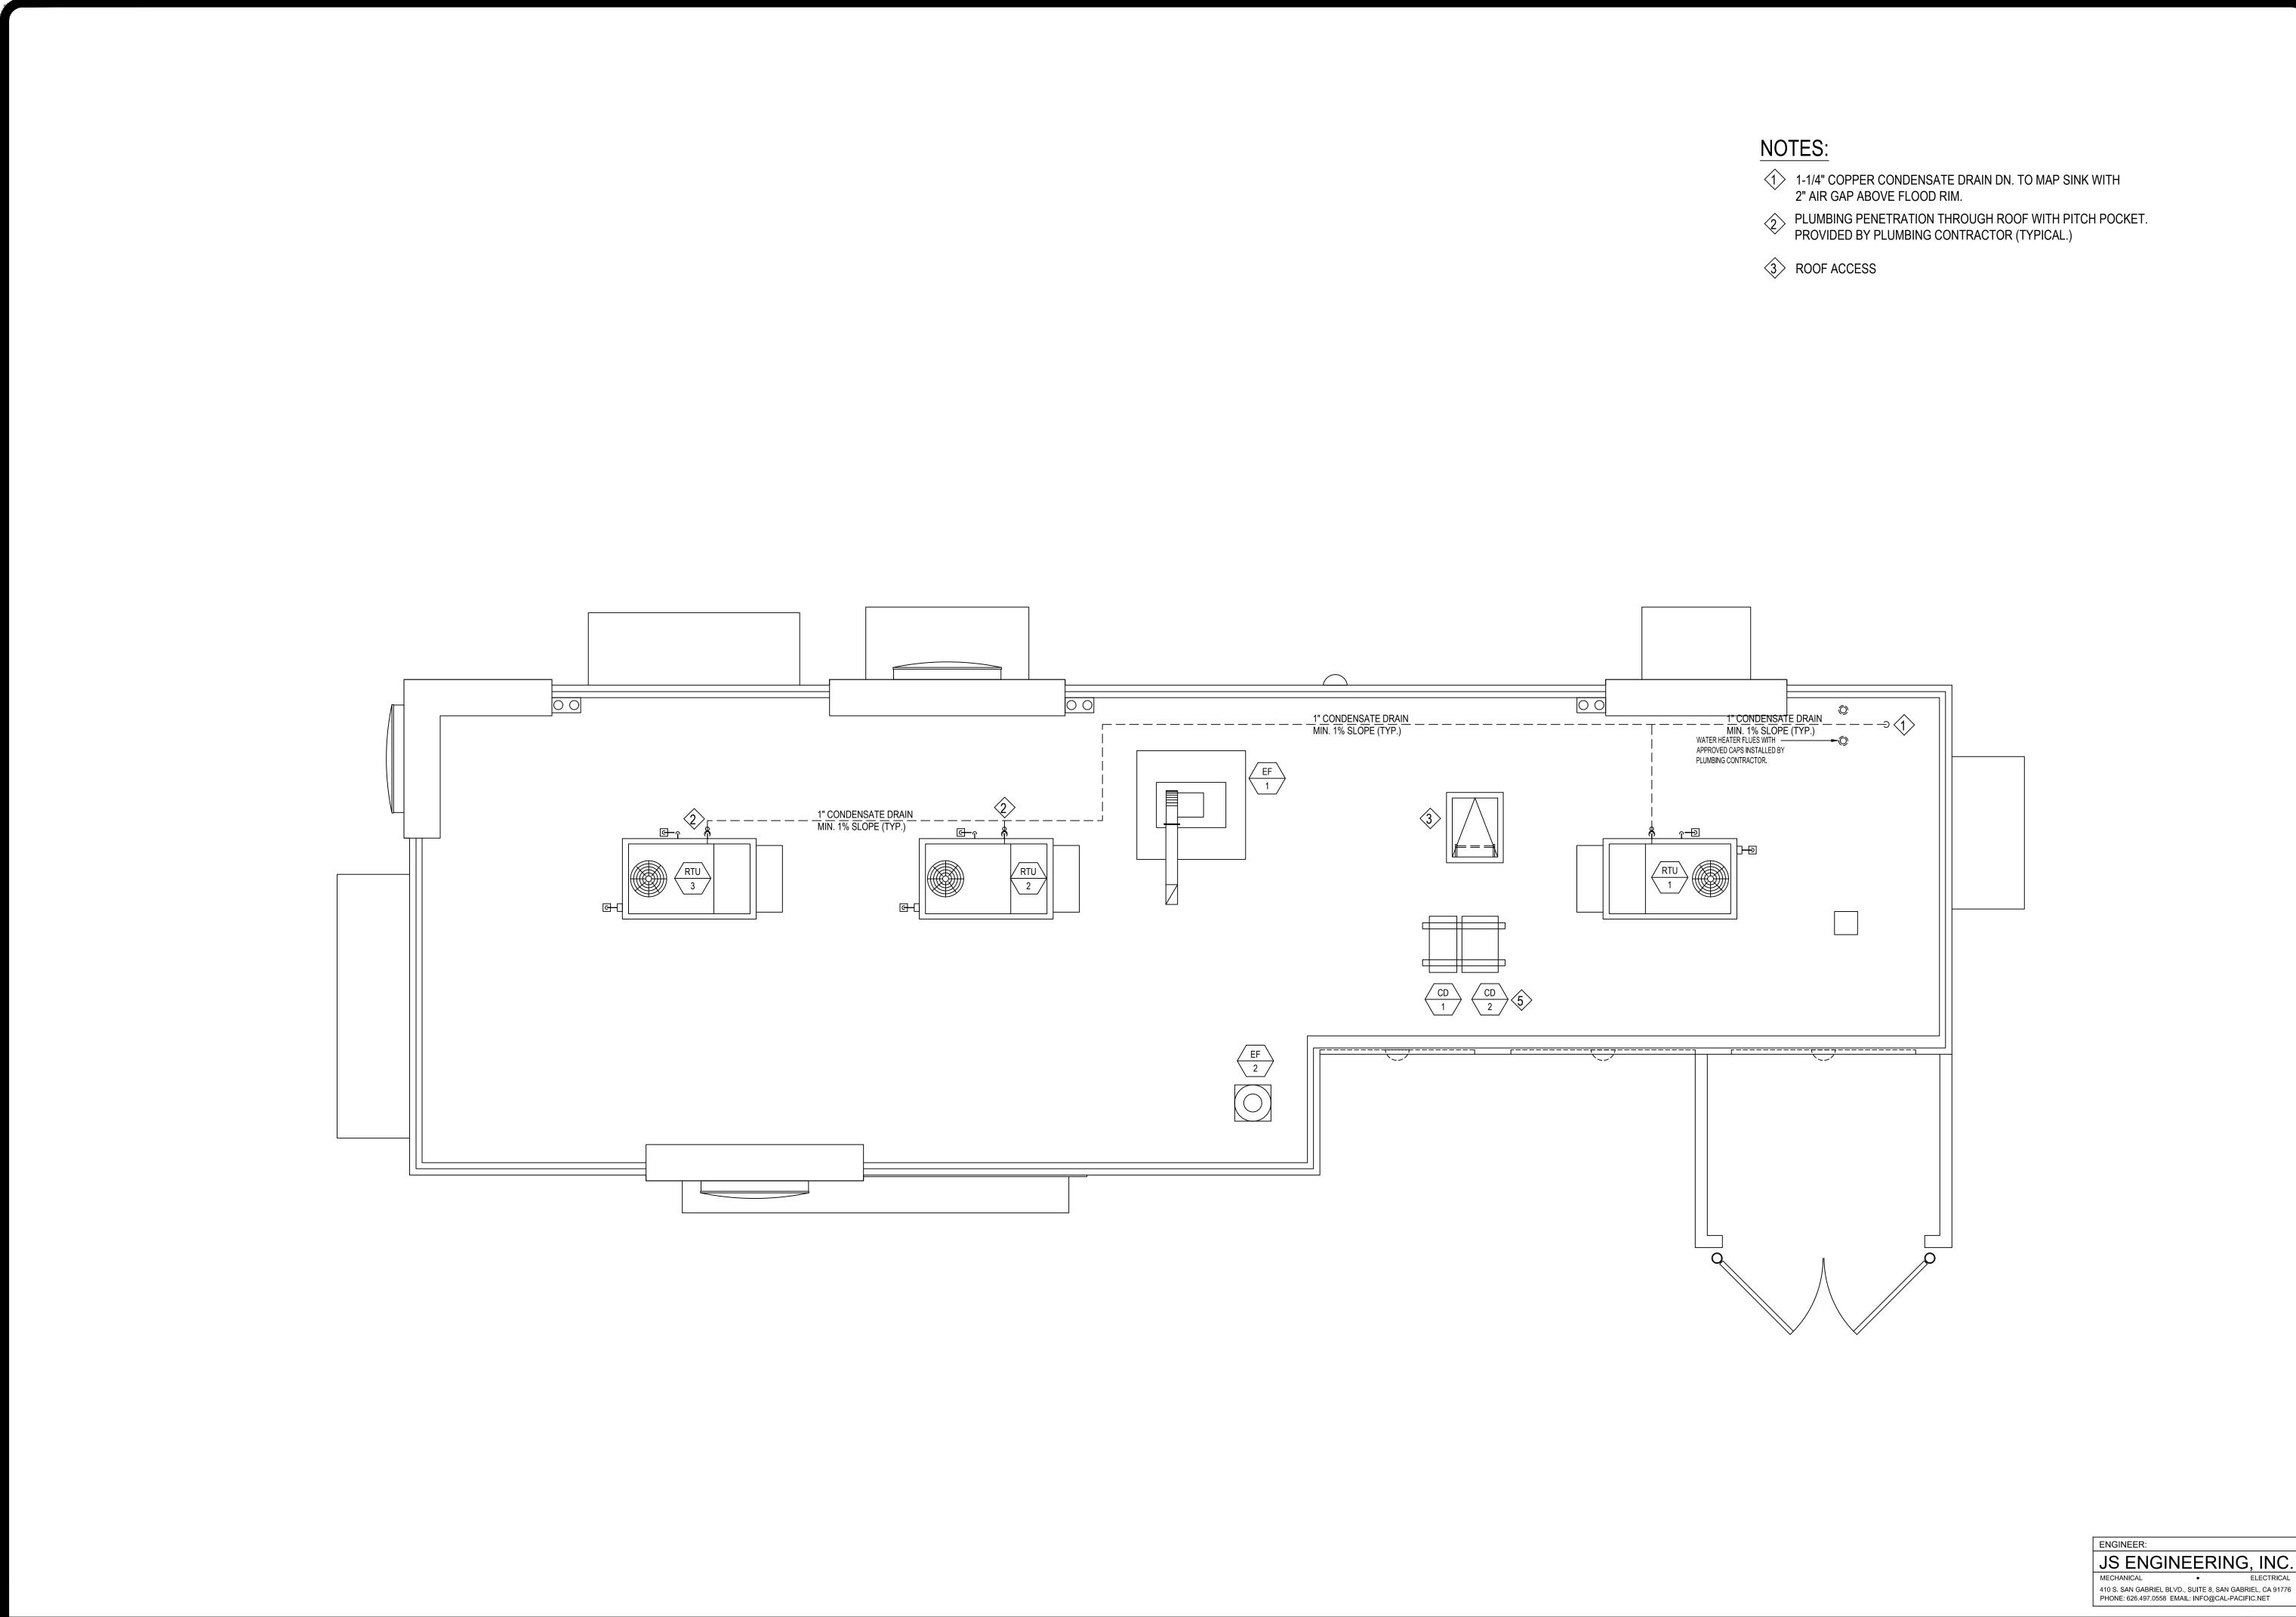

CL/AW CHECKED BY: G.H. DATE: 05/23/2021
REVISION


CLIENT: INSITE REALESTATE, LLC
BURGER KING CORP./FRANCHISEE
1400 16TH ST, SUITE 300
OAK BROOK, IL 60523-8854
PHONE: 630-3108

LANNING AND DESIGN 53 E. City Place Dr. | Santa Ana | CA | 92705



NG RESTAURANT

URGER KING R

PLUMBING ROOF PLAN
SCALE: 1/4"= 1'-0"

P-1.2

- WORK INCLUDED; ALL LABOR, MATERIALS, EQUIPMENT AND INCIDENTALS REQUIRED TO FURNISH AND INSTALL ALL HVAC WORK AS INDICATED ON THE PLANS, SPECIFIED HEREIN, AND/OR AS NECESSARY TO COMPLETE THE WORK, INCLUDING, BUT NOT LIMITED TO, THE FOLLOWING:
- 1) SANITARY SOIL, WASTE AND VENT SYSTEM.
- 2) DOMESTIC HOT AND COLD WATER SYSTEMS.
- 3) CONDENSATE DRAIN SYSTEM.
- 4) PLUMBING FIXTURES, EQUIPMENT, TRIM
- 5) ROUGH-IN AND FINAL CONNECTIONS OF WATER, GAS AND DRAIN TO EQUIPMENT, NOT INCLUDED IN THIS SECTION OR AS FURNISHED BY OWNER.

6) TESTING.

2. EXAMINATION OF THE SITE

EXAMINE THE SITE AND ALL CONDITIONS THEREON OR THEREIN TAKE INTO CONSIDERATION ALL CONDITIONS THAT MAY AFFECT THE WORK UNDER THIS CONTRACT. LACK OF THIS INFORMATION WILL NOT BE CONSIDERED AS JUSTIFICATION FOR EXTRA COST OR ALLOWANCES TO THE CONTRACT SUM.

3. CODES AND REGULATIONS.

- A. ORDINANCES AND REGULATIONS: IN ADDITION TO COMPLYING WITH THE SPECIFIED REQUIREMENTS, COMPLY WITH PERTINENT REGULATIONS OF GOVERNMENTAL AGENCIES HAVING JURISDICTION
- B. PERMITS AND INSPECTIONS: APPLY AND PAY FOR ALL PERMITS FOR THE INSTALLATION OR CONSTRUCTION OF THE PLUMBING WORK REQUIRED BY ANY LEGALLY CONSTITUTED PUBLIC AUTHORITIES HAVING JURISDICTION AND FURNISH ALL NECESSARY DRAWING REQUIRED FOR SAME. ARRANGE FOR INSPECTIONS AND EXAMINATIONS AS REQUIRED, AND DELIVER CERTIFICATES OF ALL INSPECTIONS TO THE OWNER.

4. DRAWINGS AND SPECIFICATIONS.

- A. THE DRAWING ARE IN PART DIAGRAMMATIC AND ARE INTENDED TO CONVEY THE SCOPE OF THE WORK: THEY INDICATE THE GENERAL ARRANGEMENT AND APPROXIMATE SIZES OF EQUIPMENT, PIPING, ETC. FOLLOW THE DRAWINGS AS CLOSELY AS PRACTICAL IN LAYING OUT THE WORK, BE GUIDED BY THE CONDITIONS AT THE JOB AND CONSULT THE CONSTRUCTION DRAWINGS OF THE OTHER TRADES TO BECOME FAMILIAR WITH ALL CONDITIONS AFFECTING THE WORK.
- B. VERIFY ALL CLEARANCES IN AREAS WHERE WORK WILL BE INSTALLED AND COORDINATE THE WORK WITH THAT OF THE OTHER TRADES AND OTHER SECTIONS OF THE SPECIFICATIONS.
- C. WHERE JOB CONDITIONS, OR THE ARCHITECT REQUIRE REASONABLE CHANGES IN INDICATED LOCATIONS AND ARRANGEMENT, MAKE SUCH CHANGES WITHOUT ADDITIONAL CHARGE.
- D. IT IS THE INTENT OF THE DRAWINGS AND SPECIFICATIONS TO PROVIDE COMPLETE OPERATING SYSTEMS, UNLESS SPECIFICALLY NOTED TO THE CONTRARY. THE OMISSION FROM THE DRAWINGS OR SPECIFICATIONS OF ANY MINOR DETAILS OF CONSTRUCTION INSTALLATION, MATERIALS, OR SPECIALTIES NECESSARY FOR A SAFETY OPERABLE SYSTEM SHALL NOT RELIEVE THE CONTRACTOR FROM FURNISHING THE SUCH ITEMS, IN PLACE, COMPLETE.

5. SUBSTITUTIONS

- A. WHENEVER A PRODUCT IS SPECIFIED BY TRADE NAME OR MANUFAC-TURER'S NAME, EITHER IN THE SPECIFICATIONS OR ON THE DRAWINGS SUCH DESIGNATION IS INTENDED TO ESTABLISH A STANDARD OR MERIT AND DESIGN.
- B. SUBMIT WRITTEN REQUESTS FOR SUBSTITUTIONS IN TRIPLICATE. INCLUDE CATALOG NUMBERS. CAPACITIES. RATINGS AND THE CUTS OF PRODUCTS SPECIFIED AS WELL AS PRODUCTS TO BE SUBSTITUTED. ALSO INCLUDE ACCURATE COST DATA ON THE PROPOSED AND WHETHER OR NOT MODIFICATION OF THE CONTRACT AMOUNT IS TO BE CONSIDERED.
- C. SUBSTITUTIONS OF UNLISTED MANUFACTURERS WILL NOT BE ALLOWED AFTER THE CONTRACT IS SIGNED.

6. SUBMITTALS

- A. PRODUCT DATA: SUBMIT MATERIAL LIST OF ITEMS PROPOSED TO BE PROVIDED UNDER THIS SECTION. INCLUDE MANUFACTURER'S SPECIFICATIONS, CATALOG CUTS, AND OTHER DATA NEEDED TO COMPLY WITH THE SPECIFIED REQUIREMENTS. SUBMIT ALL PRODUCT DATA AT ONE TIME, BOUND BETWEEN COVERS. PARTIAL SUBMITTALS WILL NOT BE ACCEPTED.
- B. SHOP DRAWINGS OR OTHER DATA AS REQUIRED TO INDICATE METHOD OF INSTALLATION AND ATTACHMENT OF PIPING, AND EQUIPMENT, EXCEPT WHERE SUCH DETAILS ARE FULLY SHOWN ON THE DRAWINGS.
- C. RECORD DRAWINGS AND MANUALS: PROVIDE AND KEEP AT JOB SITE A COMPLETE RECORD SET OF BLUE LINE PRINTS, CORRECTED DAILY TO SHOW EVERY CHANGE FROM THE ORIGINAL DRAWINGS AND SPECIFICATIONS. PRINTS FOR THIS PURPOSE MAY BE OBTAINED FROM THE ARCHITECT. DELIVER THE SET TO THE ARCHITECT. PAY FOR BLUEPRINTING PROJECT RECORD DRAWINGS.

7. OPENINGS

- A. OPENINGS OR HOLES FOR PIPING OR EQUIPMENT WILL NOT BE ALLOWED IN ANY STRUCTURAL MEMBERS WITHOUT CONSENT OF THE ARCHITECT.
- B. FRAMED OPENINGS HAVE BEEN INDICATED ON THE ARCHITECTURAL AND STRUCTURAL DRAWINGS. AT A TIME IN ADVANCE OF THE WORK. VERIFY THE LOCATION AND SIZE OF OPENINGS OR FURNISH NEW INSTRUCTIONS AS TO THE REQUIREMENTS FOR THESE OPENINGS. SHOULD THE FURNISHING OF THIS INFORMATION BE NEGLECTED, DELAYED OR INCORRECT, AND ADDITIONAL CUTTING, NOTCHING, OR BORING IS FOUND TO BE REQUIRED, THE WORK SHALL BE DONE AS DIRECTED BY THE ARCHITECT AT NO ADDITIONAL COST TO THE OWNER.

- C. MAKE ABSOLUTELY WATERTIGHT ANY OPENINGS THROUGH WATERPROOFED CONSTRUCTION CAUSED BY THE PENETRATION OF PIPING IN A MANNER APPROVED BY THE ARCHITECT
- 8. QUALITY ASSURANCE AND PRODUCT HANDLING
- A. USE ALL MEANS NECESSARY TO PROTECT PLUMBING MATERIALS BEFORE, DURING AND AFTER INSTALLATION AND TO PROTECT THE INSTALLED WORK AND MATERIALS OF ALL OTHER TRADES.
- B. IN THE EVENT OF DAMAGE, IMMEDIATELY MAKE ALL REPAIRS AND REPLACEMENTS NECESSARY TO THE SATISFACTION OF THE ARCHITECT AND AT NO ADDITIONAL COST TO THE OWNER.

9. NOISE AND VIBRATION

IT IS THE SPECIFIC INTENT OF THESE SPECIFICATIONS AND DESIGN CONDITIONS THAT THE ENTIRE SYSTEM INCLUDING EQUIPMENT, PIPING, AND ALL OTHER PARTS BE NOISELESS AND FREE OF VIBRATION TRANSMISSION. PROVIDE AND INSTALL VIBRATION DAMPER, SOUND INSULATION PADS, FLEXIBLE CONNECTORS AND SIMILAR MATERIAL AS REQUIRED, TO PREVENT TRANSMISSION TO THE BUILDING STRUCTURE OF SOUND AND VIBRATION CAUSED BY THE FLOW OF FLUIDS, MOTORS, MOTOR OPERATED EQUIPMENT. IF AS A RESULT OF THE INSTALLATION, NOISE OR VIBRATION OCCURS IN THE BUILDING, MAKE THE NECESSARY CORRECTIONS AT NO COST TO THE OWNER. DO NOT REDUCE THE CAPACITY OF ANY EQUIPMENT.

10. WARRANTY

BE RESPONSIBLE FOR ALL WORK UNDER THIS SECTION, ADJUST ALL VALVES, CONTROLS, VACUUM BREAKERS AND OTHER INCIDENTAL ITEMS. LEAVE THE SYSTEM IN PERFECT OPERATING CONDITION. REPAIR, REGULATE AND REPLACE ANY DEFECTIVE WORKMANSHIP MATERIALS, AND EQUIPMENT WHICH MAY BECOME APPARENT WITHIN ONE YEAR AFTER THE DATE OF THE FINAL ACCEPTANCE OF THE WORK. AT NO ADDITIONAL COST TO THE OWNER. FURNISH THE OWNER ALL MANUFACTURER'S WRITTEN WARRANTIES OF MATERIALS AND EQUIPMENT.

11. MATERIALS

- PROVIDE ALL NEW MATERIALS, IN PROPER CONDITION, OF THE BEST QUALITY FOR THE PURPOSE INTENDED, CLEARLY MARKED OR STAMPED WITH THE MANUFACTURER'S NAME AND/OR STAMP AND RATING.
- A. SOIL, WASTE AND VENT: CAST IRON NO HUB PIPE AND FITTINGS WITH STAINLESS STEEL CLAMP.
- B. DOMESTIC WATER (ABOVE GROUND): TYPE L HARD DRAWN COPPER ASTM B88. AND WROUGHT COPPER FITTINGS.

- 1. PROVIDE FITTINGS FOR CAST IRON SOIL PIPE OF THE SAME MATERIAL WEIGHT AND QUALITY SPECIFIED FOR PIPE.
- 2. PROVIDE FOE BLACK STEEL PIPES 2-1/2" AND SMALLER, BANDED BLACK MALLEABLE IRON FITTINGS.
- 3. PROVIDE FOE COPPER WATER PIPES, WROUGHT COPPER SOLDER JOINT FITTINGS. CAST FITTINGS WILL NOT BE PERMITTED.
- 4. PROVIDE FOR EXPOSED FIXTURE CONNECTIONS, 85% CAST RED BRASS, POLISHED AND CHROMIUM PLATED FITTINGS.

C. UNIONS

UNION SHALL BE PROVIDED AT ALL EQUIPMENT, AT POINTS ADJACENT TO ALL VALVES, AND ELSEWHERE AS REQUIRED TO PERMIT SERVING OF FIXTURES. UNIONS TO AS MANUFACTURED BY CRANE OR EQUAL

D. VALVES

1. GENERAL: NON RISING STEM MAY BE USED ONLY WHERE THERE IS INSUFFICIENT CLEARANCE. SOLDER JOINT OR SCREWED TYPE VALVES SHALL BE USED IN COPPER PIPING, VALVES OF ONE TYPE SHALL BE OF THE SAME MANUFACTURER. NIBCO OR APPROVED EQUAL

VALVES SCHEDULE

- GATE VALVE: NIBCO NO. S-113 GLOBE VALVE:NIBCO S-211-Y CHECK VALVE:NIBCO NO. S-413-Y BALL VALVE:NIBCO NO. S-580
- E. PIPE SUPPORTS
- FEE MASON OR APPROVED EQUAL

F. SLEEVES

PROVIDE ELCEN "E-Z CRETE" RUST-PROOF SLEEVES OF THE SIZE

G. ACCESS PANELS & BOXES

PROVIDE ACCESS PANELS AS MANUFACTURED BY J.R.SMITH ELMDOR OR EQUAL I QUALITY AND STYLE. PROVIDE ACCESS PANELS WITH THE SAME FIRE RATING AS THE WALL OR CEILING IN WHICH THE ARE INSTALLED.

- 1. PLASTER WALL AND CEILING: ELMDOR PW SERIES AKL HINGED PRIME COATED STEEL TRIM LESS ACCESS IN WITH PLASTER GROUND.
- 2. TILE, DRYWALL AND CEILING: ELMDOR PW SERIES AKL HINGED STAINLESS STEEL FLANGED ACCESS PANEL WITH BRIGHT FINISH FOR TILE WALLS,
- PRIME COATED STEEL FOR PAINTED WALLS. 3. ACOUSTICAL TILE: ELMDOR AT SERIES AKL HINGED PRIME COATED STEEL FLANGED ACCESS PANEL.
- 4. FIRE RATED WALL AND CEILING: ELMDOR FR SERIES AKL WITH RECESSED TURN LATCH.

H. FLASHING

PROVIDE FOR EACH PIPE PASSING THROUGH THE ROOF 3 LBS. SEAMLESS LEAD FLASHING ASSEMBLY-FLASHING TO HAVE STEEL REINFORCED CONICAL BOOT AND COUNTER FLASHED WITH HOODED CAST IRON COUNTER FLASHING MANUFACTURED BY STONE MAN OR EQUAL.

L. PRESSURE GAUGES AND THERMOMETER MARSH TRERICE OR APPROVED EQUAL.

13. MANUFACTURER'S RECOMMENDATIONS

INSTALL ALL EQUIPMENT, MATERIAL, FIXTURES, AND DEVICES IN ACCORDANCE WITH THE RECOMMENDATIONS OF THE MANUFACTURER AND THE REQUIREMENTS OF THE DRAWINGS AND SPECIFICATIONS. IN THE EVENT OF CONFLICT, CONSULT THE ARCHITECT FOR A DECISION AND PERFORM THE WORK IN ACCORDANCE WITH HIS DECISION.

14. INSTALLATION PIPING

A. GENERAL:

- 1. CLEAN ALL PIPE AND REMOVE ALL SCALE, SAND, DIRT, ECT. BEFORE INSTALLATION. USE FULL LENGTHS OF PIPE WHENEVER POSSIBLE TO MINIMIZE THE NUMBER OF COUPLINGS.
- 2. CUT PIPES ACCURATELY TO MEASUREMENTS ESTABLISH ON THE SITE. WORK PIPES INTO PLACE WITHOUT SPRINGING OR FORCING, AND PROPERLY CLEAR EQUIPMENT, DOORS, AND OPENINGS OF BUILDINGS.
- 3. INSTALL ALL PIPING TO RUN PARALLEL TO THE BUILDING CONSTRUCTION AND ARRANGE TO FORM NEAT AND SYMMETRICAL PATTERNS TO INSURE THE BEST APPEARANCE POSSIBLE.
- 4. UNLESS OTHERWISE SPECIFIED, CONCEAL ALL PIPE IN WALLS, PARTITIONS OR FURRED SPACES.
- 5. PROCEED WITH THE ROUGH PIPING AS RAPIDLY AS THE GENERAL CONSTRUCTION WORK WILL PERMIT AND HAVE ALL OF THE ROUGH PIPING IN AND STUBBED OUT TO THE PROPER POINT AND TESTED, IN EACH CASE, BEFORE ANY LATH, PLASTER OR FINISH WORK OF THE CEILINGS, PARTITIONS, WALL, OR FLOOR ARE IN PLACE.
- 6. INSTALL ALL PIPES WITH ALLOWANCES FOR EXPANSION AND CONTRACTION. CONSTRUCT SO THAT STRAINS WILL BE EVENLY DISTRIBUTED WITHOUT DAMAGE TO THE SYSTEM. AVOID BUILDING ERECTION STRESSES INTO THE PIPING.
- 7. MAKE CONNECTION BETWEEN COPPER OR BRASS PIPING AND STEEL WITH APPROVED DIELECTRIC COUPLINGS
- 8. AVOID CONNECTIONS BETWEEN COPPER INSTALLATION THAT COULD CAUSE A CROSS CONNECTION BETWEEN WATER SUPPLY AND DRAINAGE.
- 9. COVER ALL EXPOSED CONNECTIONS TO PLUMBING FIXTURES WITH
- POLISHED AND CHROMIUM PLATED SEAMLESS COPPER CASING. 10. SHOW NO TOOL MARKS OR THREADS ON EXPOSED PLATED,

POLISHED, OR ENAMELED CONNECTIONS FROM FIXTURES.

B. SOIL, WASTE, VENT AND DRAINAGE PIPING:

- 10. INSTALL PIPING AS STRAIGHT AS POSSIBLE AND MAKE ALL CHANGE IN DIRECTION WITH FITTINGS. MAKE OFFSETS AT 45 DEGREES OR LESS.
- 10. EXTEND ALL VENT PIPES AT LEAST 6" ABOVE FINISHED ROOF SURFACES AND HIGHER WHEREVER REQUIRED BY LOCAL PLUMBING

C. WATER PIPING.

- 1. RUN LEVEL WITHOUT POCKETS AND AS STRAIGHT AS POSSIBLE.
- 2. INSTALL HOT AND COLD WATER LINES AT LEAST 12" APART.

3. INSTALL ALL WATER LINES FROM ALL PART OF THE BUILDING

- STRUCTURE AND HANGERS WITH 1/2" THICK WAFFLE PATTERN. HAIR FELT STRIPS OF A 2" MINIMUM WIDTH COMPLETELY SURROUNDING THE PIPES. USE PIPE ISOLATORS TO ISOLATE ALL PIPE HANGERS AND SUPPORTS.
- 4.. INSTALL WATER HAMMER ARRESTORS IN AN UPRIGHT POSITION ON HOT AND COLD WATER PIPING HEADERS, AT EACH QUICK CLOSING VALVES AND WHERE INDICATED ON THE DRAWINGS.
- 5. INSTALL VACUUM BREAKER ON WATER LINES WHERE REQUIRED BY CODE EVEN IF NOT SPECIFICATION OR INDICATED ON THE DRAWINGS.
- 6. ARRANGE THERMOMETERS FOR EASY READING FORM THE FLOOR AND

INSTALL ALL PRESSURE GAUGES WITH SHUT-OFF COCKS.

15. JOINTS

- SCREWED STEEL PIPE: CUT THREADS WITH NEW CLEAN DIES. CAREFULLY - REAM AND INSPECT EACH PIECE OF PIPE BEFORE ERECTION. APPLY PIPE DOPE TO MALE THREADS ONLY. EXPOSED NO MORE THAN TWO THREADS.
- COPPER TUBING: CUT PIPE SQUARE, USING PROPER TOOLS AND REMOVE ALL BURRS. THOROUGHLY CLEAN AND OF PIPE EQUAL TO DEPTH OF FITTING, USING SAND CLOTH, SANDPAPER OR STEEL WOOL FOR CLEANING PURPOSES. APPLY A COAT OF NO. 50 STREAMLINE PASTE TO PIPE AND FITTINGS. LIQUID FLUX WILL NOT TO BE PERMITTED. USE 95-5 SOLDER INSTALL ALL PIPING IN ACCORDANCE WITH MANUFACTURER'S INSTRUCTION.
- C. COPPER OR BRASS PIPE: CUT THREADS WITH NEW CLEAN DIES, FULL THICKNESSES OF DIES. MAKE JOINTS WITH FRICTION CLAMPS AND FRICTION WRENCHES. THOROUGHLY REAM EACH PIECE OF PIPE. APPLY TAPE TO MALE THREADS.

16. UNIONS

INSTALL UNIONS ON CONNECTION TO ALL EQUIPMENT ON THE DOWNSTREAM SIDE OF ALL THREADED OR SOLDERED VALVES AND ELSEWHERE AS INDICATED ON THE DRAWINGS.

17. VALVES

A. INSTALL SHUTT-OFF VALVES IN ALL MAIN SERVICES, AT FIXTURES. AND WHERE REQUIRED TO PROVIDE COMPLETE ISOLATION OF ALL EQUIPMENT, DEVICES, ETC. FOR THEIR PROPER SERVICING. ARRANGE VALVES TO GIVE COMPLETE AND REGULATING CONTROL OF PIPING SYSTEMS THROUGHOUT THE BUILDING. INSTALL ALL VALVES WITH BEST OF WORKMANSHIP. WITH NEAT APPEARANCE AND GROUPING, SO THAT ARE EASILY ACCESSIBLE FOR MAINTENANCE..

18. PIPE SUPPORTS

- A. SUPPORT SUSPEND PIPING WITH CLEVIS OR TRAPEZE HANGERS AND RODS. IN CONCRETE SLABS SUPPORT PIPING FROM INSERTS OR ANCHORS. WHERE STEEL FRAMING IS USED, ATTACH SUPPORTS WITH SUITABLE CLAMPS AND TO WOOD FRAMING USE SUITABLE BOLTS OR LAG SCREWS.
- B. SUPPORT EACH ITEM INDEPENDENTLY FORM OTHER PIPES. DO NOT USE WIRE FOR HANGING OR STRAPPING PIPES.
- C. SPACE HANGERS AND SUPPORT FOR HORIZONTAL STEEL PIPES ACCORDING TO THE FOLLOWING SCHEDULE:
- D. ALL PIPING WHICH IS NOT ISOLATED FROM CONTACT WITH THE BUILDING BY ITS INSULATING SHALL BE INSTALLED WITH A MANUFACTURED TYPE ISOLATOR. HORIZONTAL PIPING IN STUD WALL MAY BE ISOLATED WITH HAIR FELT PADS SECURELY WIRED IN PLACE.
- . ISOLATOR SHALL BE SEMCO TRISOLATORS. SERIES NO. 100 I.PS PIPING AND SERIES NO. 500 FOR COPPER TUBING AS MANUFACTURED BY STONEMAN ENGINEERING AND MFG. CO.

PIPE SIZE: MAXIMUM SPACING ON CENTER 1-1/4" AND SMALLER: 1-1/4" AND LARGER:

F. SPACE HANGERS AND SUPPORTS FOR HORIZONTAL COPPER TUBING ACCORDING TO THE FOLLOWING SCHEDULE: TUBE SIZE; MAXIMUM SPACING ON CENTERS:

> 1-1/2" AND SMALLER: 2" AND LARGER:

OTHER LOCATIONS: VALVES, FITTINGS AND CHANGE IN DIRECTION.

G. PROVIDE SWAY BRACING ON HANGERS LONGER THAN 18". H. ARRANGE PIPE SUPPORTS TO PREVENT EXCESSIVE DEFLECTION,

AND TO AVOID EXCESSIVE BENDING STRESS.

- I. SUPPORT VERTICAL PIPING WITH RISER CLAMPS SECURED TO THE PIPING AND RESTING ON THE BUILDING STRUCTURE. PROVIDE AT EACH FLOOR UNLESS OTHERWISE NOTED.
- K. HUBLESS PIPING: PROVIDE HANGERS ON THE PIPING AT EACH SIDE OF, AND WITHIN 6" OF, HUBLESS PIPE COUPLING SO THE COUPLING WILL BEAR NO WEIGHT. MAINTAIN ALIGNMENT AND PREVENT SAGGING OF PIPE, AND MAKE ADEQUATE PROVISION TO PREVENT SHEARING AND TWISTING OF THE PIPE AND THE JOINT. DO NOT PROVIDE HANGERS ON COUPLING.

HORIZONTAL SPACING: 5'-0"

- OTHER LOCATIONS: FITTINGS AND CHANGE IN DIRECTION.
- L. SUPPORT PIPING ON ROOF ON 2"x4" REDWOOD BLOCKS 12" LONG AT MAXIMUM OF 8'-0" O.C. ANCHOR PIPING TO BLOCKS.
- M. HANGERS RODS SHALL CONFORM TO THE FOLLOWING TABLE: PIPE SIZE 2" AND SMALLER: 3/8" INCH ROD PIPE SIZE 2-1/2" AND 3": 1/2" INCH ROD

19. INSULATION

INSULATE ALL DOMESTIC HOT WATER SUPPLY PIPING. DO NOT COVER UNIONS THICKNESS SHALL BE IN ACCORDANCE WITH TABLE ON P-1 (ENERGY NOTES). MATERIAL TO BE SAME AS SPECIFIED BELOW IN

PIPE SIZE 4" AND 5": 5/8 INCH ROD

- B. INSULATE ALL NEW AND EXISTING DOMESTIC COLD WATER PIPING. (EITHER) EXPOSED OR CONCEALED) WITH 1/2" THICK ARMSTRONG 2000 OR ELASTOMERIC OR IMCOA POLYOLFIN FOAM PIPE INSULATION. ALL JOINTS SHALL BE SEALED WITH IMCOA ADHESIVE. ALL FITTINGS TO BE INSULATED WITH MITER CUT PIECES. THE WITH THE PROPERTY OF THE PROPERT PIPES RUN IN EXTERIOR WALL CHASES ARE TO BE COVERED WITH /4" INSULATION.
- FÍBERGLASS INSULATION IS NOT ALLOWED. C. PROVIDE INSULATION CONTINUOS THROUGH HANGERS AND ROLLERS.
- D. INSULATE THE TAIL PIECE, "P" TRAP, TRAP ARM AND HOT WATER SUPPLY PIPING AT EACH FIXTURE FOR HANDICAPPED USE. HANDI LAV-GUARD INSULATION KITS. MANUFACTURED BY TRUEBRO INC.

20. PIPE WRAPPING

SPIRALLY WRAP ALL UNDERGROUND STEEL AND COPPER PIPING WITH PLASTIC TAPE ONE HALF LAPPED TO GIVE DOUBLE THICKNESS. WRAPALL FIELD JOINTS AFTER PRESSURE TEST. WHERE SOIL IS CORROSIVE ATTACH ANODES TO ALL UNDERGROUND STEEL PIPING WITH ISOLATION UNIONS IN ACCORDANCE WITH RECOMMENDATIONS OF A CORROSION ENGINEERS.

21. SLEEVES AND ESCUTCHEONS

- A. PROVIDE SLEEVES FOR EACH PIPE PASSING THROUGH WALLS, PARTITIONS, FLOORS, ROOFS, AND CEILINGS. FOR CONCRETE CONSTRUCTION SET PIPE SLEEVES IN PLACE BEFORE CONCRETE
- B. FOR UN INSULATED PIPE, PROVIDE SLEEVES TWO PIPE SIZES LARGER THAN THE PIPE PASSING THROUGH. OR PROVIDE A MINIMUM OF 1/2" CLEARANCE BETWEEN INSIDE AND OUTSIDE OF THE PIPE.
- C. FOR INSULATED PIPE, PROVIDE SLEEVES OF ADEQUATE SIZE TO ACCOMMODATE THE FULL THICKNESS OF PIPE COVERING, WITH CLEARANCE FOR PACKING AND CALKING.
- D. CALK THE SPACE BETWEEN SLEEVES AND PIPE COVERING, USING A NON COMBUSTIBLE, PERMANENTLY PLASTIC, WATERPROOF, NON-STAINING COMPOUND WHICH LEAVES A SMOOTH FINISHED APPEARANCE, OR PACK WITH NON COMBUSTIBLE ASBESTOS COTTON ROPE TO WITHIN 1/2" OF BOTH WALL FACES, AND PROVIDE THE WATERPROOF COMPOUND DESCRIBED ABOVE.
- E. FINISHED AND ESCUTCHEONS:
- 1. SMOOTH UP ROUGH EDGES AROUND SLEEVES WITH PLASTER OR SPACKLING COMPOUND.
- 2. PROVIDE 1" WIDE CHROME OR NICKEL PLATED ESCUTCHEONS HELD IN PLACE WITH SET SCREW FOR ALL PIPES EXPOSED TO VIEW IN FINISHED SPACES.

22. CLEANOUTS

- A. PROVIDE CLEAN OUTS OF SAME NOMINAL SIZE AS THE PIPES THEY SERVE, EXCEPT WHERE CLEAN OUTS ARE REQUIRED IN PIPES 4" AND LARGER PROVIDE 4" CLEANOUTS.
- B. MAKE CLEAN OUTS ACCESSIBLE. AFTER PRESSURE TESTS ARE MADE AND APPROVED. THOROUGHLY GRAPHITE THE CLEAN OUT THREADS.

23. TAGGING AND IDENTIFICATION

LABEL ALL VALVES WITH SECURELY ATTACHED METAL TAGS SHOWING THE SERVICE AND VALVE NUMBER. STAMP TAGS WITH BLACK FILLED NUMBERS AND LETTERS. PRIOR TO FINAL INSPECTION, SUBMIT TO ARCHITECT TWO COPIES OF CHART. SHOWING VALVE NUMBER, SERVICE, VALVE LOCATION AND AREA CONTROLLED.

24. TESTING

A. TEST ALL WORK UNDER THE SUPERVISION OF THE REPRESENTATIVE OF THE ARCHITECT AND/OR OWNER AND INSPECTED BY ALL AUTHORITIES HAVING JURISDICTION OVER THIS WORK. DELIVER FOUR (4) SETS OF ALL TEST AND REPORTS TO THE ARCHITECT.

B. PRESSURE TESTS:

TEST THE VARIOUS PARTS OF THE SYSTEMS BEFORE PIPING IS CONCEALED AS REQUIRED BY GOVERNING AUTHORITIES AND PAY ALL COSTS FOR SAME.

OF 10 FEET HEAD OF WATER THREE (3) HOURS.

1. ENTIRE SOIL, WASTE AND VENT PIPING SHALL BE TESTED WITH MINIMUM

- 2. ALL DOMESTIC WATER PIPING SHALL BE TESTED UNDER A HYDROSTATIC PRESSURE OF 150 PSI FOR THREE (3) HOURS.
- C. OPERATING TESTS:
- 1. BEFORE FINAL ACCEPTANCE, PERFORM OPERATING TEST FOR A DURATION OF EIGHT HOURS. FURNISH ALL LABOR AND INSTRUMENTS
- D. SHOULD THE CONTRACTOR REFUSE OR NEGLECT TO MAKE ANY TEST NECESSARY TO SATISFY THE OWNER, OR HIS REPRESENTATIVE, THAT HE HAS CARRIED OUT THE TRUE INTENT AND MEANING OF THE SPECIFICATIONS. THE OWNER MAY MAKE SUCH TEST AND CHARGE THE EXPENSE THERE OF TO THE CONTRACTOR.

25. CLEANING

- A. THOROUGHLY CLEAN ALL EQUIPMENT AND PIPING TO REMOVE DUST, SCALE, PLASTER, OR ANY INTERNAL OBSTRUCTIONS BEFORE ANY COVERING IS INSTALLED OR ANY PIPING, OR EQUIPMENT IS PAINTED AND/OR PLACED IN OPERATION. CLEAN EXPOSED PARTS OF EQUIPMENT, REMOVE OIL AND GREASE, AND LEAVE THE BRIGHT METAL PARTS CLEAN AND POLISHED. RESTORE FINISHED SURFACES IF DAMAGED, AND DELIVER ENTIRE INSTALLATION IN APPROVED CONDITION.
- B. DURING THE PROGRESS OF THE WORK, CAREFULLY CLEAN UP AFTER YOUR MEN. AND LEAVE THE PREMISES AND ALL PORTIONS OF THE BUILDING IN WHICH YOU ARE WORKING, FREE FROM DEBRIS. UPON COMPLETION OF THE WORK, REMOVE ALL RUBBISH, DEBRIS AND SURPLUS MATERIALS RESULTING THEREFROM FROM THE PREMISES, AND LEAVE THE SITE IN AND, CLEAN AND ACCEPTABLE CONDITION AS APPROVED BY THE ARCHITECT.
- C. BEFORE BEING PLACED IN OPERATION, FLUSH CLEAN INSIDE OF PIPES, ECT. CLEAN ALL STRAINERS AFTER OPERATIONAL TEST. CLEAN PLUMBIN FIXTURES OF PROTECTIVE MATERIALS AND CLEAN AND POLISHED ENTIRE ASSEMBLIES. CLEAN FLOOR DRAIN GRATES AND CHECK EACH FIXTURE TO INSURE AGAINST TRAP STOPPAGE.

26. WATER SYSTEM STERILIZATION BEFORE THE USE OF ANY PORTION OF WATER SYSTEM AND BEFORE FINAL ACCEPTANCE OF THE SYSTEM, THE PURITY OF THE SYSTEM MUST MEET THE REQUIREMENTS OF THE STATE BOARD OF HEALTH. SUBMIT A CERTIFICATE FROM AN APPROVED TESTING LABORATORY THAT THE WATER SYSTEM MEETS ALL THE PURITY REQUIREMENTS OF THE STATE BOARD OF HEALTH. OBTAIN WRITTEN APPROVAL FROM WATER TESTING LABORATORY AND SUBMIT TO GENERAL CONTRACTOR FOR APPROVAL.

27. GROUTING

GROUT BEHIND ALL WALL-HUNG PLUMBING FIXTURES WITH HARD, WHITE DURABLE PLASTER MATERIALS, ELIMINATING ALL VOIDS AND CRACKS AND PROVIDING SUFFICIENT PLANE-BEARING

UPON COMPLETION OF THE WORK OF THIS SECTION AND BEFORE

FINAL ACCEPTANCE, DELIVER TO THE ARCHITECT TWO COPIES OF

SURFACES FOR MOUNTING. 28. ADJUSTING

UPON COMPLETION OF AND AFTER CLEANING OF SYSTEM AND EQUIPMENT, CAREFULLY ADJUST FOR NORMAL OPERATION THE AUTOMATIC PARTS OF PLUMBING SYSTEMS.

29. OPERATION AND MAINTENANCE INSTRUCTIONS

AN OPERATION AND MAINTENANCE MANUAL.



RE Z \mathbf{Z} C 5

 \mathbf{m}

JS ENGINEERING, INC 410 S. SAN GABRIEL BLVD., SUITE 8, SAN GABRIEL, CA 91776 PHONE: 626.497.0558 EMAIL: INFO@CAL-PACIFIC.NET

ENGINEER:

C:\Users\charl\OneDrive\2021 Project\DesignUA\Burger King\BK001 Desert Hot Springs\CD\r1\P20 PLDG Spec & SCH.dwg, 5/21/2021 5:00:20 PM, charl, AutoCAD PDF (General Documentation).pc3, CAL Arc1

PLUMBING FIXTURE SCHEDULE (COMMERCIAL) PIPE CONNECTION FIXTURE TYPE SYMBOL DESCRIPTION WASTE TRAP VENT CW HW A/S FLOOR MOUNTED, FLUSH VALVE, MAX 1.28 WATER CLOSET 1-1/4" GPF, ELONGATED, ADA COMPLIANT, OPEN FRONT (DISABLED) SEAT W/ LESS COVER, WHITE VITREOUS CHINA A/S COUNTERTOP MOUNTED, WHITE VITREOUS CHINA, LAVATORY 2" | 1-1/2" | 1-1/2" | 3/4" SELF-CLOSING FAUCETS, MAX. 0.25 GPM, WITH (DISABLED) MIXING VALVE SET @ 110°F MAX. ADA COMPLIANT HAND SINK SEE KITCHEN DWGS FOR EQUIPMENT & 1/2" 2" | 1-1/2" | 1-1/2" | FAUCET MODEL (WALL MOUNTED) HAND SINK SEE KITCHEN DWGS FOR EQUIPMENT & 2" | 1-1/2" | 1-1/2" | 1/2" (COUNTERTOP MOUNTED) FAUCET MODEL SEE KITCHEN DWGS FOR EQUIPMENT & 3/4" FAUCET MODEL. PROVIDE NON-REMOVABLE MOP SINK VACUUM BREAKER POT SINK SEE KITCHEN DWGS FOR EQUIPMENT & 3/4" FAUCET MODEL (3 COMP. SINK) PREP. SINK SEE KITCHEN DWGS FOR EQUIPMENT & 3/4" (1 COMP. SINK) FAUCET MODEL "JR. SMITH" 2005 TRAPPED WITH 2" | 1-1/2" | 1-1/2" FLOOR DRAIN TRAP PRIMER "JR. SMITH" 2005 TRAPPED WITH 3" | 1-1/2" FLOOR DRAIN HALF GRATE, 906-2-C-G 12"X12"X6" 2" | 1-1/2" | 1-1/2" FLOOR SINK W/ DOME STRAINER "ZURN" OR EQUAL HALF GRATE, 910-2-C-G 12"X12"X6" FLOOR SINK |W/ DOME STRAINER "ZURN" OR EQUAL THERMOSTATIC MIXING VALVE 3/4" "NAVIGATOR" MODEL S59-4016, UNDER SINK WATER FILTER PROVIDE BY OWNER INSTALL BY G.C. BACK-FLOW PREVENTER "WATTS" MODEL SD-3, ASSE 1022 APPROVED DUAL (CARBONATED BEVERAGE CHECK WITH ATMOSPHERIC VENT MACHINES) BOOSTER PUMP PROVIDE BY OWNER INSTALL BY G.C. PRECISION PLUMBING PRODUCTS PRIME-TIME TRAP PRIMER ELECTRONIC TRAP PRIMING ASSEMBLY PTS. EXPANSION TANK AMTROL THERM-X-TROL NO. ST-12 DOMESTIC HOT WATER CIRCULATING PUMP "GRUNDFOS" MODEL UP 15-18 1/25 HP 120V 1PH, W/ CIRCULATING PUMP PROGRAMMABLE TIMER AND SENSORS. FREEZE-PROOF HOSE BIBB, WITH VACUUM BREAKER HOUSE BIBB BACKFLOW PREVENTOR IN A RECESSED BOX WITH LOCK. WOODFORD MB65 OR APPROVED EQ. JR SMITH, MODEL 5005 WATER HAMMER ARRESTOR DUAL TANK-LESS WATER HEATER SYSTEM. MODEL NCC-199CDV, WITH QUICK CONNECT CORD. INSTALLATION CONTACT NORITZ AMERICA DUAL TANK-LESS WATER HEATER JENSEN PRECAST 1,500 GAL GREASE INTERCEPTOR GREASE INTERCEPTOR APPROVED TRAFFIC RATED UP TO 6FT COVER.

NOTE:

- PROVIDED & INSTALLED BY PLUMBING CONTRACTOR. ALL EQUIPMENT SHALL BE APPROVED BY THE ARCHITECT AND OWNER OTHERWISE NOTED.
- 2. ALL PLUMBING FIXTURES SHALL BE LISTED AND LABELED.

GREASE INTERCEPTOR CALCULATION						
FIXTURE	QUANTITY	SEWER FU EACH	SEWER FU TOTAL			
MOP SINK	1	3	3			
POT SINK	2	3	6			
FLOOR SINK	5	3	15			
FLOOR DRAIN	5	2	10			
			#			
TOTAL			34			

MIN. 1,000 GAL. CAPACITY REQUIRED FOR BURGER KING PROVIDE 1,500 GAL. GREASE INTERCEPTOR PER 2019 CPC SEC. 1014.3.6

PLUMBING GENERAL NOTES

- 1. THE PLUMBING SYSTEM SHALL COMPLY WITH THE 2016 CALIFORNIA PLUMBING CODE.
- 2. DRAWING AND SPECIFICATIONS GOVERN WHERE THEY EXCEED CODE REQUIREMENTS.
- 3. CONTRACTOR SHALL VERIFY LOCATION AND DEPTH OF UTILITIES AT POINT OF CONNECTION BEFORE START OF WORK.
- 4. REFER TO ARCHITECTURAL DRAWINGS FOR EXACT LOCATION OF PLUMBING FIXTURES.
- 5. ALL UNDERGROUND SHUT OFF VALVES OUTSIDE OF BUILDING SHALL BE IN CONCRETE BOXES WITH THE NAME OF THE SERVICE CASTED IN THE COVER.
- 6. ALL PLUMBING FIXTURES AND EQUIPMENT SHALL HAVE ISOLATING VALVES ON WATER SUPPLY LINES. VALVE SHALL BE LINE SIZE, UNLESS NOTED OTHERWISE.
- 7. ALL PLUGGED TEES AND PLUGGED WYES SHALL BE LINE SIZE, UNLESS NOTED OTHERWISE.
- 8. ALL PIPING PENETRATING WALL, CEILING, AND FLOOR SHALL BE ISOLATED FROM BUILDING STRUCTURES WITH RESILIENT SEALS.
- 9. RUN ALL INDOOR PLUMBING PIPING CONCEALED IN WALL OR ABOVE CEILING, UNLESS NOTED OTHERWISE.
- 10. PROVIDE DIELECTRIC UNIONS AT BIMETALLIC PIPE JOINTS.
- 11. PROVIDE CHROME PLATED CAPS FOR WALL CLEANOUTS.
- 12. WASTE LINE SHALL BE SLOPED NOT LESS THAN 1/4" PER FT. IN THE DIRECTION OF FLOW.
- 13. ALL VALVES AND COCKS SHALL BE LOCATED TO BE READILY ACCESSIBLE. WHERE VALVES ARE INSTALLED WITHIN OR BEHIND WALLS OR CEILING, ACCESS PANEL SHALL BE INSTALLED.
- 14. WATER SUPPLY AND DRAIN PIPES UNDER ACCESSIBLE LAVATORIES AND SINKS SHALL BE INSULATED OR OTHERWISE BE CONFIGURED TO PROTECT AGAINST CONTACT. PROTECTORS, INSULATORS, OR BOTH SHALL COMPLY WITH ASME A112.18.9.
- 15. EACH VENT SHALL TERMINATE NOT LESS THAN 10 FT. FROM, OR AT LEAST 3 FT. ABOVE ANY WINDOW, DOOR, OPENING AIR INTAKE OR VENT SHAFT, NOR LESS THAN 3 FT. IN EVERY DIRECTION FROM ANY LOT LINE; ALLEY AND STREET EXCEPTED.
- 16. ALL REQUIRED CLEANOUTS SHALL BE INSTALLED AS PER SEC. 707.0 & 719.0 OF THE PLUMBING CODE.
- 17. EACH VENT SHALL RISE VERTICALLY TO A POINT NOT LESS THAN SIX (6) INCHES IN HEIGHT ABOVE THE FLOOD LEVEL RIM OF THE FIXTURE BEFORE BEING CONNECTED TO ANY OTHER VENT.
- 18. NEW OR REPAIRED POTABLE WATER SYSTEMS SHALL BE DISINFECTED PRIOR TO USE ACCORDING TO THE METHOD SET IN SECTION 609.9 OF THE PLUMBING CODE.
- 19. PLUMBING FIXTURES SHALL BE CERTIFIED BY CEC. (WATER CLOSET 1.28 GPF, URINAL 0.125 GPF, SHOWER HEAD 2.0 GPM, COMMERCIAL SINK FAUCETS 1.8 GPM, LAVATORY(METERING) 0.2GPM.)
- 20. PROVIDE NON-LEAD SOLDER FOR POTABLE WATER PIPING JOINTS AND CONNECTION.
- 21. MAX. HOT WATER TEMPERATURE TO PUBLIC LAVATORIES TO BE 110°F & MIN. HOT WATER TEMPERATURE TO KITCHEN FIXTURES TO BE 120°F.
- 22. FLOOR DRAIN OR SIMILAR TRAPS DIRECTLY CONNECTED TO THE DRAINAGE SYSTEM AND SUBJECT TO INFREQUENT USE SHALL BE PROVIDED WITH TRAP PRIMING. TRAP PRIMING DEVICES SHALL BE ACCESSIBLE FOR MAINTENANCE.(SECTION 1007 CPC)
- 23. COMBUSTIBLE PIPING INSTALLATIONS SHALL BE INSTALLED PER CHAPTER 14 OF THE CALIFORNIA PLUMBING CODE FOR "FIRESTOP PROTECTION."
- 24. PROPOSED ADDITION, ALTERATION, OR IMPROVEMENT REQUIRES ALL NON-COMPLIANT FIXTURES TO BE REPLACED WITH WATER CONSERVING PLUMBING FIXTURE.
- 25. CONDENSATE DRAIN ARE TRAPPED IN ACCORDANCE WITH THE APPLIANCE MANUFACTURER'S INSTRUCTION.
- 26. PROTECT RECEPTOR ON ROOF OR OUTSIDE OF BUILDING FROM RAIN WATER BY ELEVATING THE
- RIM TWO (2) INCHES ABOVE ADJACENT SURFACE.

 27. PUBLIC LAVATORIES SHALL HAVE A WATER TEMPERING DEVICE THAT COMPLIES WITH ASSE 1070 OR CSA B125.3. WATER HEATER THERMOSTAT SHALL NOT BE CONSIDERED A CONTROL TO MEET
- 28. INSULATION OF DOMESTIC HOT WATER PIPING SHALL BE IN ACCORDANCE WITH SECTION 609.11.1 AND SECTION 609.11.2.

FIXTURE LINIT SUMMARY

TIXTUIL UNIT SUMMANT						
SERVICE	OLD F.U.	NEW F.U.	TOTAL F.U.			
DOMESTIC WATER	0	34	34	_		
SANITARY SEWER	0	49	49			
		· ·				

SERVICE REQUIREMENTS

OLIVIOL INLIGOTIVE MILITO			
SERVICE	SIZE MAIN	CAPACITY	
DOMESTIC WATER	(E) 1-1/2 INCH	44 GP	M
SANITARY SEWER	(E) (2) 6 INCH	49 F.L	J
FUEL GAS	2-1/2 INCH	846 CF	H

(E) WATER PIPE SIZING CHART

` '						`	
PIPE	GPM	VELOCITY			FIXTU	RE UNITS	
SIZE	GFIVI	FT/SEC		F - TANK		F - VALVE	
1/2"	2.0	MAX. 8	1	F.U. @ 5.	0 psi	F.U. @	psi
3/4"	6.0		7	F.U. @	psi	F.U. @	psi
1"	13.0		18	F.U. @	psi	F.U. @	psi
1-1/4"	22.0		34	F.U. @	psi	F.U. @	psi
1-1/2"	35.0	T	66	F.U. @	psi	F.U. @	psi
		*					

(COLD WATER)

(E) WATER PIPE SIZING CHART (COLD WATER)					
PIPE	GPM	VELOCITY	FIXTU	RE UNITS	
SIZE	GFIVI	FT/SEC	F - TANK	F - VALVE	
1/2"	2.0	MAX. 8	1 F.U. @ 5.0 psi	F.U. @ psi	
3/4"	6.0		7 F.U. @ psi	F.U. @ psi	
1"	12.0	▼	16 F.U. @ ▼ psi	F.U. @ psi	

	PLUI	MBING LEGEND
SYMBOL	ABBREV.	DEFINITION
	S OR W	SANITARY SEWER OR WASTE ABOVE GRADE/FLOOR
	S OR W	SANITARY SEWER OR WASTE BELOW GRADE/FLOOR
	V	SANITARY VENT
D	D	INDIRECT DRAIN
	CW	DOMESTIC COLD WATER
	HW	DOMESTIC HOT WATER
—— G —	G	NATURAL GAS
— ф –	COTG	CLEANOUT TO GRADE
—ф	FCO	FLOOR CLEANOUT
i	WCO	WALL CLEANOUT
	WHA	WATER HAMMER ARRESTOR
\longrightarrow	GV	GATE VALVE
— X —	GLV	GLOBE VALVE
	STR	STRAINER
	U	UNION
─ ₹		GAS OR GATE COCK
•	POC	POINT OF CONNECTION
WC - 1		PLUMBING FIXTURE DESIGNATION
WH		PLUMBING EQUIPMENT DESIGNATION
(FD	FLOOR DRAIN
	FS	FLOOR SINK
(E)	EXIST`G	EXISTING
	ABV	ABOVE
	AP	ACCESS PANEL
	CONT.	CONTINUATION
	DN.	DOWN
	FLR.	FLOOR
	GPM	GALLONS PER MINUTE
	PLBG	PLUMBING
	TEMP.	TEMPERATURE
	TYP.	TYPICAL
	VTR	VENT THROUGH ROOF
	W/	WITH
	YB	YARD BOX
	RPPBFP	REDUCE PRESSURE PRINCIPLE BACKFLOW PREVENTER

NON-RESIDENTIAL ENERGY CONSERVATION STANDARDS NOTE:

- 1. PIPING INSULATION SHALL COMPLY WITH CEC BUILDING ENERGY EFFICIENCY
- 2. ALL PLUMBING EQUIPMENT SHALL BE CERTIFIED PER CEC BUILDING EFFICIENCY
- 3. THE "MANDATORY MEASURES" OF THE ENERGY EFFICIENCY STANDARD HAVE BEEN REVIEWED AND THE DESIGN, DRAWINGS AND CALCULATIONS COMPLY WITH THESE

	PIPE MATERIAL SCHEDULE						
SERVICE	UNDERGROUND	ABOVE GROUND					
COLD & HOT WATER	HARD DRAWN COPPER TUBE TYPE "K" OR "L"	HARD DRAWN COPPER TUBE TUBE "L"					
SANITARY WASTE	"NO-HUB" CAST IRON OR ABS *	"NO-HUB" CAST IRON OR ABS *					
SANITARY VENT	"NO-HUB" CAST IRON OR ABS *	GALV. STEEL, SCHEDULE 40/ "NO-HUB" CAST IRON OR ABS *					
INDIRECT DRAIN		HARD DRAWN COPPER TUBE TYPE "M"					
GAS		BLACK STEEL, SCHEDULE 40					


NOTE: * ABS MAY BE USED ONLY WITH OWNER AND LOCAL AUTHORITY APPROVAL.

ENGINEER:

JS ENGINEERING, INC.

MECHANICAL • ELECTRICAL


410 S. SAN GABRIEL BLVD., SUITE 8, SAN GABRIEL, CA 91776
PHONE: 626.497.0558 EMAIL: INFO@CAL-PACIFIC.NET

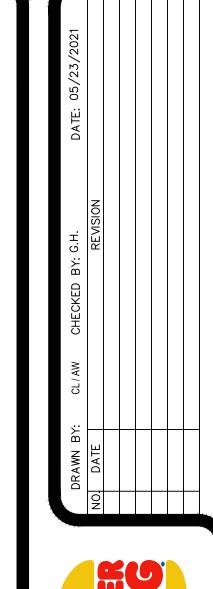

SURGE KING

CLIENT: INSITE REALESTATE, LL BURGER KING CORP./FRANCHIS 1400 16TH ST, SUITE 300 OAK BROOK, IL 60523-8854 PHONE: 630-592-3198

PLANNING AND DESIGN 153 E. City Place Dr. | Santa Ana | CA | 92705

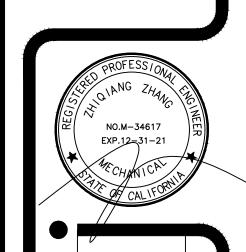



G RESTAURANT

GER KING REST TWO BUNCH PALMS TRAIL
RT HOT SPRINGS, CA 92240

BURGE 66745 TWC

P-2.

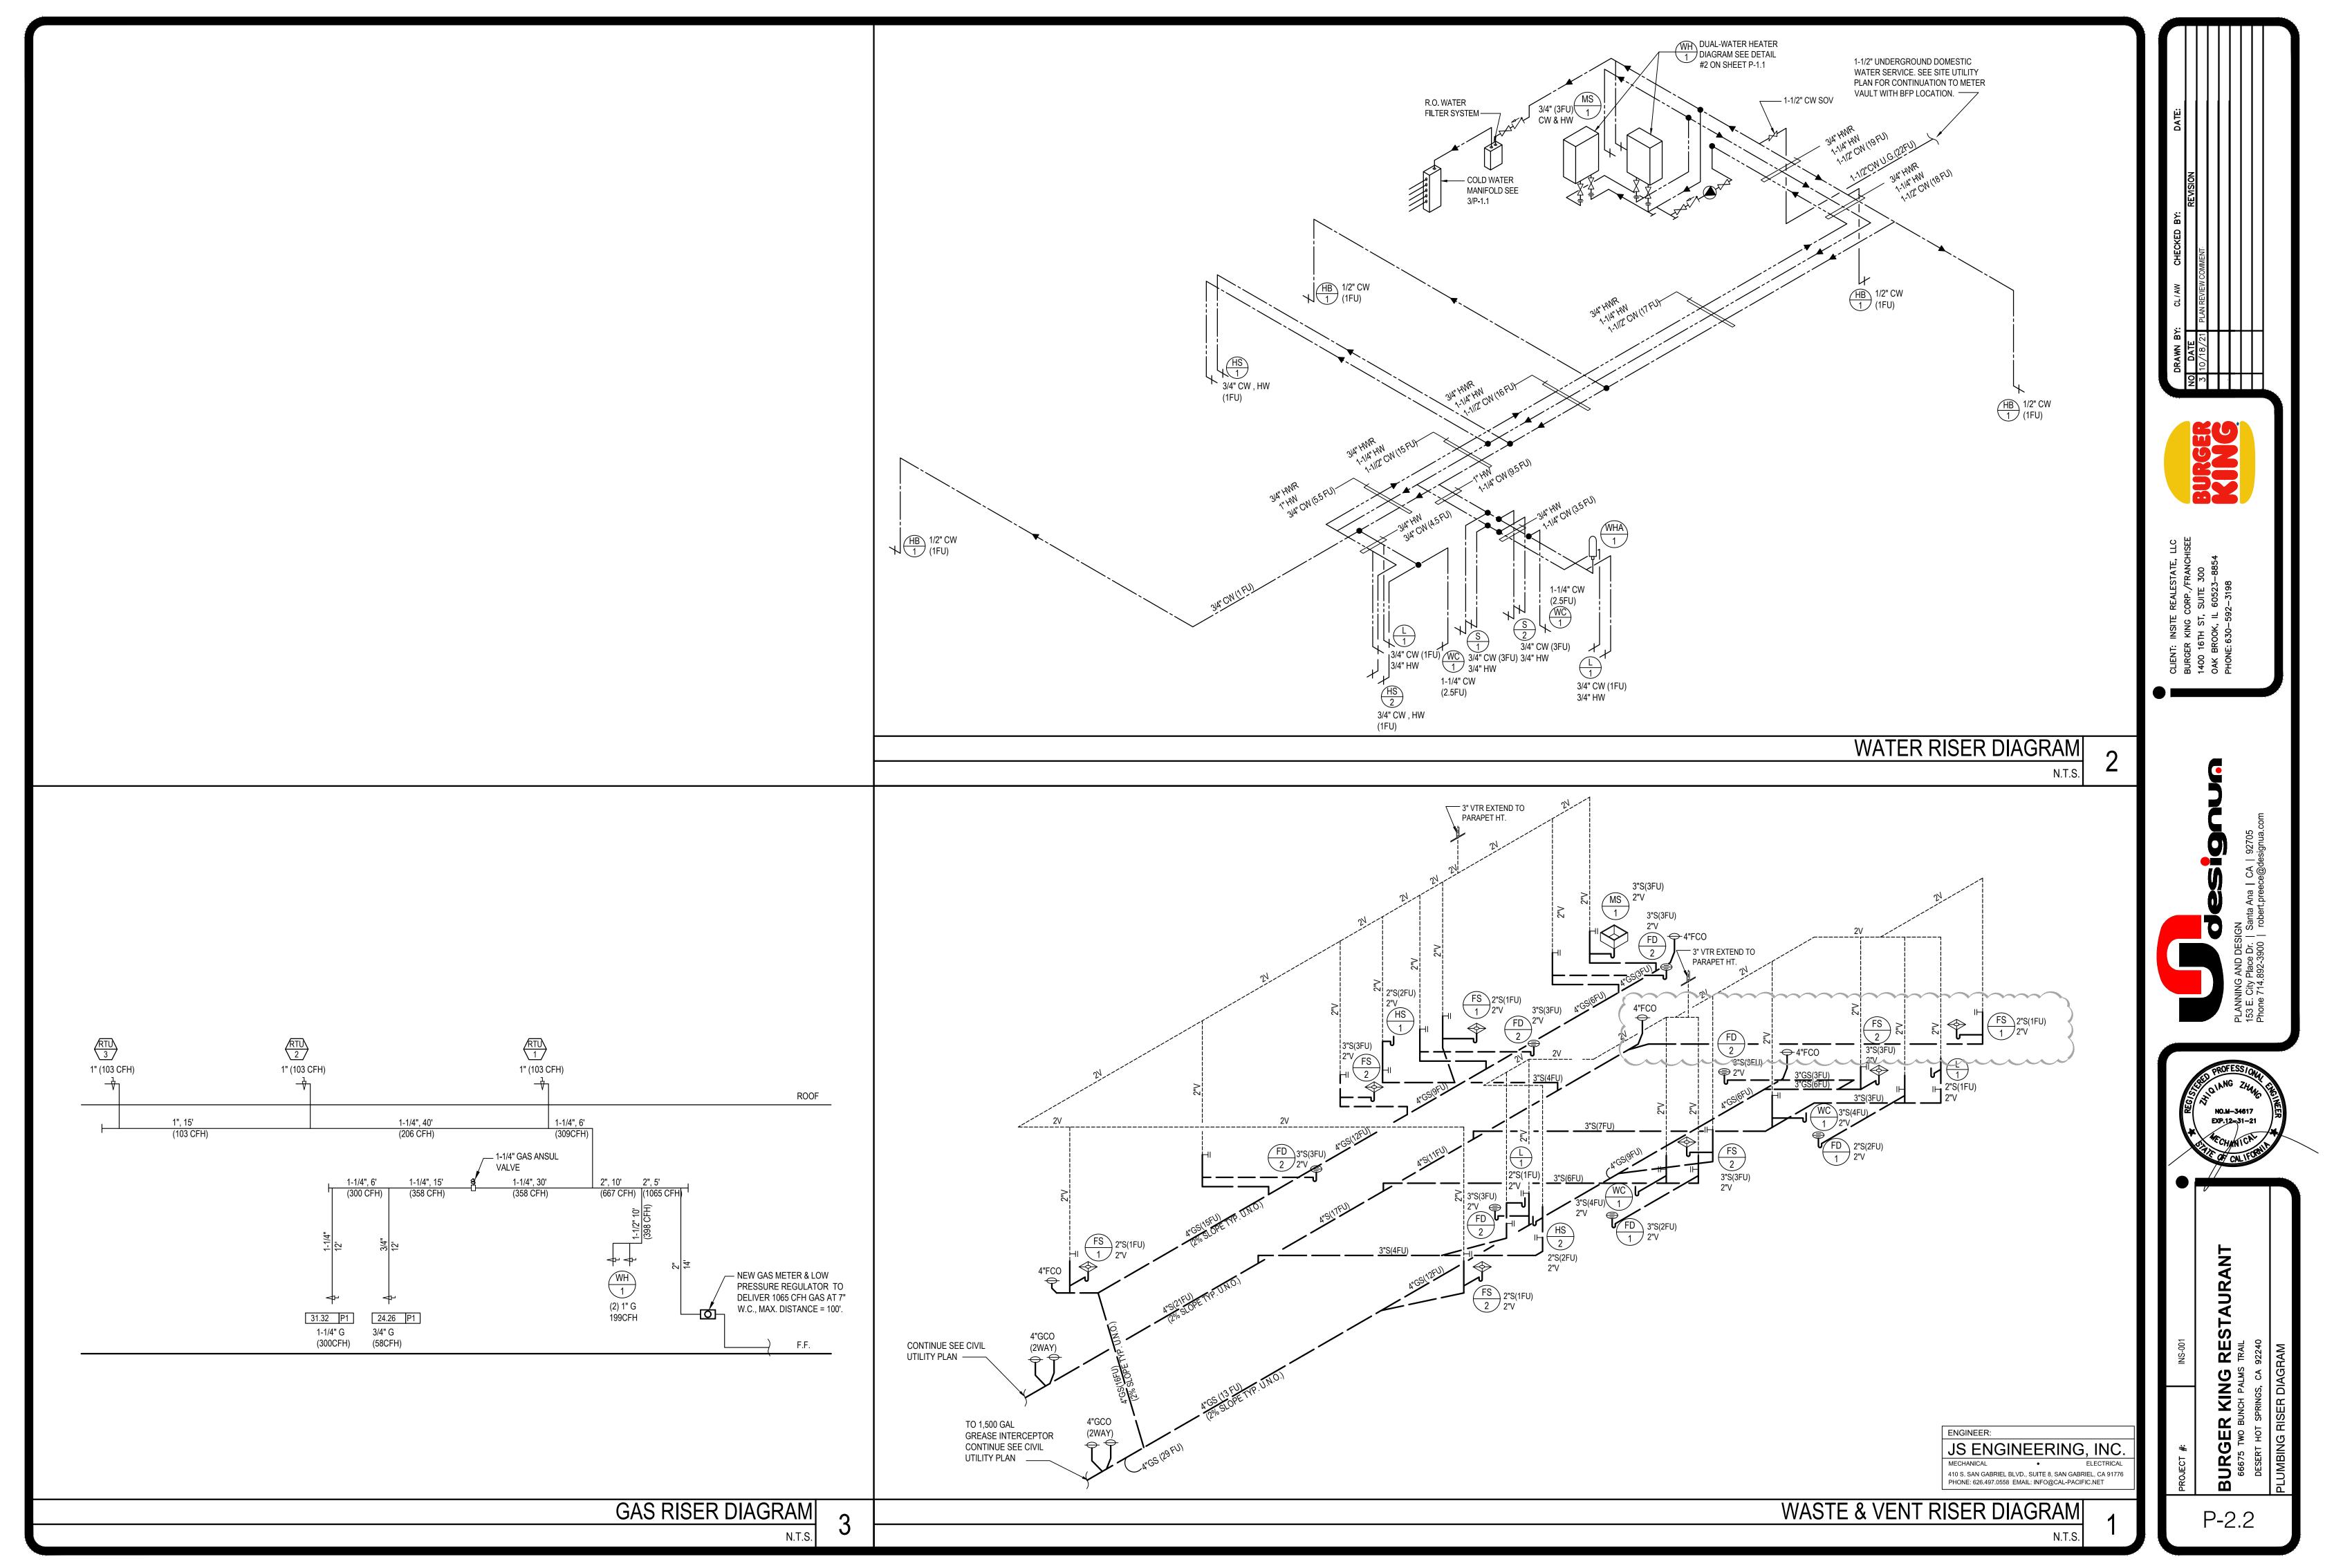

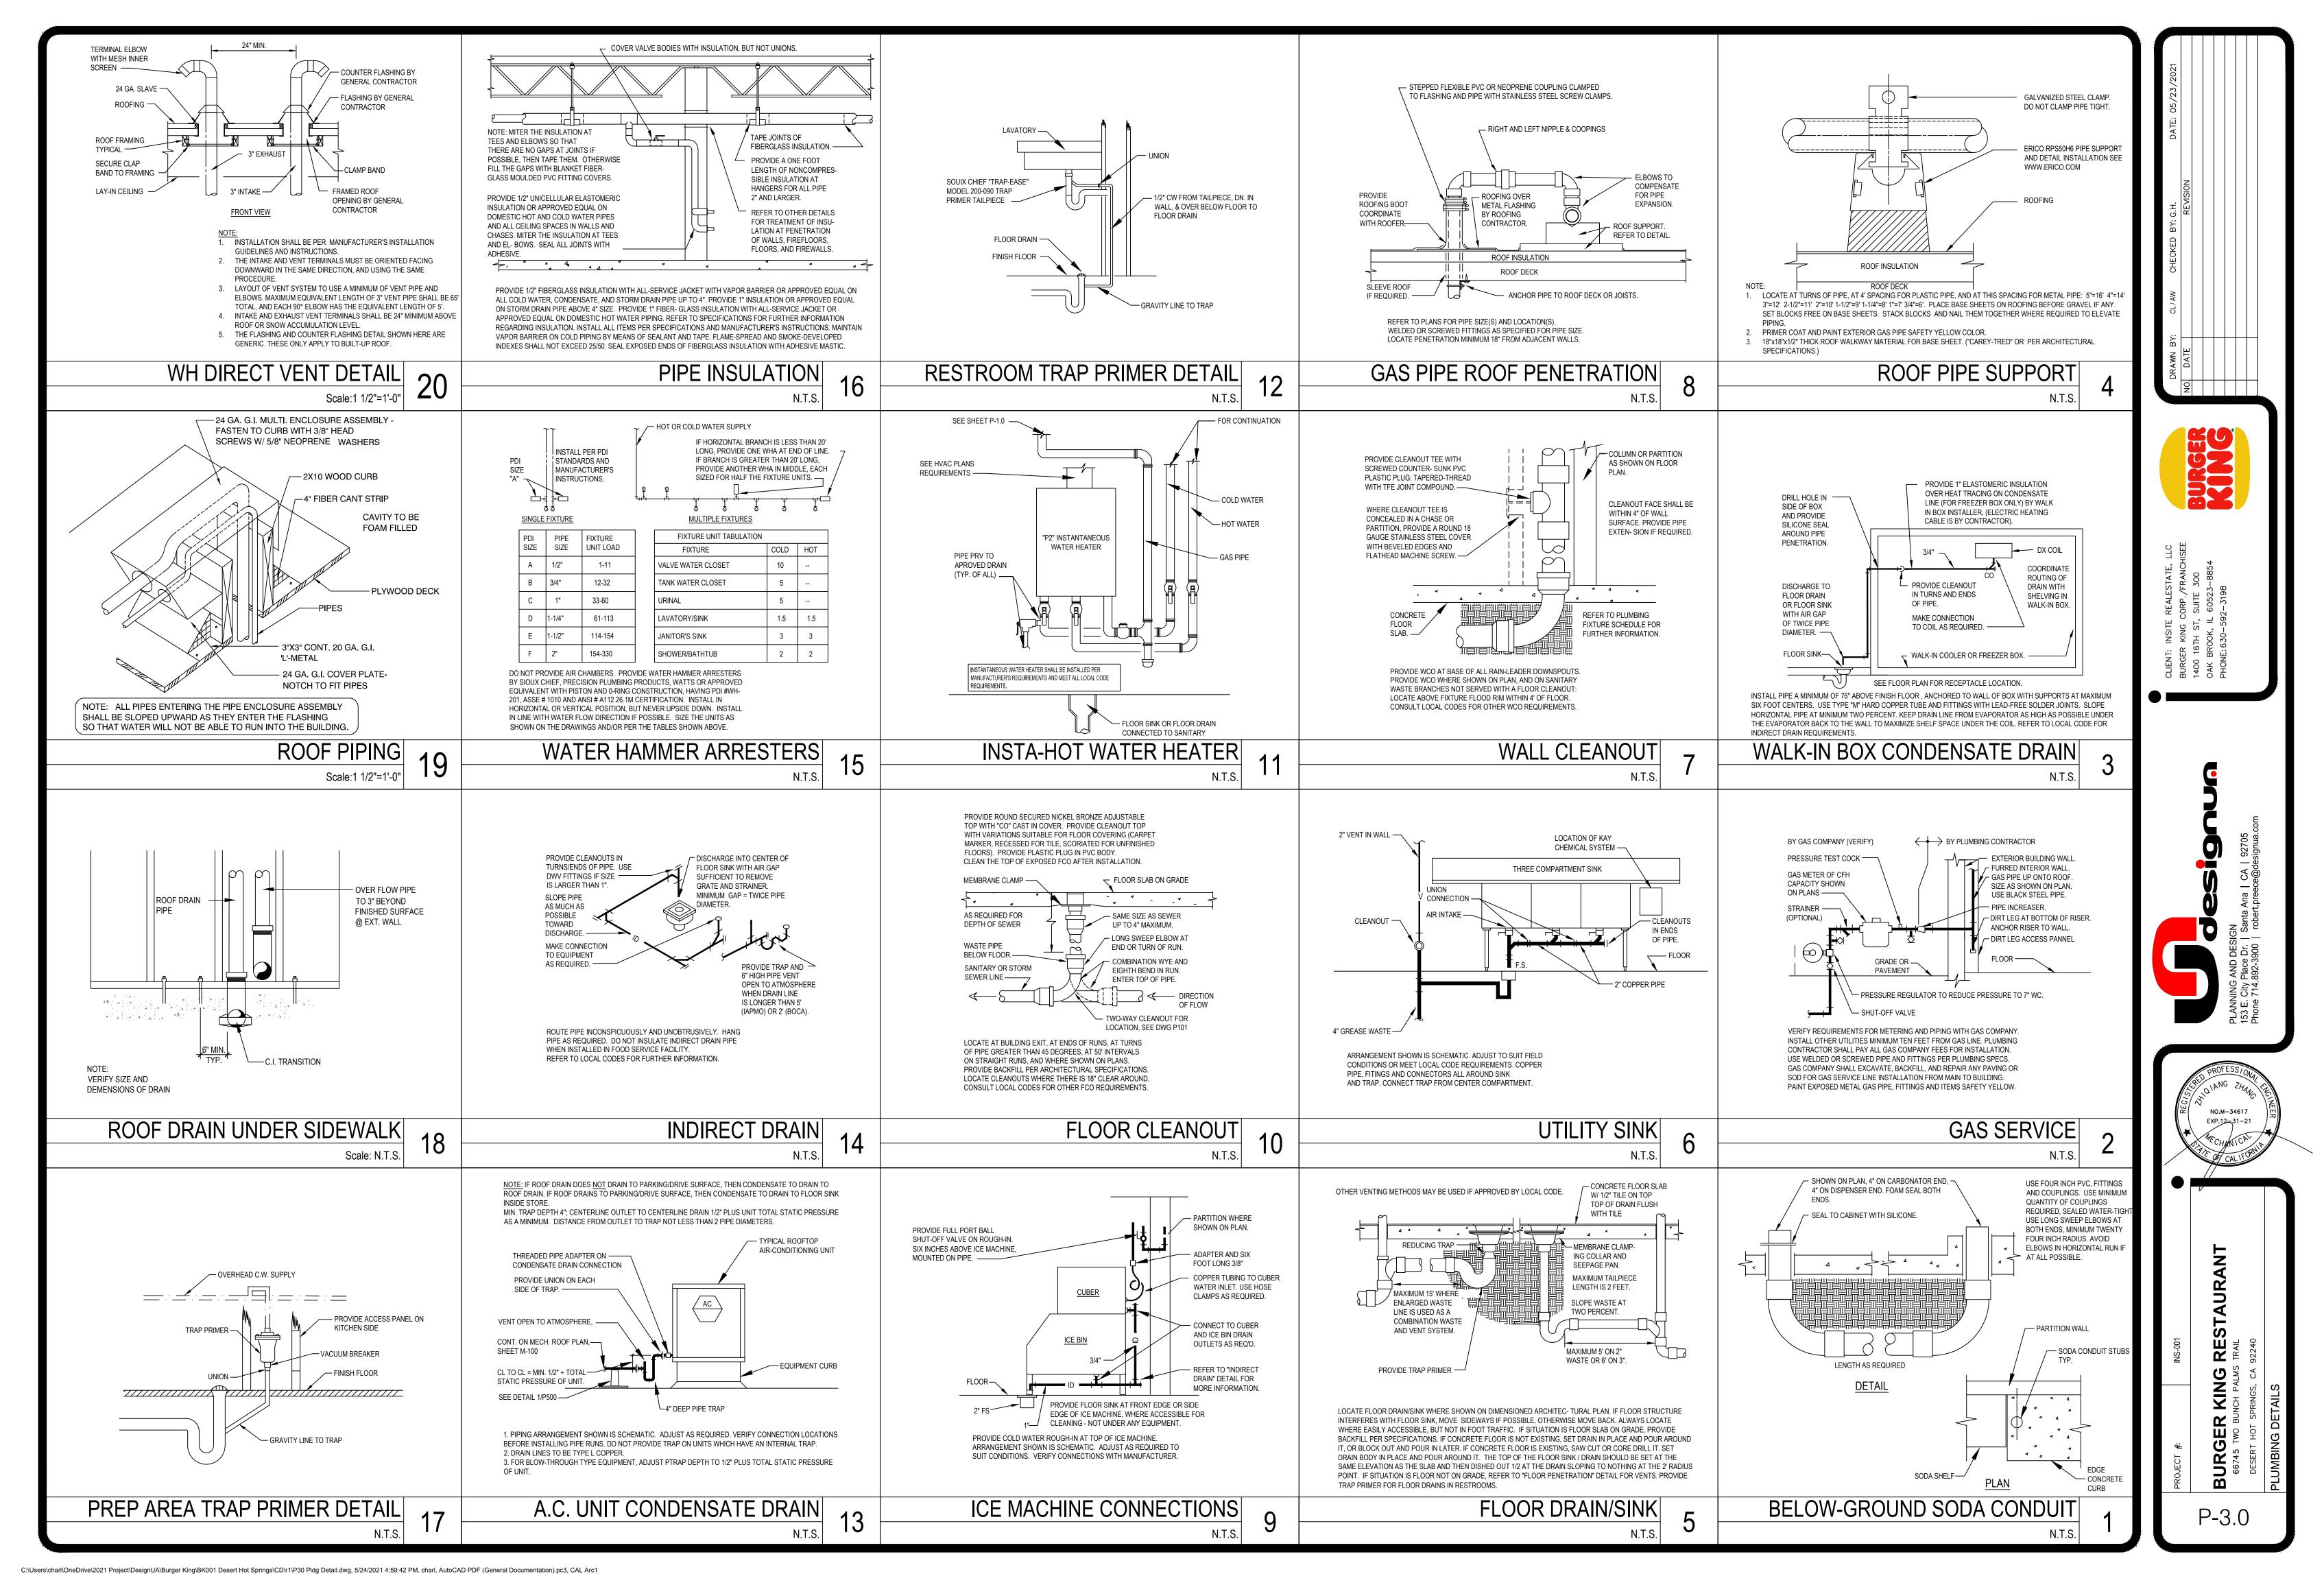

THE WORK SHALL INCLUDE:

- A. PROVISION OF ELECTRICAL AND TELEPHONE SERVICE. B. LIGHTING AND POWER SYSTEM.
- C. LIGHTING FIXTURES, LAMPS, OUTLETS, DEVICES.
- D. WIRING FOR HVAC. AND PLUMBING, INCLUDING CONTROLS AND CONTROL WIRING PER MECH. DRAWING. (SEE NOTES 43 & 44)
- E. TELEPHONE CONDUITS AND OUTLETS. . SHOP DRAWINGS, WIRING DIAGRAMS, EQUIPMENT DATA.
- G. TESTING, CLEANING, ADJUSTING.
- H. METAL SUPPORTS, PLYWOOD BACKINGS. I. PERMITS, INSPECTIONS, FEES.
- J. TEMPORARY POWER AND LIGHT FOR ELECTRICAL WORK.
- K. RECORD "AS BUILT" DRAWINGS. L. PANELBOARDS, TRANSFORMERS, FEEDERS ETC.
- M. EMERGENCY LIGHTING.
- N. GROUNDING, BONDING. O. PULL WIRE IN ALL EMPTY CONDUITS. P. SERVICE & EQUIPMENT GROUNDING SYSTEM..

ELECTRICAL CONTRACTOR SHALL OBTAIN ARCHITECTURAL REFLECT. CEILING PLAN. LIGHT FIXTURES SPECIFICATIONS ON ARCHITECTURAL PLANS SHALL SUPERSEDE ELECTRICAL LIGHTING FIXTURES SCHEDULE SPECIFICATIONS.

CONTRACTOR TO NOTIFY ENGINEER OF ANY DISCREPANCIES PRIOR TO ORDERING

NOTES: FIXTURE LIST

- 1. FIXTURE CATALOG NUMBERS ARE INDICATED FOR GUIDANCE PURPOSES. ALL WRITTEN DESCRIPTION IN SPECIFICATIONS AND ON DRAWING SHALL APPLY.
- 2. ALL ADJUSTABLE FIXTURES SHALL BE AIMED AND ADJUSTED DURING EVENING HOURS TO THE SATISFACTION OF THE ARCHITECT.
- 3. ALL RECESSED FIXTURES SHALL BE COMPATIBLE WITH THE FINISH CEILING SYSTEM.
- 4. RECESSED INCANDESCENT FIXTURES SHALL BE PRE-WIRED TO ATTACHED JUNCTION
- BOX IN ACCORDANCE TO LOCAL CODE REQUIREMENTS. 5. ALL SUSPENDED FIXTURES SHALL BE STEM MOUNTED UNLESS SPECIFICALLY CALLED FOR AS CHAIN MOUNTED. SEE SPECIFICATION FOR REQUIREMENTS.
- FIXTURES INSTALLED IN WET LOCATION SHALL BE MARKED "SUITABLE FOR WET LOCATIONS".
- 7. FIXTURES INSTALLED IN LUMINOUS CEILING SHALL BE APPROVED FOR THAT PURPOSE.
- 8. VERIFY LETTER SIZE AND COLOR OF INTERNALLY ILLUMINATED EXIT SIGN WITH LOCAL CODE AUTHORITY PRIOR TO SUBMITTING SHOP DRAWINGS.

ALL FIXTURES IN CORRIDOR & STORAGE ROOM NOTED WITH N.L. SHALL HAVE INTEGRAL

CHANGES TO EXISTING CONDITIONS

1. CONTRACTOR SHALL VISIT THE SITE AND MAKE HIMSELF THOROUGHLY FAMILIAR WITH THE EXISTING CONDITIONS.

BUILT IN BATTERY (90 MIN. 1400 LUMENS).

- 2. ALL WORK SHALL BE PERFORMED TO CHANGE THE EXISTING ELECTRICAL INSTALLATION AS INDICATED OR AS REQUIRED TO PERFORM THE NEW WORK.
- 3. REMOVE ALL LIGHT FIXTURES, SWITCHES, SPEAKERS, TELEPHONE OUTLETS, RECEPTACLES, MISCELLANEOUS CONDUIT, WIRE, ETC., THAT INTERFERES WITH NEW CONSTRUCTION. EXTEND ANY INTERRUPTED CIRCUITS. PROVIDE BLANK COVER PLATES AS REQUIRED. IN FINISHED AREAS, COVER PLATES SHALL MATCH THE WALL SURFACE.
- 4. NO INFORMATION IS GIVEN ON THE DRAWINGS ABOUT EXISTING INSTALLATIONS VERIFY ALL INFORMATION BEFORE PROCEEDING WITH ANY WORK THAT MAY BE AFFECTED. INCLUDE AS A PART OF THE CONTRACT ALL WORK REQUIRED TO PRODUCE THE INDICATED RESULT.
- 5. EXCEPT AS MAY BE SPECIFICALLY INDICATED OTHERWISE, ALL ELECTRICAL MATERIALS AND EQUIPMENT REMOVED FROM THE EXISTING INSTALLATION IN THE COURSE OF PERFORMING THE INDICATED WORK SHALL BE REUSED AND SHALL BE TREATED AS FOLLOWS:
- A. ALL CONDUITS, CONDUCTORS, OUTLET BOXES AND FITTINGS SHALL BECOME THE PROPERTY OF THE CONTRACTOR AND SHALL BE REMOVED FROM THE SITE
- B. ALL OTHER REMOVED ITEMS SHALL BE TURNED OVER TO THE OWNER AND DISPOSED OF AS DIRECTED BY THE OWNER.
- 6. CLEAN ALL REMOVED ITEMS THAT ARE TO BE REUSED. CONDUITS THAT ARE TO BE REUSED SHALL BE CLEANED BEFORE INSTALLING ANY NEW CONDUCTORS. WHERE A CHOICE IS POSSIBLE, SLECT THE BEST OF THE REMOVED ITEMS FOR REUSE.
- 7. REMOVE EXISTING PANEL AND RELOCATE TO LOCATION SHOWN. EXTEND EXISTING FEEDER TO NEW LOCATION.
- 8. PROVIDE CONDUITS, WIRING, BREAKERS, DISCONNECTS AND CONTROLS TO A/C UNITS(NOT PART OF THIS WORK)
- 9. ON ADDITIONS AND/OR REHABILITATION OF EXISTING CONSTRUCTION, ALL PHASES OF THE NEW WORK SHALL BE SCHEDULED TO KEEP SHUT-DOWN AND CUT-OVER TIMES TO A MINIMUM. ALL SUCH SHUT-DOWNS OF THE ELECTRICAL AND SIGNAL SYSTEMS WHICH WILL INTERRUPT SERVICE TO THE EXISTING FACILITIES SHALL BE PRE-ARRANGED WITH THE OWNER IN ADVANCE. IN EVENT SHUT-DOWN TIMES INTERFERE WITH THE SCHOOL SCHEDULE, THIS WORK SHALL BE PERFORMED DURING THE "OFF" HOURS, AT NO ADDED COST OR INCONVENIENCE TO THE OWNER.
- 10. CONTRACTOR MAY USE EXISTING CONDUITS, OUTLETS, JUNCTION BOXES, ETC. TO ACHIEVE THE DESIGN REQUIREMENTS OF THE ELECTRICAL DRAWINGS. CONTRACTOR SHALL CLEAN AND CHECK ALL ITEMS THAT ARE REUSED FOR CIRCUIT INTEGRITY AND CONTINUITY.

GENERAL NOTES

- I. THE ELECTRICAL CONTRACTOR SHALL VISIT THE SITE OF THE WORK AND THOROUGHLY FAMILIARIZE HIMSELF WITH THE WORKING CONDITIONS AND THE EXACT NATURE AND EXTENT OF THE WORK TO E DONE. TAKING INTO ACCOUNT ANY SPECIAL OR UNUSUAL FEATURES PECULIAR TO THIS JOB.
- 2. CONTRACTOR SHALL OBTAIN AND PAY FOR ALL NECESSARY ELECTRICAL PERMIT(S) PRIOR TO JOB START AND OBTAIN PROPER INSPECTION FROM DEPARTMENT OF BUILDING AND SAFETY.
- 3. ALL ELECTRICAL INSTALLATION SHALL COMPLY WITH THE APPLICABLE ELECTRICAL CODE OF CITY OF <u>BROOKINGS</u>. ENERGY CONSERVATION IN STATE OF <u>OREGON</u> AND OTHER APPLICABLE ORDINANCES AND STATUES.
- 4. OVERCURRENT PROTECTION AND DISCONNECTING MEANS FOR ALL MOTORS SHALL BE INSTALLED TO COMPLY WITH ELECTRICAL CODE AND EQUAL
- 5. EXACT LOCATION OF ALL EQUIPMENT SHALL BE VERIFIED IN THE FIELD AND ROUTING OF CONDUITS SHALL SUIT FIELD CONDITIONS.
- 6. ALL ELECTRICAL EQUIPMENT OUTDOORS SHALL BE WEATHERPROOF AND LISTED FOR THE PURPOSE.
- 7. IT IS THE INTENT OF THESE DRAWINGS THAT THIS BE A COMPLETE ELECTRICAL JOB. ANY ERRORS OR OMISSIONS SHALL BE BROUGHT TO THE ATTENTION OF THE ENGINEER PRIOR TO BIDDING THE JOB.
- 8. CONTACT POWER AND TELEPHONE CO. AND INSTALL SERVICES AS PER UTILITY CO. REQUIREMENTS. CONTRACTOR SHALL PAY ALL FEES AND
- 9. THE CONTRACTOR SHALL EXAMINE THE CONTRACT PLANS IN ORDER TO LOGICALLY LOCATE WORK IN COORDINATION WITH CONSTRUCTION SUCH AS CABINETS, BEAMS, FURRING, DOOR SWINGS E.T.C.
- 10. CONDUITS SHALL BE CLEAN OF WATER, DEBRIS, AND OTHER FOREIGN MATERIAL PRIOR TO PULLING CONDUCTORS.
- FOR FUTURE USE, INCLUDING TELEPHONE AND INTERCOMMUNICATION SYSTEM, SHALL HAVE #12 GALVANIZED PULL WIRE LEFT IN PLACE FOR FUTURE USE. 12. THE ELECTRICAL CONTRACTOR SHALL BE RESPONSIBLE FOR PROPER

11. CONDUITS WHICH ARE INSTALLED AT THIS TIME AND LEFT EMPTY

- PHASING OF THE BRANCH CIRCUITS INSIDE PANELBOARD(S), TO WITIN 10% OF EACH PHASE.
- 13. ALL PANELS SHALL HAVE HINGED AND LOCKABLE DOORS. INSTALL A TYPEWRITTEN DIRECTORY IN ALL PANELS.
- 14. ALL CONTROL WIRING FOR THE A/C AND HEATING SHALL BE OF 600V INSULATION. CABLE SHALL BE PROVIDED BY MECHANICAL CONTRACTOR AND INSTALLED BY ELECTRICAL CONTRACTOR.
- 15. ALL WIRING SHALL BE TYPE THHN OR THWN 600 VOLTS UNLESS NOTED
- 16. THERMOSTATS SHALL BE MOUNTED ON 4S x 1 1/2" DEEP J-BOX.
- 17. BOND ALL METALLIC GAS AND WATER PIPING FOR CONTINUITY PER N.E.C. PREVAILING EDITION.
- 18. SEE ARCHITECTURAL REFLECTED CEILING PLAN FOR EXACT LTG.
- 19. CONDUITS ENTERING OR LEAVING FREEZER OR COOLER AREA SHALL BE
- 20. CONTRACTOR SHALL CONSULT WITH ARCHITECT AND KITCHEN SUPPLIER
- FOR EXACT LOCATIONS OF EQUIPMENTS PRIOR TO ROUGH-IN AND COORDINATE LOCATION OF OUTLETS AND SWITCHES WITH OTHER TRADES.
- 21. ROOF ACCESS IS PROVIDED. SEE ARCHITECTURAL PLAN.
- 22. CHECK WITH MECHANICAL FOR ACTUAL NO. OF CONTROL WIRE TO A/C UNIT AND TIMECLOCK. CONTRACTOR TO PROVIDE AND INSTALL TIMECLOCK AS REQUIRED BY MECHANICAL CONTRACTOR FOR A/C UNIT IN ACCORDANCE TO TITLE 24 PRIOR TO START OF WORK. ELECTRICAL CONTRACTOR SHALL VERIFY WITH A/C CONTRACTOR THE ELECTRICAL REQUIREMENTS FOR THE A/C AND HEATING SYSTEM. ELECTRICAL CONTRACTOR SHALL PROVIDE ALL NECESSARY ELECTRICAL WORK TO MAKE A COMPLETE AND OPERABLE SYSTEM. PROVIDE 1/2" C.O. FROM EACH A/C UNIT TO THERMOSTAT.
- 23. ALL FEEDER AND BRANCH CIRCUIT CONDUCTORS ARE BASED ON COPPER CONDUCTOR RATING.
- 24. ALL CONTINUOUS ROWS OF FLUORESCENT FIXTURES SHALL BE WRED WITH "RHH" OR "AVA" WIRES.
- 25. ALL BALLASTS SHALL BE HPF. C.B.M. E.T.L. CERTIFIED, CLASS P EQUAL TO UNIVERSAL VLH SERIES, OF QUIETEST SOUND RATING AVAILABLE AND LOWEST HEAT AVAILABLE, AND U.L. APPROVED.
- 26. CONTRACTOR SHALL BE RESPONSIBLE FOR ORDERING PROPER TYPES OF TRIM FOR ALL RECESSED FLUORESCENT FIXTURES AND
- 27. ALL FIXTURES SHALL BE U.L. LISTED AND APPROVED FOR THE PURPOSE.
- 28. ALL ACRYLIC TO BE EXCLUDED.

PROVIDED WITH SEAL.

- 29. ALL LIGHTING FIXTURES SHALL BE INSTALLED PER MANUFACTURERS
- 30. RECESSED FIXTURES IN FIRE RATED CEILING OR SUPPLY AIR PLENUMS SHALL BE APPROVED FOR THE FIRE RATING OF THE CEILING. PROVIDE AIR—TIGHT GASKETS TO SEAL AROUND OPENINGS.
- 31. FIXTURES IN LUMINOUS CEILINGS OR CEILING CAVITIES OR SOFFITS SHALL BE APPROVED FOR TYPE OF INSTALLATION.
- 32. FINISH OF TRIMS OF ALL RECESSED INCANDESCENT FIXTURES SHALL MATCH CEILING FINISH AS DIRECTED BY THE ARCHITECT.
- 33. VERIFY LETTER SIZE AND COLOR OF INTERNALLY ILLUMINATED EXIT SIGNS WITH LOCAL AUTHORITIES PRIOR TO SUBMITAL OF SHOP
- 34. ALL WIRING OF ANY TYPE TO BE INSTALLED IN METAL CONDUIT.

ELECTRICAL NOTES

- 1. MAXIMUM SHORT CIRCUIT AVAILABLE AT THE MAIN SWITCHBOARD IS ______ N/A _____ AMPS SYMMETRICAL.
- 2. MAIN SWITCHBOARD SHALL HAVE A MINIMUM BUS BRACING OF ___N/A____
- 3. MAIN DISCONNECT SHALL BE PADLOCKABLE IN THE "OFF" POSITION.
- 4. UNLESS OTHERWISE NOTED, ALL FUSES SHALL BE CURRENT LIMITING CLASS RK1 EQUAL TO BUSS KTN-R FOR 250V DISCONNECT SWITCHES AND BUSS KTS-R FOR 480V DISCONNECT SWITCHES.
- 5. UNLESS OTHERWISE NOTED. ALL FUSES FOR MOTOR CONTROL CENTERS OR FOR THE PROTECTION OF MOTOR CIRCUITS SHALL BE DUAL-ELEMENT (TIME DELAY) CLASS RK5 EQUAL TO BUSS FRN-R FUSETRON FUSES FOR 250V AND BUSS FRS-R FUSES FOR 480V.
- 6. ALL CIRCUIT BREAKERS SHALL HAVE A MINIMUM 10,000 A.I.C. UNLESS NOTED OTHERWISE.
- 7. ALL FEEDER LENGTHS SHOWN ARE FOR VOLTAGE DROP CALCULATIONS ONLY. ELECTRICAL CONTRACTOR SHALL DETERMINE EXACT FEEDER LENGTH FOR HIS BID.
- 8. ALL CONDUCTORS OF ANY TYPE TO BE COPPER.

FOR INDEX CARDS.

- 9. PROVIDE A METAL CABINET AND SET OF SPARE FUSES FOR EACH SIZE AND TYPE SHOWN ON THE SINGLE LINE DIAGRAM. CABINET SHALL HAVE HINGED DOOR AND NAMEPLATE "SPARE FUSES".
- 10. ALL SECTIONS OF THE MAIN SWITCHBOARD SHALL BE EQUIPPED WITH MICARTA NAMEPLATES INDICATING: "CAUTION-INSTALL
- CURRENT LIMITING FUSES AS ORIGINALLY INSTALLED". 11. THE DISCONNECTING MEANS FOR THE F.A. CONTROL PANEL SHALL
- BE 10' MIN. AND 25' MAX. AWAY FROM SERVICE MAIN DISCONNECT 12. PROVIDE CARD HOLDERS ON INSIDE OF DOORS OF PANELBOARDS
- 13. PROVIDE TWO (2) KEYS WITH EACH PANELBOARD.
- 14. SPACES IN PANELBOARDS SHALL BE FULLY BUSSED TO ACCEPT FUTURE CIRCUIT BREAKERS. 15. TOP AND BOTTOM GUTTERS SHALL BE MINIMUM 6" HIGH. PROVIDE
- 12" GUTTER WHERE DOUBLE LUGS ARE REQUIRED. 16. SUBMIT MAIN SWITCHBOARD SHOP DRAWINGS TO THE UTILITY COMPANY FOR THEIR REVIEW AND APPROVAL.
- 17. ALL PULL BOXES SIZES SMALL BE PER UTILITY CO.'S REQUIREMENTS.
- 18. SHOP DRAWINGS FOR ALL MOTOR CONTROL CENTERS SHALL BE PREPARED IN ACCORDANCE WITH THE CONTROL DIAGRAMS SUBMITTED BY THE MECHANICAL CONTRACTOR AND BEARING BOTH ELECTRICAL
- AND MECHANICAL ENGINEERS' APPROVAI 19. WHERE CIRCUIT BREAKERS SUPPLY POWER TO FLUORESCENT FIXTURES, MOTORS, AND SIGNAL SYSTEMS, THE BREAKERS SHALL

BE FURNISHED WITH LOCKING FACILITIES SO THAT EACH INDIVIDUAL

20. ALL CIRCUIT BREAKERS USED TO CONTROL LIGHTING FIXTURES SHALL BE U.L. LISTED FOR SWITCHING DUTY, 'SWD'.

BREAKER CAN BE LOCKED OFF WITH A PADLOCK.

- 21. A. CONTRACTOR SHALL PROVIDE A "UFER GROUND" FOR SERVICE GROUNDING SYSTEM WHICH SHALL CONSIST OF, BUT NOT LIMITED TO:
- 1. 20' LENGTH OR MORE OF A COPPER CONDUCTOR (SIZED PER N.E.C. 75. SEC.#250-94A) LOCATED BELOW THE VAPOR BARRIER AND ABOUT 3" ABOVE THE BASE OF CONCRETE FOOTING. MINIMUM NO. 2 BARE COPPER CONDUCTOR ENCASES IN MINIMUM 2" OF CONCRETE.
- 2. ACCESSIBLE AND APPROVED GROUND CLAMPS.
- 3. BONDING OF COPPER CONDUCTOR TO INTERIOR METALLIC COLD WATER PIPING SYSTEM.
- 4. BONDING JUMPER OR SCREWS FOR NEUTRAL TERMINAL IN MAIN SWITCHBOARD, IF INSTALLED FROM THE CAN.
- PROVIDE ALL REQUIRED COMPONENTS FOR A COMPLETE "UFER GROUND SYSTEM" AS APPROVED BY LOCAL INSPECTOR AND
- B. COLD WATER PIPE GROUNDING METHOD, IF USED, SHALL BE SUPPLEMENTED BY AN ADDITIONAL GROUNDING ELECTRODE AS INDICATED BY SECTION 250-81(A), SUPPLEMENTAL FLECTRODE SHALL BE 5/8" DIAMETER X 10 FEET DRIVEN COPPER GROUND ROD BONDED TO WATER MAIN BY CONDUCTOR SIZED THE SAME
- AS THE SERVICE GROUND CONDUCTOR. 22. BUSES IN PANEL BOARDS, SWITCHBOARDS, SERVICES ETC., FEEDERS AND BRANCH CIRCUIT CONDUCTORS SHALL BE COPPER. THIS REQUIREMENT SUPERSEDE OTHER DOCUMENTATION. ALUMINUM BUS OR CONDUCTORS CAN BE USED ONLY WHEN CONTRACTOR OBTAINS APPROVAL IN WRITING
- 23. INSTALL NYLON PULL WIRE IN EACH SPARE CONDUIT.
- 24. TEMPERATURE RATING OF ALL CONDUCTOR TERMINALS SHALL BE 75 DEGREE CELSIUS. FOR SWITCHBOARDS, PANELBOARDS AND EQUIPMENT CONTAINING BREAKERS, SWITCHES AND CONDUCTOR TERMINATIONS SHALL BE LISTED FOR 75 DEGREE TERMINATION.
- 25. HORIZONTAL PORTION OF CONDUIT EXPOSED ON THE ROOF AND FEEDING EQUIPMENT SHALL NOT BE MORE THAN 5' UNLESS THE WRITTEN APPROVAL FROM ARCHITECT OR ENGINEER IS OBTAINED.
- 26. PANELBOARDS TO HAVE BOLT ON CIRCUIT BREAKERS.
- 27. ELECTRICAL EQUIPMENT SHALL BE LISTED BY A CITY OF BROOKINGS RECOGNIZED ELECTRICAL TESTING LABORATORY OR APPROVED BY THE

- 1. THE GENERAL CONDITIONS AND THE ELECTRICAL SECTION OF SPECIFICATIONS SHALL APPLY TO THIS PORTION OF WORK, IN ADDITION TO ELECTRICAL NOTES AND GENERAL NOTES STATED HEREIN.
- 2. REFER TO ALL THE DRAWINGS AND VISIT SITE IN ORDER TO COORINATE THE ELECTRICAL WORK WITH OTHER WORK ON THE PREMISES AND WITH FIELD CON-DITIONS. THE ARCHITECTURAL AND STRUCTURAL DRAWINGS TAKE PRECEDENCE OVER THE ELECTRICAL DRAWINGS IN THE REPRESENTATION OF THE GENERAL CONSTRUCTION WORK OF THESE TRADES, REFER TO REFLECTED CEILING PLANS FOR FIXTURE LOCATION AND TO EQUIPMENT SUPPLIER DRAWINGS FOR OUTLET
- 3. WHERE THE WORK AFFECTS THE OPERATION OF EXISTING FACILITIES INCLUDE ANY PREMIUM COSTS REQUIRED TO AVOID SHUT-DOWN OF FACILITIES DURING NORMAL OPERATION.
- 4. PROVIDE ALL LABOR, MATERIAL, EQUIPMENT, TRANSPORTATION, AND SERVICE REQUIRED FOR A COMPLETE AND OPERATIVE ELECTRICAL SYSTEM AS INDICATED

SYMBOL LIST

— T — TELEPHONE CONDUIT 3/4" C. UNLESS OTHERWISE NOTED — T + TELEPHONE CONDUIT 1" C. UNLESS OTHERWISE NOTED CONDUIT CONCEALED IN WALL OR CEILING, UNLESS OTHERWISE NOTED - - CONDUIT CONCEALED IN FLOOR OR UNDERGROUND, UNLESS OTHERWISE NOTED — E — EXITING CONDUIT

2 #12 IN 1/2" C, UNLESS OTHERWISE NOTED → ₩ 3 #12 IN 1/2" C, UNLESS OTHERWISE NOTED 4 #12 IN 3/4" C, UNLESS OTHERWSE NOTED 5 #12 IN 3/4" C, UNLESS OTHERWISE NOTED 6 #12 IN 1" C, UNLESS OTHERWISE NOTED

#10 ... INDICATES CONDUCTOR SIZE, CONDUIT SIZE AS REQUIRED

7 #12 IN 1" C, UNLESS OTHERWISE NOTED 8 #12 IN 1" C, UNLESS OTHERWISE NOTED • CONDUIT UP CONDUIT DOWN

	SYMBOL LEGEND
SYMBOL	DESCRIPTION
	FLUORESCENT LIGHTING FIXTURE
OA-1	
Юа	INCANDESCENT LT. FIXTURE (WALL MT'D.) CONTROLLED BY SWITCH 'a'
	EQUIPMENT/SERVICE CHASE
<u></u>	LIGHTED EXIT SIGN — CEILING & WALL MT'D. — PROVIDED W/ BATT. PACK
(A)	LIGHT FIXTURE TYPE 'A' - SEE LIGHTING FIXTURE SCHEDULE
\Q\	PADDLE FAN - SEE LIGHT FIXTURE SCHEDULE FOR SPECS.
\$ a	SINGLE POLE TOGGLE SWITCH (20A, 125/277V) +48", SWITCH 'a'
\$2	DOUBLE POLE TOGGLE SWITCH (20A, 125/277V) +48".
\$3	THREE-WAY TOGGLE SWITCH (20A, 125/277V) +48"
\$4	FOUR-WAY TOGGLE SWITCH (20A, 125/277V) +48"
\$ P	SWITCH WITH LIGHTED HANDLE WHEN-HANDLE IS IN THE 'ON' POSITION IT IS LIT
\$ F	FAN. DISC. SWITCH (FURNISHED WITH FAN CONNECTED BY CONTRACTOR)
\$ м	MOTOR RATED TOGGLE SWITCH WITH HEATERS (MANUAL STARTER)
\$ PR	TOGGLE SWITCH WITH PILOT LIGHT FURNISHED PRE-WIRED WITH WALK-IN REFRIGERATOR/ FREEZER
\$ st	MAIN BREAKER SHUNT TRIP. BREAK GLASS STATION — ASCO OR EQUAL. (FOR FIRE FIGHTERS DIS. WHEN REQ'D. BY LOCAL CODE AUTHORITY)
\$ sL	CONTROL SWITCH FOR STOCK LEVEL SYSTEM PROVIDED BY FIXTURE MANUF.
HR	WALK-IN REFRIGERATOR/FREEZER DOOR HEATER PRE-WIRED IN DOOR FRAME
H(R)	WALK-IN REFRIGERATOR/FREEZER WALL MOUNTED LIGHT PRE-WIRED IN WALL COORDINATE LAMP WITH SUPPLIER
<u> </u>	DUPLEX RECEPTACLE OUTLET, 20A, 125V, 3W, SPEC. GRADE, WALL MT'D., +18"
+	DUPLEX RECEPTACLE OUTLET, 20A, 125V, 3W, SPEC. GRADE, CEILING MOUNTED
Ф	SINGLE RECEPTACLE OUTLET, 30A, 125V, 3W, SPEC. GRADE
W.P.	INDICATES "WEATHER PROOF"
R.T.	INDICATES "RAINTIGHT"
E.W.H.	INDICATES "ELECTRIC WATER HEATER"
G.F.I.	INDICATES "GROUND FAULT INTERRUPTING" DEVICE
M.R.P.	MASTER RELAY PANEL (SEE WIRING DIAGRAM)
E.C.	EMPTY CONDUIT
NL -	NIGHT LIGHT — UNSWITCHED
	SPECIAL PURPOSE OUTLET-TO MATCH EQUIPMENT PLUG
<u> </u>	JUNCTION BOX-CEILING AND WALL
<u>[i]</u>	PRE-WIRED J-BOX IN EQUIPMENT - SUPPLIED BY EQUIP. MANUFACTURER
<u> </u>	PREWIRED OUTLETS BY EQUIPMENT MANUFACTURER
_	TELEPHONE OUTLET
H <u>-</u>	PUSH BUTTON — EDWARDS #B52
	BELL — EDWARDS #17-4
	TRANSFORMER — EDWARDS #99B
<u>©</u> -टि-४४-	DUCT STRIP HEATER WITH DISC. (FUSED) SWITCH & CONTACTOR—SIZE FUSES
_	AS PER MANUFACTURER'S DIRECTION MOTOR — CONNECTED BY ELECTRICIAN
y	MOTOR STARTER - MOUNTED AND CONNECTED BY ELECTRICIAN
]-3 €6 F	HEAVY DUTY SAFETY (DISC.) SWITCH: 3=3 POLE: 60=60 AMP: F=FUSE SIZE AS DIRECTED BY EQUIP.MANUF.(FUSED IF REQ'D. BY CODE GOVERNING AUTHORITY).
-	JUNCTION BOX ON STUBBED UP CONDUIT
	DISTRIBUTION PANEL OR GUTTER
	LIGHTING OR GENERAL PANELBOARD
₽▽	EMERGENCY BATTERY LIGHT/REMOTE HEAD (WALL MT'D.)
	BRANCH CIRCUIT HOMERUN TO PANEL
-	FLEXIBLE METAL CONDUIT
	CONDUIT RUN CONCEALED IN WALL OR CEILING
	CONDUIT RUN UNDERGROUND, IN OR BELOW FLOOR SLAB
<u> </u>	CONDUIT RUN CONCEALED, TO VIEW, ABOVE EXPOSED WOOD BRIDGING AND PAINTED TO MATCH WOOD
— DC—	DIRECT CURRENT WIRING (12 V.)
	DUST GUALE DETECTOR EUROPER A MOTULER BY UVA A CONTROL

ABBREVIATIONS

AFF ABOVE FINISHED FLOOR CO CONDUIT ONLY

EX EXPLOSION-PROOF

NITS NOT IN THIS SECTION NTS NOT TO SCALE

NIC NOT IN CONTRACT

DUCT SMOKE DETECTOR-FURNISHED & INSTALLED BY H.V.A.C. CONTRACTOR SELF-POWERED (24V.) TO SHUT DOWN A/C UNIT UPON SMOKE DETECTION.


SMOKE DETECTOR ALARM PANEL FURNISHED BY H.V.A.C. CONTRACTOR

48"A.F.F. PROVIDE IDENTIFICATION ENGRAVED PLATE OR SIGN.

GFI GROUND FAULT INTERRUPTER UON UNLESS OTHERWISE NOTED VL VERIFY EXACT LOCATION HID HIGH INTENSITY DISCHARGE WP WEATHER-PROOF LCL CALCULATED @ 125 %. MTD MOUNTED


> ENGINEER: JS ENGINEERING, INC. 410 S. SAN GABRIEL BLVD., SUITE 8, SAN GABRIEL, CA 91776 PHONE: 626.497.0558 EMAIL: INFO@CAL-PACIFIC.NET




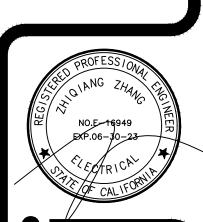



 \mathbf{m}


C:\Users\char\\OneDrive\2021 Project\DesignUA\Burger King\INS 001 Desert Hot Springs\CD\r2 base update\E01 General Notes.dwg, 6/7/2021 1:32:13 PM, charl, AutoCAD PDF (General Documentation).pc3, CAL Arc1

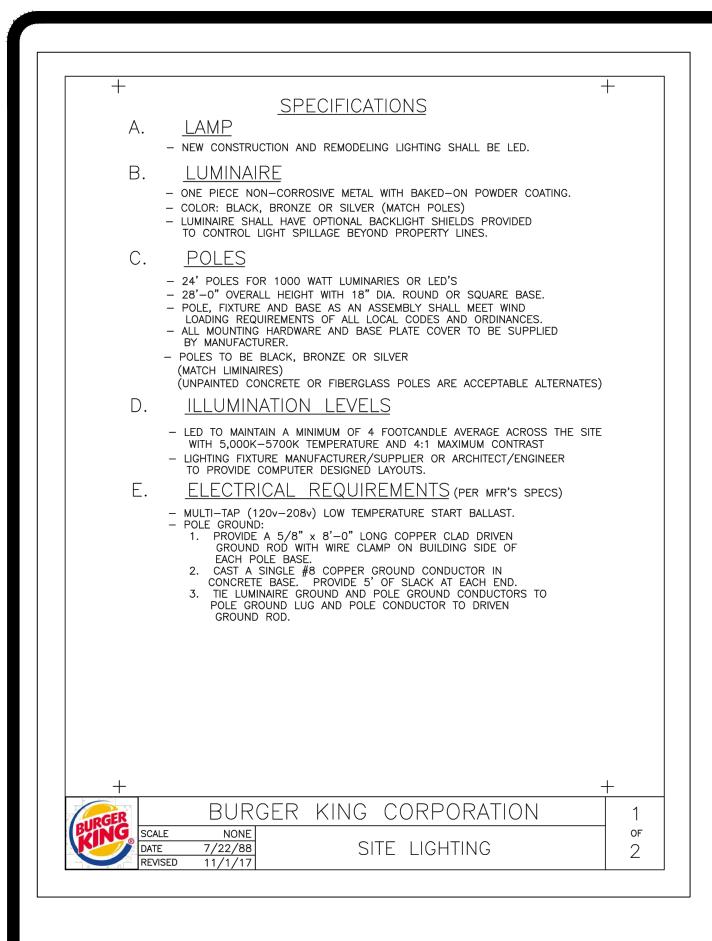


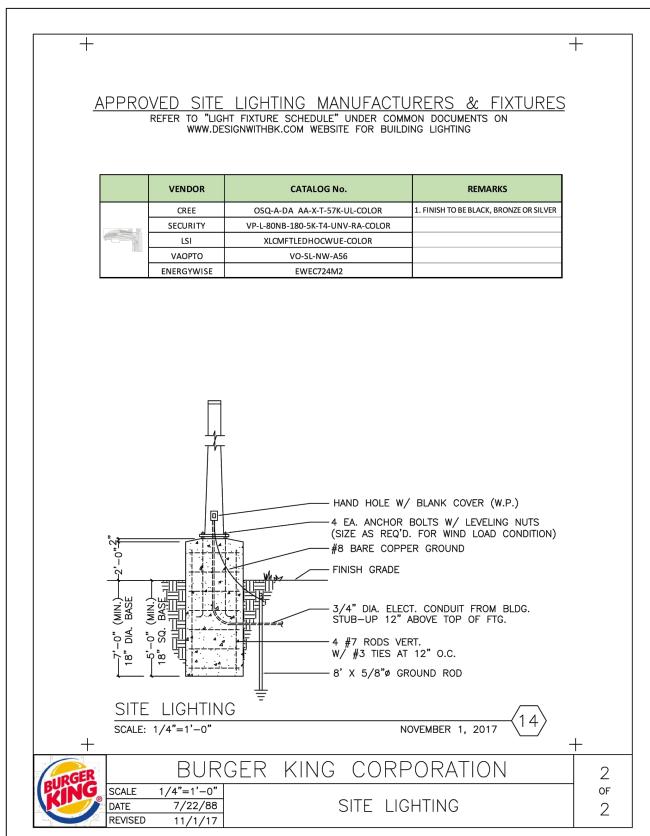


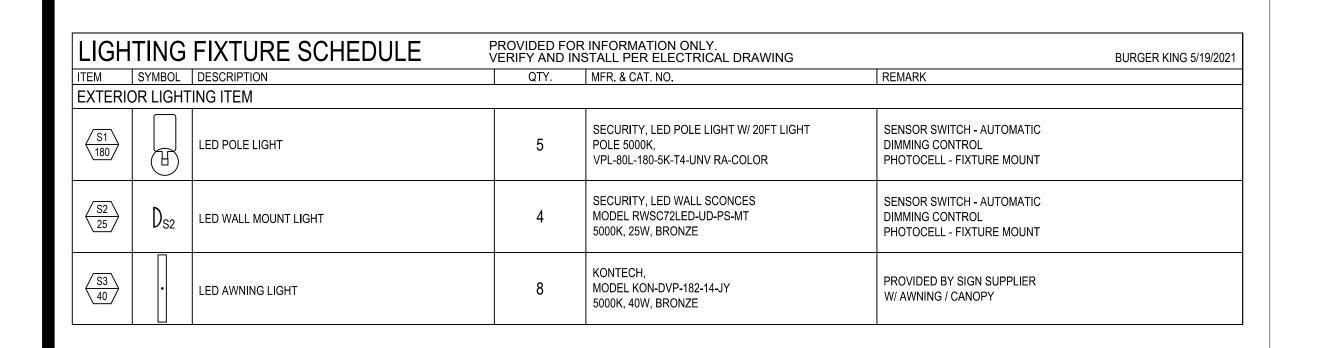


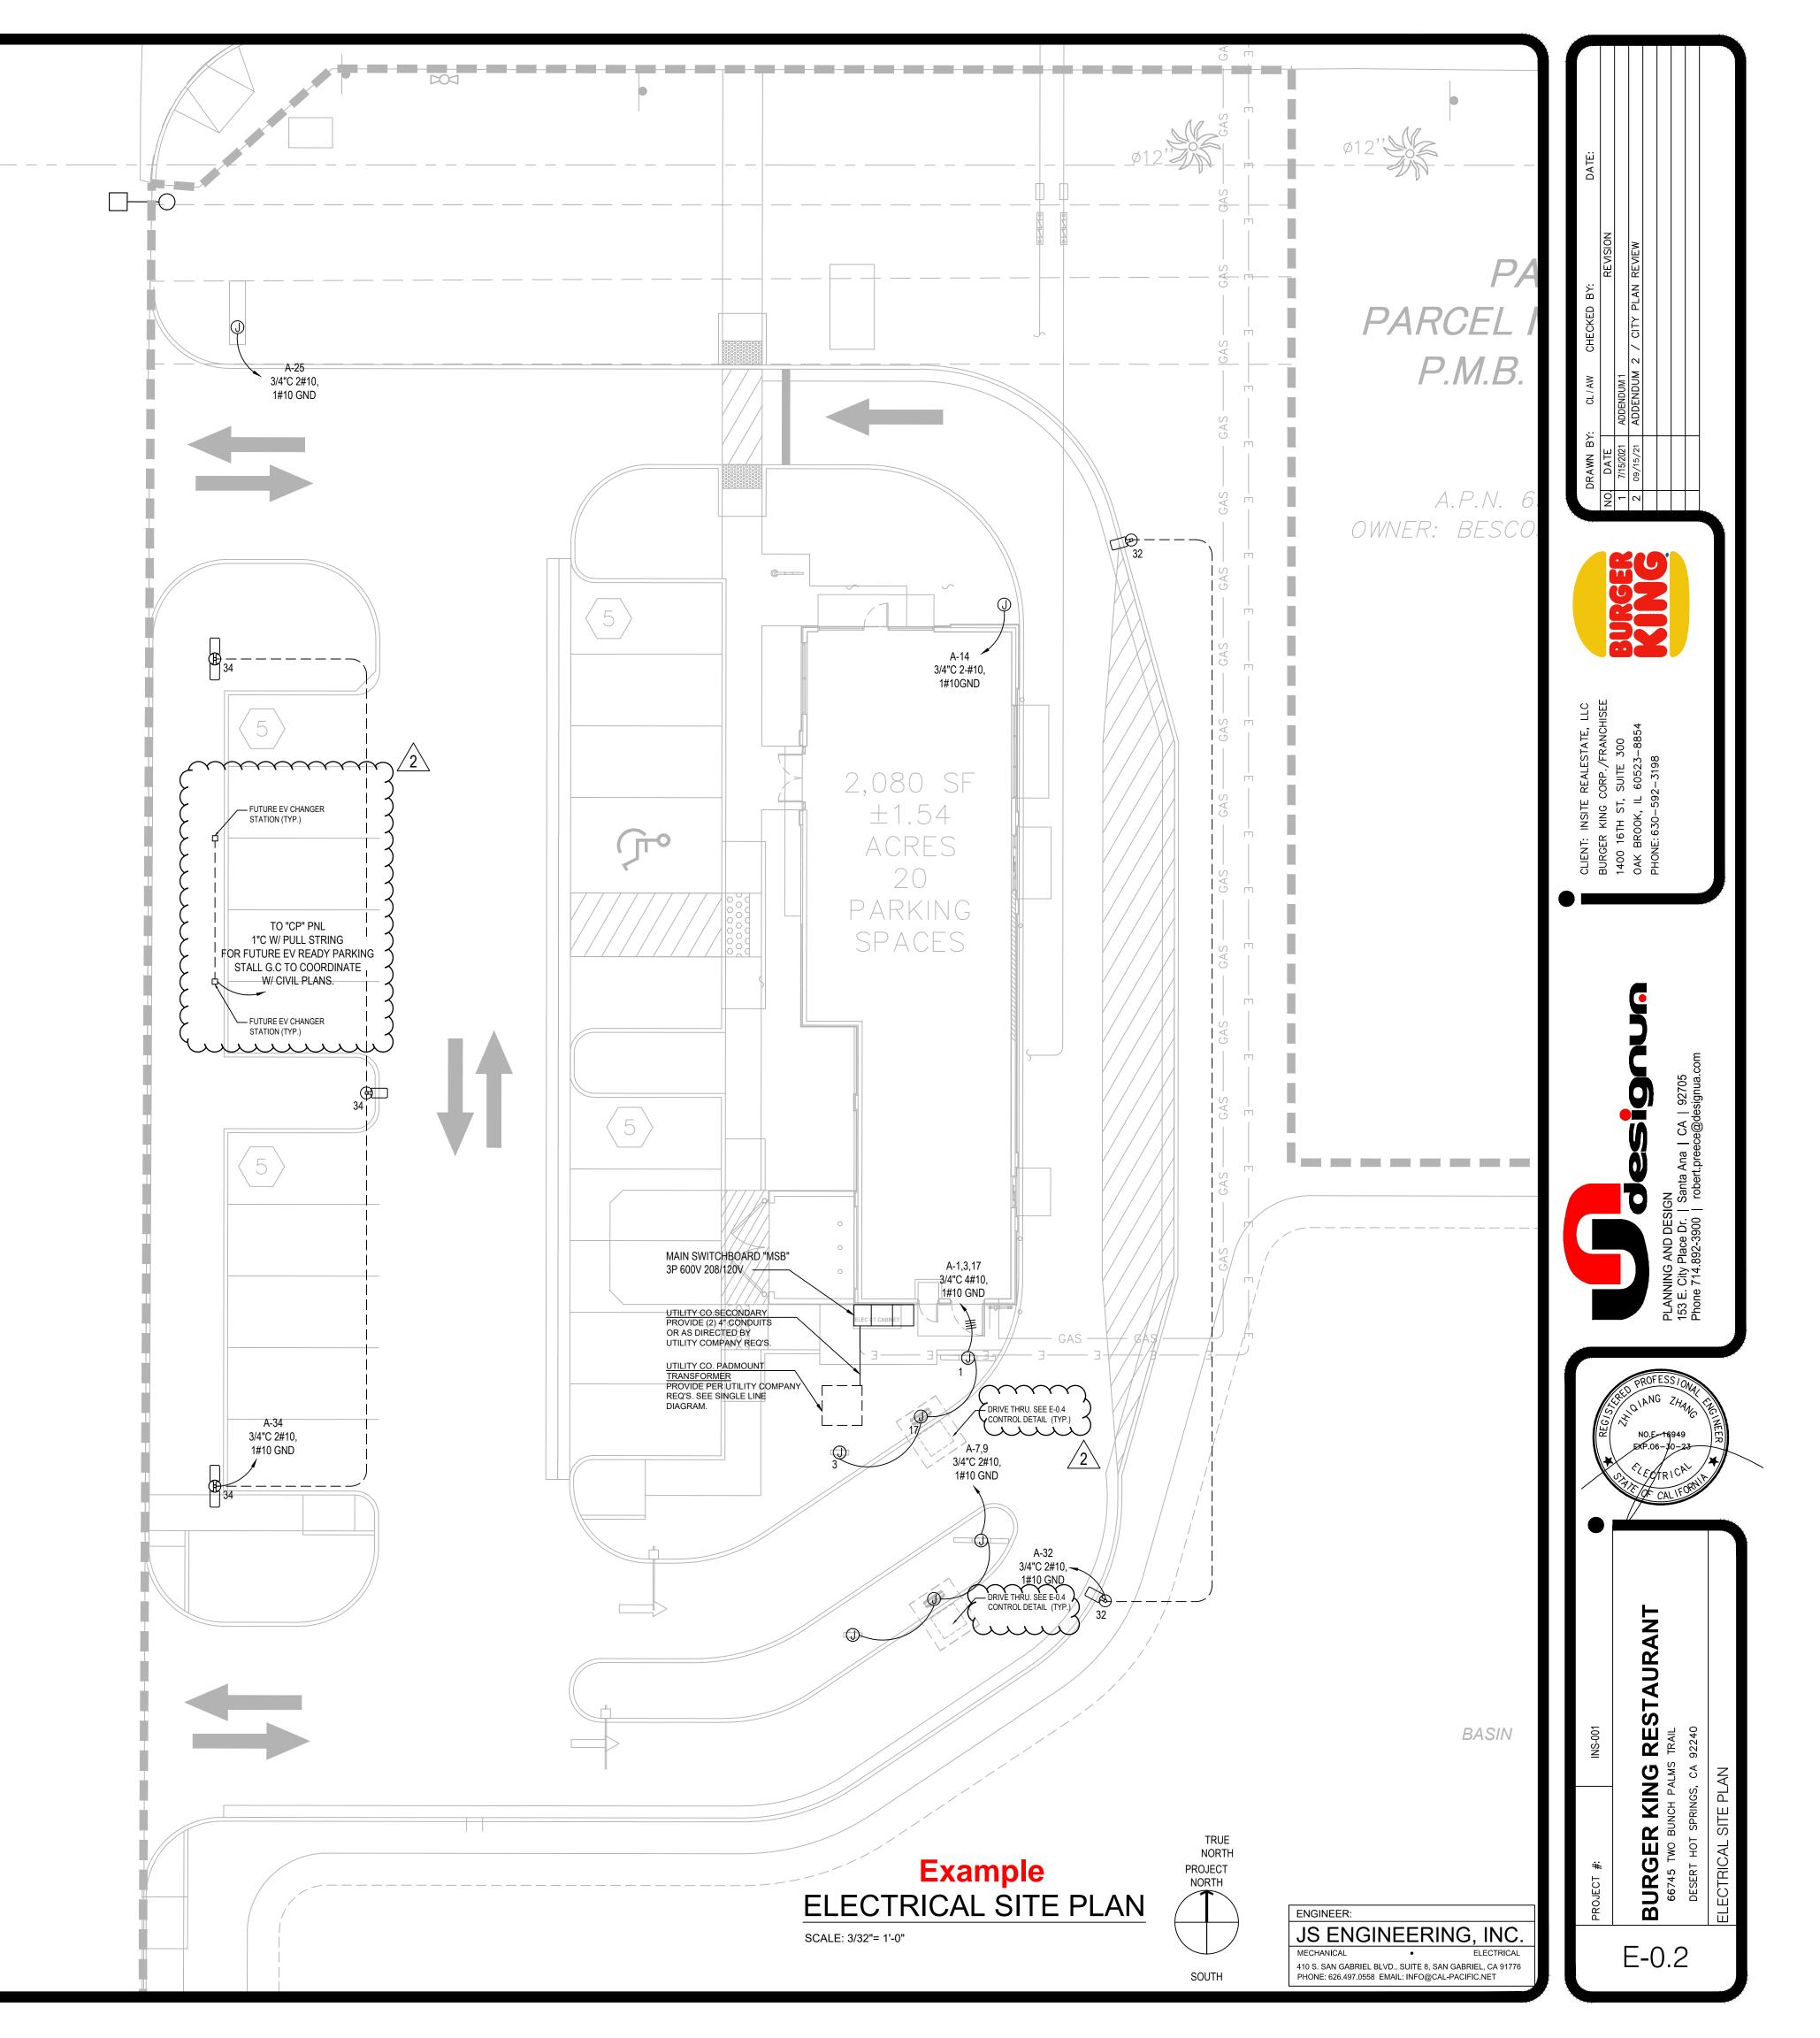

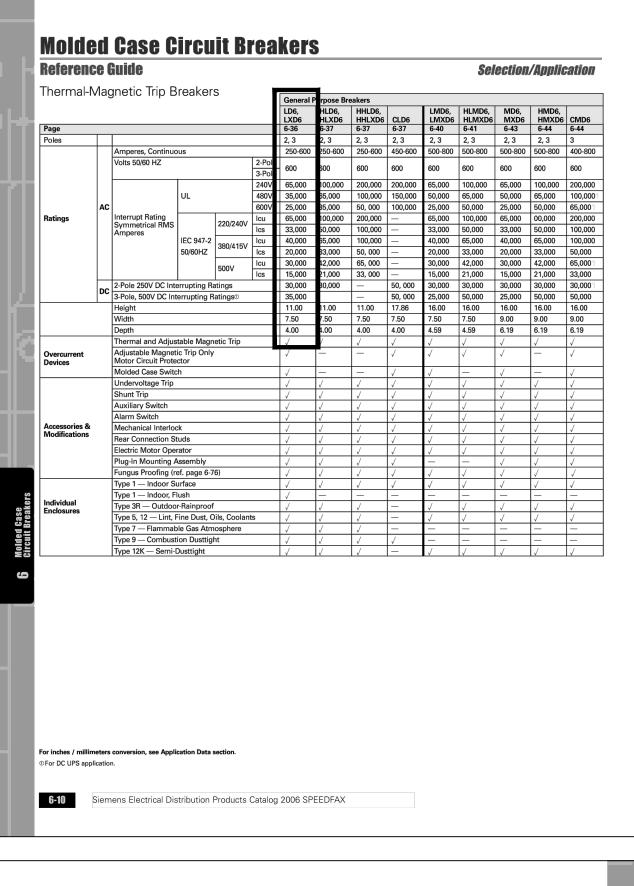


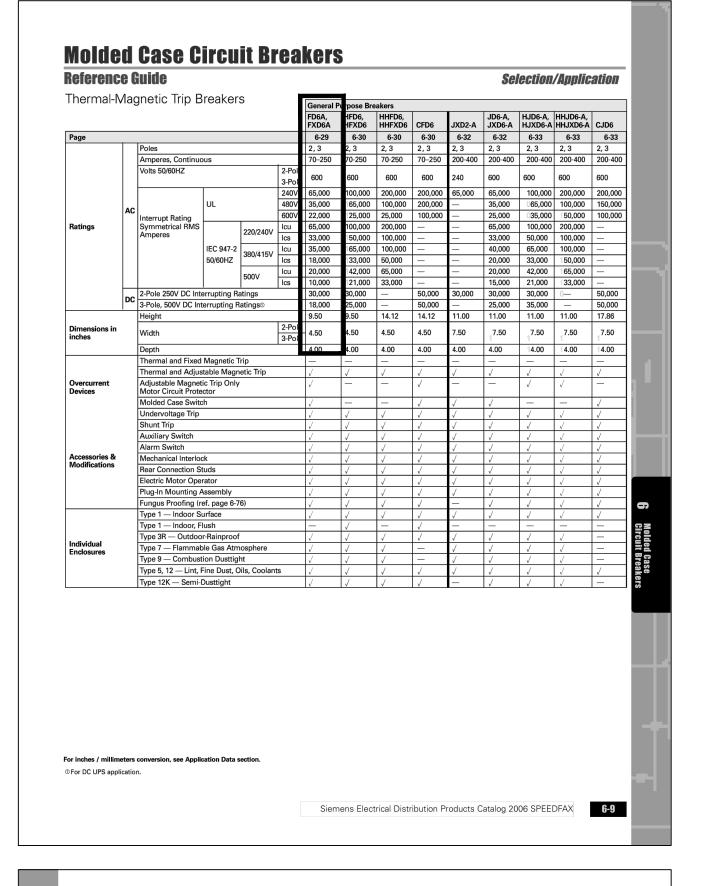


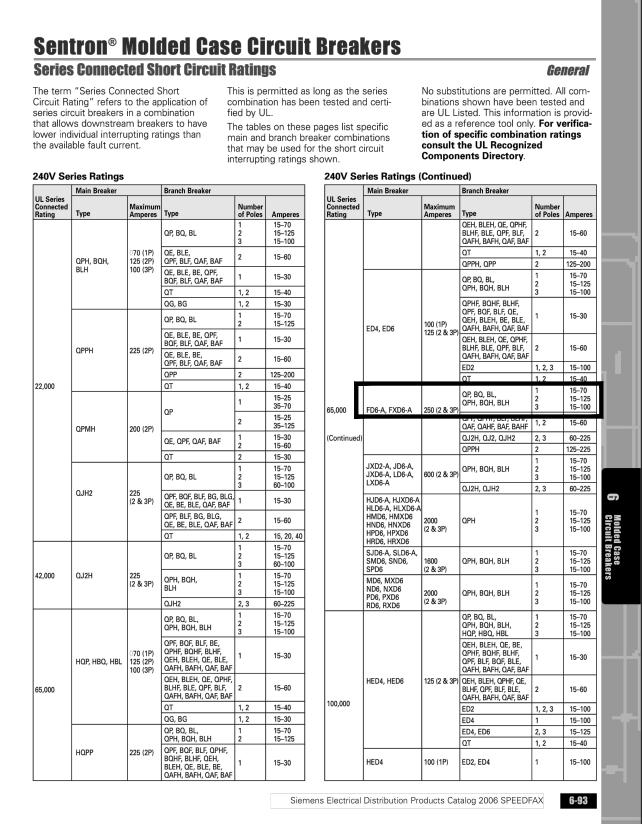

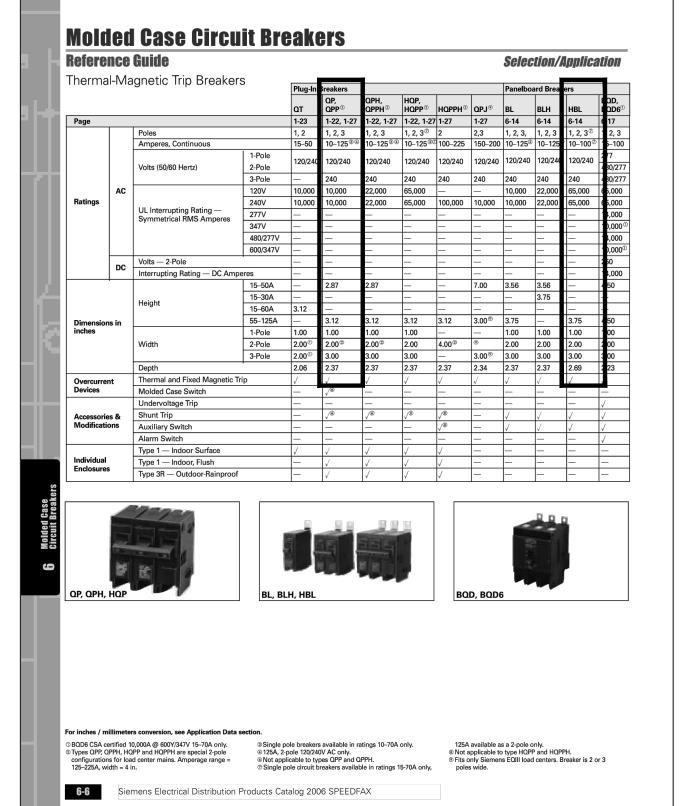

		VOLTAG	E DRO	P CAL	CULATI	ON						
FROM	то	LENGTH	VD.	%	LOAD	AWG	C.MILLS					
		(FEET)	(V)		(A)							
					(MAX)							
MSB	PANEL "A"	40	0.4	0.21	81	#3/0	167800	#18	1620	1PHASE	: VD=2xKxlx	(L/CM
MSB	PANEL "B"	40	0.4	0.19	75	#3/0	167800	#16	2580	3PHASE	: VD=1.732x	KxlxL/CM
MSB	PANEL "C"	40	0.3	0.17	65	#3/0	167800	#14	4110			
MSB	MODULE	75	1.2	0.57	95	#2/0	133100	#12	6530	K=12.9 FO	R COPPER	
MSB	AC-1	65	1.8	0.88	33	#6	26240	#10	10380	K=21.2 FO	R ALUMINUM	
MSB	AC-2	75	2.1	1.01	33	#6	26240	#8	16510			
MSB	AC-3	100	2.8	1.35	33	#6	26240	#6	26240	I=CURREN	Т	
MSB	PANEL"CP"	45	0.5	0.26	56	#1/0	105600	#4	41740	L=LENGTH	I	
								#3	52620	CM=CIRCU	JLAR MILES	
								#2	66360			
PANEL"A", A-23	FIXTURE	80	2.0	1.66	10	#10	10380	#1	83690			
PANEL"B", B-9.11	FIXTURE	40	2.4	1.14	15	#12	6530	#1/0	105600			
PANEL"B", B-13,15	FIXTURE	40	1.6	0.76	16	#10	10380	#2/0	133100			
PANEL"B", B-17,19,21	FIXTURE	50	1.9	0.93	18	#10	10380	#3/0	167800			
								#4/0	211600			
PANEL"C", C-9,11	FIXTURE	40	1.7	0.81	17	#10	10380					
PANEL"CP", CP-1,3	EV CARGER	150	4.3	2.06	29	#6	26240					
AX. VOLTAGE DROP IN I	 PANEL "A": 0.2	1% +1.66%	=1.86%	LESS T	HAN 5%							
AX. VOLTAGE DROP IN I	PANEL "B": 0.1	9% +1.14%	=1.33%	, LESS T	THAN 5%							
AX. VOLTAGE DROP IN I	PANEL "C": 0.1	7% +0.81%	=0.98%	LESS	HAN 5%							

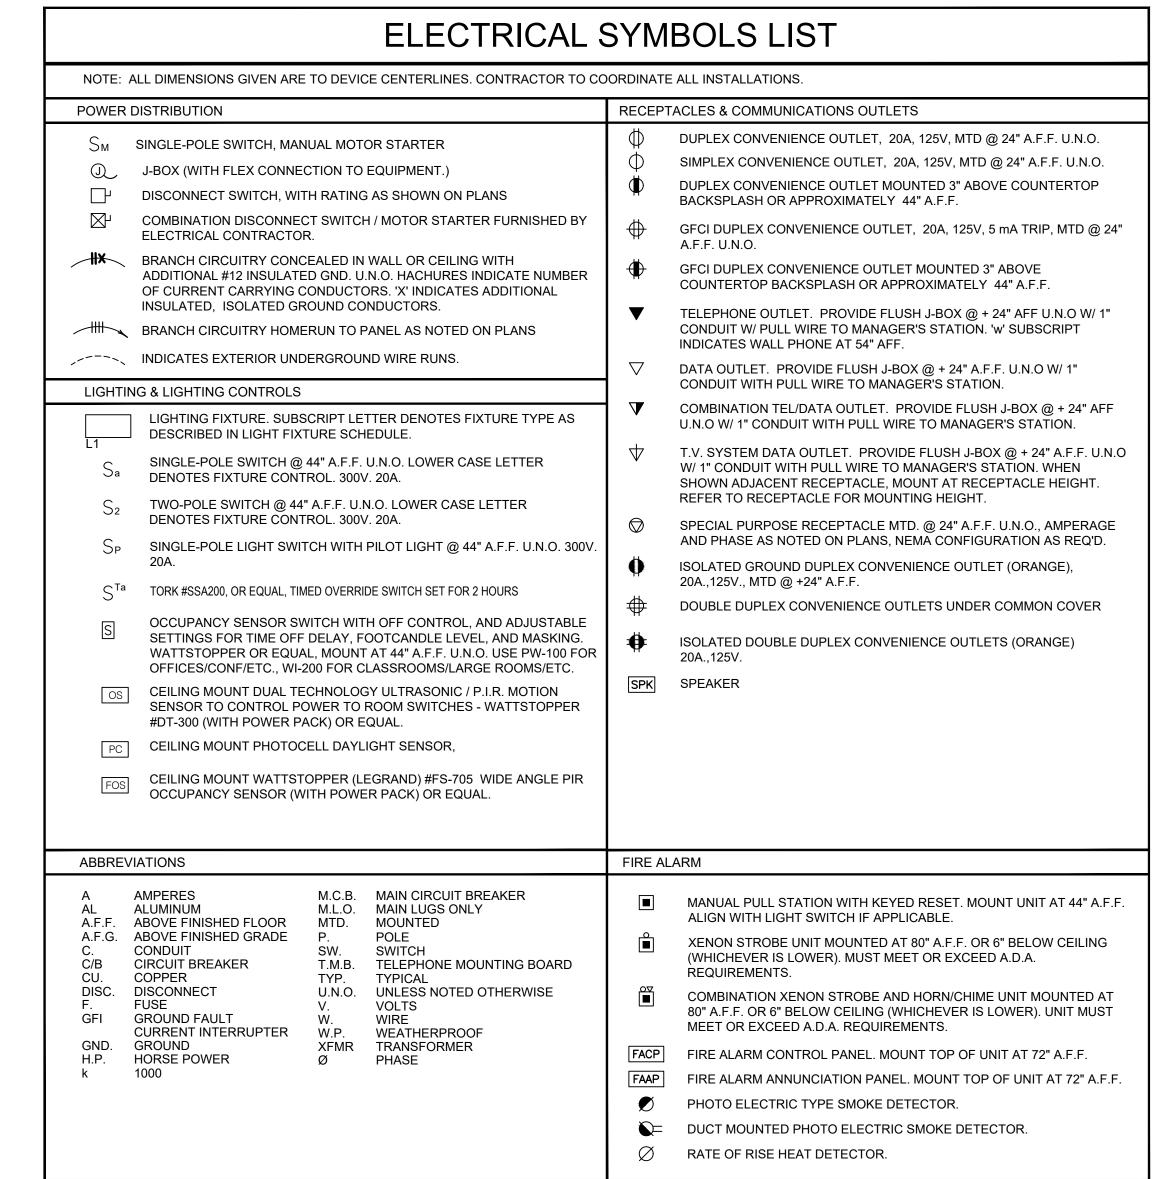

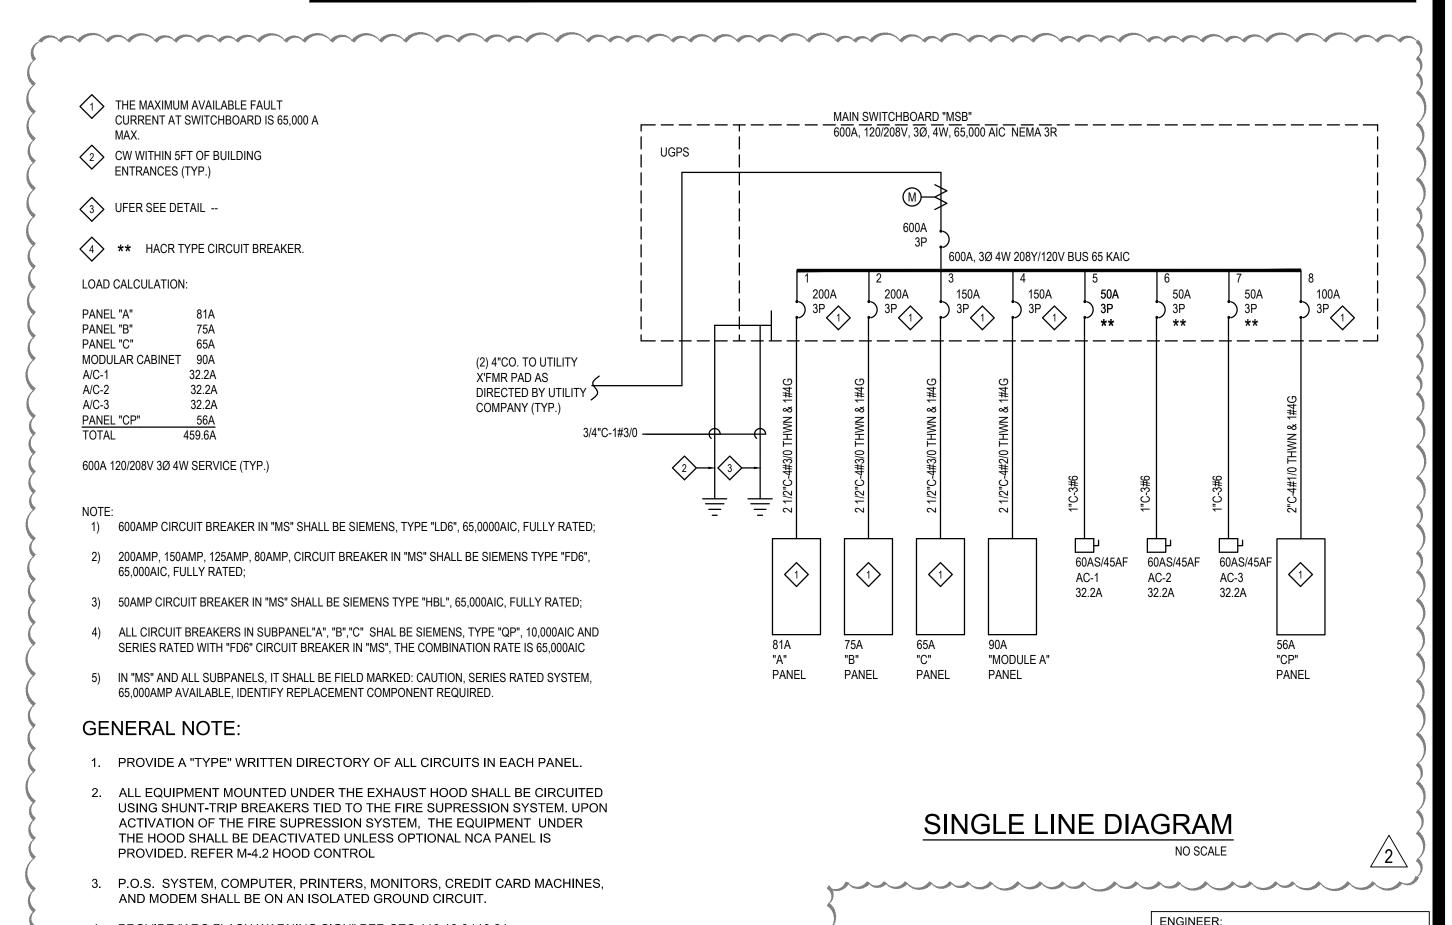

4. PROVIDE "ARC FLASH WARNING SIGN" PER CEC 110.16 &110.24

5. PROVISE FIELD IDENTIFICATION REQUIRED FOR PANELBOARDS PER CEC

410 S. SAN GABRIEL BLVD., SUITE 8, SAN GABRIEL, CA 91776
PHONE: 626.497.0558 EMAIL: INFO@CAL-PACIFIC.NET


JS ENGINEERING, INC

E-0.3

URG

 \mathbf{m}

3 2 10

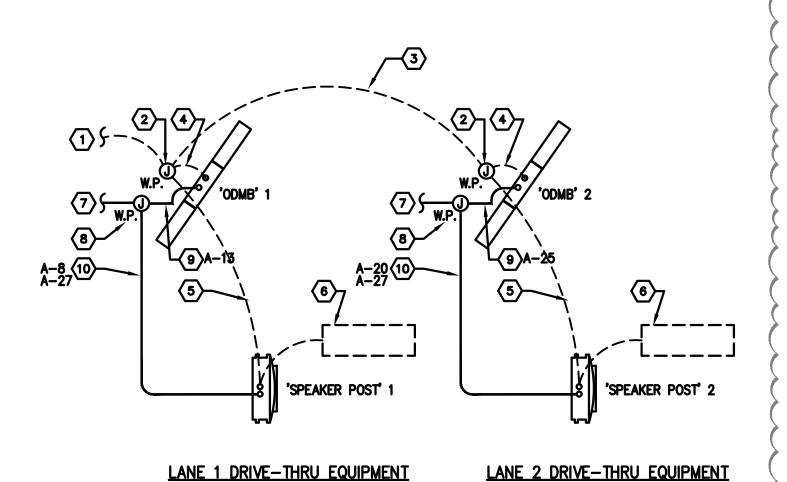

EXECUTE: KEYED NOTES - DRIVE THRU:

DATA

1. 2" UNDERGROUND DATA CONDUIT FROM DRIVE—THRU.

2. WATERPROOF JUNCTION DATA BOX LOCATED BEHIND 'ODMB'.

WATERFROOF JUNCTION DATA BOX LOCATED BEHIND ODMB.
 2" UNDERGROUND DATA CONDUIT TO LANE 2.
 3/4" PVC SWEPT INTO 'ODMB' FOOTER.
 3/4" PVC SWEPT INTO 'SPEAKER POST'.
 1/2" PVC SWEPT INTO 'SPEAKER POST' FROM UNDER CONCRETE LOOP.

LANE 1 DRIVE—THRU EQUIPMENT


ELECTRICAL

7. 1" UNDERGROUND POWER CONDUIT TO DEDICATED CIRCUIT. REFER TO PANEL SCHEDULE.

8. WATERPROOF JUNCTION POWER BOX LOCATED BEHIND 'ODMB'.

9. 1/2" CONDUIT SWEPT INTO 'ODMB' FOOTER FOR DEDICATED POWER. REFER TO PANEL SCHEDULE.

10. 3/4" CONDUIT SWEPT INTO 'SPEAKER POST' FOOTER FOR DEDICATED POWER. TIE INTO BUILDING LIGHT CIRCUIT. REFER TO PANEL SCHEDULE.

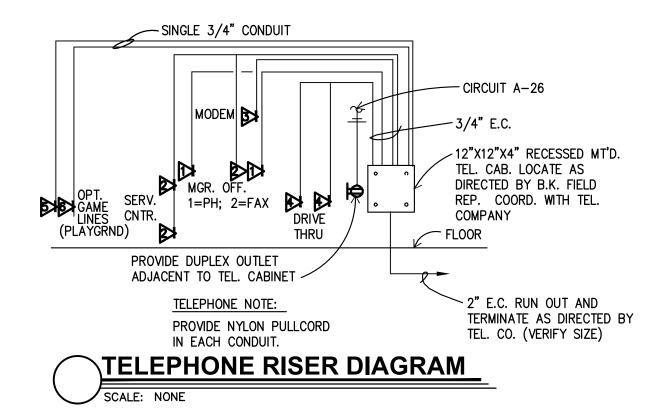


VOLTAGE <u>120/208</u> BUS AMPS <u>100A</u> MAIN BREAKER □ LUGS ONLY 🖾		4W.					PAN	NEL_	CP							TOP BOT	FEEI TOM	FEED	PLAN IXI	FLUS	TACE MTG.□ H MTG. ⊠	
DESCRIPTION			MPS	LOAD	OUT	LETS	1 ('	C K T	Вι	JS	C	C			S LOAD					DESC	RIPTION	
514 01111105B	Α	В	С	CODE	L F	R M	B	T		3 C	T	В	L	R M	1 COPE	Α	В	С				
EV CHANGER	2975		-	0		+1	40A/2P		•	\top												
EV CHANGER		2975	2975			+	40A/2P	3	1	Т	6				+							
LY CITAINULIN	2975		29/3	0		+'		7	I	I	8		1									
FUTURE SOLAR SYSTEM	2373	2700		0		1	30A/3P		$oxed{oxed}$	Щ	10		1									
-			2700	0		+		11	$ \bot $	\downarrow	12											
_	2700			0		\top		13	+	\vdash	14											
								15	4	+	16											
								17	+	+	18											
								19	+	+	20											
								21	+	\vdash	22											
								23	+	┿	24											
						\perp		25	+	+	26											
						+		27	+	\vdash	28				_							
						_	-	29	T	1	30 32				_							
						+		31 33	•	Ħ	34				_		-					
						+		35	T	Т	36				+							
						+		37		\square	38				+							
						+		39	L	П	40				+							
						+		41	L		42											
SUB TOTALS	8650	5675	5675							ш	11					0	0	0			SUB TOT.	ALS
CONN. PHASE TOTAL: A8					56	75																
			_	<u> </u>			_,									ı	OAD (CODE		K KI	TCHEN	
CONN. PANEL TOTAL 200	•	•	_													ı	-5/10 (JUL		L LC	NG CONT. LOA	.D/
L.C.L & L.M. 0 KIT. EQUIP 0	x1.2	5 _	0		. (VA)															LA	ARGEST MOTOR	·
KIT. EQUIP0		_	0		. (VA)	(K =	> 6 @ 65	5%)													THERS ECEPTACLE	
REC. <=10KVA 0			0		. (VA)	(1ST	10 KVA	k100%	8)											IX IXL	LOLI IAOLL	
REC. REMAINDER 0 OTHERS LOAD 20000	x0.5	_	2000	_	. (VA)																	
OTHERS LOAD	x1	_	2000		. (VA)		56AMP															


120 /208		4144							,,	۸ "									CEE	DI AN		1
VOLTAGE 120/208 BUS AMPS 225A MAIN BREAKER LUGS ONLY	_ 3ø, _ _AMP,	-					Р	ANEL	<i></i>	4							TOP BOT	ATION FEED TOM F ARKS	EED	⊠ 5	SURFACE MTG. LUSH MTG. M	
DESCRIPTION		T-AN		LOAD CODE	OUT			C K	=	BUS	ΙN	0		JTLE R		LOAD CODE		T-AM		D	ESCRIPTION	
DRIVE THRU MENU BD	A 1000	В	С	0	L		1 20A/		1-	ВС		20A/1P		K	M	L	350	В	С	DINING R	ROOM LIGHT	+
PRE-SALE MENU BD.		1000	- 1	-0		_	1 20A/			++	- 4	20A/1P	12			L		180		DINING R	ROOM LIGHT	1
SHOW WIND. RECEPT.			1200	L		1	20A/			╅		20A/1P				L			602	KITCHEN	LIGHT	1
SHOW WIND. RECEPT.	1200			L	ナ	1	20A/	IP 7	 1-∳	+		20A/1P		1		0	360			OCU/CRI	EDIT CARD SWIPE	1
SHOW WIND. RECEPT.		1200		L	$ \overline{} $	1	20A/	IP 9	1+	++	10	20A/1P	7	1		R		540		DIGITAL	MENU BOARD	1
SHOW WIND. RECEPT.			1200	L	1	1	20A/	IP 11	7+	╅	12	20A/1P	4	2	1	0			560	RESTROC	OM LTG/ EF-2	1
DRIVE THRU MENU SIGN	720		*	7	1		20A/	IP 13	∃ -∳	++	14	20A/1P	1			L	720			DIRECTIO	NAL SIGNS	1
SPARE							20A/	IP 15	71	++	16	20A/1P	•							SPARE		1
ORDER STATION			900	K			1 20A/	IP 17	7+	╅	18	20A/1P	•	2		R			360	SMOKE [ETECTOR	1
CHANNEL LETTERS LOGO	1200			L			1 20A/	IP 19	- -∳	++	- 20	20A/1P	1			L	132			EXTERIOR	R LTG.	1
PARAPET LIGHT BAND		240		L	1		20A/	IP 21	7+	++	22	20A/1P	•		1	L		720		LTG CON	TORL	1
CHANNEL LETTERS LOGO			1200	L			1 20A/			╅	- 24	20A/1P	11			L			380	EXTERIOR	R LTG.	1
MONUMENTSION	1200	7			Y		(20A)	IP 25	1	Н	- 26	20A/1P	•	1		R	360			TELEPHO	NE BOARD	1
SPARE							20A/	IP 27	14	(++	- 28	20A/1P	•	3		R		540		EXTERIOR	R RECEPTS.	1
SBARE	ا ل	ر	S	L.	لد	J	20A/	IB 29	U	\ +	- 30	20A/1P	•	2		R			360	KITCHEN	RECEPT.	1
ROOF RECEPTS.	540			R		3	20A/	IP 31	-	++	- 32	20A/1P	3			L	224			SITE LIGH	ITING	1 ^
SERVICE CUNTER CORR.		360		R		2	20A/	IP 33	7+	++	- 34	20A/1P	4			L		336		SITE LIGI	HTING	1/3
D/T. SPEED / CAMERA			540	R		3	20A/	IP 35	<u>1</u>	┵		20A/1P				\sim	\sim	>	~	SPARE	~~~~	
DRIVE THRU WIND.AIR CURTAIN	960			К		1	20A/	IP 37	7 →	++	(38	20A/1P	1	1		R	180	-		MANAGEI	R STATION	1
DRIVE THRU WIND.AIR CURTAIN		960		К		1	20A/	IP 39	1+			20A/1P		1.		R.		180		MANAGE	R STATION .	1. 4
AIR CURTAIN			1200	К		1		IP 41		-	42			ightharpoons	Image: Control of the contr		$\overline{\Box}$					Ψ.
SUB TOTALS	6820	3760	6240									•					2326	2496	2262		SUB TOTALS	1
CONN. PHASE TOTAL: A9146 CONN. PANEL TOTAL23904 L.C.L & L.M13004		√A);	6256 1625	C .	85 (VA)	02	;										L	OAD C	ODE	K L	KITCHEN LONG CONT. LOAD/ LARGEST MOTOR	
KIT. EQUIP 4020 REC. <=10KVA 3960 REC. REMAINDER 0 OTHERS LOAD 2920	- - _ x0.5	_	4020 3960 0 2920)	(VA)	(K (1S	=> 6 @ Γ 10 KV/)%)											O R	OTHERS RECEPTACLE	
TOTAL DEMAND LOAD	_ ^!	_	2715				75A	MDC.														1

BUS AMPS <u>225A</u> MAIN BREAKER □ LUGS ONLY	AMP	•															BOT	FEED TOM I ARKS	FEED	
DESCRIPTION	VOI	_T—Al	MPS	LOAD	OUTL			C	Bl	JS	C	C	οι	JTLE	TS	LOAD	VOL	T-AN	1PS	DESCRIPTION
	Α	В	С	CODE	LR	М	В	Т	ΑE	3 0) T	l B	L	R	М	CODE	Α	В	С	
CARBONATOR	713			K	1		20A/2F		•	Н	- 2	20A/3P			1	K	955			EF-1
-		713		K			_	3	<u> </u> +•	₩	- 4					K		955		_
ICE / SODA DISPENSER			575	K	1		20A/2F		╁┼	┝	- 6					K			955	
_	575			K			_	7] -	Н		20A/1P			1	K	500			HOOD CONTROL PANEL
COMBINATION FREEZER		1610		K	1		30A/2F	9]+•	┝┤	- 10	20A/1P		1				401		BROILER
-			1610	K			-	11]+	┝	- 12	2								SPACE FOR SHUNT TRIP BREA
COMBINATION FREEZER	1725			K	1		20A/2F	13]+	Н	- 14	20A/1P		1		K	1150			4-BANK FRYER
_		1725		K			_	15		₩	- 16	i –								SPACE FOR SHUNT TRIP BREA
FROZEN BEVERAGE			2100	K		1	30A/3F	17]+	┝		20A/1P		1		K			1403	MEAT FREEZER/HOLDING FREE
_	2100			K			-	19]-∳	Н	- 20									SPACE FOR SHUNT TRIP BREA
_		2100		K			-	21]₩	₩	- 22	30A/3P			1	K		2300		MINI-COMBI OVEN
ICE MACHINE			1277	K	1		20A/2F	23	1—	┝	- 24	-				К			2300	_
_	1277			K			T -	25	1-∳	Н	- 26	6 -				K	2300			-
TEA COFFEE BREWER		1610		K	1		20A/1P	27	1₩	₩	- 28	3								SPACE FOR SHUNT TRIP BREA
41" EXPEDITER STATION STD.			1840	K	1		20A/1P	29	1—	┝	- 30	30A/2P			1	K			1840	FRYER STATION
FILTER SYSTEM	180			K	1		20A/1P	31	1+	Н	- 32					K	1840			-
WATER HEATER CONTROL		100		К	1		20A/1P	33	1₩	₩	- 34	20A/2P		1		К		1035		MULTI PRODUCT HOLDING UNIT
SLICER			450	К	1		20A/1P	35	1—	┝	- 36	-				К			1035	_
								37	1 →	Н	- 38	3								
								39	1₩	₩	- 40									
								41	1+	┝	- 42	2								
SUB TOTALS	6570	7858	7852			•	•	•				•					6745	4691	7533	SUB TOTAL
CONN. PHASE TOTAL: A 13	315 _E	1	2549	c	1538	35	_;													
CONN. PANEL TOTAL 412 L.C.L & L.M. 0		VA);	0		_ (VA)												L	OAD C	ODE	K KITCHEN L LONG CONT. LOAD, LARGEST MOTOR
KIT. EQUIP 40848 REC. <=10KVA 0 REC. REMAINDER 0	— — — x0.5	_	2655 0 0	01			> 6 @ 6 10 KVA		%)											O OTHERS R RECEPTACLE

VOLTAGE 120/208 BUS AMPS 225A MAIN BREAKER □ LUGS ONLY	3ø, AMP	4W.						PA	NEL	<u>"C</u>	n 							TOP BOT	FEED TOM		
DESCRIPTION	VOI	_T—A	MPS	LOAD	OU.	TLE	TS	С	C	ВІ	JS	C	С	Οι	JTLE		LOAD		T-A	/IPS	DESCRIPTION
	Α	В	С	CODE	L	R	М	В	Т	Α) T	l B	L	R	М	CODE	Α	В	С	
OHU / MICROWAVE	1760			K		1		30A/2P	_	•	Н	_	20A/2P			1	K	1242			W.I. FREEZER EVAPORATOR
_		1760		K				_	3	+	┡┤	- 4					K		1242		_
OHU / MICROWAVE			1760			1		30A/2P		+	╁		20A/1P			1	K			650	
_	1760			K				_	7	•	H		20A/1P		1		K	690			BEVERAGE REF.
VERTICAL TOASTER		1817		K				30A/2P	_	十	┥┤	_	20A/1P	_	1		K		840		REACH-IN FREEZER
_			1817	K		1		_	11	+	╁		20A/2P		1		K			1553	MUTI-HOLDING UNIT
VERTICAL TOASTER	1817			K		1		30A/2P		 + -	Н	- 14					K	1553			_
-		1817		K					15]+	┿┤		20A/1P		1		K		1200		SANDWISH STATION
HOLDING FREEZER			529	K		1		20A/1P	17]+	┝	- 18	20A/2P		1		Κ			1553	MUTI-HOLDING UNIT
REF. BATTER STATION	345			K		1		20A/1P	19	 + -	Н	- 20	-				Κ	1553			_
W.I. COOLER LTG. CONTROL		530		K			1	20A/1P	21]+	┥┤	- 22	20A/1P		1		Κ		759		UNDER COUNTER REF.
W.I. CONDEN'G UNIT			679	К			1	20A/2P	23	1+	┝		- 20A/2P		1		Κ			1311	EGG COOKER
_	679			K				_	25	 →	Н	- 20	5 -				K	1311			_
W.I. FREEZER CONDEN'G UNIT		1001		K			1	20A/3P	27	1+	┥┤	- 28	20A/1P		1		R		180		DISPOSAL CADDY SYSTEM
_			1001	К					29	1+	┝	- 30									
_	1001			К				-	31	-	Н	- 32	:								
									33	14	┥┤	- 3									
									35	14	┝	- 36									
									37	-	Н	- 38									
									39	14	┥┤	- 40									
									41	14	╽	- 42									
SUB TOTALS	7362	6925	5786					!						_				6349	4221	5067	SUB TOTAL
CONN. PHASE TOTAL: A 137					10	853															
CONN. PANEL TOTAL 3571	0 (x1.25 x0.5	VA); 5 <u> </u>	0 2309 180 0	5	_ (VA _ (VA)) (k) (1	(=)	; > 6 @ 6: 10 KVA		%)								L	OAD C	CODE	K KITCHEN L LONG CONT. LOAD, LARGEST MOTOR O OTHERS R RECEPTACLE

ENGINEER: JS ENGINEERING, INC. 410 S. SAN GABRIEL BLVD., SUITE 8, SAN GABRIEL, CA 91776 PHONE: 626.497.0558 EMAIL: INFO@CAL-PACIFIC.NET

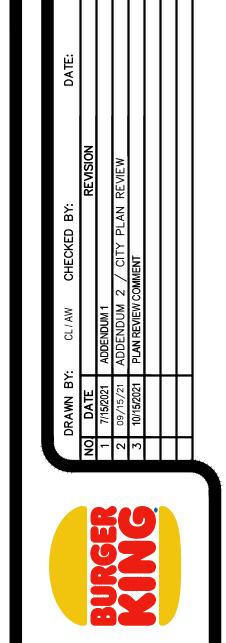

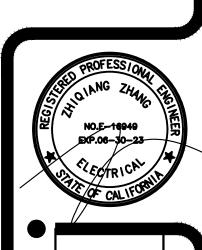

BURGER

E-0.4

"MORNING ARRIVAL"

STEP 1

TURN THE KITCHEN UNOCCUPIED-OCCUPIED SWITCH TO THE THE OCCUPIED POSITION. THE KITCHENS AIR CONDITIONING SYSTEM WILL GO FROM NIGHT SETBACK MODE TO THE THERMOSTAT SET POINT.

NOTE: THE AIR CONDITIONING FAN WILL START AND RUN CONTINUOUSLY. EXHAUST FAN WILL NOT RUN UNTIL THIS SWITCH IS IN THE OCCUPIED POSITION.

STEP 2

TURN ON THE EXHAUST FAN SWITCH TO THE ON POSITION THIS WILL ALLOW YOU TO TURN ON THE FRYERS AND BROILER.

"RESTAURANT OPEN FOR **BUSINESS**"

STEP 1

TURN THE DINING UNOCCUPIED-OCCUPIED SWITCH TO THE THE OCCUPIED POSITION. THE DINING AIR CONDITIONING SYSTEM WILL GO FROM NIGHT SETBACK MODE TO THE THERMOSTAT SET POINT.

STEP 2

TURN THE SIGN AND PARKING LOT LIGHTING SWITCHES TO THE AUTO POSITION, THIS WILL ENGAGE THE LIGHTING PHOTOCELLS SO THAT THE LIGHTS WILL AUTOMATICALLY COME ON AFTER DARK. TURN THE SWITCH TO THE ON POSITION TO OVER RIDE THE PHOTOCELLS AT ANY TIME THE LIGHTING MUST REMAIN ON.

"RESTAURANT CLOSE FOR **BUSINESS**"

STEP 1

TURN THE DINING UNOCCUPIED-OCCUPIED SWITCH TO THE UNOCCUPIED POSITION. THE DINING AIR CONDITIONING SYSTEM WILL GO FROM THE THERMOSTAT SET POINT TO THE NIGHT SET BACK MODE.

TURN THE SIGN AND PARKING LOT LIGHTING SWITCHES TO THE OFF POSITION, THIS WILL DISENGAGE THE LIGHTING PHOTOCELLS.

STEP 3

TURN THE EXHAUST FAN SWITCH TO THE OFF POSITION THE BROILERS EXHAUST FAN WILL CONTINUE TO RUN FOR 15 MINUTES FOR A COOL DOWN CYCLE, AND THEN SHUT OFF

NOTE: THE FRYERS AND BROILER SHOULD BE TURNED OFF AND ALLOWED TO COOL DOWN BEFORE TURNING THE HOOD OFF. TO PREVENT ACCIDENTAL ANSUL DISCHARGE. THE BROILERS HOOD WILL ALWAYS RUN 15 MINUTES AFTER THE EXHAUST FAN SWITCH IS TURNED TO THE

"EMPLOYEES LEAVING THE <u>BUILDING"</u>

WHEN READY TO EXIT THE BUILDING PUSH THE SECURITY DEPARTURES SWITCH. THE PARKING LOT LIGHTS WILL COME BACK ON FOR 15 MINUTES THEN SHUT OFF AUTOMATICALLY.

"MANAGER/LAST PERSON LEAVING THE BUILDING'

STEP 1

TURN THE KITCHEN UNOCCUPIED-OCCUPIED SWITCH TO THE UNOCCUPIED POSITION. THE KITCHENS AIR CONDITIONING SYSTEM WILL GO FROM THE THERMOSTAT SET POINT TO THE NIGHT SET BACK MODE.

STEP 2

WHEN READY TO EXIT THE BUILDING PUSH THE SECURITY DEPARTURE SWITCH. THE PARKING LOT LIGHTS WILL COME BACK ON FOR 15 MINUTES THEN SHUT OFF AUTOMATICALLY.

"HOOD VENTILATION SYSTEM


WHEN THE HOOD EXHAUST FAN CURRENT SENSOR DETECTS A DROP IN AMPERAGE (SUCH AS A BELT BREAKING) IT WILL DISABLE THE LINE VOLTAGE TO THE EXHAUST FAN(S), FRYER AND BROILER APPLIANCES. THE EXHAUST FAN SWITCH SHOULD BE PLACED IN THE OFF POSITION AND THE FAN SHOULD BE CHECKED AND/OR REPAIRED BEFORE TURNING THE SWITCH TO THE ON POSITION.


"PARKING LOT LIGHTING NOTE"

WHEN THE PARKING LOT LIGHTS ARE TURNED OFF, THEY MUST COOL DOWN FOR ABOUT 10

MINUTES BEFORE THEY WILL COME BACK ON. *NOTE: IF IT IS NECESSARY TO ADJUST THE AMPERAGE OF THE BROILER EXHAUST HOOD FAN MOTOR, THE FAN MOTOR CURRENT SENSOR MUST BE RESET AS FOLLOWS:

ADJUST UNDERCURRENT POTENTIOMETER TO MAXIMUM (CLOCKWISE IS MAXIMUM.) APPLY CURRENT. ONCE CURRENT IS STABILIZED, DECREASE UNDERCURRENT POT UNTIL RED LIGHT TURNS OFF. WITHIN SEVEN SECONDS TURN UP UNTIL RED LIGHT TURNS ON. IF A LIGHT REMAINS OFF FOR MORE THEN TEN SECONDS, DISCONNECT SUPPLY VOLTAGE TO RESET. SEE INSTALLATION INSTRUCTIONS PN MRP COVER.

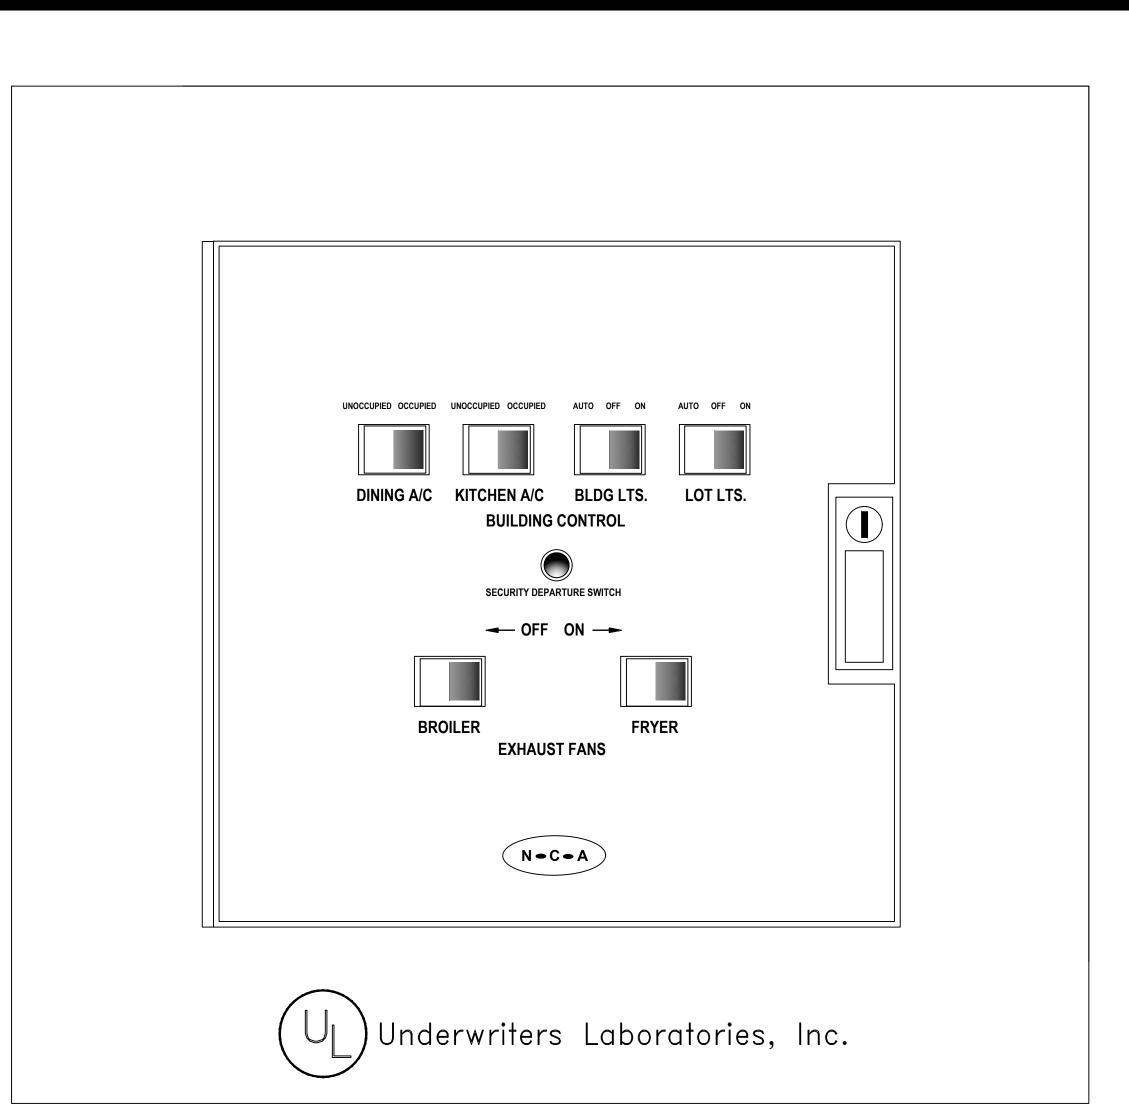

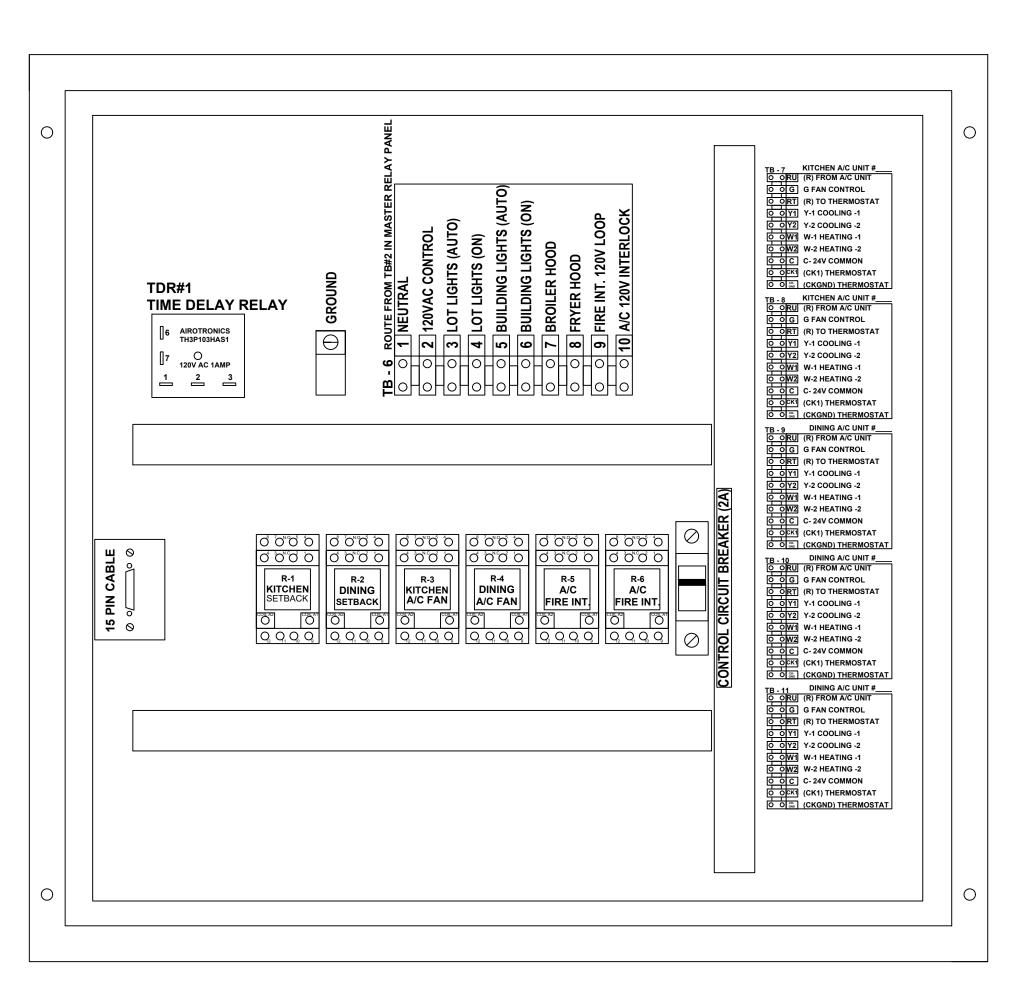

SEQUENCE OF OPERATION

MANUAL CONTROL SYSTEM

THE A/C UNITS UNOCCUPIED-OCCUPIED SWITCH IS USED TO: TURN THE STORE ON IN THE MORNING AND OFF IN THE EVENING. WHEN A/C UNIT UNOCCUPIED-OCCUPIED SWITCH IS TURNED TO THE ON POSITION:

THE AIR CONDITIONING SYSTEM WILL GO FROM NIGHT MODE TO SYSTEM ON.

THE OUTDOOR DAMPERS WILL OPEN TO A PRESET POSITION. (OPTIONAL)

THE AIR CONDITIONING FANS WILL START AND RUN CONTINUOUSLY.

DAMPERS WILL NOT OPEN DURING NIGHT SET BACK MODE. (OPTIONAL) THE AIR CONDITIONERS WILL BEGIN TO COOL OR HEAT AT THE OCCUPIED TEMPERATURE SETPOINT.

THE COOKING EQUIPMENT AND EXHAUST FANS CAN NOW BE TURNED ON WHEN NEEDED.

WHEN A/C UNOCCUPIED-OCCUPIED SWITCH IS TURNED TO THE OFF POSITION: EXHAUST FANS, SUPPLY FANS, AND EVAPORATOR BLOWERS WILL SHUT DOWN.

THE HEATING AND COOLING OPERATION SHALL REVERT TO SYSTEM NIGHT SET BACK MODE.

THE COOKING EQUIPMENT SHALL BE DISABLED.

THE SIGNAGE LIGHTING & LOT LIGHTING SHALL BE DISABLED IF SWITCHES ARE IN THE OFF POSITION.

THE PARKING LOT POLE LIGHTS & SECURITY LIGHTS SHALL REMAIN ON FOR 15 MIN AFTER THE SECURITY DEPARTURE SWITCH IS ACTIVATED.

WHEN THE HOOD EXHAUST FAN CURRENT SENSOR DETECTS A DROP IN AMPERAGE IT WILL DISABLE THE LINE VOLTAGE TO THE FRYER AND BROILER APPLIANCES.

HOOD VENTILATION SYSTEM

IF THE HOOD VENTILATION SWITCH IS IN THE OPEN POSITION, THE HOOD VENTILATION SYSTEM CAN BE STARTED.

THE BROILER SYSTEM AND THE FRYER SYSTEM SHALL BE STARTED BY MOVING THE ON/OFF SWITCH TO THE ON POSITION. IF EITHER THE BROILER OR FRYER SWITCH IS IN THE ON POSITION, THE MAKE-UP AIR UNIT (IF APPLICABLE) SHALL START AUTOMATICALLY.

ACTIVATION OF THE HOOD FIRE SUPPRESSION SYSTEM SHALL DE-ENERGIZE THE MAKE UP AIR UNIT, ALL A/C UNITS, AND THE CONTROLLED COOKING EQUIPMENT. THE BROILER AND THE FRYER EXHAUST SYSTEM SHALL CONTINUE TO OPERATE. THE FIRE SUPPRESSION SYSTEM SHALL BE MANUALLY RESET.

EXTERIOR LIGHTING CONTROL

ALL OF THE EXTERIOR LIGHTING SHALL BE CONTROLLED, WITH THE EXCEPTION OF THE SECURITY LIGHTS WHICH SHALL BE OPERATED BY ITS OWN PHOTOCELL. SECURITY LIGHTING IS OPTIONAL.

THE SIGNAGE SELECTOR SWITCH (3-POS.) CONTROLS THE PRIME SIGN, ALL MARQUEE SIGNS, AND BUILDING ACCENT LIGHTING.


ON POSITION: LIGHTING SHALL BE ON PERMANENTLY.

OFF POSITION: LIGHTING SHALL BE OFF PERMANENTLY.

AUTO POSITION: LIGHTING SHALL BE CONTROLLED BY THE PHOTO CELL

THE LOT LIGHTS THREE POSITION SWITCH WORKS THE SAME AS THE SIGNAGE SWITCH.

NOTE: UNOCCUPIED-OCCUPIED / MASTER RELAY PANEL SHALL BE COMPLETE WHEN SHIPPED TO THE JOB SITE. NO INTERNAL WIRING SHALL BE REQUIRED. MAKE ALL EXTERNAL WIRING CONNECTIONS AS REQUIRED.

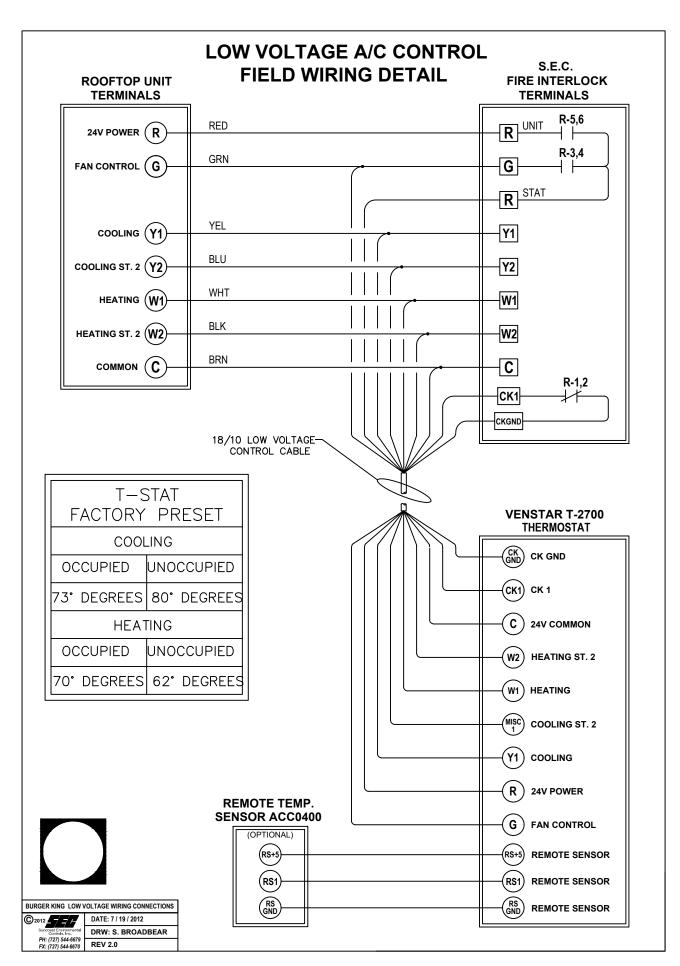



ELECTRICAL CONTRACTOR NOTES

- 1. RUN ONE (10) CONDUCTOR 18 GAUGE THERMOSTAT CABLE FROM THE ROOFTOP AIR CONDITIONING UNIT TO THE "UNOCCUPIED-OCCUPIED" PANEL.
- 2. RUN 0NE (10) CONDUCTOR 18 GAUGE THERMOSTAT CABLE FROM THE "UNOCCUPIED-OCCUPIED" PANEL TO THE THERMOSTAT LOCATION.
- 3 RUN ONE (10) CONDUCTOR 18 GAUGE THERMOSTAT CABLE FROM THE ROOFTOP AIR CONDITIONING UNIT TO THE NIGHT SETBACK THERMOSTAT LOCATION. IF NOT CONTROLLED WITH P-374-2700 T-STAT. REFER TO SHEET M-1
- - 4. TERMINATION OF ALL 24 VOLT AIR CONDITIONING CONTROL WIRING SHALL BE DONE BY THE MECHANICAL CONTRACTOR.
 - 5. ELECTRICAL CONTRACTOR SHALL RUN LINE VOLTAGE FROM THE CURRENT SENSOR LOCATED IN THE BROILER HOOD EXHAUST FAN TO THE CONTACTOR PANEL

LOCATED BY THE SWITCHGEAR.


HVAC SYSTEM CONSULTANTS / GROUP NATIONAL CORPORATE ACCOUNT SERVICES, INC. DRAWINGS SHOWN ARE FOR PROTOTYPICAL CONSIDERATIONS ONLY. SITE-SPECIFIC DESIGN IS REQUIRED BY BURGER KING CORPORATION. AS A COURTESY, NCA CONSULTANTS PROVIDES SITE-SPECIFIC DESIGN WITH SITE-SPECIFIC PROFESSIONAL ENGINEER SEAL UNDER AN AGREEMENT BETWEEN NCA CONSULTANTS AND BURGER KING CORPORATION. FOR SITE-SPECIFIC DESIGN, ARCHITECTS EMAIL REFLECTED CEILING PLAN, ELEVATIONS, KITCHEN PLANS, FLOOR PLAN, SITE PLAN, EXTERIOR ELEVATIONS, AND ROOF STRUCTURAL PLAN TO DESIGN@NCACONSULTANTS.COM TO CONTACT THE NCA CONSULTANTS BY PHONE, CALL TOLL-FREE (877) 530-0078. O 1 LOT POLE LIGHTS

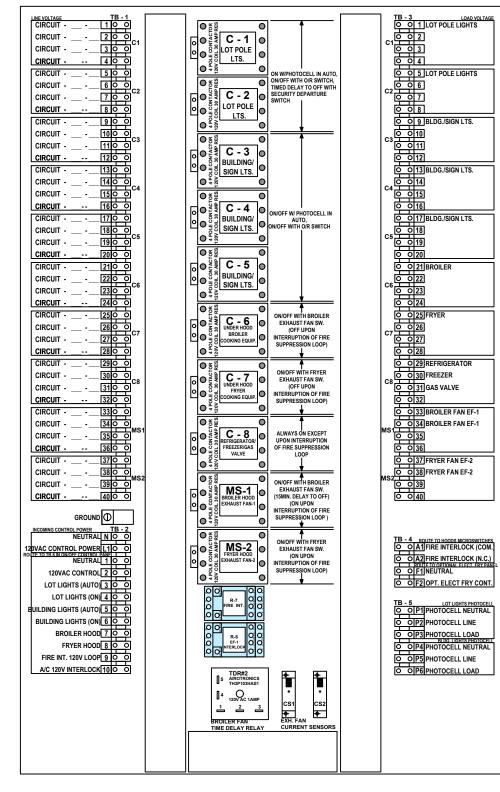

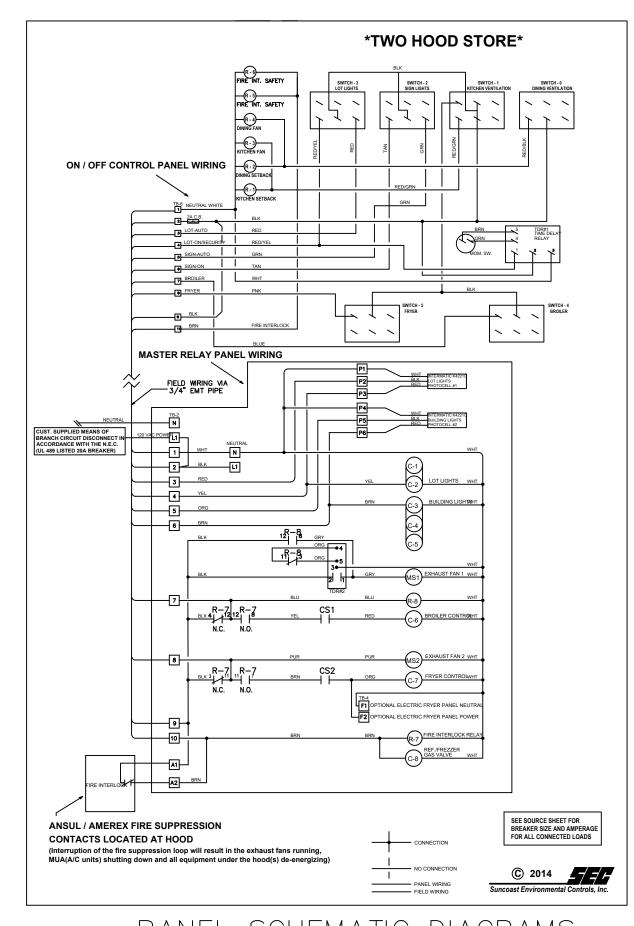


PANEL SCHEMATIC DIAGRAMS


Copyright 2019- Drawings, specifications, notes, database, computer files, field data, and reports as instruments of service prepared by the Design of Record. As instruments of services, these items remain the property of the Design of Record, who shall retain all statutory and other reserved rights, including the copyright thereto. Any use, reproduction or changes to these documents without written consent of NCA Consultants is a violation of federal copyright laws.

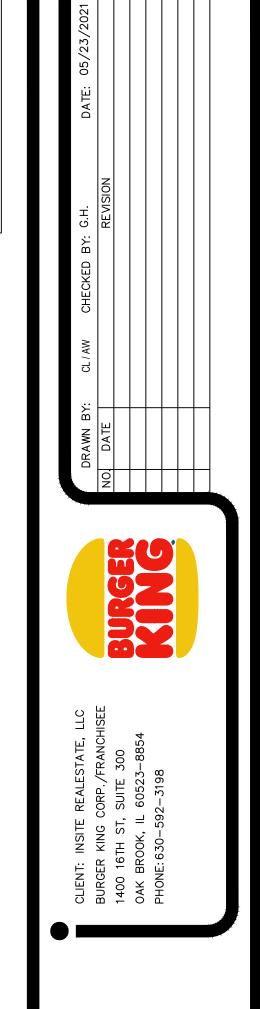



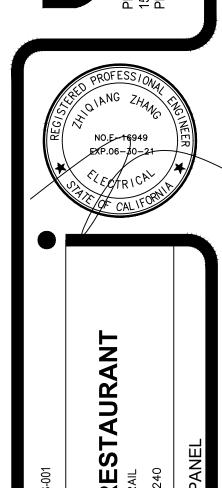

RES. KING URG $\mathbf{\Omega}$

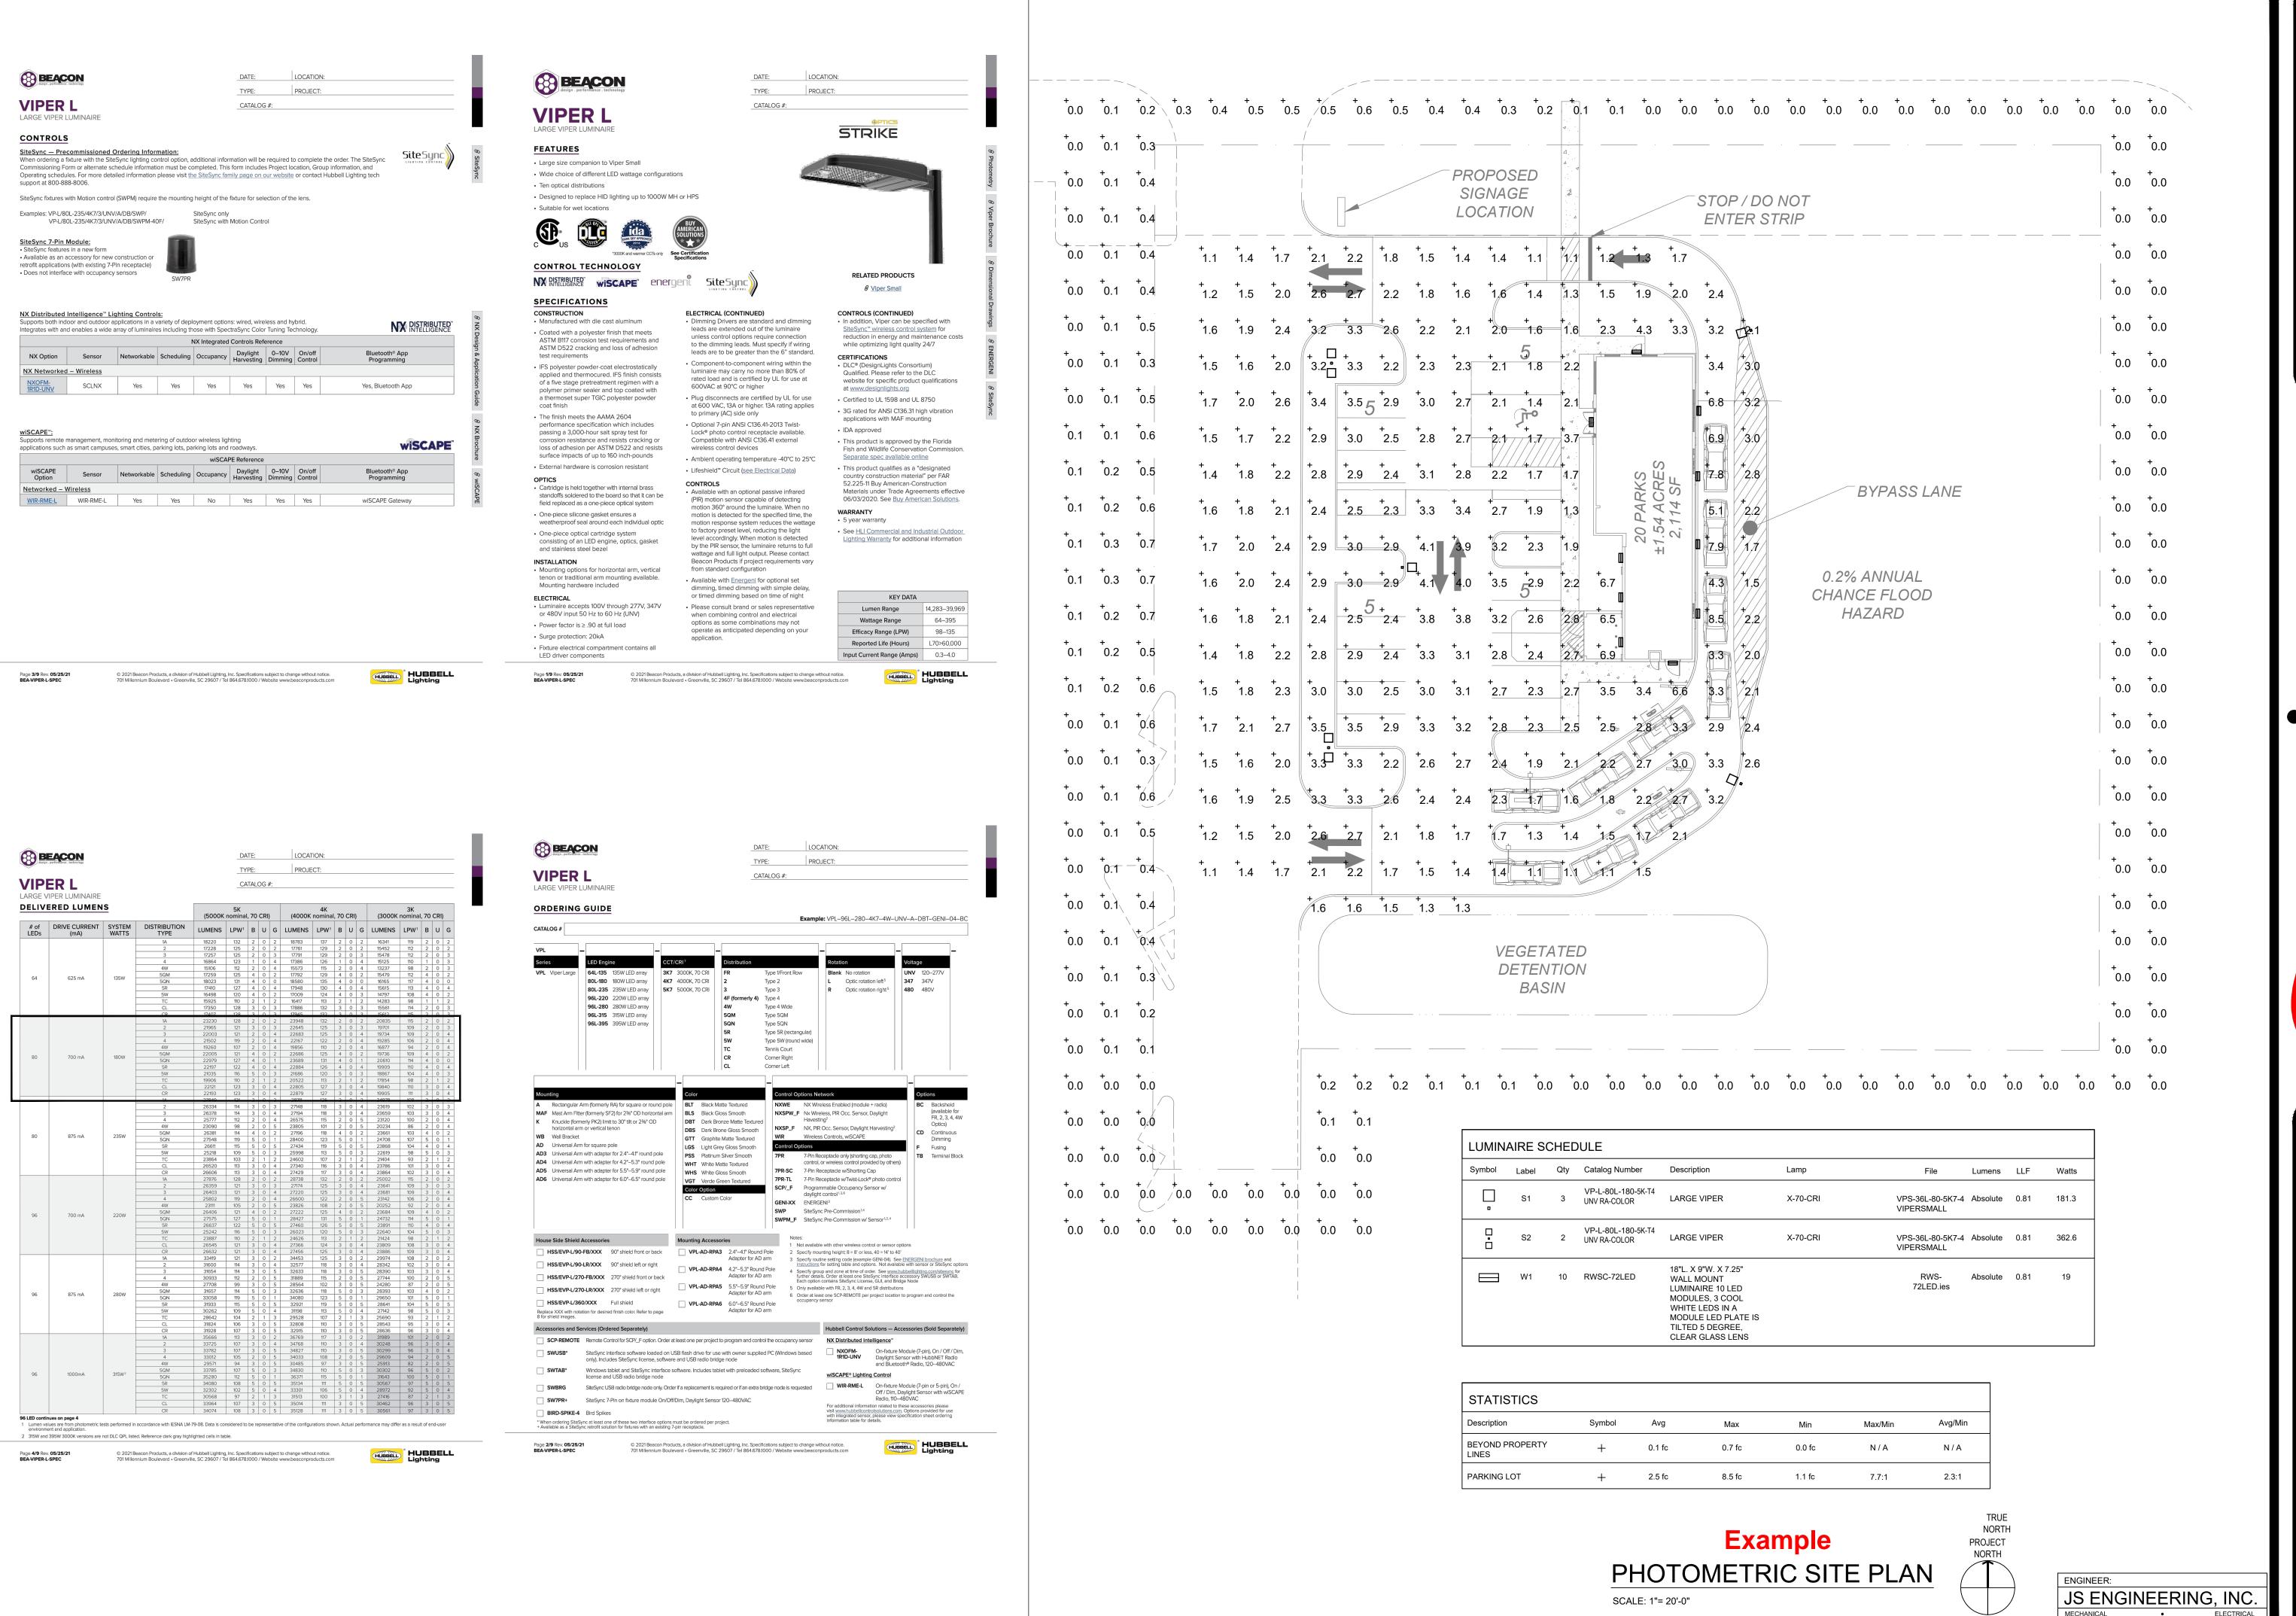


C:\Users\charl\OneDrive\2021 Project\DesignUA\Burger King\INS 001 Desert Hot Springs\CD\r2 base update\EFC Photometric Site Plan.dwg, 8/29/2021 4:16:11 PM, charl, AutoCAD PDF (General Documentation).pc3, CAL Arc1

410 S. SAN GABRIEL BLVD., SUITE 8, SAN GABRIEL, CA 91776
PHONE: 626.497.0558 EMAIL: INFO@CAL-PACIFIC.NET

الم الم

C

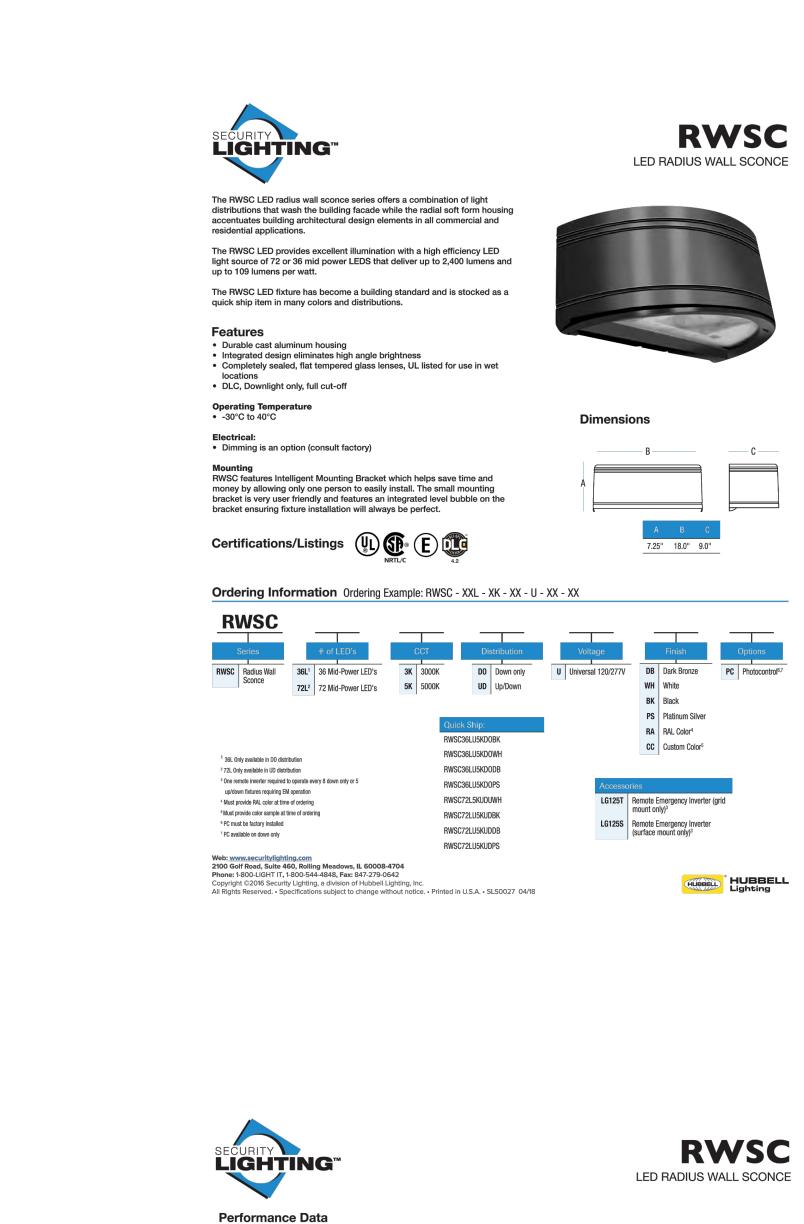




4 0 1 2 2.25 3 3.75 4


Web: www.securitylighting.com
2100 Golf Road, Suite 460, Rolling Meadows, IL 60008-4704
Phone: 1-800-LIGHT IT, 1-800-544-4848, Fax: 847-279-0642
Copyright ©2016 Security Lighting, a division of Hubbell Lighting, Inc.
All Rights Reserved. • Specifications subject to change without notice. • Printed in U.S.A. • SLS0027 04/18

ENGINEER: JS ENGINEERING, INC. MECHANICAL 410 S. SAN GABRIEL BLVD., SUITE 8, SAN GABRIEL, CA 91776 PHONE: 626.497.0558 EMAIL: INFO@CAL-PACIFIC.NET


HUBBELL Lighting

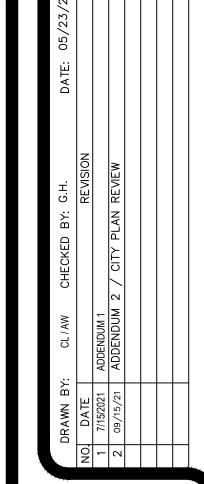



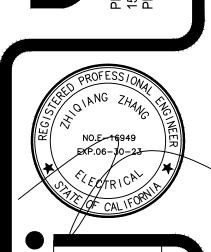

BURGER I 66745 TWO BUN

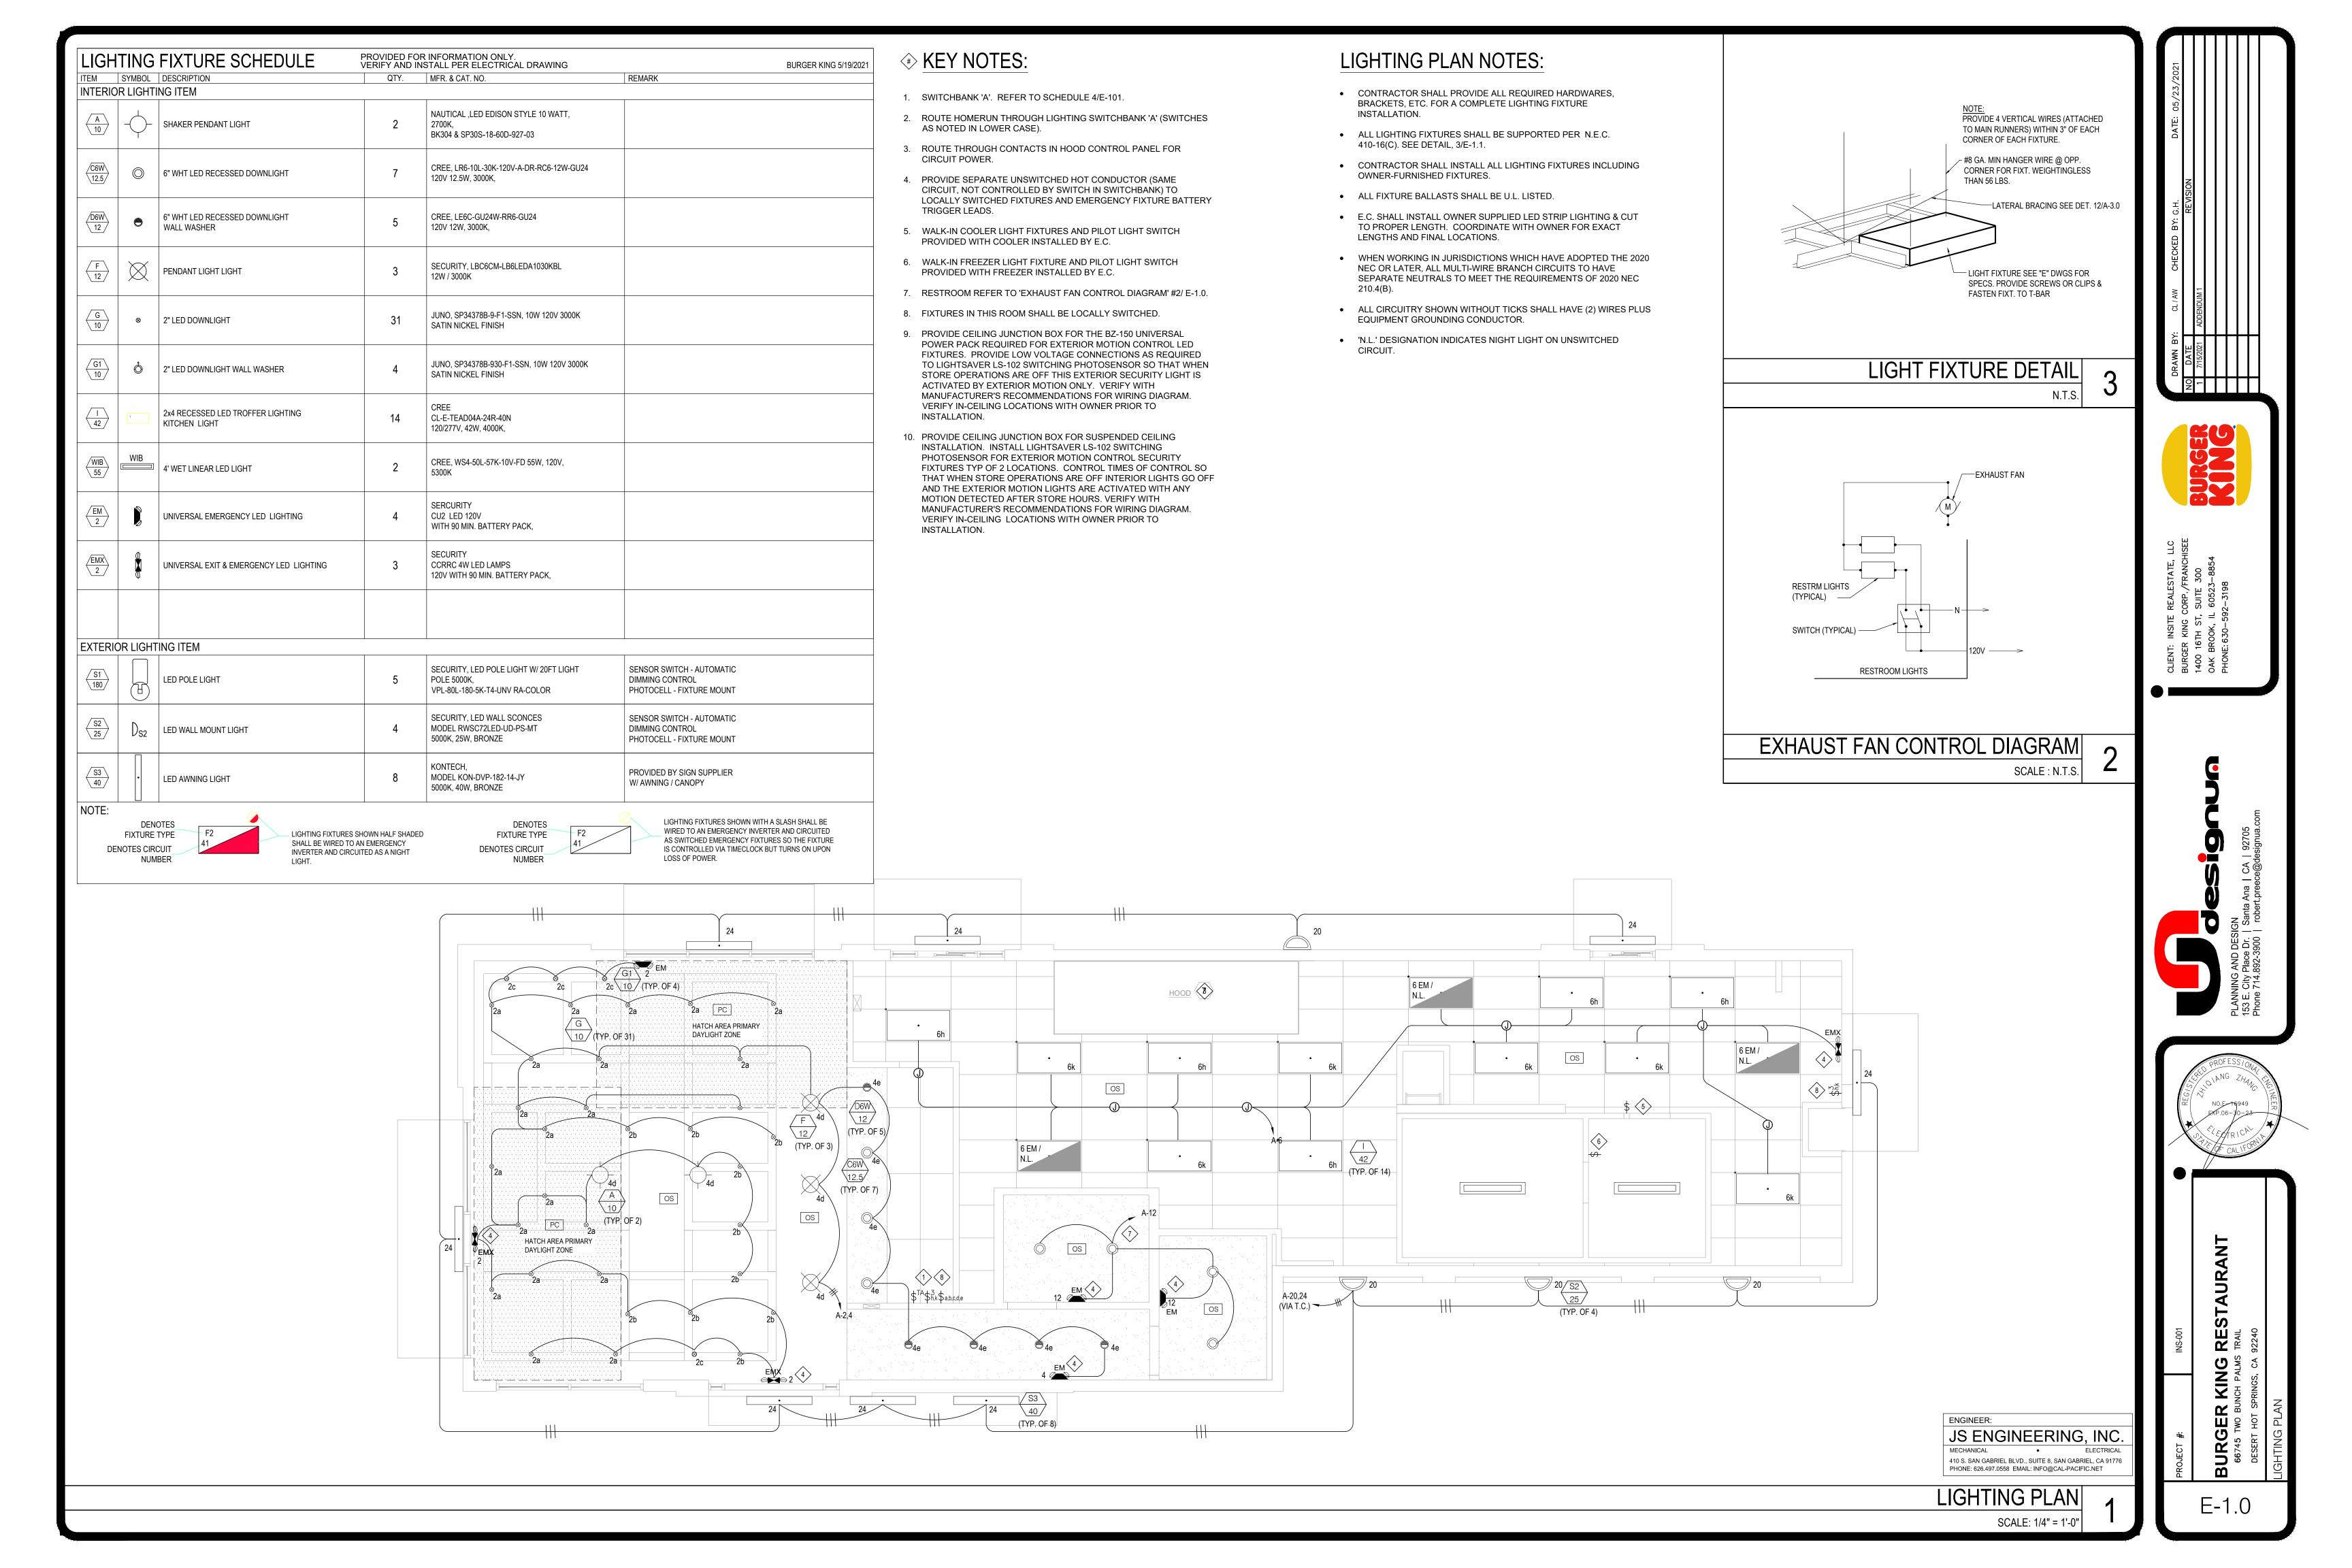

					ŀ	(ES ELI	ECTRIC	CAL SCHE	DULE				
ITEM#	TAG#	QTY	DESCRIPTION	VOLTS	PH	CYCLE	НР	BRKR SIZE	AMPS	ELEC CONN TYPE	PLUG TYPE	CONN RI HGHT	ELECTRICAL REMARKS
10.81	E1	2	CARBONATOR	120 V	1	60 Hz	1/3	20.00 A	6.20 A	PLUG & CORD	NEMA 5-20P	78"	ADDITIONAL ELECTRICAL OUTLETS TO BE PLACED 86" & 94" A.F.F. SEE DETAIL ON K4.0
11.03	E1	1	ICE/SODA DISPENSER	115 V	1	60 Hz	-	20.00 A	5.00 A	PLUG & CORD	NEMA 5-20P	48"	24VAC ELECTRICAL SYSTEM SUPPLIED USING 115V TRANSFORMER PROVIDED WITH DISPENSER
11.03	E2	1	ICE/SODA DISPENSER	115 V	1	60 Hz	-	20.00 A	5.00 A	PLUG & CORD	NEMA 5-20P	24"	24VAC ELECTRICAL SYSTEM SUPPLIED USING 115V TRANSFORMER PROVIDED WITH DISPENSER
15.11	E1	1	COMBINATION FREEZER	208 V	3	60 Hz	1	20.00 A	14.00 A	PLUG & CORD	REFER TO REMARKS	12"	E.C. TO SUPPLY & INSTALL 6FT. CORD & PLUG
15.11	E2	1	COMBINATION FREEZER	208 V	3	60 Hz	1 1/2	20.00 A	15.00 A	PLUG & CORD	REFER TO REMARKS	12"	E.C. TO SUPPLY & INSTALL 6FT. CORD & PLUG
15.69	E1	1	FROZEN BEVERAGE DISPENSER	208 V	1	60 Hz	1/4	30.00 A	30.00 A	PLUG & CORD	NEMA L6-30P	36"	BEATER: (3)1/6 HP FAN: 1/4 HP
16.09	E1	1	ICE MACHINE	208 V	1	60 Hz	-	15.00 A	11.10 A	DIRECT WIRED	DIRECT	84"	-
17.56	E1	1	INFUSION TEA COFFEE BREWER	120 V	1	60 Hz	-	20.00 A	14.00 A	PLUG & CORD	NEMA 5-15P	24"	-
20.37	E1	1	41" EXPEDITER STATION STD FLOW	120 V	1	60 Hz	-	20.00 A	16.00 A	PLUG & CORD	NEMA 5-20P	0"	CONNECTS INTO RECEPTACLE ON PREP MODULE "A" VIA 6' POWER CORD
21.66	E1	1	60" PREP MODULE "A" - (ABCD/ACBD)	208 V	3	60 Hz	-	0.00 A	1.08 A	DIRECT WIRED	DIRECT	0"	DOWN THRU SERVICE CHASE; E.C. TO CONNECT TO LOAD CENTER PROVIDED, AS REQ'D FOR 150A- 5 WIRE W/106A FEEDER. AMPERAGE LOAD FOR LOAD CENTER IN THIS CABINET TO BE CALCULATED FROM COMBINED LOADS OF EQUIPMENT ATTACHED TO THIS CABINET.
21.67	E1	1	28" BUN TOASTER MODULE "B"										CONNECTS TO LOAD CENTER ON PREP MODULE "A"
21.68	E1	1	32.5" PREP MODULE "C"										CONNECTS TO LOAD CENTER ON PREP MODULE "A"
21.69	E1	1	20" PREP MODULE "D"										CONNECTS TO LOAD CENTER ON PREP MODULE "A"
23.66	E1	1	180" CANOPY HOOD										E.C. TO CONNECT TO UTILITY CABINET'S ELECTRICAL SYSTEM ON HOOD F/ HOOD'S COMPONENTS & LIGHTS. REFER TO DETAIL SHEET K4.1 FOR INSTALLATION OF HOOD & COMPONENTS
23.71	E1	1	EXHAUST FAN	208 V	3	60 Hz	2	20.00 A	8.30 A	DIRECT WIRED	REFER TO REMARKS	12"	E.C. TO INTERCONNECT CIRCUIT W/ SAFETY INTERLOCK AT BUILDING'S MAIN BREAKER PANEL. CONNECTION HEIGHT @ 12" B.F.R.
24.26	E1	1	BROILER	120 V	1	60 Hz	-	20.00 A	3.50 A	PLUG & CORD	NEMA 5-20P	24"	-
25.11	E1	1	44" MEAT WELL FREEZER	120 V	1	60 Hz	-	20.00 A	7.60 A	PLUG & CORD	NEMA 5-15P	24"	-
30.04	E1	1	35" FRY STATION - ROC GEN 3.5 LH	208 V	1	60 Hz	_	20.00 A	16.00 A	PLUG & CORD	NEMA L14-20P	24"	-
31.32	E1	1	4-BANK FRYER	120 V	1	60 Hz	-	0.00 A	10.00 A	PLUG & CORD	NEMA 5-15P	24"	-
31.89	E1	1	PORTABLE FILTER	120 V	1	60 Hz	1/3	0.00 A	6.20 A	PLUG & CORD	NEMA 5-15P	12"	NOT SHOWN
32.52	E1	1	PRODUCT HOLDING FREEZER	120 V	1	60 Hz	_	20.00 A	4.60 A	PLUG & CORD	NEMA 5-15P	24"	-
32.58	E1	1	REFRIGERATED BATTER STATION	120 V	1	60 Hz	_	20.00 A	3.00 A	PLUG & CORD	NEMA 5-20P	0"	-
36.72	F1	1	MINI COMBI OVEN-STEAMER	208 V	3	60 Hz	_	30.00 A	20.00 A	PLUG & CORD	SEE RMKS	24"	E.C. TO SUPPLY & INSTALL CORD & PLUG
40.01	E1	1	WALK-IN COOLER/FREEZER BOX	120 V	1	60 Hz	_	20.00 A	1.00 A	DIRECT WIRED	DIRECT	0"	EC TO MAKE ALL CONNECTIONS AS REQD
40.22	E1	1	WALK-IN COOLER CONDENSING UNIT	208 V	1	60 Hz	3/4	20.00 A	5.90 A	DIRECT WIRED	DIRECT	0"	-
40.30	E1	<u> </u>	WALK-IN FREEZER CONDENSING UNIT	208 V	3	60 Hz	3	20.00 A	8.70 A	DIRECT WIRED	DIRECT	0"	_
40.36	E1	1	WALK-IN COOLER EVAPORATOR	115 V	1	60 Hz	-	20.00 A 20.00 A	0.80 A	DIRECT WIRED	DIRECT	0"	E.C. TO WIRE UNIT FROM ELECTRICAL KNOCKOUTS IN TOP OR BACK OF UNIT
40.41	E1	1	WALK-IN FREEZER EVAPORATOR	208 V	1	60 Hz	3	20.00 A	10.80 A	DIRECT WIRED	DIRECT	0"	E.C. TO WIRE UNIT FROM ELECTRICAL KNOCKOUTS IN TOP OR BACK OF UNIT
40.55	E1	1	BEVERAGE REFRIGERATOR	120 V	1	60 Hz	_	20.00 A	6.00 A	PLUG & CORD	NEMA 5-20P	0"	CONNECT TO RECEPTACLE IN EXPO 5
40.85	E1	1	REACH-IN FREEZER	120 V	1	60 Hz	1/2	20.00 A	7.80 A	PLUG & CORD	NEMA 5-20P	0"	PLUGS INTO RECEPTACLE AT MODULE "D"
50.01	E1	1	MICROWAVE OVEN	240 V	1	60 Hz	-	20.00 A	15.30 A	PLUG & CORD	NEMA 6-20P	0"	CONNECTS INTO RECEPTACLE ON PREP MODULE "A", 5' 6" POWER CORD
50.01	E1	1	MICROWAVE OVEN	240 V	1	60 Hz	-	20.00 A	15.30 A	PLUG & CORD	NEMA 6-20P	0"	CONNECTS INTO RECEPTACLE ON PREP MODULE "D", 5' 6" POWER CORD
51.39	E1	1	MULTI-PRODUCT HOLDING UNIT	208 V	1	60 Hz	-	20.00 A	9.00 A	PLUG & CORD	NEMA 6-15P	60"	-
51.43	E1	2	MULTI-PRODUCT HOLDING UNIT	208 V	1	60 Hz	_	20.00 A	13.50 A	PLUG & CORD	NEMA 6-15P	0"	CONNECTS INTO RECEPTACLES ON PREP MODULE A & C
53.56	E1	1	REACH-IN UNDERCOUNTER REFRIGERATOR - RH DOOR	115 V	1	60 Hz	1/5	20.00 A	6.60 A	PLUG & CORD	NEMA 5-15P	24"	-
55.02	E1	2	RAPID VERTICAL TOASTER	208 V	1	60 Hz	_	20.00 A	15.80 A	PLUG & CORD	NEMA L6-30P	0"	CONNECT INTO RECEPTACLE ON PREP MODULE "B"
59.51	E1		EGG COOKER	208 V	1	60 Hz	_	20.00 A	11.40 A	PLUG & CORD	NEMA L6-20P	0"	CONNECTS INTO RECEPTACLE ON PREP MODULE "D"
931.91	E1	1	SHORTENING DISPOSAL CADDY SYSTEM	0 V	0	60 Hz	-	0.00 A	0.00 A	-	-	0"	VERIFY AND REWORK ALL EXISTING UTILITIES AS REQUIRED

KEY NOTE: (#)

- 1. ALL CIRCUITRY/CONDUIT FOR DISPLAY CABINET TO BE ROUTED IN CASEWORK TO J-BOX IN WALL AND CONCEAL IN WALL.
- 2. J-BOX FOR SIGNAGE. COORDINATE LOCATION WITH ARCHITECT / OWNER / SIGN PACKAGE. SIGN DISCONNECT PROVIDED BY SIGN CONTRACTOR.
- 3. ROUTE HOMERUN THROUGH LIGHTING SWITCHBANK 'A' (SWITCH AS NOTED IN LOWER
- 4. CUBICLE ELECTRICAL & DATA RACEWAY BY FURNITURE VENDOR AND GENERAL CONTRACTOR TO COORDINATE J-BOX LOCATION.
- 5. CEILING MOUNT ELECTRICAL & DATA OUTLET.
- 6. SUB-PANEL TO COORDINATE ARCHITECT LOCATION PRIOR TO INSTALL.
- 7. G.C. (GENERAL CONSTRUCTOR) TO COORDINATE WITH OWNER TO PROVIDE NECESSARY ELECTRICAL POWER, DATA OUTLET READY FOR WORK TABLE AND CABINET INSTALLATION. FURNITURE BY OWNER.
- 8. ALL DEVICES UNDER HOOD TO BE PROVIDED AND INSTALLED WITH SHUNT TRIP CIRCUIT BREAKER AND WATERPROOFING BOX (RED DOT #CKSUV).

GFCI NOTE:

SECTION 210.8(B) PROVIDES GFCI PROTECTION REQUIREMENTS FOR SPECIFIC RECEPTACLES IN OTHER THAN DWELLINGS. OTHER LOCATIONS IN THE NEC PROVIDE ADDITIONAL REQUIREMENTS WHERE GFCI PROTECTION IS REQUIRED FOR RECEPTACLES AND SPECIFIC EQUIPMENT, WHETHER CORD AND PLUG CONNECTED OR DIRECTLY WIRED.

FOR MANY CODE CYCLES, 210.8(B) HAS PROVIDED GFCI REQUIREMENTS BUT ONLY WHEN DEALING WITH 125-VOLT, SINGLE-PHASE, 15- AND 20-AMPERE RECEPTACLES INSTALLED IN SPECIFIC LOCATIONS. NOW, THIS SECTION HAS BEEN REWORDED TO INCLUDE THE FOLLOWING:

- 1. ALL 50 AMPERES OR LESS, SINGLE-PHASE RECEPTACLES RATED 150 VOLTS TO GROUND OR LESS.
- 2. ALL 100 AMPERES OR LESS, THREE-PHASE RECEPTACLES RATED 150 VOLTS TO GROUND OR LESS.

IT'S ALWAYS IMPORTANT TO REMEMBER THAT GFCI PROTECTION CAN BE PROVIDED AT THE RECEPTACLE ITSELF OR AHEAD OF A RECEPTACLE BY USING GFCI TYPE CIRCUIT BREAKERS (IF AVAILABLE) TO PROTECT THE ENTIRE CIRCUIT.








BURGER 66745 TWO BUN


E-1.1

POWER PLAN SCALE: 1/4" = 1'-0

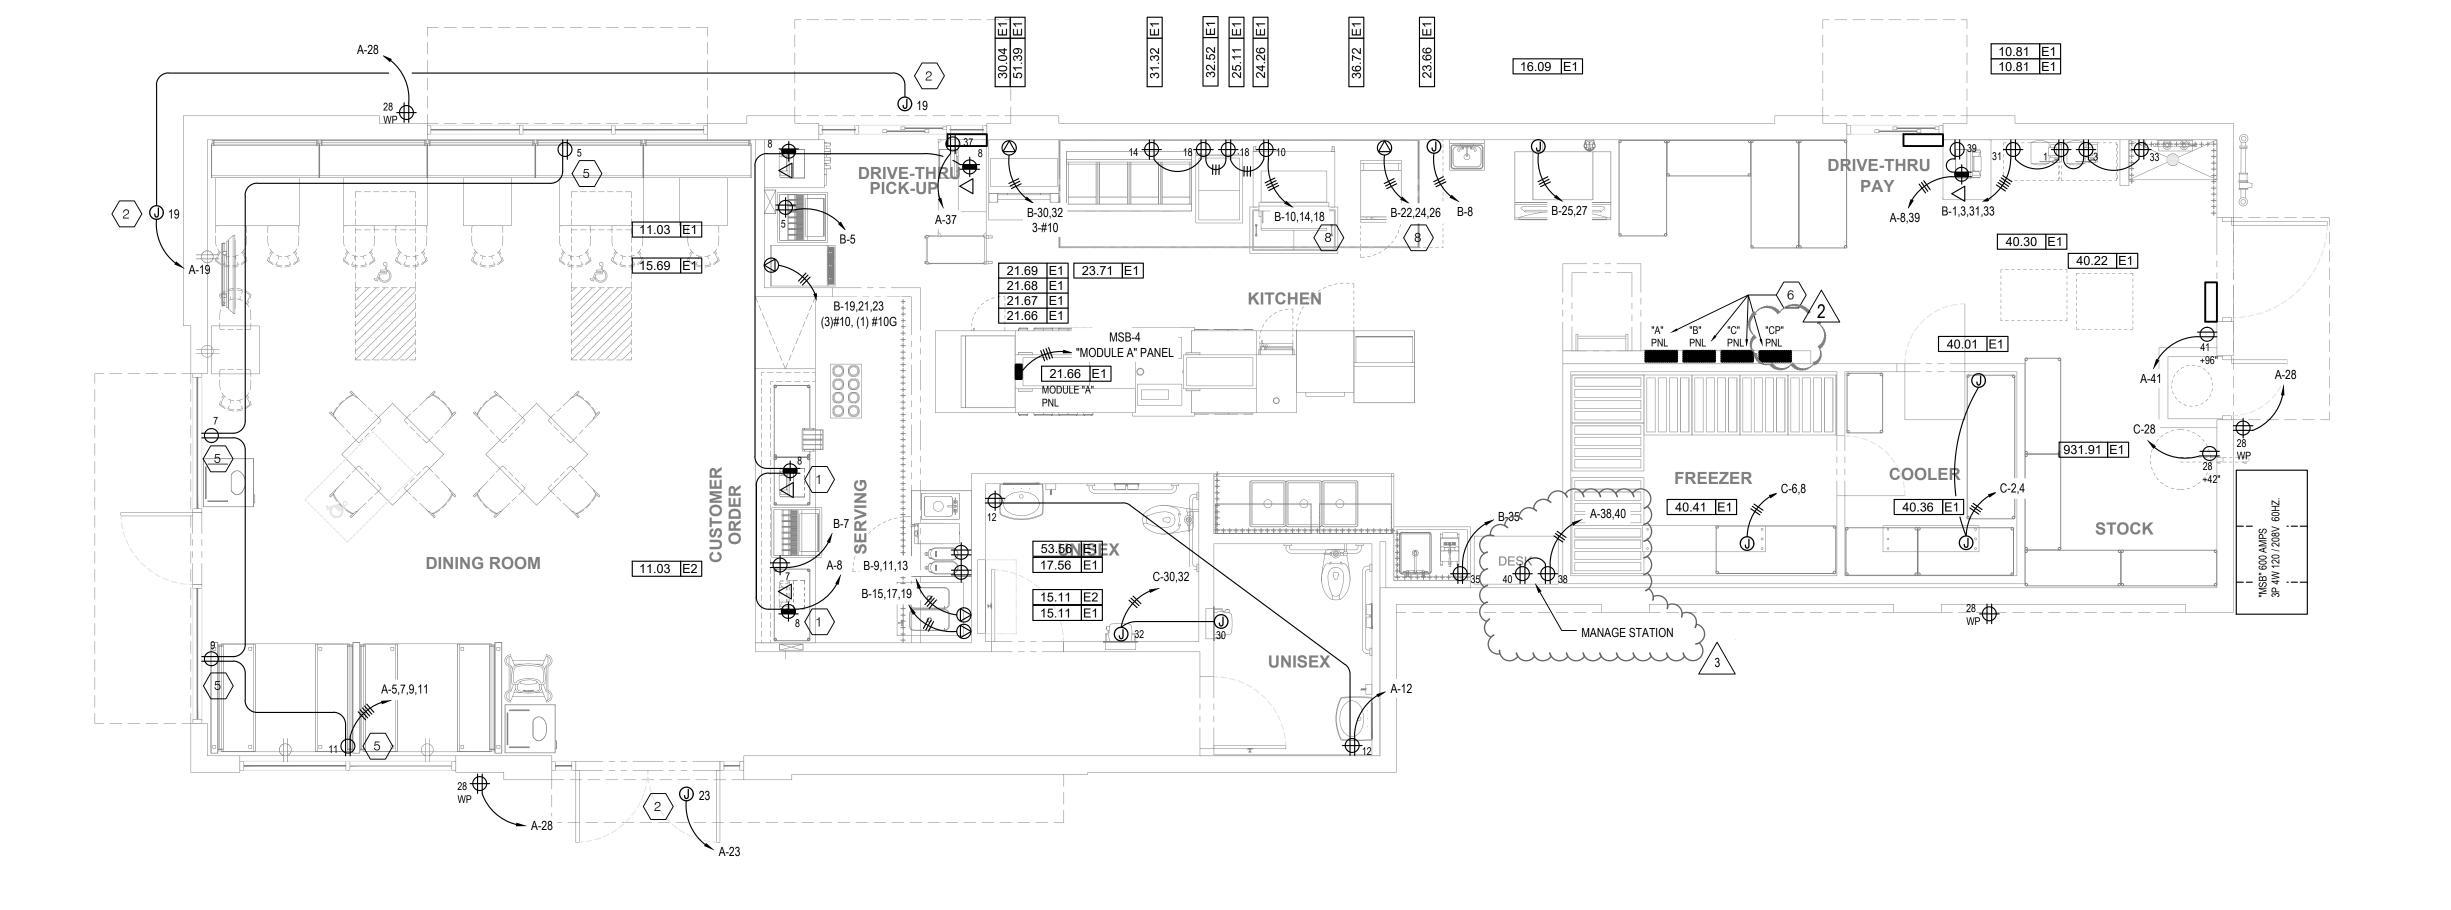

JS ENGINEERING, INC.

ENGINEER:

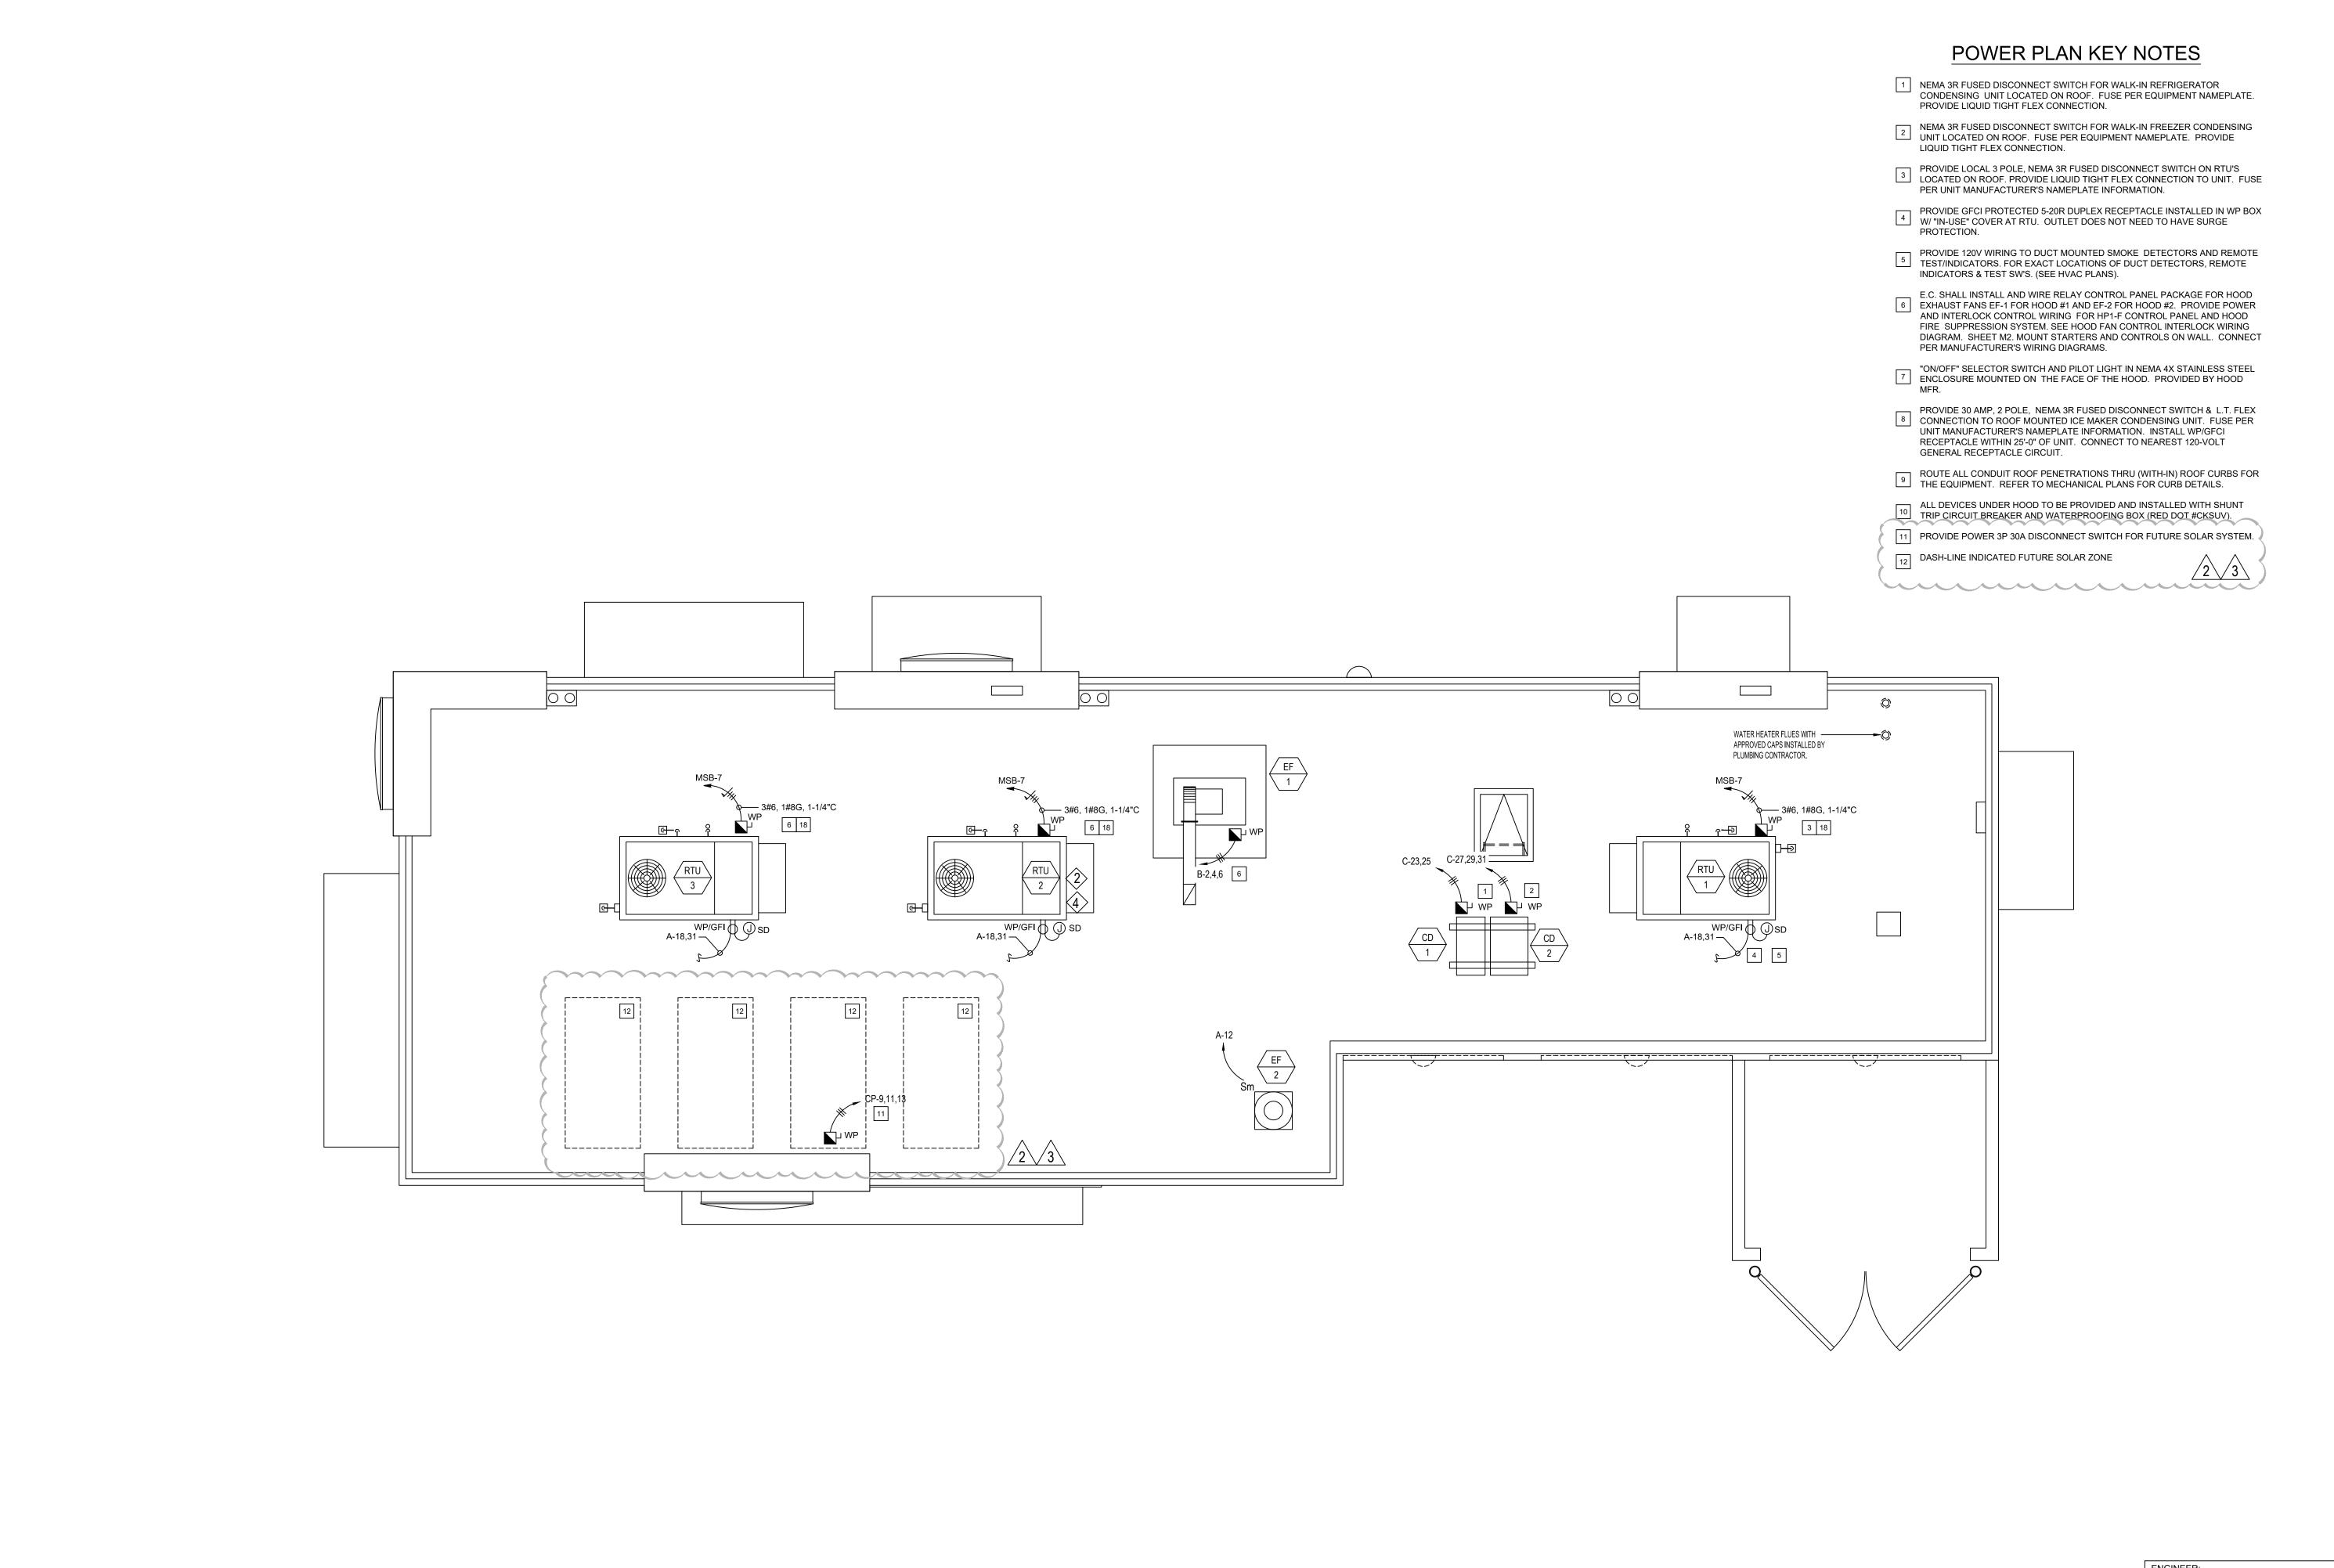

STATE, LLC FRANCHISEE 300

IENT: INSITE REALESTATE, LI RGER KING CORP./FRANCHIS 00 16TH ST, SUITE 300

PLANNING AND DESIGN 153 E. City Place Dr. | Santa Ana | CA | Phone 714.892-3900 | robert.preece@de

VG RESTAURANT

BURGER KING I 66745 TWO BUNCH PALMS


E-1

HVAC ROOF PLAN

JS ENGINEERING, INC.

410 S. SAN GABRIEL BLVD., SUITE 8, SAN GABRIEL, CA 91776 PHONE: 626.497.0558 EMAIL: INFO@CAL-PACIFIC.NET

SCALE: 1/4"= 1'-0"

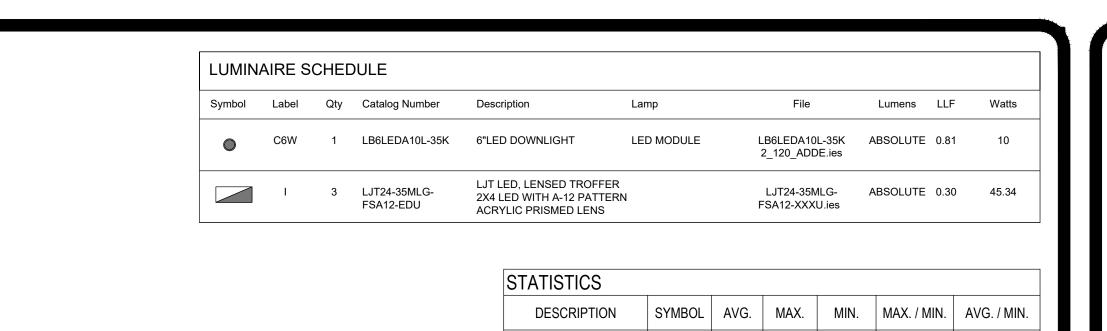

5.7 6.5 7.2 7.4 7.7 7.4 6.9 4.8 4.3 3.1 3.9 4.8 5.7 6.1 6.3 5.7

2.7 3.2 4.0 5.3 to EN

 0.9
 1.2
 1.9
 2.7
 3.5

 4.5
 3.98
 3.4
 2.7
 8 1.9
 2.1
 8 2.7
 2.4
 2.4
 3.3
 4.0
 5.3
 4.1
 3.3
 6.7
 7.3
 7.8
 7.8
 7.8
 5.8
 5.1
 3.0
 3.6
 2.4
 3.0
 3.6
 4.4

 4.6
 3.7
 3.2
 2.3
 3.9
 4.7
 5.5
 6.1
 5.5
 4.7
 3.9
 3.1
 2.3
 3.9
 4.7
 5.5
 6.1
 5.5
 4.7

5.2 4.3 3.4

[†]4.2 | [†]1.9 | [†]2.2 | [†]1.2 | [†]1.9 | [†]2.2 | [†]2.6 |

 to.9
 ti.2
 ti.6
 ti.9
 ti.2
 ti.6
 ti.8

\bar{\dagger}
\



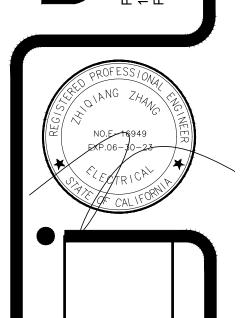

BURGER 66745 TWO BUN

†6.6 †6.7

*5.7 *5.6 *0.9

*4.8 * *4.7 *3.3


*3.9 *3.8 *2.2

*3.1 *2.9 *1.9

JS ENGINEERING, INC.

410 S. SAN GABRIEL BLVD., SUITE 8, SAN GABRIEL, CA 91776 PHONE: 626.497.0558 EMAIL: INFO@CAL-PACIFIC.NET

ENGINEER:

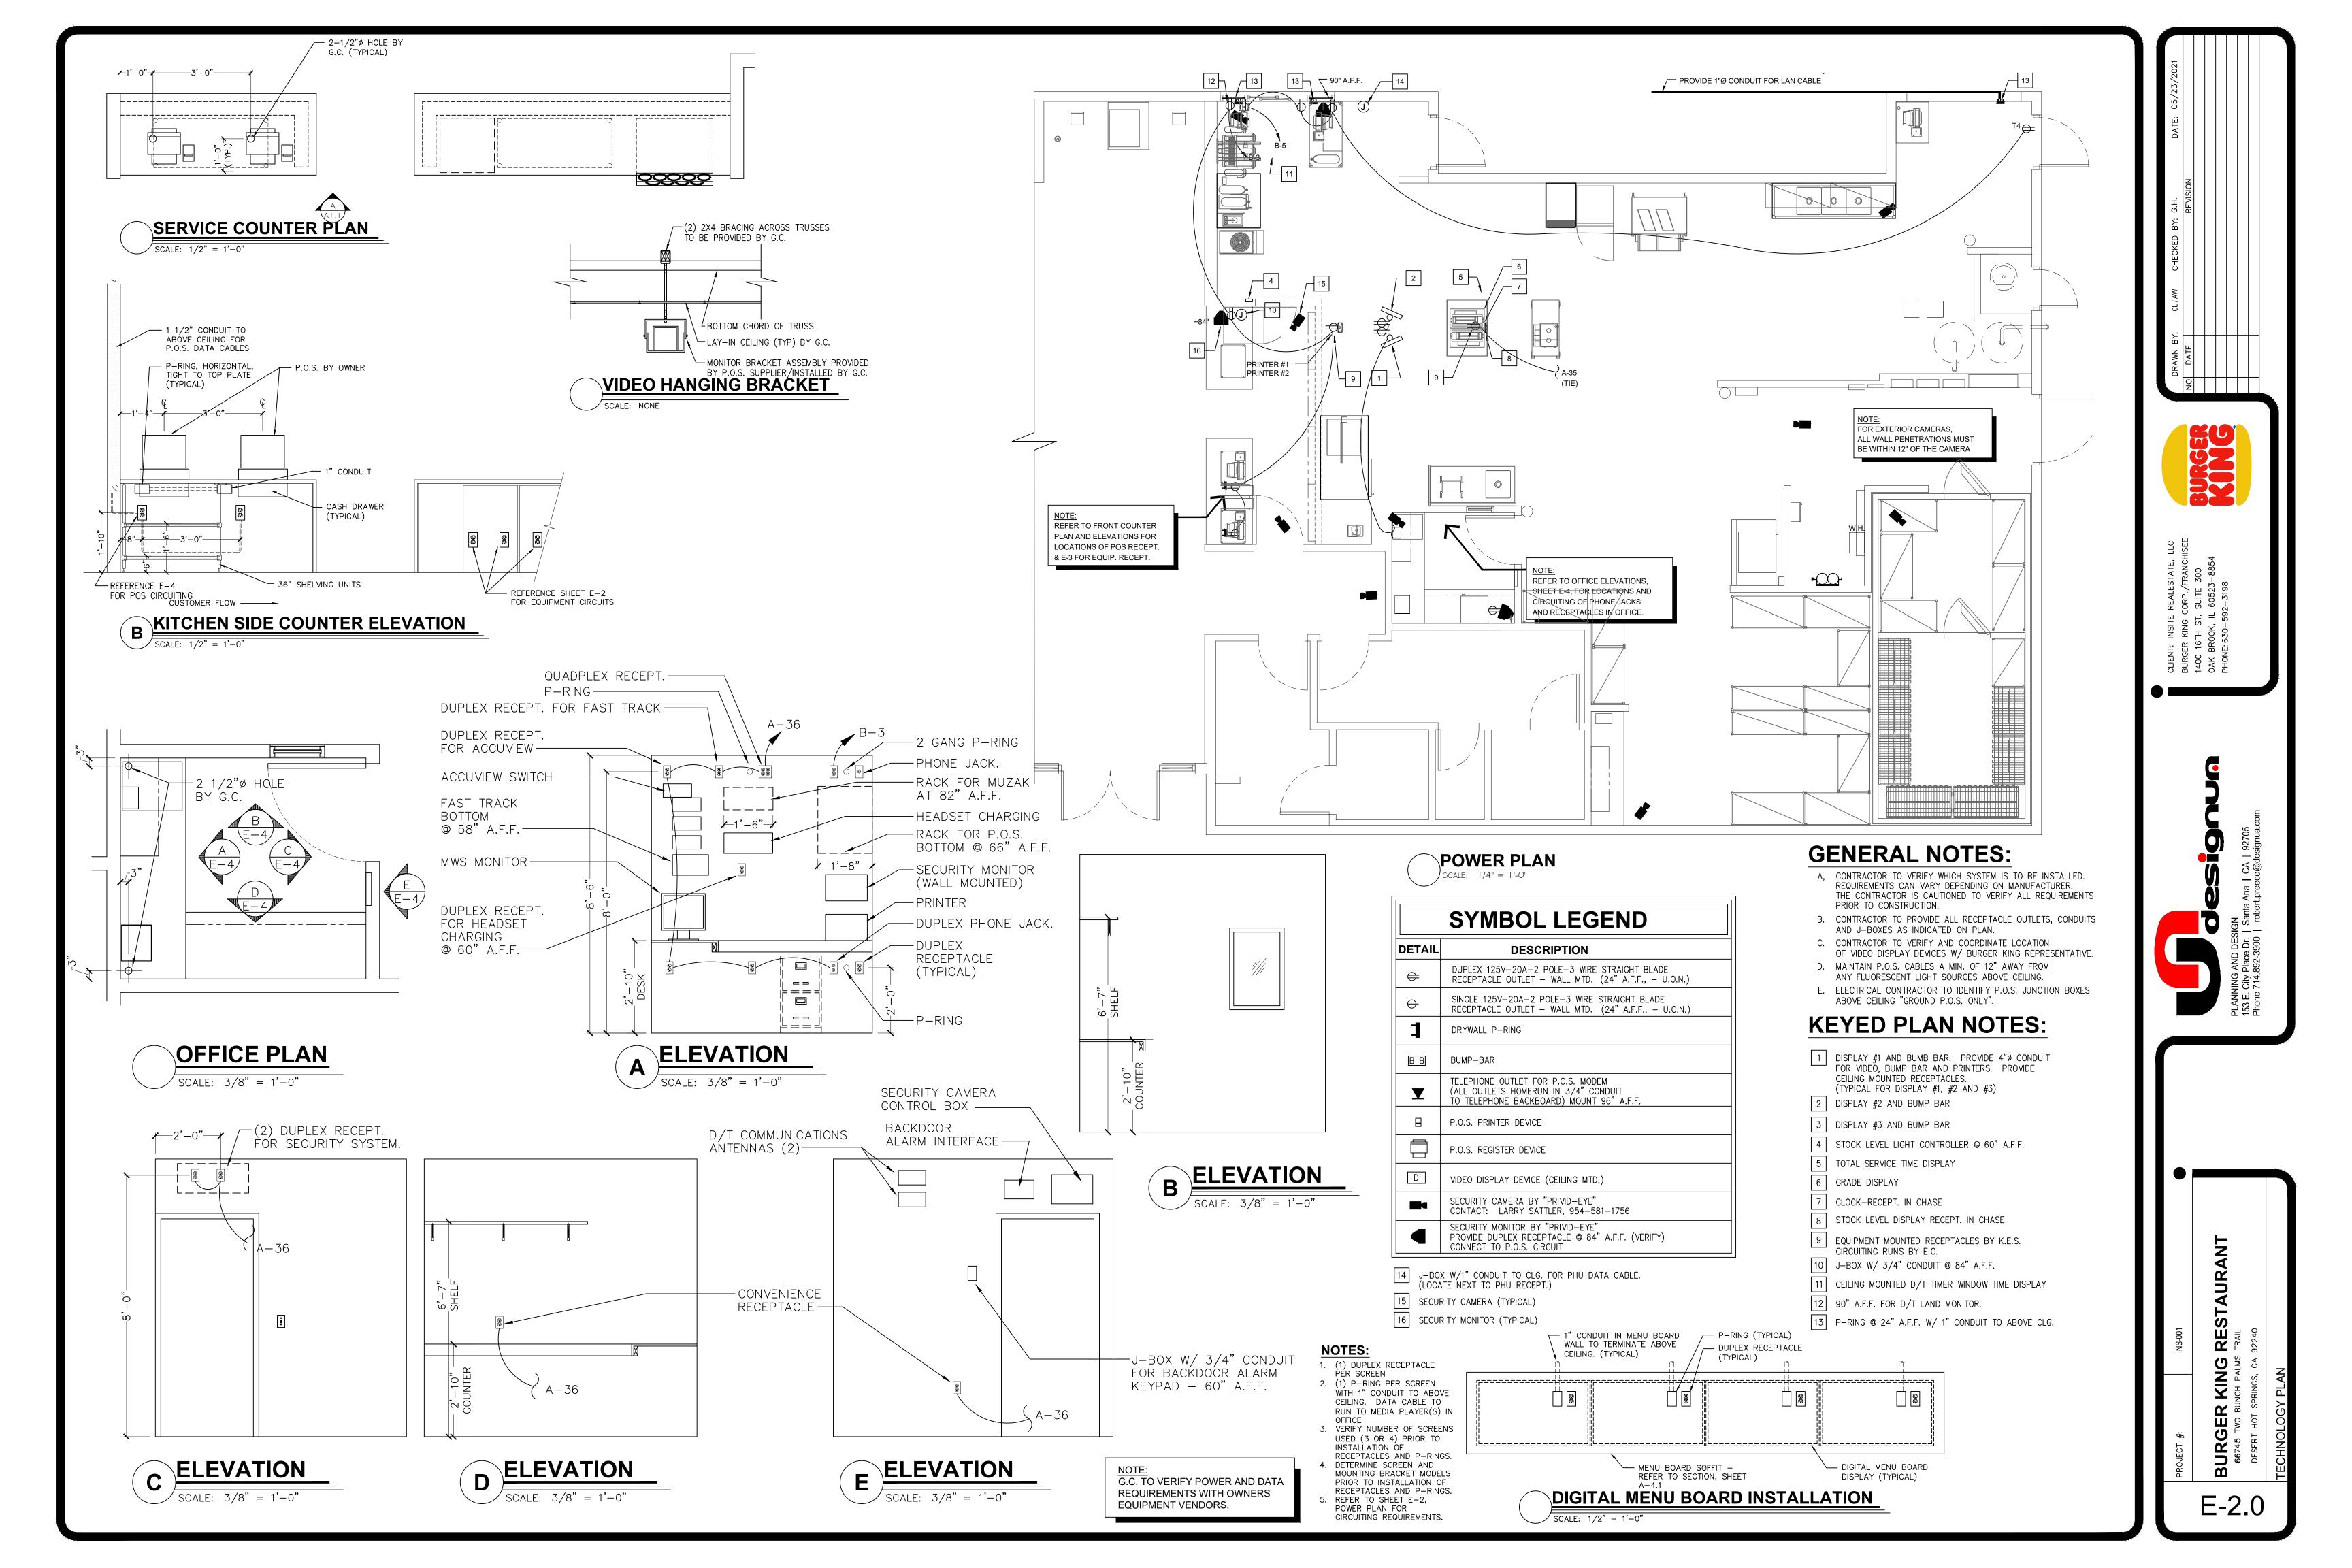

STATE OF CALIFORNIA			
Indoor Lighting NRCC-LTI-E (Created 01/20)			CALIFORNIA ENERGY COMMISSION
CERTIFICATE OF COMPLIANCE			NRCC-LTI-
Project Name: Burger King @	Desert Hot Springs	Report Page:	Page 7 of
Project Address: 66745 TWO B	UNCH PALMS TRAIL, DESERT HOT SPRINGS, CA 92240	Date Prepared:	5/19/202
DOCUMENTATION AUTHOR	'S DECLARATION STATEMENT		?
I certify that this Certificate of C	Compliance documentation is accurate and complete		
Documentation Author Name:	Zhiqiang Zhang	Documentation Author Signature:	
Company:	JS Engineering	Signature Date:	5/20/2021
Address:	410 S. San Gabriel Blvd., Suite B	CEA/ HERS Certification Identification	(if applicable):
City/State/Zip:	San Gabriel, CA 91776	Phone:	(626) 497-0558
Compliance (responsible de: 3. The energy features and per Certificate of Compliance co 4. The building design features compliance documents, wo 5. I will ensure that a complete	3 of the Business and Professions Code to accept responsigner) formance specifications, materials, components, and menter to the requirements of Title 24, Part 1 and Part 6 or system design features identified on this Code of Regulations of Compliance are consistent with the d to the enforcement agency for apprenade available with the building peri	design or system design identified on this . e information provided on other applicable roval with this building permit application. mit(s) issued for the building, and made available
	provides to the building owner at occupancy.	Danier Cinnet	\sim
Responsible Designer Name:	Zhiqiang Zhang	Responsible Designer Signature:	
Company :	JS Engineering	Date Signed:	5/20/2021
Address:	410 S. San Gabriel Blvd., Suite B	License:	E-169 4 9
City/State/Zip:	San Gabriel, CA 91776	Phone:	(626) 497-0558

CA Building Energy Efficiency Standards - 2019 Nonresidential Compliance: http://www.energy.ca.gov/title24/2019standards January 2020

CERTITION	ighting eated 01/20)	A N. C. T.				CAL	IFORNIA ENERGY COMI	
CERTIFICAT Project Nam	E OF COMPLI	ANCE King @ Desert	Hot Springs	Report Page:				NRCC-LTI Page 4 of
			ALMS TRAIL, DESERT HOT SPRINGS, CA 92240	Date Prepared:				5/19/202
LIGHTIN	C DOWED A	II OWANCE: C	COMPLETE BUILDING OR AREA CATEGORY METHO	NDS .				<u> </u>
			or each area complying using the Complete Building or A		per <u>§140.6(</u>	<u>b)</u> . Indicate if	additional lighting	
		or adjustment	s per <u>§140.6(a)</u> are being used.					-
Conditioned	d Spaces 01		02	03	04	05	06	
	01			Allowed		Allowed	Additional All	owances /
Ar	ea Descriptio	n	Complete Building or Area Category Primary Function Area	Density (W/ft ²)	Area (ft²)	Wattage (Watts)	Adjustn Area Category	
	DINING		Dining - Fast Food	0.4	580	232		
S	SERVICE AREA		Retail Merchandise Sales, Wholesale Showroom	1	104	104		
	KITCHEN		Kitchen, Food Preparation	0.95	1,186	1,126.7		
R	RESTRM/HALL		Restroom	0.65	210	136.5	See Tables Lea	D for datail
				TOTAL:	2,080	1,599.2	See Tables J or	P for detail
						1		
. ADDITIO	NAL LIGHT	NG ALLOWAN	ICE: AREA CATEGORY METHOD QUALIFYING LIGH	TING SYSTEM				[
This Section	n Does Not Ap	pply						
K TAILORI	ED METHOR	GENERAL LIC	GHTING POWER ALLOWANCE					<u> </u>
	n Does Not Ap							
			NCE: TAILORED WALL DISPLAY					<u></u>
This Section	n Does Not Ap	pply						
M ADDITI	IONAL LIGH	TING ALLOWA	NCE: TAILORED FLOOR AND TASK LIGHTING					<u> </u>
	n Does Not Ap							
		F-7						
N. ADDITIO	ONAL LIGHT	ING ALLOWA	NCE: TAILORED ORNAMENTAL/SPECIAL EFFECTS					<u> </u>
This Section	n Does Not Ap	pply						
O. ADDITIO	ONAL LIGHT	ING ALLOWA	NCE: TAILORED VERY VALUABLE MERCHANDISE					<u></u>
This Section	n Does Not Ap	pply						
CA Building E	Energy Efficien	cy Standards - 20	19 Nonresidential Compliance: http://www.energy.ca.gov/tit	le24/2019standards				January 202
ndoor L								in a con
IRCC-LTI-E (Cr						CAL	IFORNIA ENERGY COMI	MISSION
CERTIFICAT	E OF COMPL							NRCC-LTI
Project Nam		King @ Desert		Report Page:				Page 5 of
Project Add	Iress: 66745	TWO BUNCH PA	ALMS TRAIL, DESERT HOT SPRINGS, CA 92240	Date Prepared:				5/19/20
P. POWER	ADJUSTME	NT: LIGHTING	CONTROL CREDIT (POWER ADJUSTMENT FACTOR	R (PAF))				<u> </u>
	n Does Not Ap			(//				
	POWER REI	DUCTION COM	ADLIANCE FOR ALTERATIONS					6
Q. RATED		pply	IPLIANCE FOR ALTERATIONS					
	n Does Not Ap		IPLIANCE FOR ALTERATIONS					E
This Section		VED FOR ALTE						
This Section	HTING POV		RATIONS - CONTROLS EXCEPTIONS					
This Section								
This Section R. 80% LIG This Section	GHTING POV 1 Does Not Ap	pply						
This Section R. 80% LIG This Section S. DAYLIGI	GHTING POV 1 Does Not Ap	pply POWER ADJU	RATIONS - CONTROLS EXCEPTIONS					•
This Section R. 80% LIG This Section S. DAYLIGI	GHTING POV 1 Does Not Ap	pply POWER ADJU	RATIONS - CONTROLS EXCEPTIONS					
This Section R. 80% LIG This Section S. DAYLIGI This Section T. DECLAR	GHTING POV In Does Not Ap HT DESIGN In In Does Not Ap	POWER ADJUST Poply EQUIRED CER	RATIONS - CONTROLS EXCEPTIONS STMENT FACTOR (PAF) TIFICATES OF INSTALLATION					
This Section R. 80% LIG This Section S. DAYLIGI This Section This Section This Section This Section This Section	GHTING POV In Does Not Ap HT DESIGN I In Does Not Ap ATION OF R Inctions: Select	POWER ADJUST POWER ADJUST Ply EQUIRED CER Stions have been	RATIONS - CONTROLS EXCEPTIONS STMENT FACTOR (PAF) TIFICATES OF INSTALLATION made based on information provided in previous tables	•	•			iin why in
This Section R. 80% LIG This Section S. DAYLIGI This Section T. DECLAR Table Instru Table E. Adde	HT DESIGN IN DOES NOT APPLIED TO THE PROPERTY OF RESIDENCE OF RESIDENCE OF RESIDENCE OF THE PROPERTY OF THE PR	POWER ADJUST POWER ADJUST POPLY EQUIRED CER Stions have been arks. 





CA Building Energy Efficiency Standards - 2019 Nonresidential Compliance: http://www.energy.ca.gov/title24/2019standards

NRCI-LTI-02-E - Must be submitted for a lighting control system, or for an Energy Management Control System (EMCS), to be recognized for compliance.

NRCI-LTI-06-E - Must be submitted for additional wattage installed in a video conferencing studio to be recognized for

NRCI-LTI-04-E - Must be submitted for two interlocked systems serving an auditorium, a convention center, a conference room, a multipurpose room, or a theater to be recognized for compliance.

NRCI-LTI-05-E - Must be submitted for a Power Adjustment Factor (PAF) to be recognized for compliance.

ndoor Li	FORNIA ighting				- The state of the
RCC-LTI-E (Cre	eated 01/20)		CALIFORNIA	ENERGY COMMI	ission 🐸
ERTIFICATI	E OF COMP	LIANCE			NRCC-LTI-
roject Nam	ne: Burge	er King @ Desert Hot Springs	Report Page:		Page 6 of
roject Add	ress: 6674	5 TWO BUNCH PALMS TRAIL, DESERT HOT SPRINGS, CA 92240	Date Prepared:		5/19/202
		REQUIRED CERTIFICATES OF ACCEPTANCE			<u> </u>
able E. Ada	ditional Ren	ctions have been made based on information provided in previous tables narks. These documents must be provided to the building inspector during the control of the control	g construction and any with "-A" in the form name must i		
able E. Ada	ditional Ren		g construction and any with "-A" in the form name must i		
able E. Ada cceptance	ditional Ren Test Techni	narks. These documents must be provided to the building inspector durin ician Certification Provider (ATTCP). For more information visit: http://w	g construction and any with "-A" in the form name must i	be completed	
able E. Ada	ditional Ren	narks. These documents must be provided to the building inspector durin	g construction and any with "-A" in the form name must i	be completed	through (
able E. Ada cceptance	ditional Ren Test Techni	narks. These documents must be provided to the building inspector durin ician Certification Provider (ATTCP). For more information visit: http://w	g construction and any with "-A" in the form name must in www.energy.ca.gov/title24/attcp/providers.html	be completed	spector
able E. Ada cceptance YES	ditional Ren Test Techn NO	narks. These documents must be provided to the building inspector durin ician Certification Provider (ATTCP). For more information visit: <u>http://w</u> Form/Title	g construction and any with "-A" in the form name must in www.energy.ca.gov/title24/attcp/providers.html	be completed	spector
able E. Add cceptance YES	ditional Ren Test Techno NO	narks. These documents must be provided to the building inspector durinician Certification Provider (ATTCP). For more information visit: <a -a"="" atic="" attcp="" controls.<="" form="" href="http://www.http://www.ntm.nust.nust.nust.nust.nust.nust.nust.nust</td><td>g construction and any with " in="" must="" name="" providers.html="" switch="" td="" the="" time="" title24="" www.energy.ca.gov=""><td>be completed</td><td>spector</td>	be completed	spector	
able E. Ada cceptance YES	nditional Ren Test Techno NO	narks. These documents must be provided to the building inspector durin ician Certification Provider (ATTCP). For more information visit: <a -a"="" attcp="" attic="" controls.<="" form="" href="http://w/</td><td>g construction and any with " in="" must="" name="" providers.html="" switch="" td="" the="" time="" title24="" www.energy.ca.gov=""><td>be completed</td><td>spector</td>	be completed	spector	

CA Building Energy Efficiency Standards - 2019 Nonresidential Compliance: http://www.energy.ca.gov/title24/2019standards

STATE OF CALIFORNIA **Indoor Lighting** NRCC-LTI-E (Created 01/20 CERTIFICATE OF COMPLIANCE This document is used to demonstrate compliance with requirements in §110.9, §110.12(c), §130.0, §130.1, §140.6, and §141.0(b)2 for indoor lighting scopes using the prescriptive path. Project Name: Burger King @ Desert Hot Springs
Project Address: 66745 TWO BUNCH PALMS TRAIL, DESERT HOT SPRINGS, CA 92240 5/19/2021 01 Project Location (city) 04 Total Conditioned Floor Area (ft²) 02 Climate Zone 05 Total Unconditioned Floor Area (ft²) 06 # of Stories (Habitable Above Grade) 03 Occupancy Types Within Project (select all that apply): School Hotel/Motel Office ✓ Retail Support Areas Parking Garage Other (write in): High-Rise Residential Relocatable Healthcare B. PROJECT SCOPE Table Instructions: Include any lighting systems that are within the scope of the permit application and are demonstrating compliance using the prescriptive path outlined in \$140.6 or \$141.0(b)2 for alterations. WARNING: Changing the Calculation Method in this table will result in the deletion of data previously input. If you need to change the calculation method, please open a new form or use "Save As". Scope of Work **Conditioned Spaces** My Project Consists of (check all that apply): Calculation Method Area (ft²) Calculation Method Area (ft²) ✓ New Lighting System Area Category 2,080 Altered Lighting System Altered Lighting System Total Area of Work (ft²) C. COMPLIANCE RESULTS Table Instructions: If any cell on this table says "DOES NOT COMPLY" or "COMPLIES with Exceptional Conditions" refer to Table D. for guidance. conditioned and Area Category Tailored unconditioned Total PAF Control Total Adjusted be combined for compliance per \$140.6(c)1 spaces must not Complete Area Category Additional S140.6(c)3 = Total Allowed $\frac{140.6(c)3}{140.6(c)3}$ Designed Credits = (Watts) 05 Must be ≥ 08 (Watts) <u>§140.6(a)2</u> (+) (Watts) *Includes §140.6 Adjustments §140.6(b)1. 1,057.5 1,599.2 1,599.2 COMPLIES Table Continued CA Building Energy Efficiency Standards - 2019 Nonresidential Compliance: http://www.energy.ca.gov/title24/2019standards January 2020

STATE OF CAI										
	Lighting									23
	Created 01/20) ATE OF COMPLIANCE						CA	ALIFORNIA ENERGY C		RCC-L
Project Na		ings			Report Page:					age 2
	Idress: 66745 TWO BUNCH PALMS TR		T SDRINGS CA O	2240	Date Prepared	٠.				/19/2
r roject Au	idless. 00/43 TWO BONCH FALINS II	AIL, DESERT TR	or serrings, ca s.	2240	Date Freparet	u.				113/2
C. COMP	LIANCE RESULTS									
Uncondit	ioned:			=	2		=			
				Conti	rols Compliance (S	See Table H for D	Details)	COMPLI	ES	
			Rated P	ower Reduct	ion Compliance (S	ee Table Q for D	Details)	Not Applic	able	
							<u> </u>			
D. EXCEP	TIONAL CONDITIONS									
This table	is auto-filled with uneditable commen	ts because of s	elections made or	data enterea	l in tables through	out the form.				
No except	ional conditions apply to this project.									
E. ADDITI	IONAL REMARKS									
This table	includes remarks made by the permit	applicant to the	e Authority Having	g Jurisdiction.						
	OR LIGHTING FIXTURE SCHEDULE									
	ructions: Include all permanent design	ed lighting and	all portable light	ing in offices.						
Designed '	Wattage: Conditioned Spaces									
01	02	03	04	05	06	07	08	09	1	10
Name or		Modular	Small Aperture	Watts per	How Wattage is	Total number	Exempt per		Field In	ıspec
Item Tag	Complete Luminaire Description		& Color Change ¹	luminaire ²	determined	luminaires	§140.6(a)3	Design Watts		
	CHANGE DEAD ANT LIGHT	,			N45 6 2			20	Pass	Fa
A	SHAKER PENDANT LIGHT			10	Mfr. Spec ²	2		20	$\vdash \vdash$	
C6W	6" WHT LED DOWNLIGHT			12.5	Mfr. Spec ²	7		87.5	$\sqcup \sqcup$	
D6W	6" LED DOWNLIGHT WALL WASHER			12	Mfr. Spec ²	5		60		
F	PENDANT LIGHT LIGHT			12	Mfr. Spec ²	3		36		
G	2" LED DOWNLIGHT			10	Mfr Spec ²	31		310		Т

CA Building Energy Efficiency Standards - 2019 Nonresidential Compliance: http://www.energy.ca.gov/title24/2019standards January 2020

Total Designed Watts CONDITIONED SPACES: 1,057.5

Indoor Lighting		
NRCC-LTI-E (Created 01/20)		CALIFORNIA ENERGY COMMISSION
CERTIFICATE OF COMPLIANCE		NRCC-LTI-E
Project Name: Burger King @ Desert Hot Springs	Report Page:	Page 3 of 7
Project Address: 66745 TWO BUNCH PALMS TRAIL, DESERT HOT SPRINGS, CA 92240	Date Prepared:	5/19/2021

¹ FOOTNOTE: Design Watts for small aperture and color changing luminaires which qualify per <u>§140.6(a)4B</u> is adjusted to be 75% of their rated wattage. Table F automatically makes this adjustment, the permit applicant should enter full rated wattage in column 05. ² Authority Having Jurisdiction may ask for Luminaire cut sheets to confirm wattage used for compliance per §130.0(c) Wattage used must be the maximum rated for the luminaire, not the lamp.

This Section Does Not	Apply								
H. INDOOR LIGHTIN	G CONTROLS (Not Including PAFs)								2
	ase include lighting controls for condition the lighting controls section of the Compl				, ,	,		on of this	table
Building Level Control	ls								
	01	02					03		
Mandatory Demand Response §110.12(c)			Shut-Off Controls §130.1(c)					Field Inspector	
								Pass	Fail
	Not Required ≤ 10,000 SF	See Area/Space Level Controls							
Area Level Controls									
04	05	06	07	08	09	10	11	1	.2
Area Description	Complete Building or Area Category Primary Function Area	Area Controls §130.1(a)	Multi-Level Controls	Shut-Off Controls	Primary/Skylit Daylighting	Secondary Daylighting	Interlocked Systems	Field Inspector	
			§130.1(b)	§130.1(c)	§130.1(d)	§140.6(d)	§140.6(a)1	Pass	Fail
DINING	Dining Fast Food	Manual ON/ Manual ON/OFF OFF	Bi-level Switch	Occ. Senson	Included	NA.ª			
KITCHEN	Kitchen, Food Preparation	Manual ON/ Manual ON/OFF OFF	Bi-level Switch	Auto Auto Timeswitch Timeswitch	NA.A	NAA			
RESTRM	Restroom	Manual ON/ OFF	Bi-level Switch	Vacancy	NA.A	NA			
*NOTES: Controls with	n a * require a note in the space below ϵ	explaining how co	mpliance is achieve	ed.		1	3		
EX: Conference 1: Primary/Skylight Daylighting: Exempt because less than 120 watts of general lighting;					Plan Sheet Showing Daylit Zones:				
EXCEPTION 1 to §130.		ise iess tilali 120 v	vatts of generaling	ming,		an sheet show	ing Dayiit 201	163.	

CA Building Energy Efficiency Standards - 2019 Nonresidential Compliance: http://www.energy.ca.gov/title24/2019standards

2" LED DOWNLIGHT

G1 2" LED DOWNLIGHT WALL WASHER I 2x4 LED TROFFER LIGHTING

January 2020

January 2020

January 2020

ENGINEER:

 $\mathbf{\Omega}$

C:\Users\charl\OneDrive\2021 Project\DesignUA\Burger King\INS 001 Desert Hot Springs\CD\r2 base update\E30 ENERGY CALC.dwg, 8/26/2021 2:19:05 PM, charl, AutoCAD PDF (General Documentation).pc3, CAL Arc1

JS ENGINEERING, INC. 410 S. SAN GABRIEL BLVD., SUITE 8, SAN GABRIEL, CA 91776 PHONE: 626.497.0558 EMAIL: INFO@CAL-PACIFIC.NET

CERTIFICATE (ated 11/19)						CALIFORNIA	ENERGY COMN			
	OF COMPLIAN								NRCC-LTO-		
	roject Name: Burger King @ Desert Hot Springs Report Page: roject Address: 66745 TWO BUNCH PALMS TRAIL, DESERT HOT SPRINGS, CA 92240 Date Prepared:								Page 4 of		
Project Addre	SS: 66/45 TW	O BUNCH PALIVIS TRAIL,	DESERT HUT SPRIN	NGS, CA 92240	Date	Prepared:			10/18/202		
Parking Lo	ot & Drive Thu	r. Asphalt	31,690	0.025	792.25		0.25)	792.25		
Build	ding Facade	Concrete	8,560	0.03	256.8		0.4)	256.8		
								I			
						Initial Wattag	e Allowance for Entire Site	(Watts):	350		
						Total Gen	eral Hardscape Allowance	(Watts):	1,399.05		
	A 1	A A	A A		A A	A A	A A A				
J. LIGHTING	ALLOWANCE	:: PER APPLICATION							?		
This Section D	Does Not Apply										
V LICUTING	ALLOWANG	E. CALEC EDONITACE									
		E: SALES FRONTAGE							2		
Inis Section L	Does Not Apply										
LUGHTING	: ALLOWANCE	: ORNAMENTAL							<u></u>		
	Does Not Apply								<u> </u>		
This Section L	Joes Not Apply										
M. LIGHTING	G ALLOWANG	E: PER SPECIFIC AREA							7		
This Section D	Does Not Apply										
N. EXISTING	CONDITION	S POWER ALLOWANCE	(alterations on	ly)					?		
This Section D	Does Not Apply							'			
		UIRED CERTIFICATES							?		
							ection needs to be changed				
		. These documents must Compliance documents				ction and can be fo	und online at <u>https://www</u>	<u>.energy.ca.g</u>	<u> </u>		
111111111111111111111111111111111111111	turiuurus/2013		s/Nonresidentidi_i	DOCUMENTS/ NACI/				Field	Field Inspector		
YES	NO	Form/Title -						Pass	<u> </u>		
									Fail		
	NRCI-LTO-01-E - Must be submitted for all buildings.										
•	ONR	NRCI-LTO-02-E - Must be submitted for a lighting control system; or for an Energy Management Control System (EMCS), to be recognized for compliance.									
•	rec								•		
_	rec										
•	rec	tandards - 2019 Nonrocidos	ntial Compliance, he	in //www.onorm.co	gov/title24/2010e	randarde		N.	ovember 2010		
•	rec	tandards - 2019 Nonresider	ntial Compliance: <u>htt</u>	:p://www.energy.ca	.gov/title24/2019st	tandard <u>s</u>		N	ovember 2019		
•	rec	tandards - 2019 Nonresider	ntial Compliance: <u>htt</u>	:p://www.energy.ca	.gov/title24/2019st	tandard <u>s</u>		N	ovember 2019		
•	rec	tandards - 2019 Nonresider	ntial Compliance: <u>htt</u>	tp://www.energy.ca	.gov/title24/2019st	tandard <u>s</u>		N	ovember 2019		
CA Building End	ergy Efficiency S	tandards - 2019 Nonresider	ntial Compliance: <u>htt</u>	tp://www.energy.ca	.gov/title24/2019st	tandards		N	ovember 2019		
•	ergy Efficiency S	tandards - 2019 Nonresider	ntial Compliance: <u>htt</u>	rp://www.energy.ca	.gov/title24/2019st	tandards		N	ovember 2019		

Table Instructions: Selections have been made based on information provided in previous tables of this document. If any selection needs to be changed, please explain why in

Table E. Additional Remarks. These documents must be provided to the building inspector during construction and must be completed through an Acceptance Test Technician

NRCA-LTO-02-A - Must be submitted for all outdoor lighting controls except for alterations where controls area added to ≤ 20

Pass Fail

November 2019

November 2019

626-497-0558

P. DECLARATION OF REQUIRED CERTIFICATES OF ACCEPTANCE

YES NO

Certification Provider (ATTCP). For more information visit: http://www.energy.ca.gov/title24/attcp/providers.html

CA Building Energy Efficiency Standards - 2019 Nonresidential Compliance: http://www.energy.ca.gov/title24/2019standards

SAN GABRIEL, CA 91776

City/State/Zip:

STATE OF CALIFORNIA **Outdoor Lighting** NRCC-LTO-E (Created 11/19) CERTIFICATE OF COMPLIANCE Project Name: Burger King @ Desert Hot Springs Project Address: 66745 TWO BUNCH PALMS TRAIL, DESERT HOT SPRINGS, CA 92240 10/18/2021 DOCUMENTATION AUTHOR'S DECLARATION STATEMENT I certify that this Certificate of Compliance documentation is accurate and complete Documentation Author Name: JOSEPH ZHANG Documentation Author Signature: JS ENGINEERING, INC Signature Date: 10/18/2021 Company: 410 S. SAN GABRIEL BLVD, #8 CEA/ HERS Certification Identification (if applicable): City/State/Zip: SAN GABRIEL, CA 91776 626-497-0558 Phone: RESPONSIBLE PERSON'S DECLARATION STATEMENT I certify the following under penalty of perjury, under the laws of the State of California: 1. The information provided on this Certificate of Compliance is true and correct. 2. I am eligible under Division 3 of the Business and Professions Code to accept responsibility for the building design or system design identified on this Certificate of Compliance (responsible designer) 3. The energy features and performance specifications, materials, components, and manufactured devices for the building design or system design identified on this Certificate of Compliance conform to the requirements of Title 24, Part 1 and Part 6 of the California Code of Regulations. 4. The building design features or system design features identified on this Certificate of Compliance are consistent with the information provided on other applicable compliance documents, worksheets, calculations, plans and specifications submitted to the enforcement agency for approval with this building permit application. 5. I will ensure that a completed signed copy of this Certificate of Compliance shall be made available with the building permit(s) issued for the building, and made available to the enforcement agency for all applicable inspections. I understand that a completed signed copy of this Certificate of Compliance is required to be included with the documentation the builder provides to the building owner at occupancy. Responsible Designer Name: JOSEPH ZHANG Responsible Designer Signature: 10/18/2021 JS ENGINEERING, INC Date Signed: Company E16949 410 S. SAN GABRIEL BLVD, #8 Address: License:

Phone:

CA Building Energy Efficiency Standards - 2019 Nonresidential Compliance: http://www.energy.ca.gov/title24/2019standards

STATE OF CALIFORNIA Outdoor Lighting NRCC-LTO-E (Created 11/19 CERTIFICATE OF COMPLIANCE This document is used to demonstrate compliance with requirements in §110.9, §130.0, §130.2, §140.7, and §141.0(b)2L for outdoor lighting scopes using the prescriptive path. Project Name: Burger King @ Desert Hot Springs Project Address: 66745 TWO BUNCH PALMS TRAIL, DESERT HOT SPRINGS, CA 92240 10/18/2021 A. GENERAL INFORMATION 01 Project Location (city) DESERT HOT SPRINGS. 04 Total Illuminated Hardscape Area (ft²) 02 Climate Zone 03 Outdoor Lighting Zone per Title 24, Part 1 §10-114 or as designated by Authority Having Jurisdiction (AHJ): LZ-0: Very Low - Undeveloped Parkland LZ-2: Moderate - Rural Areas LZ-4: High - Must be reviewed by CA Energy Commission for Approval **B. PROJECT SCOPE** Table Instructions: Include any outdoor lighting systems that are within the scope of the permit application and are demonstrating compliance using the prescriptive path outlined in §140.7 or §141.0(b)2L for alterations My project consists of: Must Comply with Allowances from §140. New Lighting System Altered Lighting System Is your alteration increasing the connected lighting load (Watts)? % of Existing Luminaires Being Altered¹ Sum Total of Luminaires Being Added or Altered Calculation Method ¹ FOOTNOTES: % of Existing Luminaires Being Altered = (Sum Total of Luminaires Being Added or Altered / Existing Luminaires within the Scope of the Permit Application) x 100 C. COMPLIANCE RESULTS Table Instructions: If any cell on this table says "DOES NOT COMPLY" or "COMPLIES with Exceptional Conditions" refer to Table D. for auidance. Calculation of Total Allowed Lighting Power (Watts) §140.7 or §141.0(b)2L Per Per Specific Existing Sales - Application + Frontage + Area OR Power Total Allowed Total Actual 07 Must be ≥ 08 Allowance §140.7(d)2 §140.7(d)2 §140.7(d)2 §140.7(d)2 §141.0(b)2L (Watts) §140.7(d)1 (See Table J) (See Table K) (See Table L) (See Table M) (See Table N) (See Table F) 1,280 Not Applicable


"Use it or lose it" Allowances (select all that apply) Hardscape Per Application | Sales Frontage | Allowance Table K Table M Table L Linear Wattage Allowance (LWA) Illuminated Allowed Density Area Allowance Perimeter Allowed Density Linear Allowance AWA + LWA Surface Type Area Description Area (ft²) (W/ft²) (Watts) Length (If) (W/If) (Watts) (Watts)

CA Building Energy Efficiency Standards - 2019 Nonresidential Compliance: http://www.energy.ca.gov/title24/2019standards

ENGINEER:

JS ENGINEERING, INC.

410 S. SAN GABRIEL BLVD., SUITE 8, SAN GABRIEL, CA 91776 PHONE: 626.497.0558 EMAIL: INFO@CAL-PACIFIC.NET

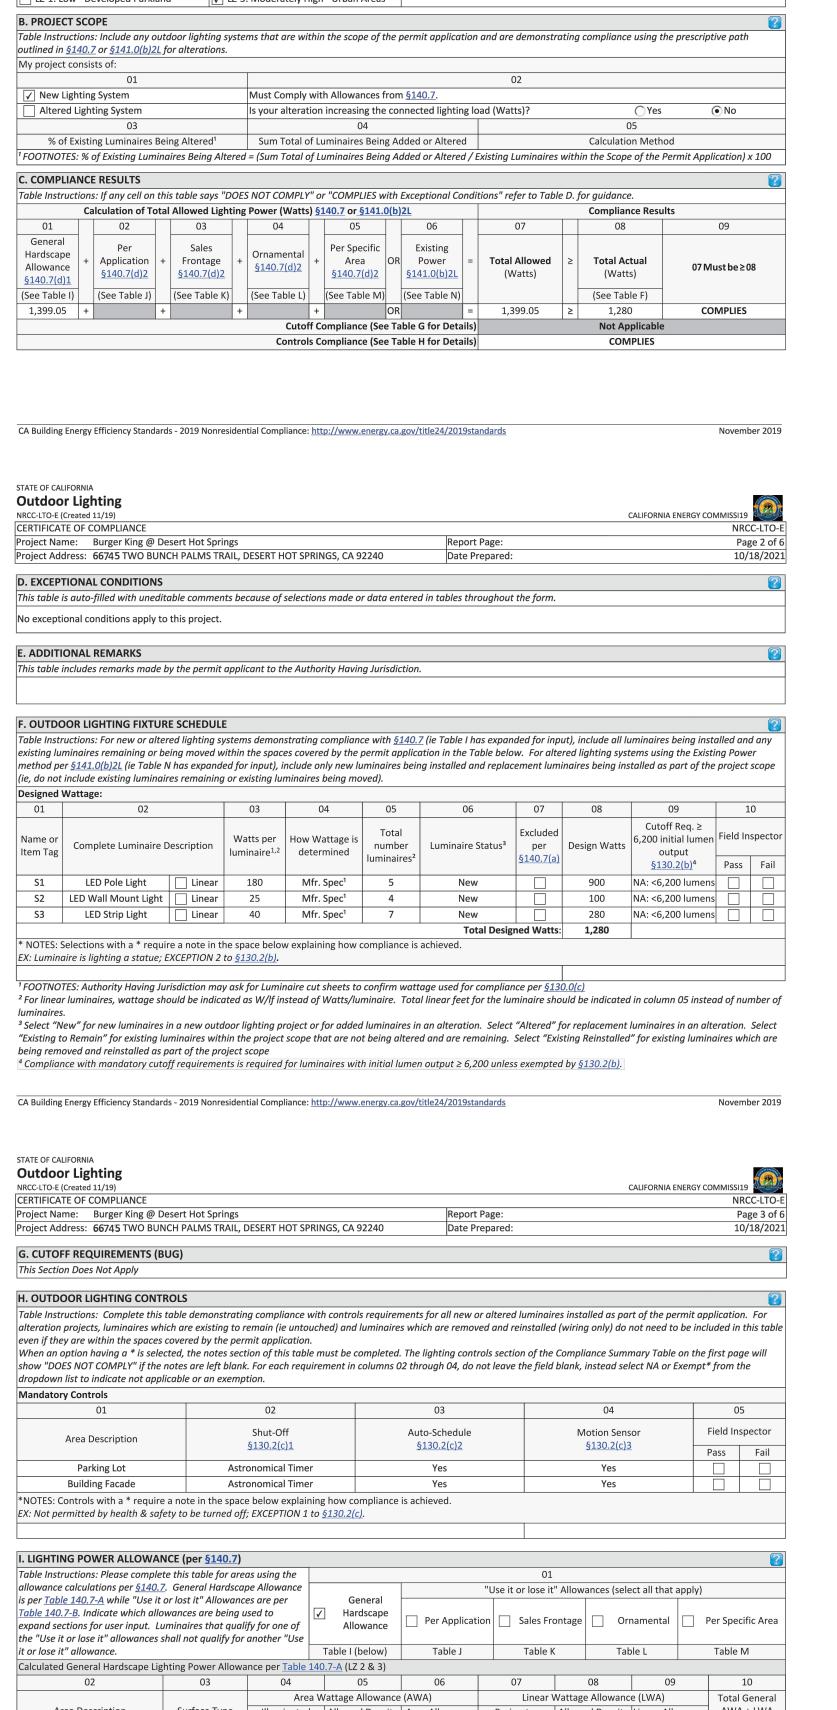

C:\Users\charl\OneDrive\2021 Project\DesignUA\Burger King\INS 001 Desert Hot Springs\CD\r2 base update\E30 ENERGY CALC.dwg, 10/18/2021 2:38:23 PM, charl, AutoCAD PDF (General Documentation).pc3, CAL Arc1